


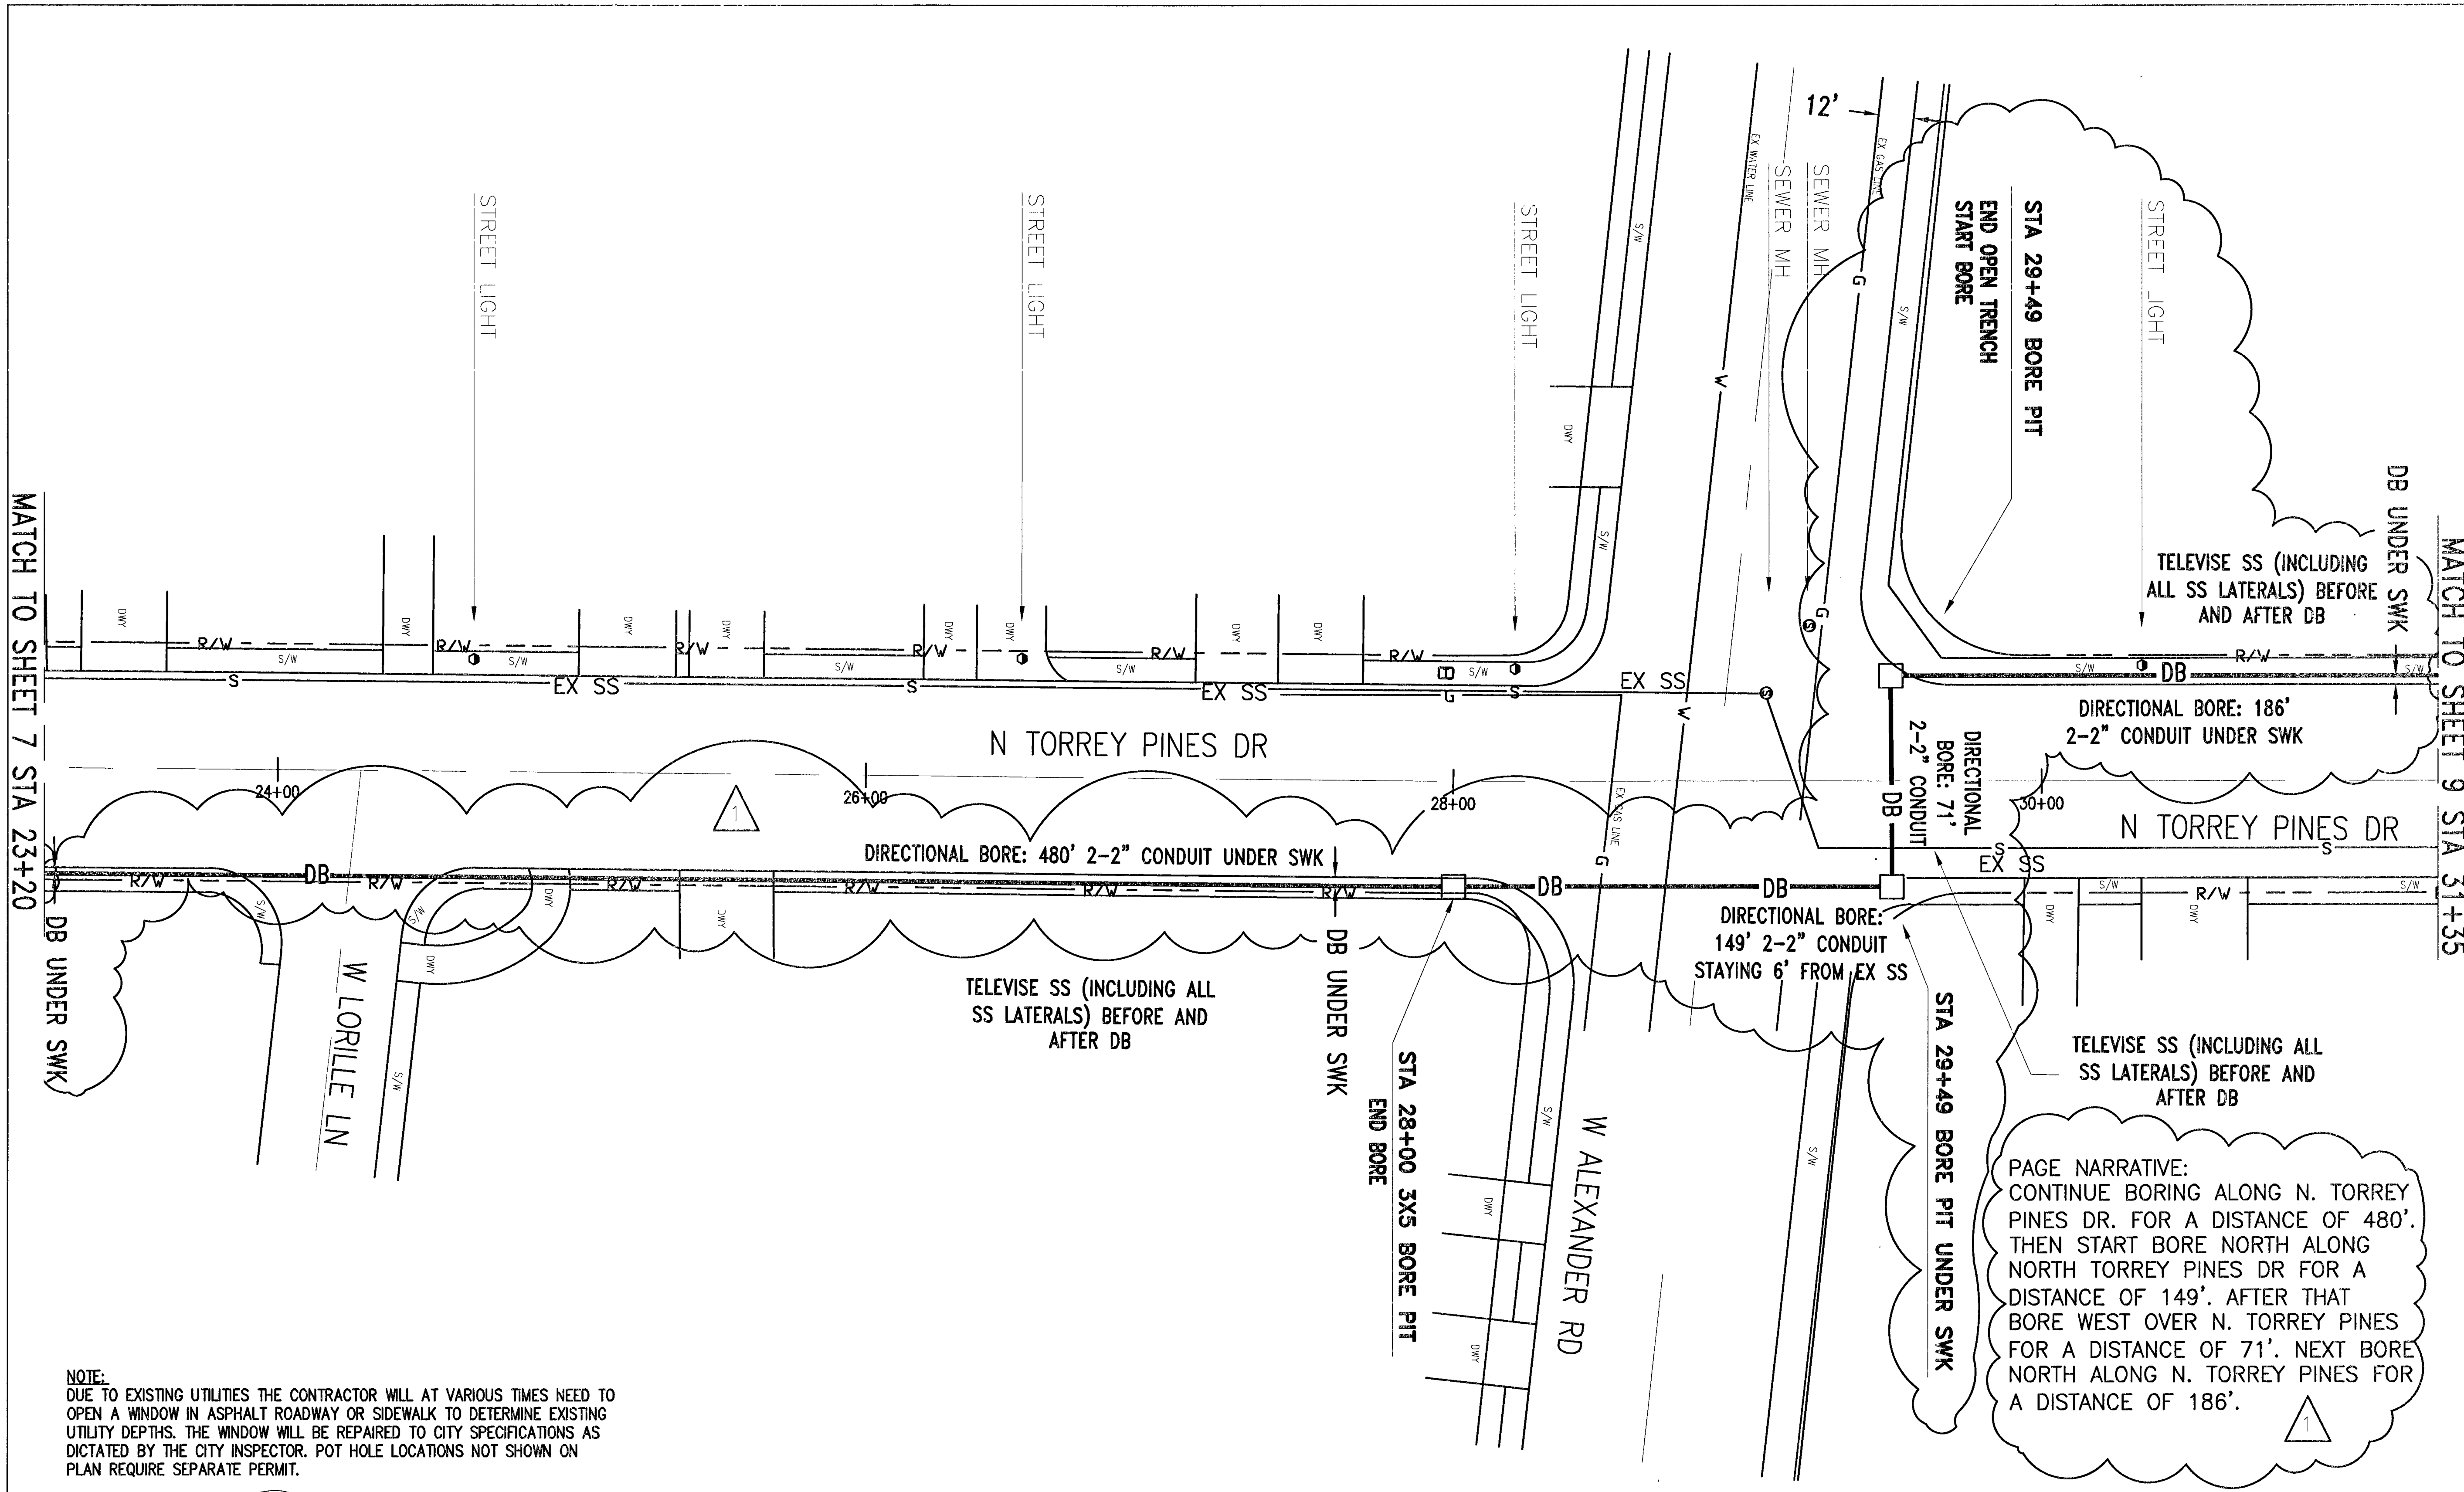


MATCH TO SHEET 7 STA 23+20

MATCH TO SHEET 9 STA 31+35

NOTE:
DUE TO EXISTING UTILITIES THE CONTRACTOR WILL AT VARIOUS TIMES NEED TO OPEN A WINDOW IN ASPHALT ROADWAY OR SIDEWALK TO DETERMINE EXISTING UTILITY DEPTHS. THE WINDOW WILL BE REPAIRED TO CITY SPECIFICATIONS AS DICTATED BY THE CITY INSPECTOR. POT HOLE LOCATIONS NOT SHOWN ON PLAN REQUIRE SEPARATE PERMIT.

RUS LIST	EST QTY	ACT QTY
BHF(30x60x30)T	0	
BFOV(2)(2)OT	0	
BORE PIT	3	
BM60(2-2)	886'	
BM73	15'	

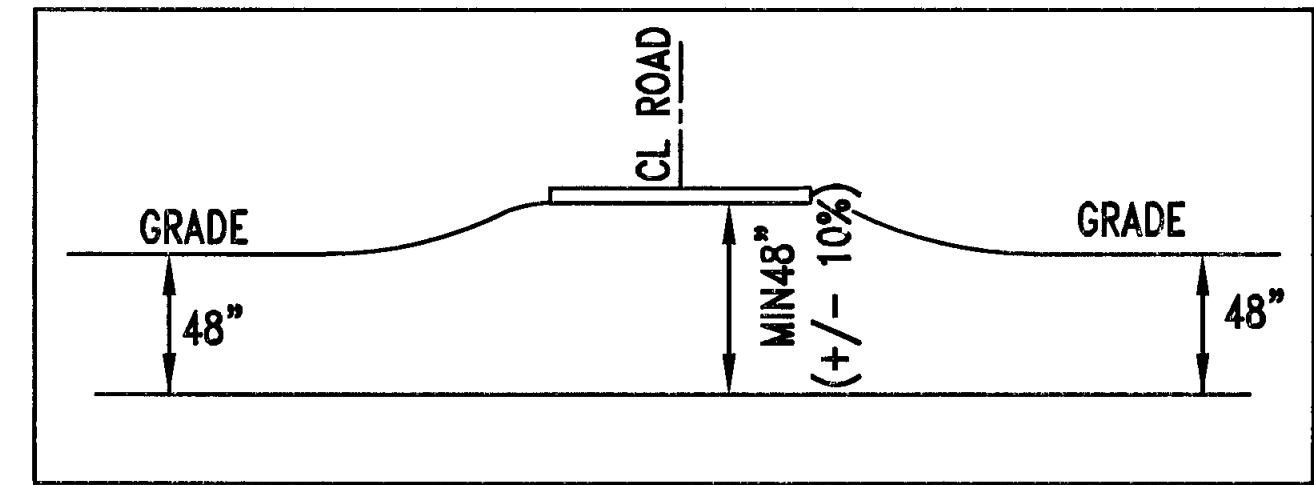

DIRECTIONAL BORE DETAIL
NOT TO SCALE

PROJECT: _____

SEG/SPAN: _____ SEG

FROM _____ TO _____

SECTION: 11

TOWNSHIP: 20S

RANGE: 60E

TITLE: FIBER OPTIC CABLE ROUTE

N. TORREY PINES DR
GOWAN RD TO CRAIG RD

REVISIONS

DATE	DESCRIPTION	INITIAL
3/14	CHANGE ALIGNMENT	JW
	PK 3-13-14	

MP _____ TO MP _____

SHEET 8 OF 11

DWG. NO. CTL E.422282

PAGE NARRATIVE:
CONTINUE BORING ALONG N. TORREY PINES DR. FOR A DISTANCE OF 480'. THEN START BORE NORTH ALONG NORTH TORREY PINES DR FOR A DISTANCE OF 149'. AFTER THAT BORE WEST OVER N. TORREY PINES FOR A DISTANCE OF 71'. NEXT BORE NORTH ALONG N. TORREY PINES FOR A DISTANCE OF 186'.

REPLAT