



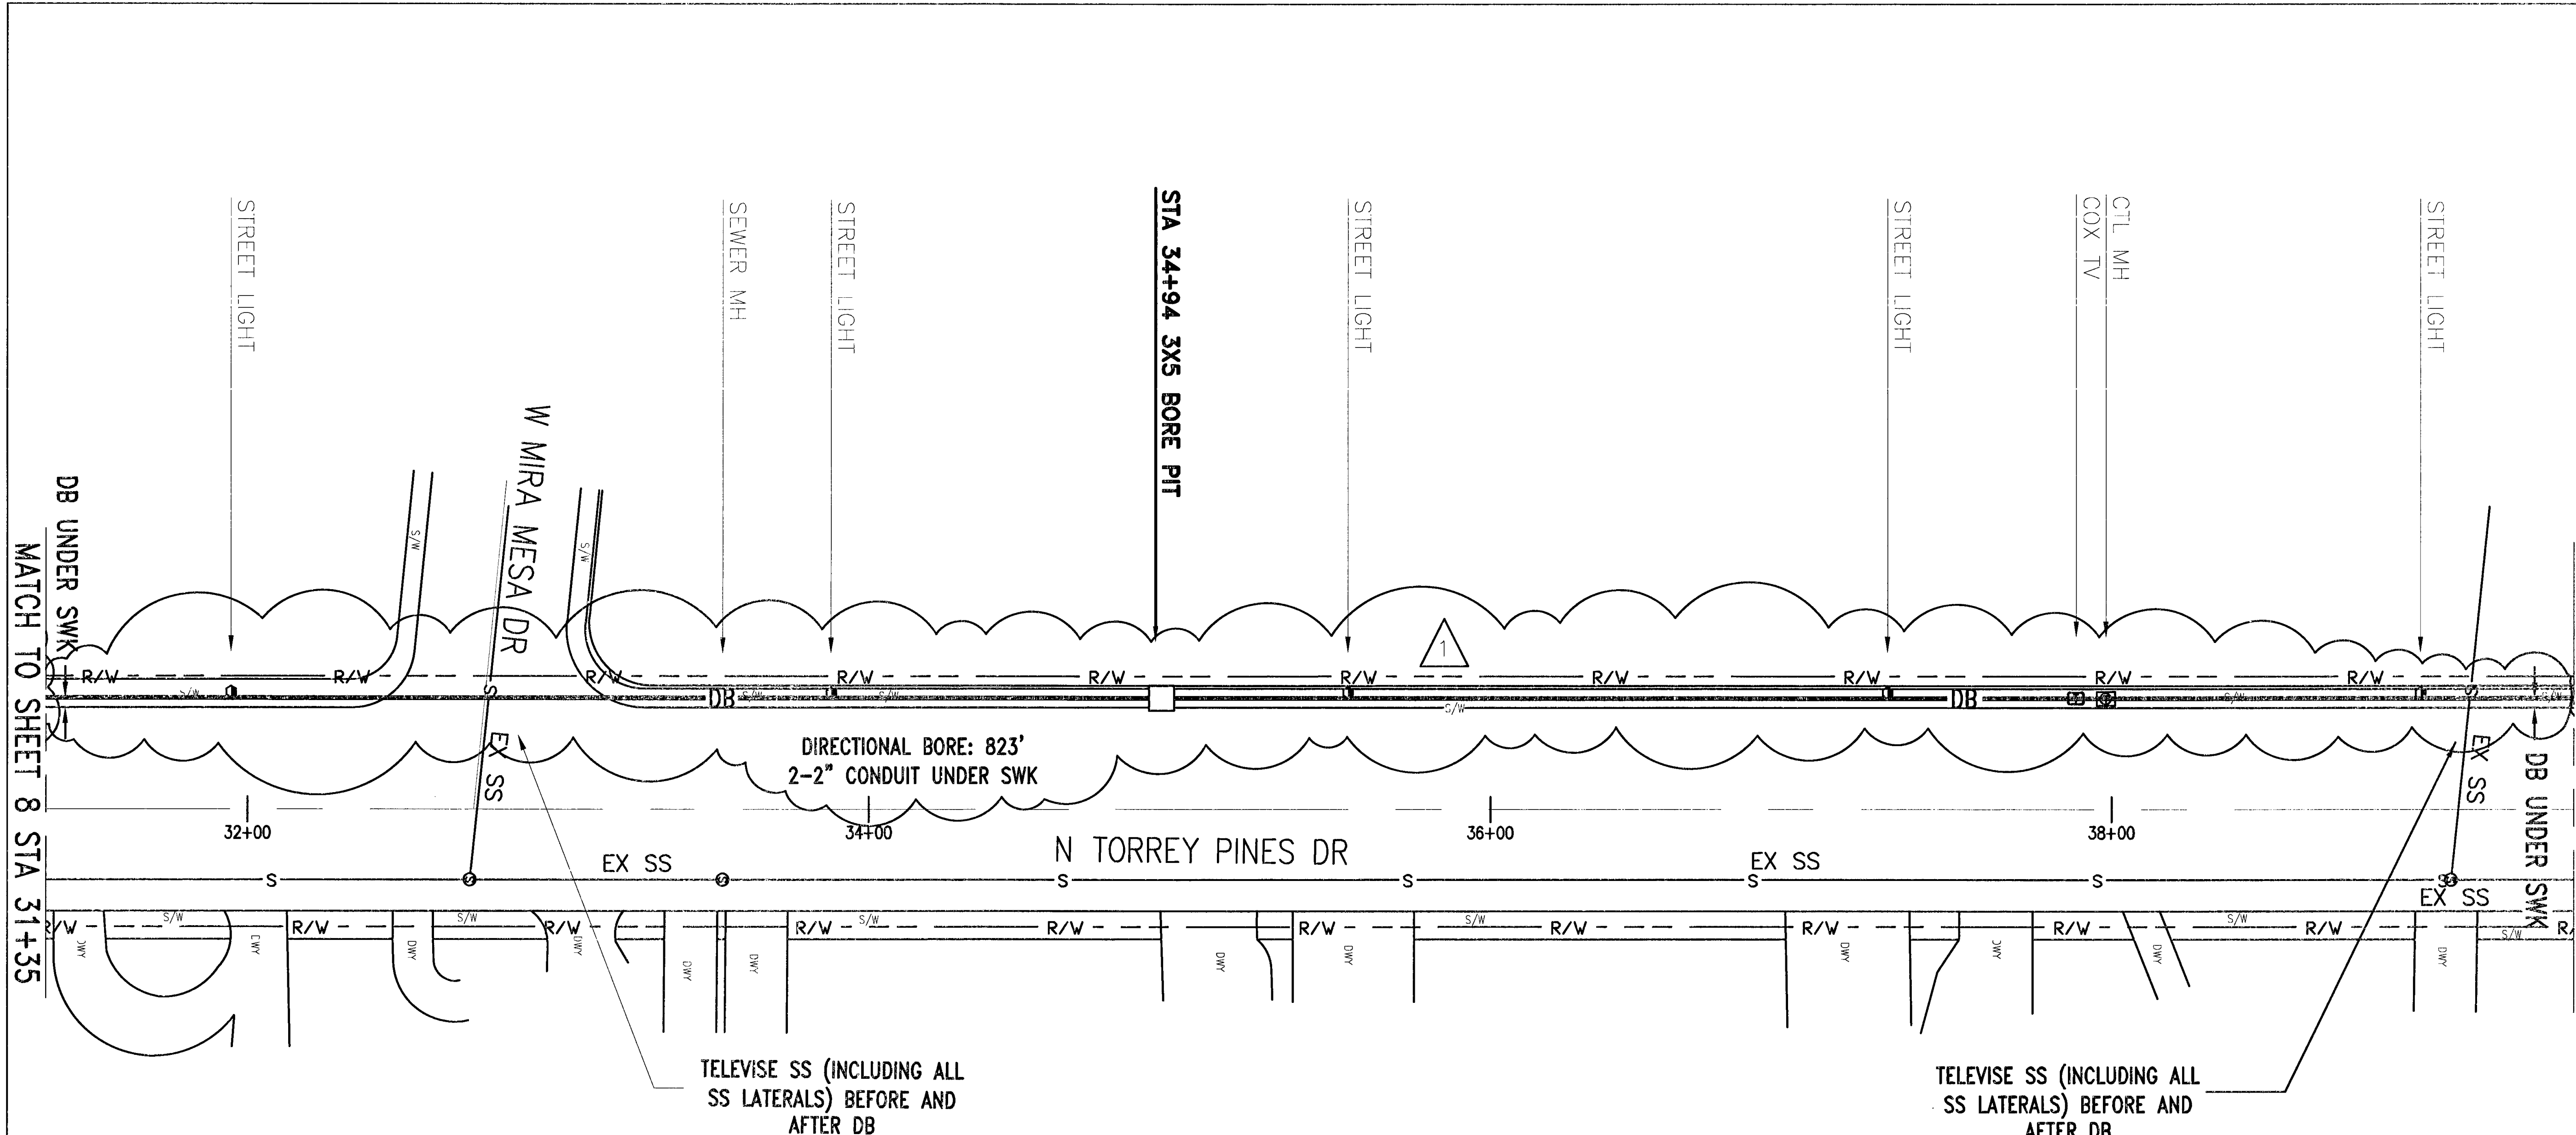

NOTE:
 DUE TO EXISTING UTILITIES THE CONTRACTOR WILL AT VARIOUS TIMES NEED TO OPEN A WINDOW IN ASPHALT ROADWAY OR SIDEWALK TO DETERMINE EXISTING UTILITY DEPTHS. THE WINDOW WILL BE REPAIRED TO CITY SPECIFICATIONS AS DICTATED BY THE CITY INSPECTOR. POT HOLE LOCATIONS NOT SHOWN ON PLAN REQUIRE SEPARATE PERMIT.

RUS LIST	EST QTY	ACT QTY
BM60(2-2)PD	823'	
BFOV(2)(2)OT	-	
BORE PIT	1	
BM73	5'	

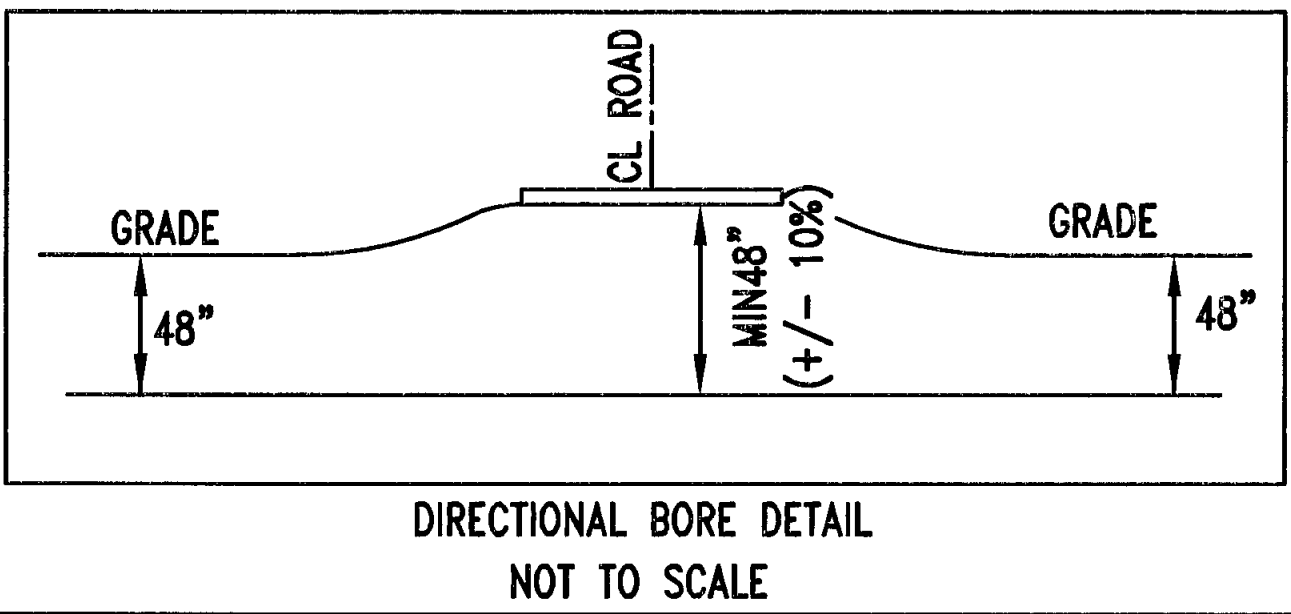

PAGE NARRATIVE:
 CONTINUE BORING NORTH ALONG N TORREY PINES DR A DISTANCE OF 823'.

PROJECT: _____

SEG/SPAN: _____ SEG

FROM _____ TO _____

SECTION: 11
 TOWNSHIP: 20S
 RANGE: 60E

TITLE: FIBER OPTIC CABLE ROUTE

N. TORREY PINES DR
 GOWAN RD TO CRAIG RD

REVISIONS

DATE	DESCRIPTION	INITIAL
3/14	CHANGE ALIGNMENT	JW
	PK 3-13-14	

MP _____ TO MP _____

SHEET 9 OF 11

DWG. NO. _____ CTL E.422282