



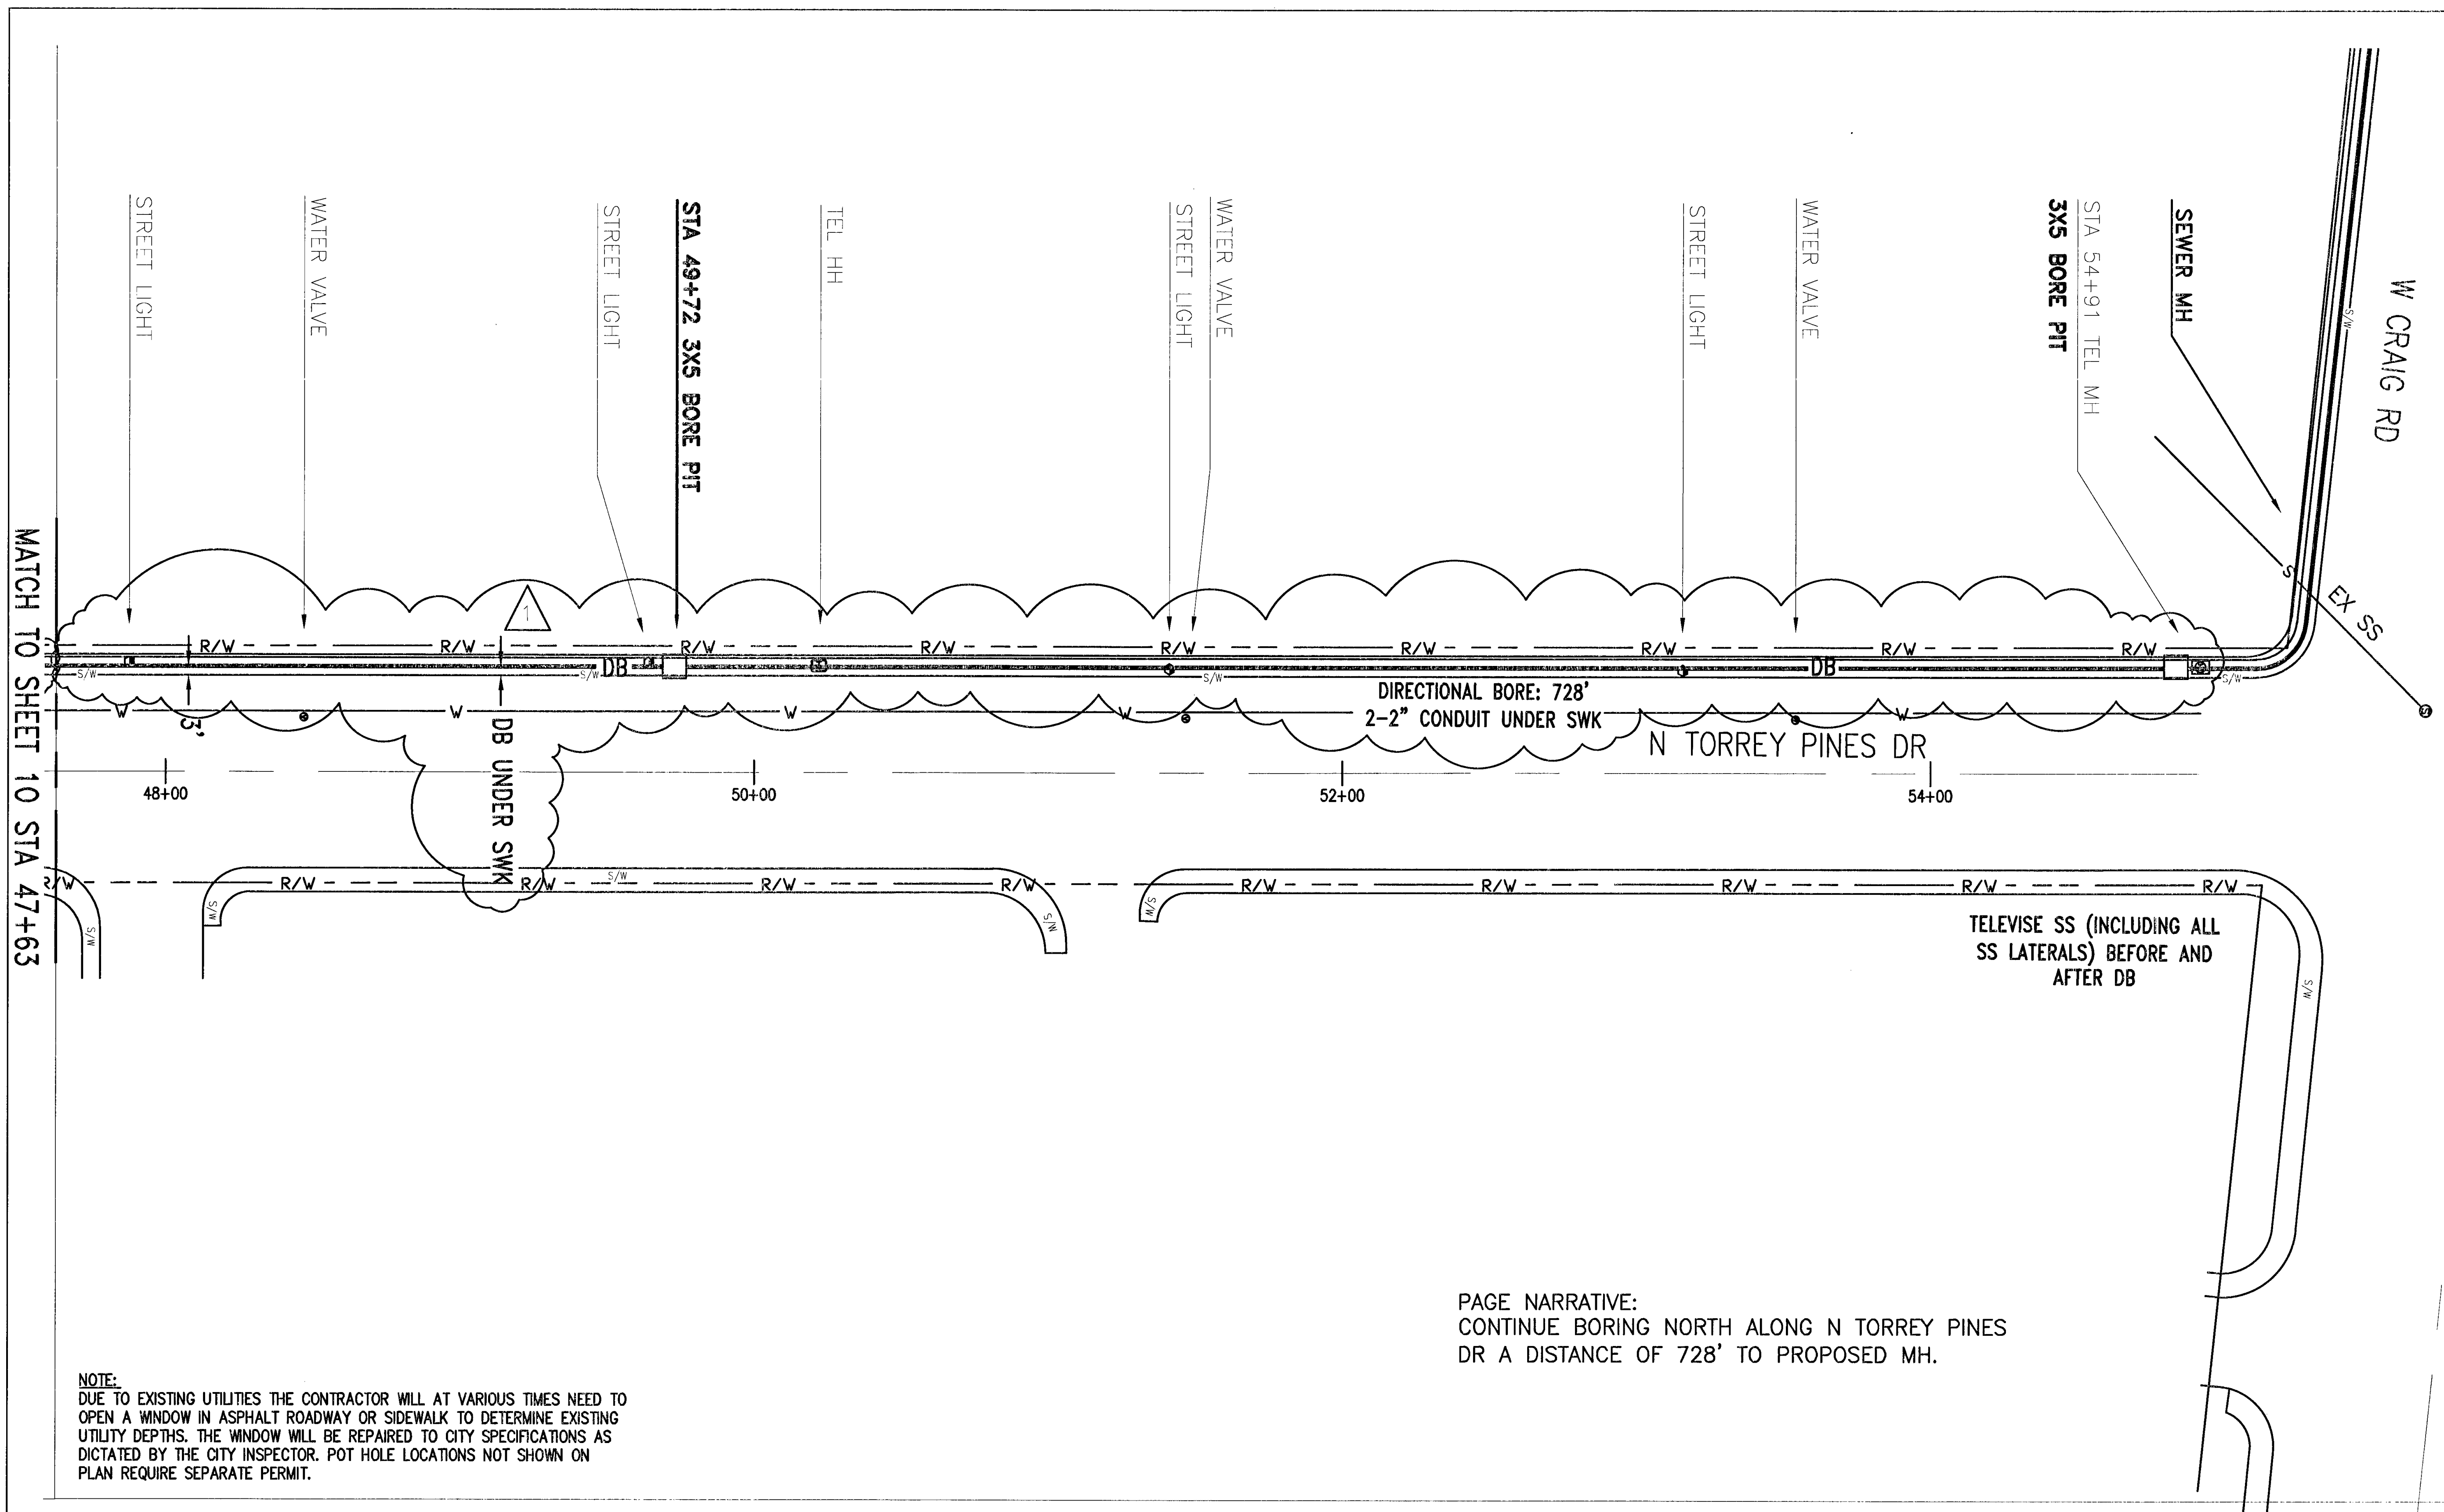


NOTE:
DUE TO EXISTING UTILITIES THE CONTRACTOR WILL AT VARIOUS TIMES NEED TO OPEN A WINDOW IN ASPHALT ROADWAY OR SIDEWALK TO DETERMINE EXISTING UTILITY DEPTHS. THE WINDOW WILL BE REPAIRED TO CITY SPECIFICATIONS AS DICTATED BY THE CITY INSPECTOR. POT HOLE LOCATIONS NOT SHOWN ON PLAN REQUIRE SEPARATE PERMIT.

RUS LIST	EST QTY	ACT QTY
BHF(30x60x30)T	-	
BM73A(12)	-	
BM60(2-2)PD	728	
BORE PIT	2	
BFOV(2)(2)OT	-	
BM73	10'	


PAGE NARRATIVE:
CONTINUE BORING NORTH ALONG N TORREY PINES DR A DISTANCE OF 728' TO PROPOSED MH.

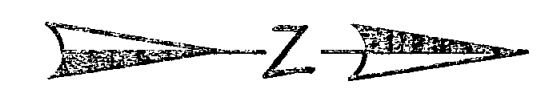

PROJECT: _____
SEG/SPAN: _____ SEG
FROM _____ TO _____
SECTION: 11/14
TOWNSHIP: 20S
RANGE: 60E

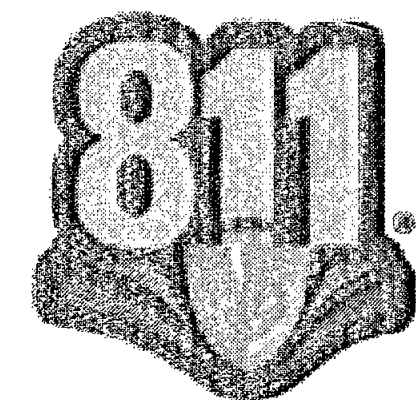

Know what's below.
Call before you dig.

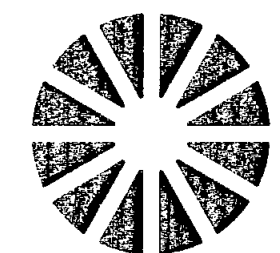

CenturyLink

TITLE: FIBER OPTIC CABLE ROUTE

N. TORREY PINES DR
GOWAN RD TO CRAIG RD

REVISIONS

DATE	DESCRIPTION	INITIAL
3/14	CHANGE ALIGNMENT PK 3-13-14	JW

MP TO MP

SHEET 11 OF 11

DWG. NO. CTL E.422282

REplot