



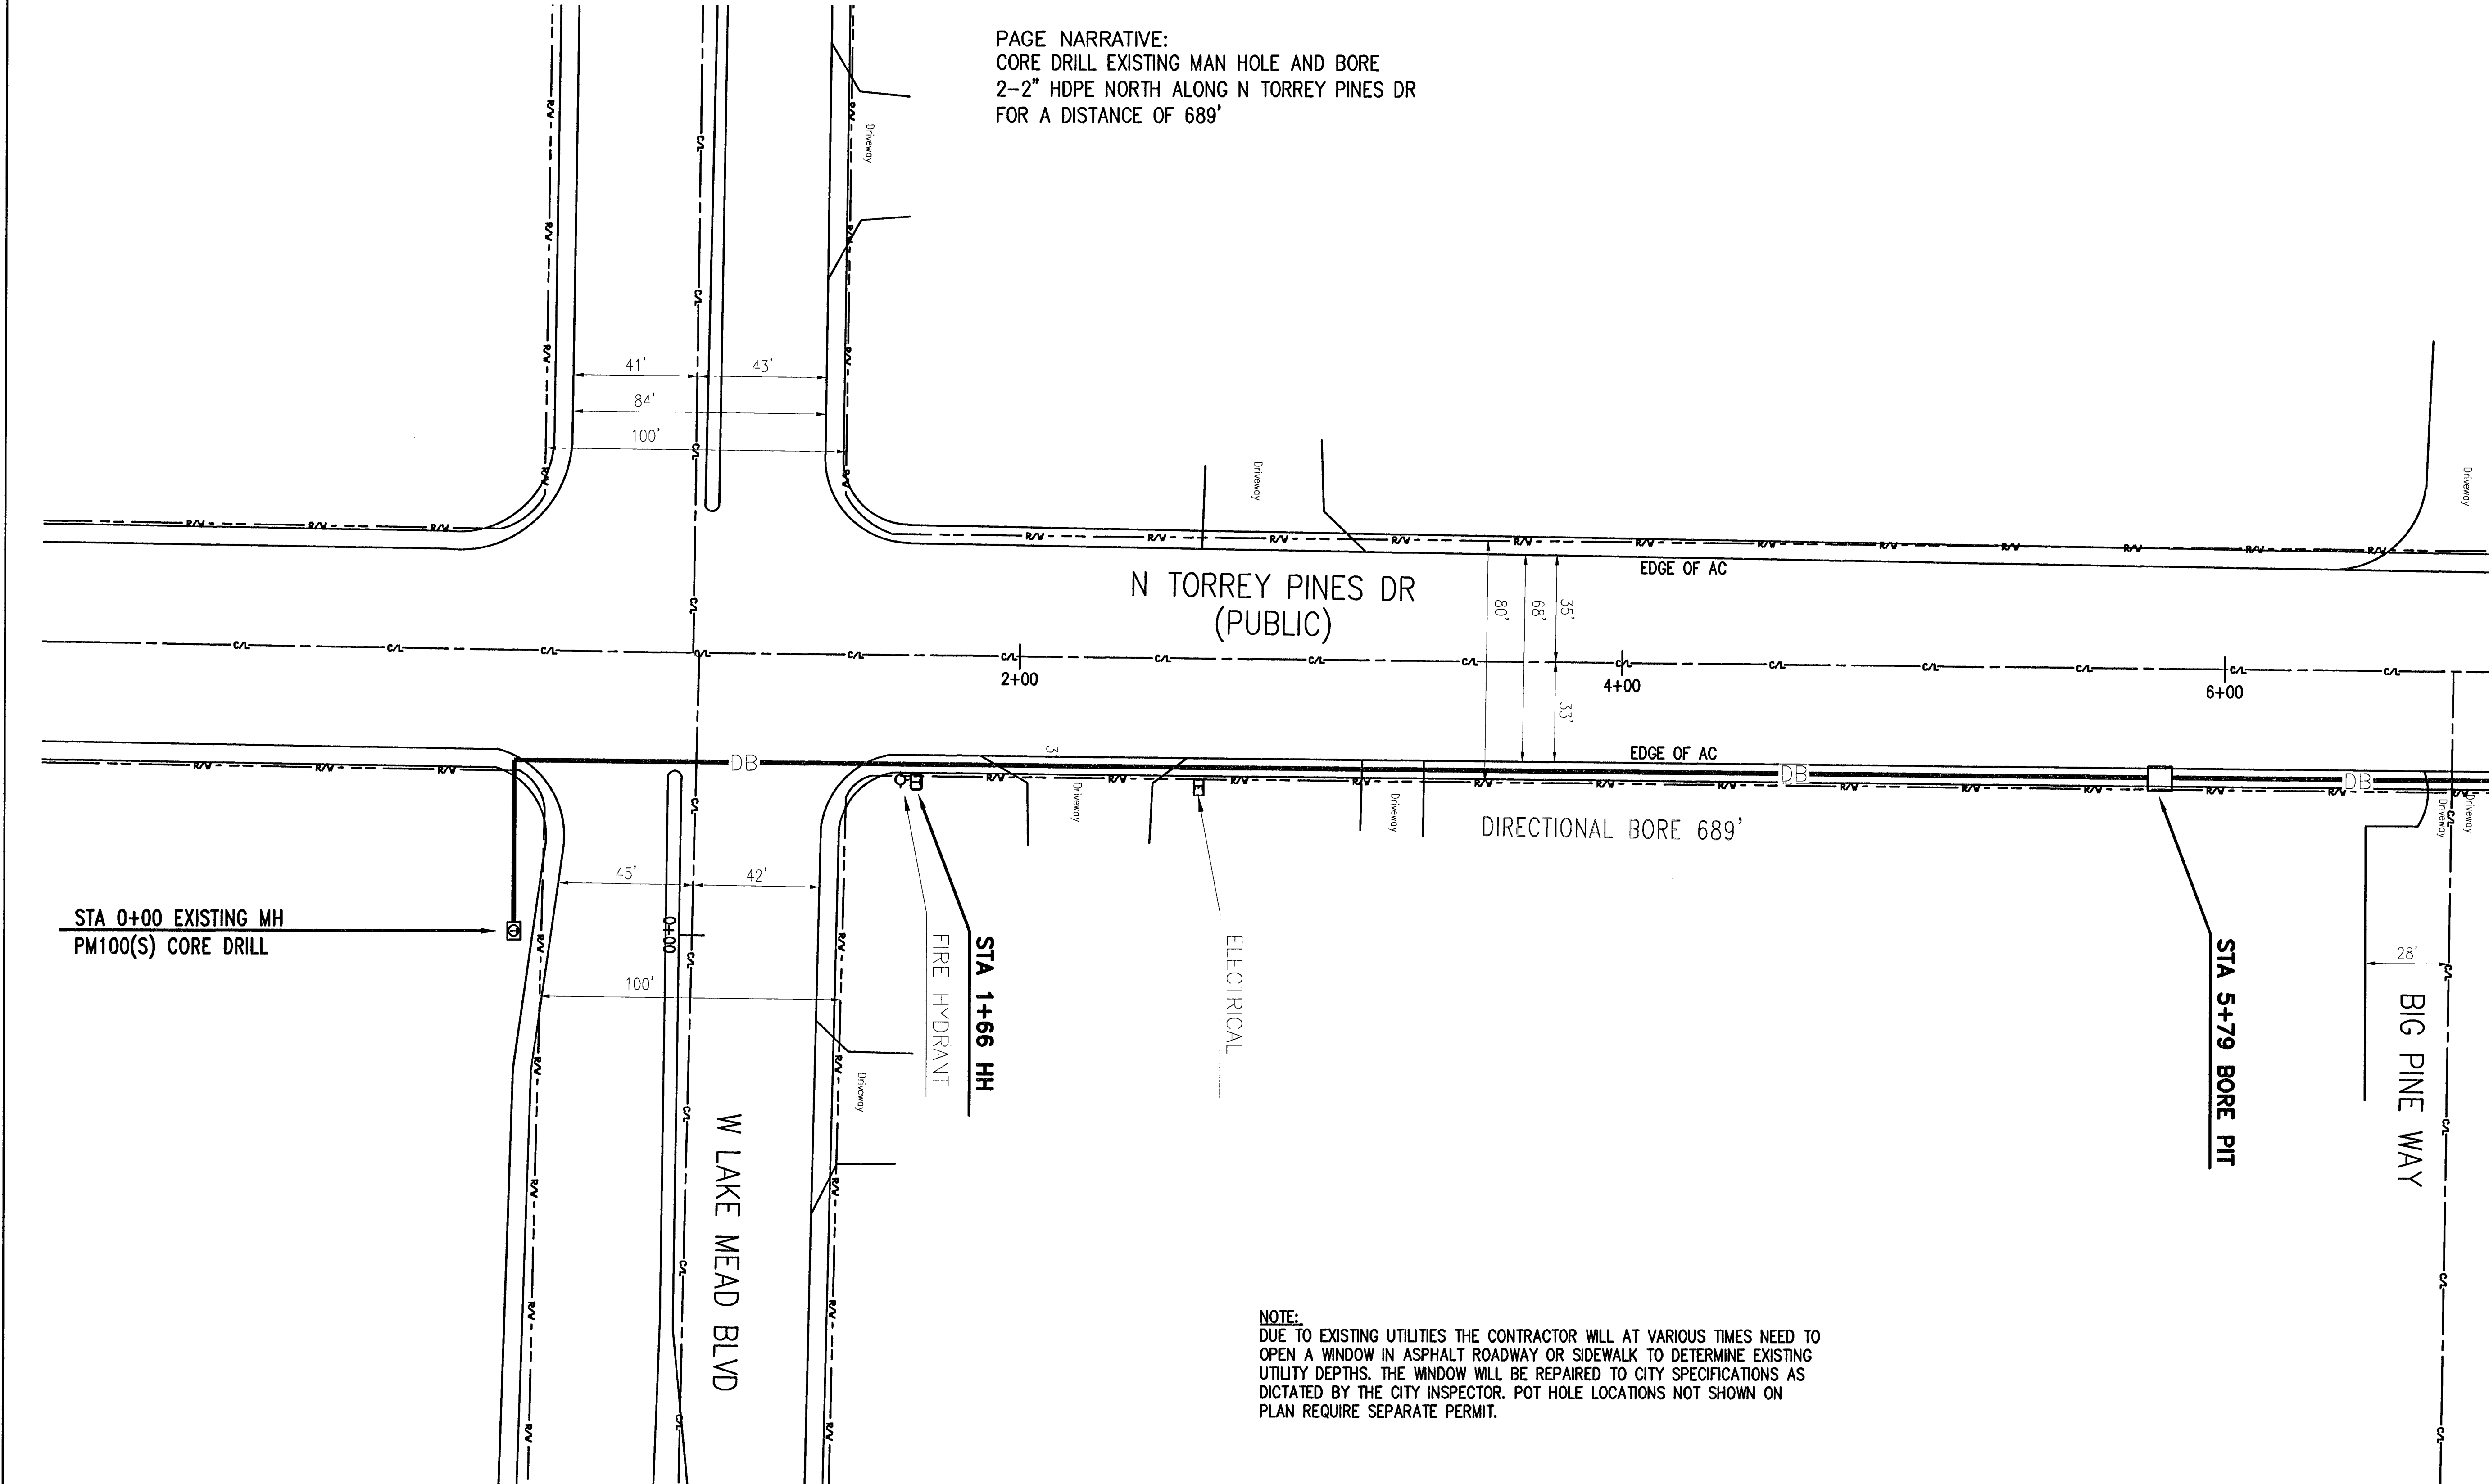

PAGE NARRATIVE:
CORE DRILL EXISTING MAN HOLE AND BORE
2-2" HDPE NORTH ALONG N TORREY PINES DR
FOR A DISTANCE OF 689'

NOTE:
DUE TO EXISTING UTILITIES THE CONTRACTOR WILL AT VARIOUS TIMES NEED TO
OPEN A WINDOW IN ASPHALT ROADWAY OR SIDEWALK TO DETERMINE EXISTING
UTILITY DEPTHS. THE WINDOW WILL BE REPAIRED TO CITY SPECIFICATIONS AS
DICTATED BY THE CITY INSPECTOR. POT HOLE LOCATIONS NOT SHOWN ON
PLAN REQUIRE SEPARATE PERMIT.

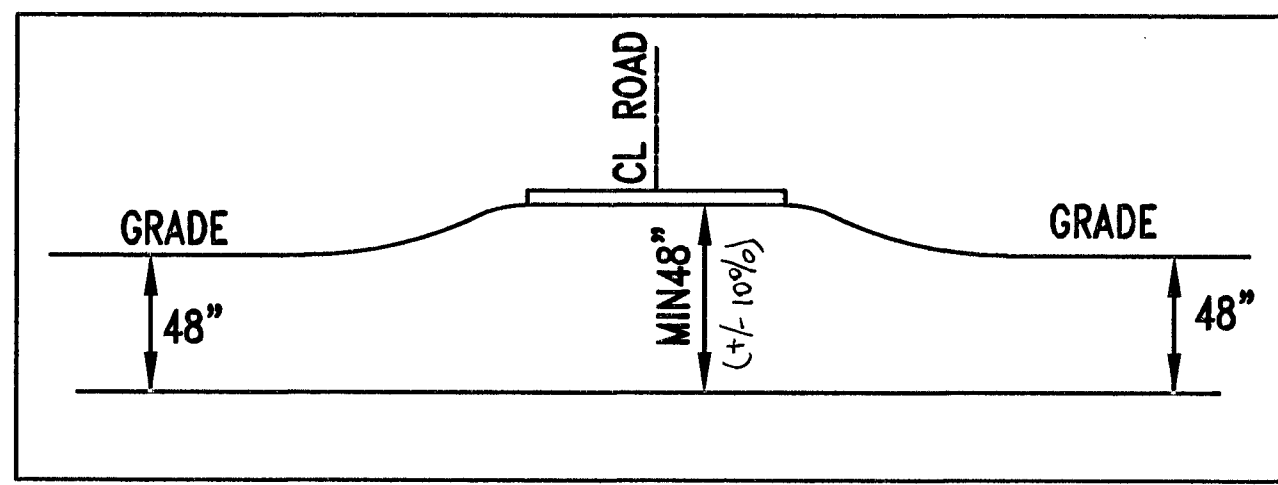

DIRECTIONAL BORE DETAIL
NOT TO SCALE

RUS LIST	EST QTY	ACT QTY
BM60(2-2)PD	689'	
BORE PIT	1	
BM73A	396'	

PROJECT: H# 52212

SEG/SPAN: SEG

FROM TO TO

SECTION: VARIES

TOWNSHIP: 20S

RANGE: 60E

Know what's below.
Call before you dig.

TITLE: FIBER OPTIC CABLE ROUTE

N. TORREY PINES DR.

W. LAKE MEAD TO PEAK DR.

REVISIONS

DATE	DESCRIPTION	INITIAL

SCALE: NONE

EXCEPT AS MAY BE OTHERWISE PROVIDED BY CONTRACT, THESE DRAWINGS AND SPECIFICATIONS SHALL REMAIN THE PROPERTY OF CENTURY LINK COMMUNICATIONS CORPORATION. BOTH BEING ISSUED IN STRICT CONFIDENCE AND SHALL NOT BE REPRODUCED, COPIED, OR USED FOR ANY PURPOSE WITHOUT SPECIFIC WRITTEN PERMISSION.

MP TO MP

SHEET 5 OF 11

DWG. NO. CTL E. 422282

MATCH TO SHEET 6 STA 6+89