



PAGE NARRATIVE:
CONTINUE BORE 2-2" HDPE NORTH
ALONG N TORREY PINES DR
FOR A DISTANCE OF 298' TO A PROPOSED
HAND HOLE, THEN CONTINUE BORE 517'.

MATCH TO SHEET 7 STA 23+17

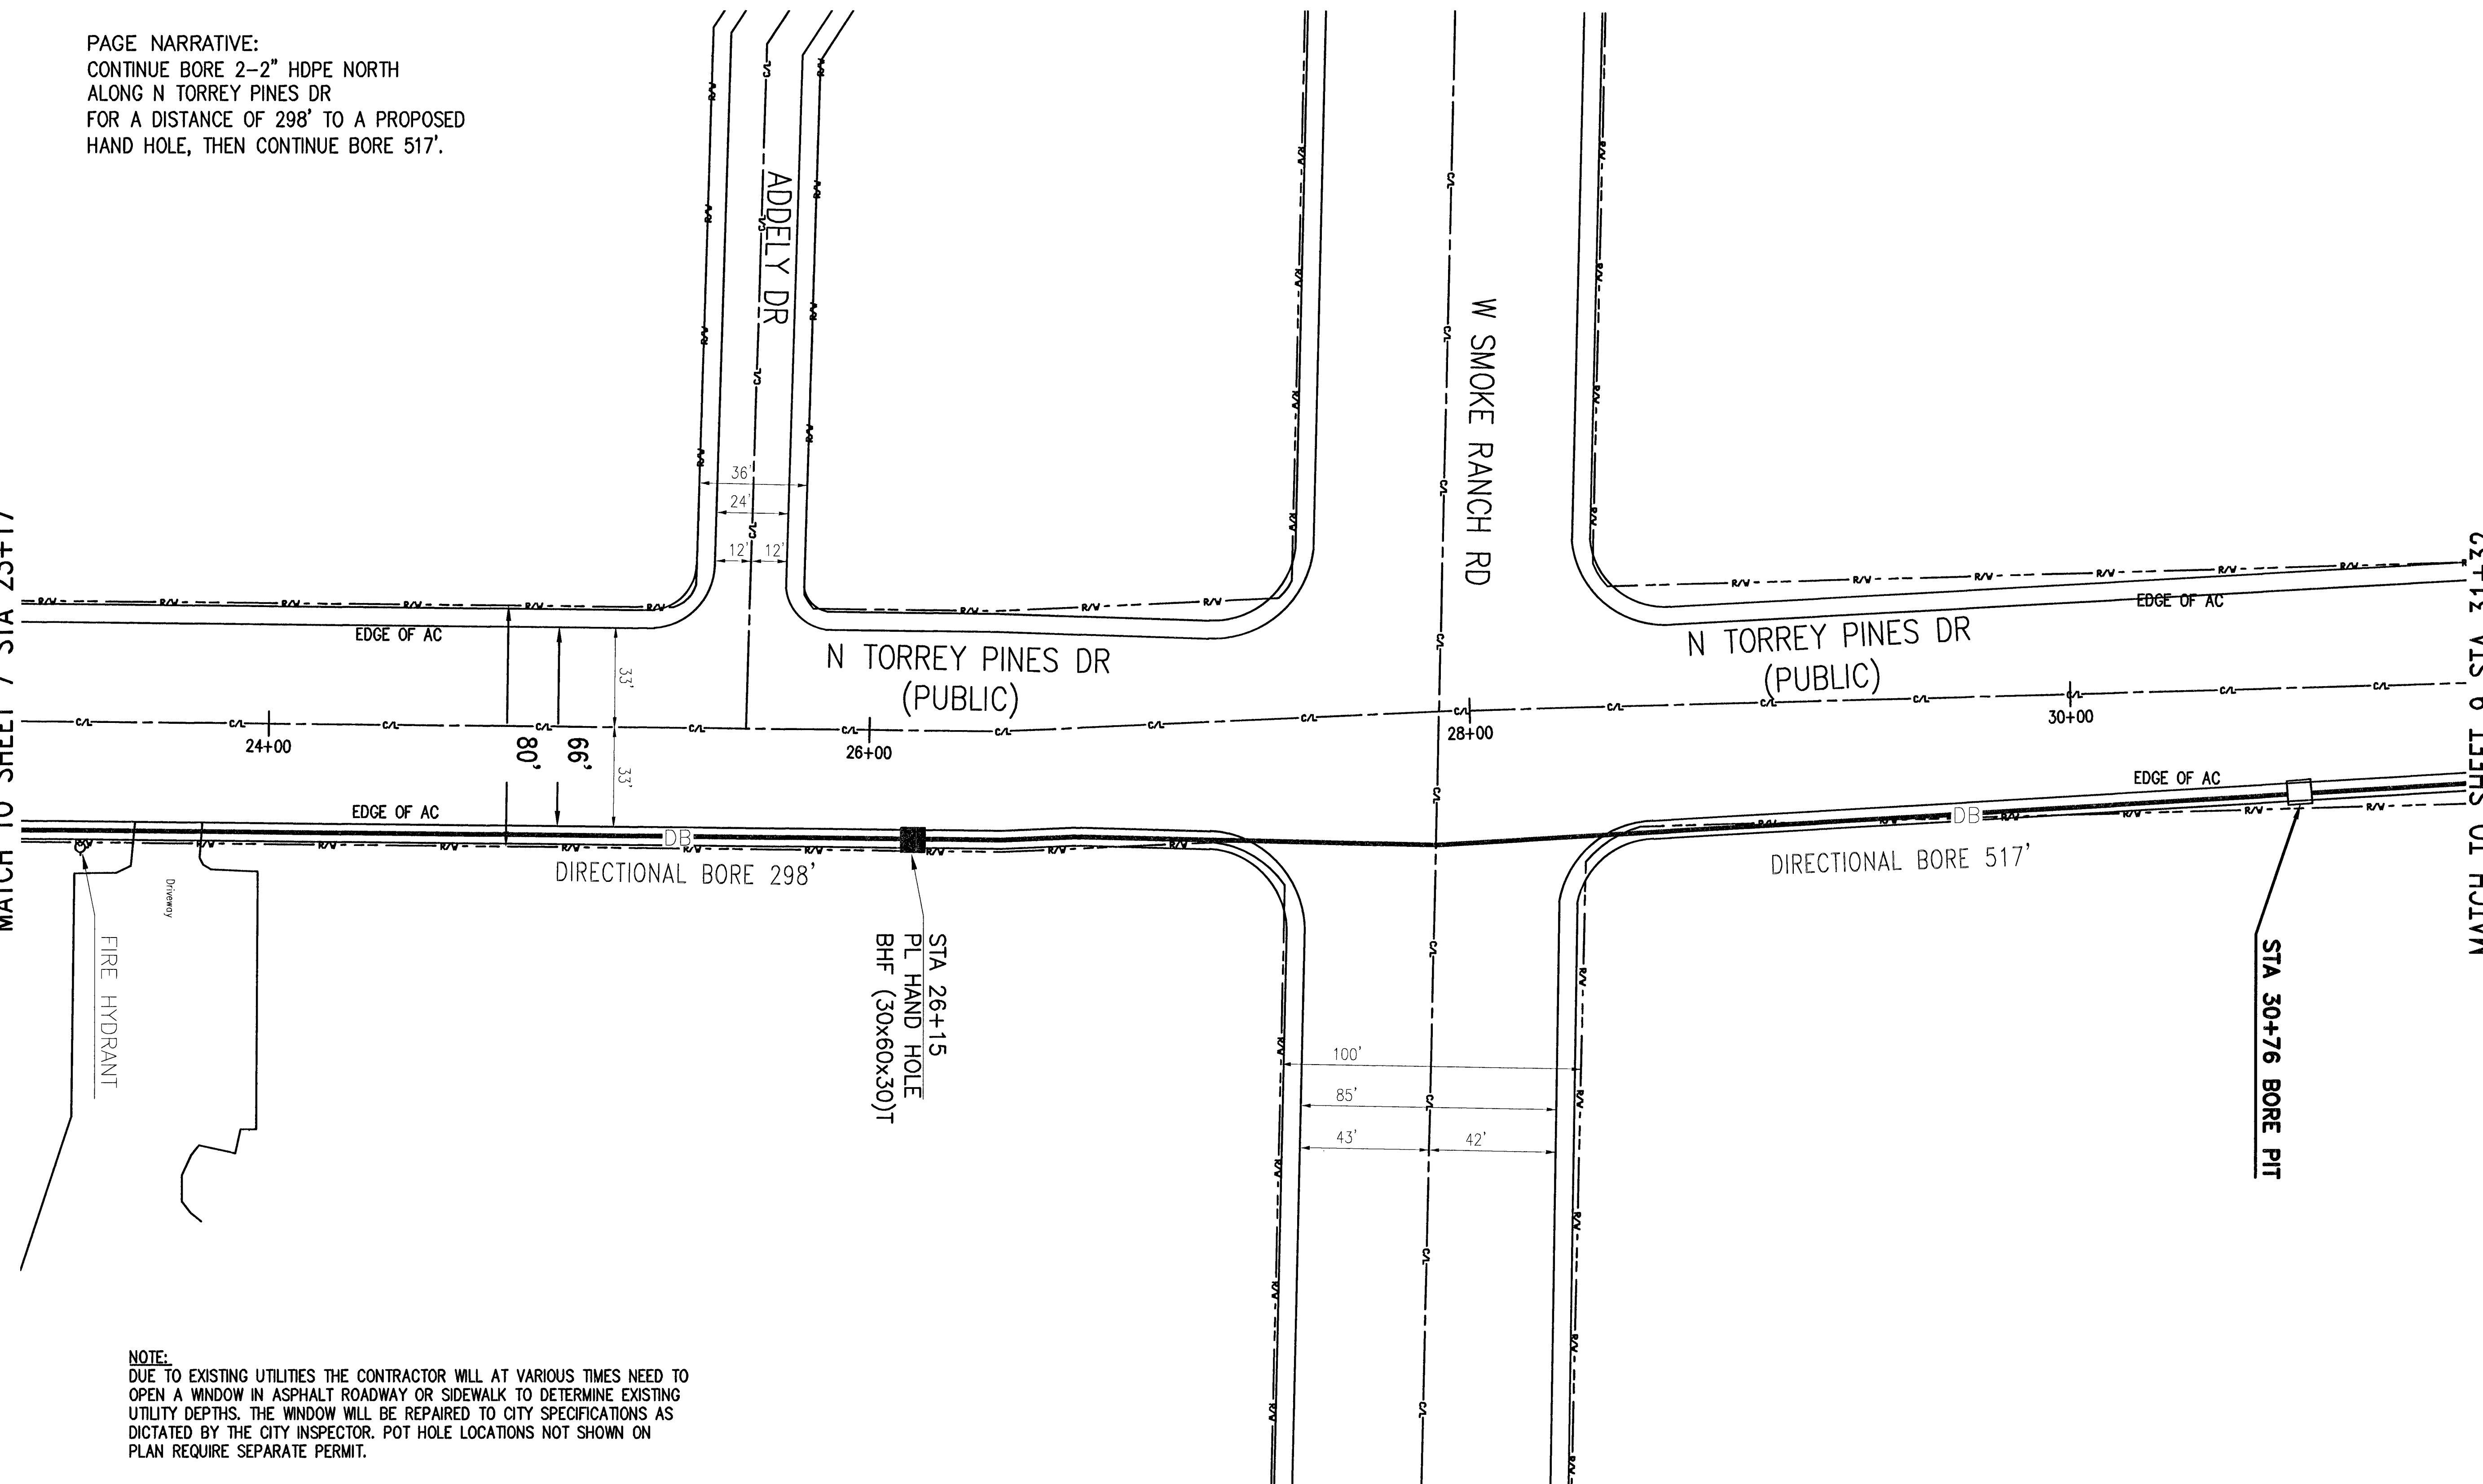


NOTE:
DUE TO EXISTING UTILITIES THE CONTRACTOR WILL AT VARIOUS TIMES NEED TO
OPEN A WINDOW IN ASPHALT ROADWAY OR SIDEWALK TO DETERMINE EXISTING
UTILITY DEPTHS. THE WINDOW WILL BE REPAIRED TO CITY SPECIFICATIONS AS
DICTATED BY THE CITY INSPECTOR. POT HOLE LOCATIONS NOT SHOWN ON
PLAN REQUIRE SEPARATE PERMIT.

RUS LIST	EST QTY	ACT QTY
BM60(2-2)PD	815'	
BORE PIT	1	
BHF(30x60x30)T	1	

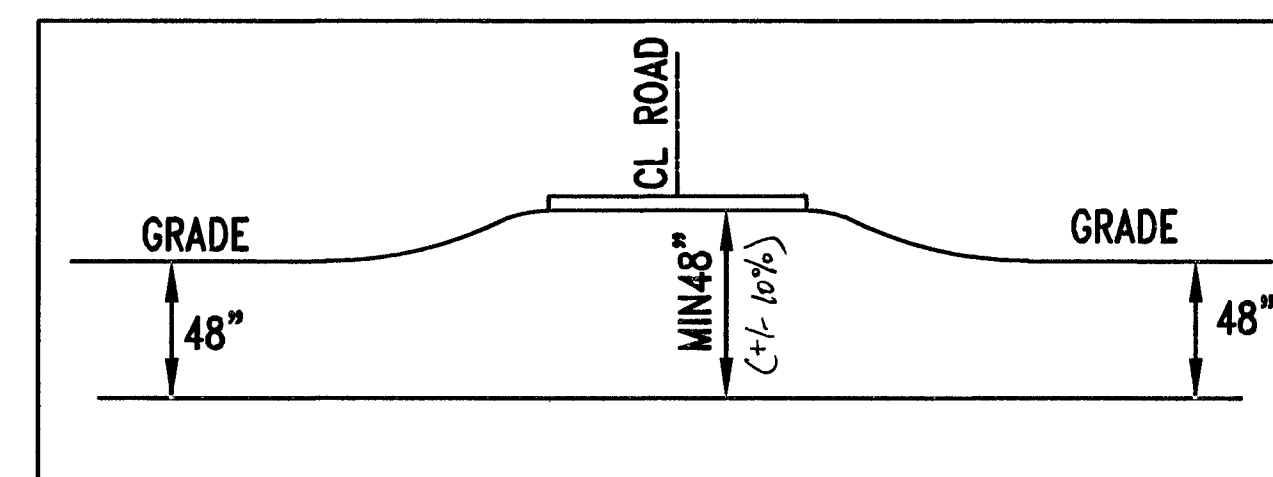

DIRECTIONAL BORE DETAIL
NOT TO SCALE

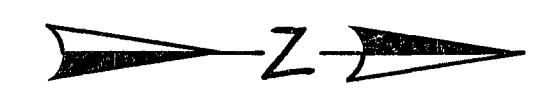

PROJECT: H# 52212


SEG/SPAN: SEG

FROM
TO
TO

SECTION: VARIES
TOWNSHIP: 20S
RANGE: 60E



Know what's below.
Call before you dig.

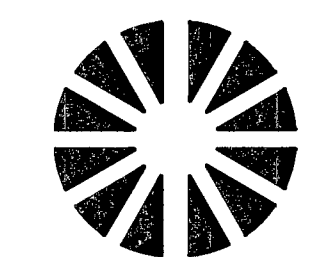

CenturyLink

TITLE: FIBER OPTIC CABLE ROUTE

N. TORREY PINES DR.

W. LAKE MEAD TO PEAK DR.

REVISIONS

DATE	DESCRIPTION	INITIAL

SCALE: NONE

EXCEPT AS MAY BE OTHERWISE PROVIDED BY CONTRACT, THESE
DRAWINGS AND SPECIFICATIONS SHALL REMAIN THE PROPERTY OF
CENTURY LINK COMMUNICATIONS CORPORATION. BOTH BEING ISSUED
IN STRICT CONFIDENCE AND SHALL NOT BE REPRODUCED, COPIED,
OR USED FOR ANY PURPOSE WITHOUT SPECIFIC WRITTEN
PERMISSION.

MP TO MP

SHEET 8 OF 11

DWG. NO. CTL E. 422282