
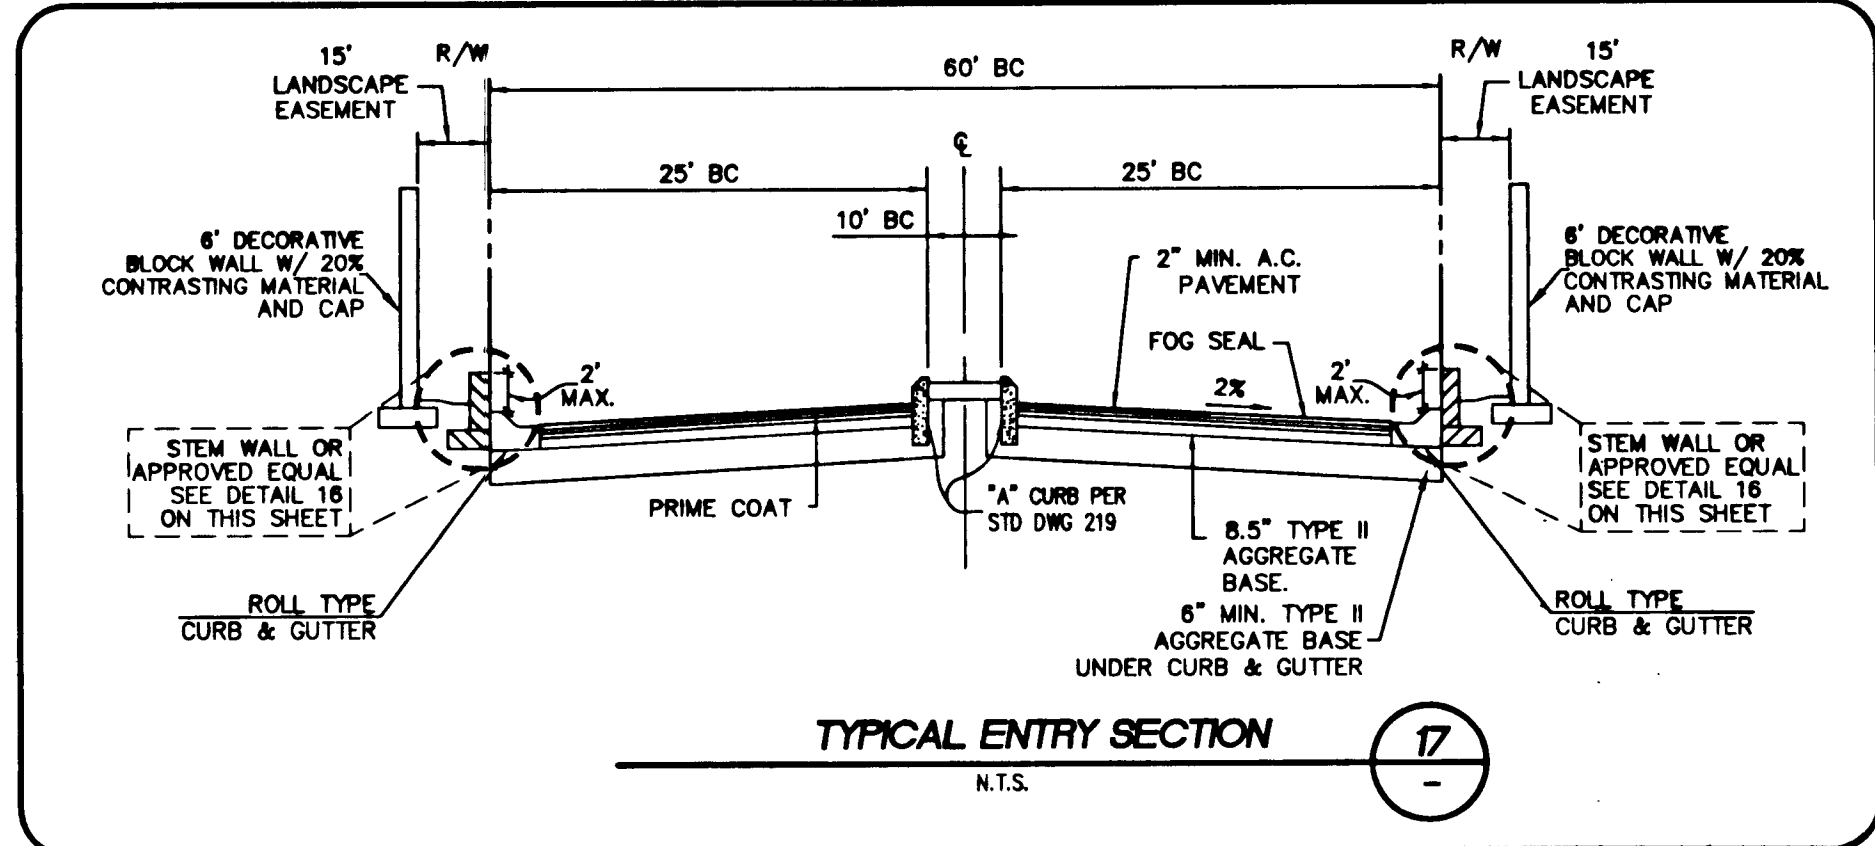
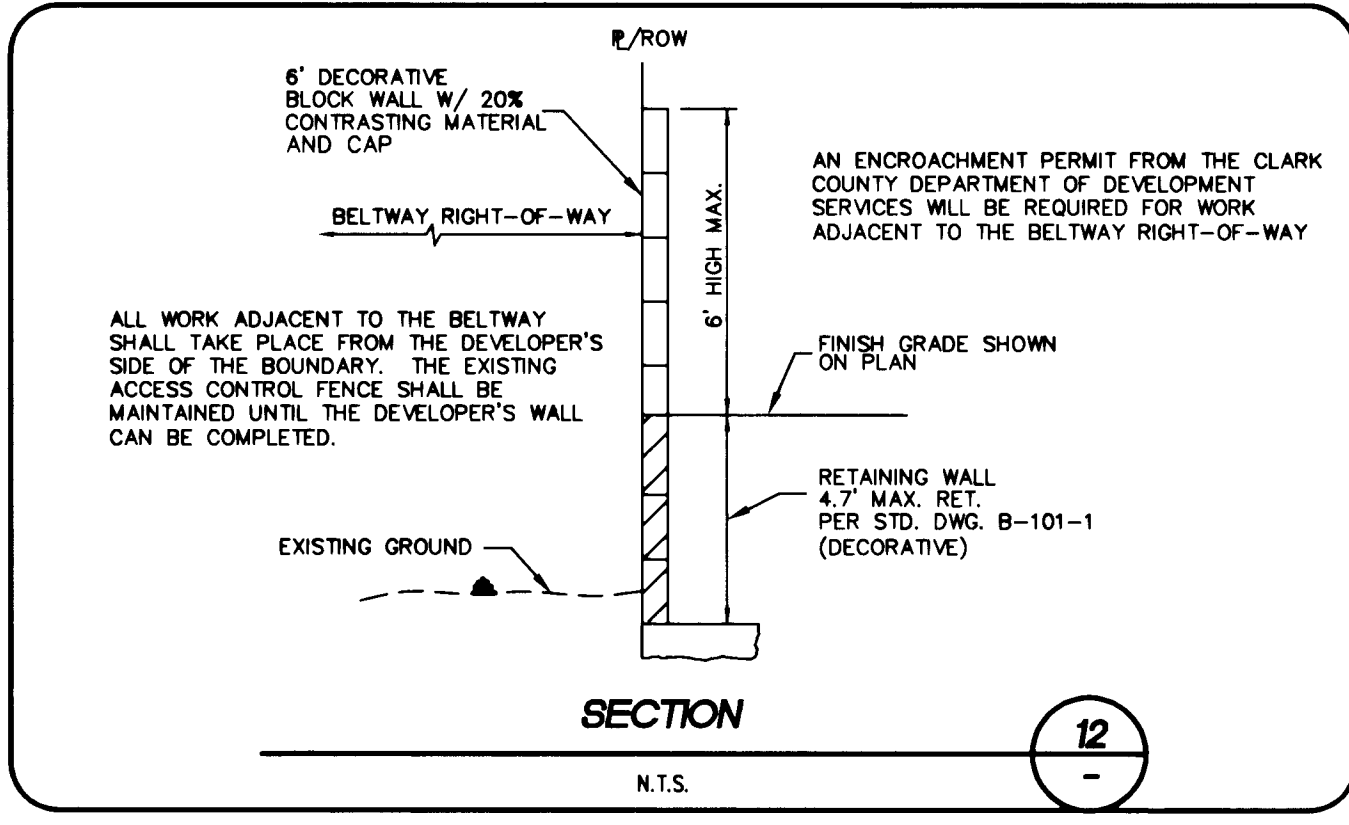
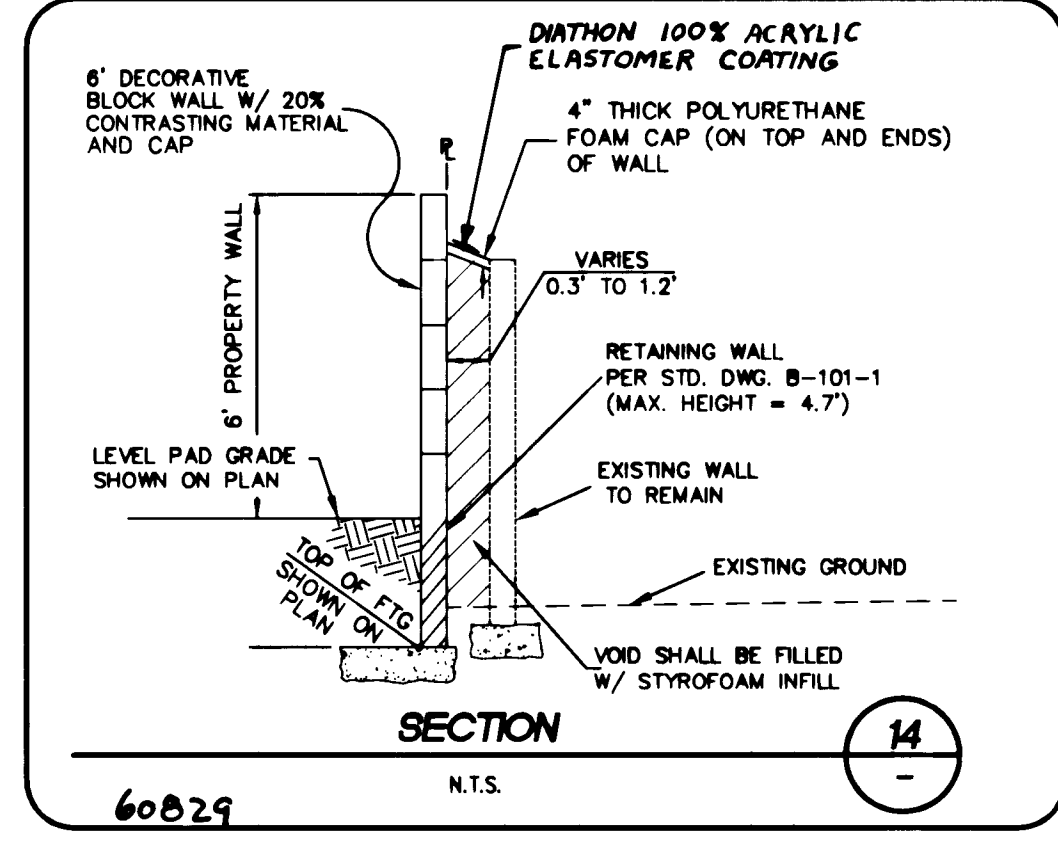
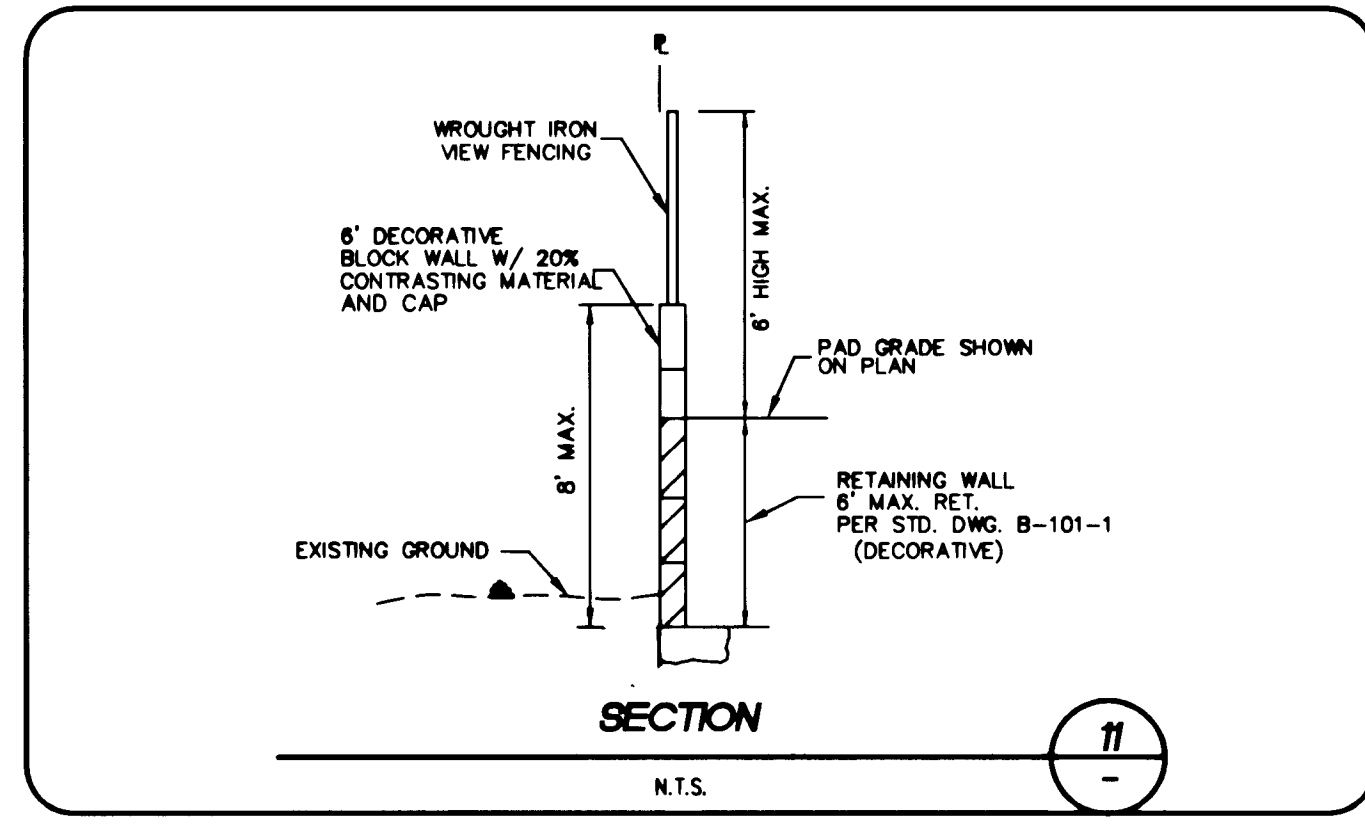
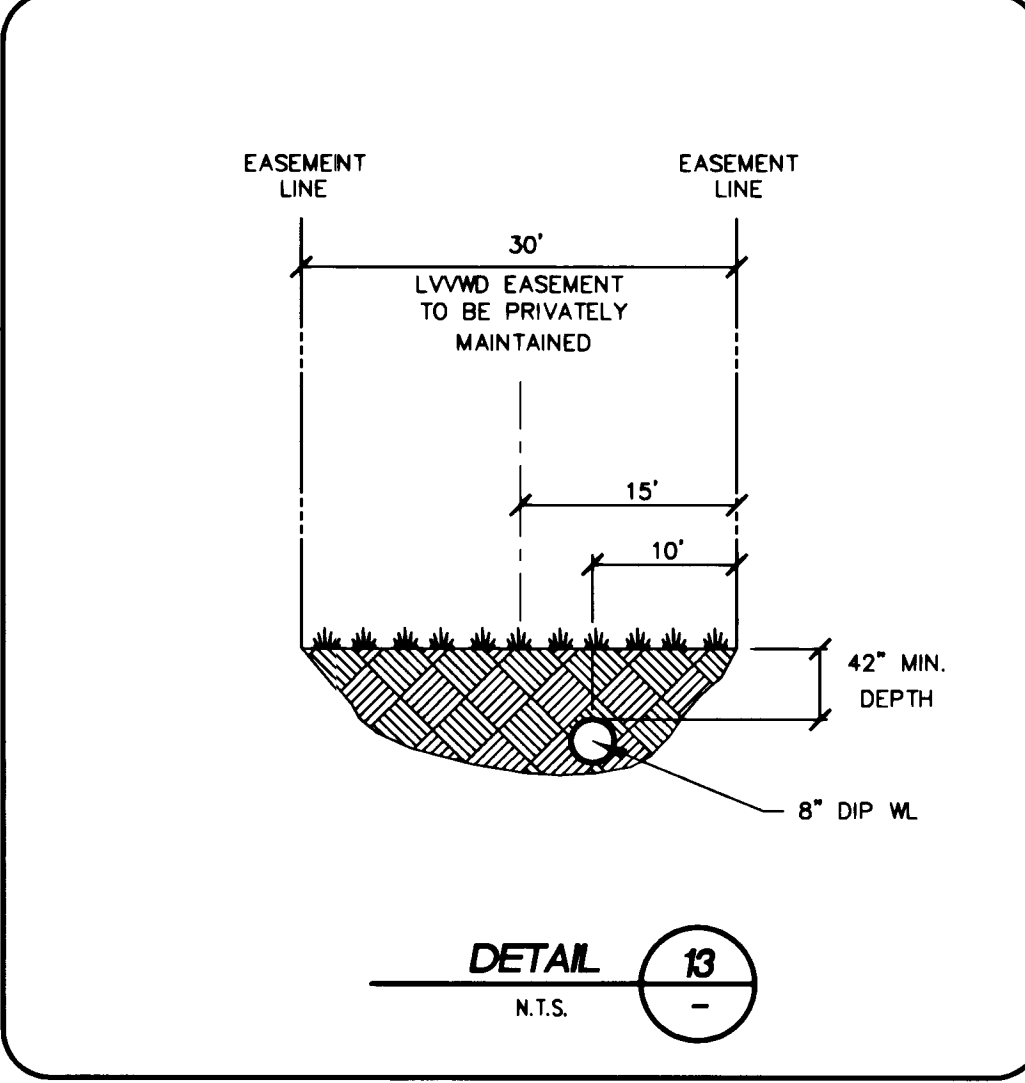
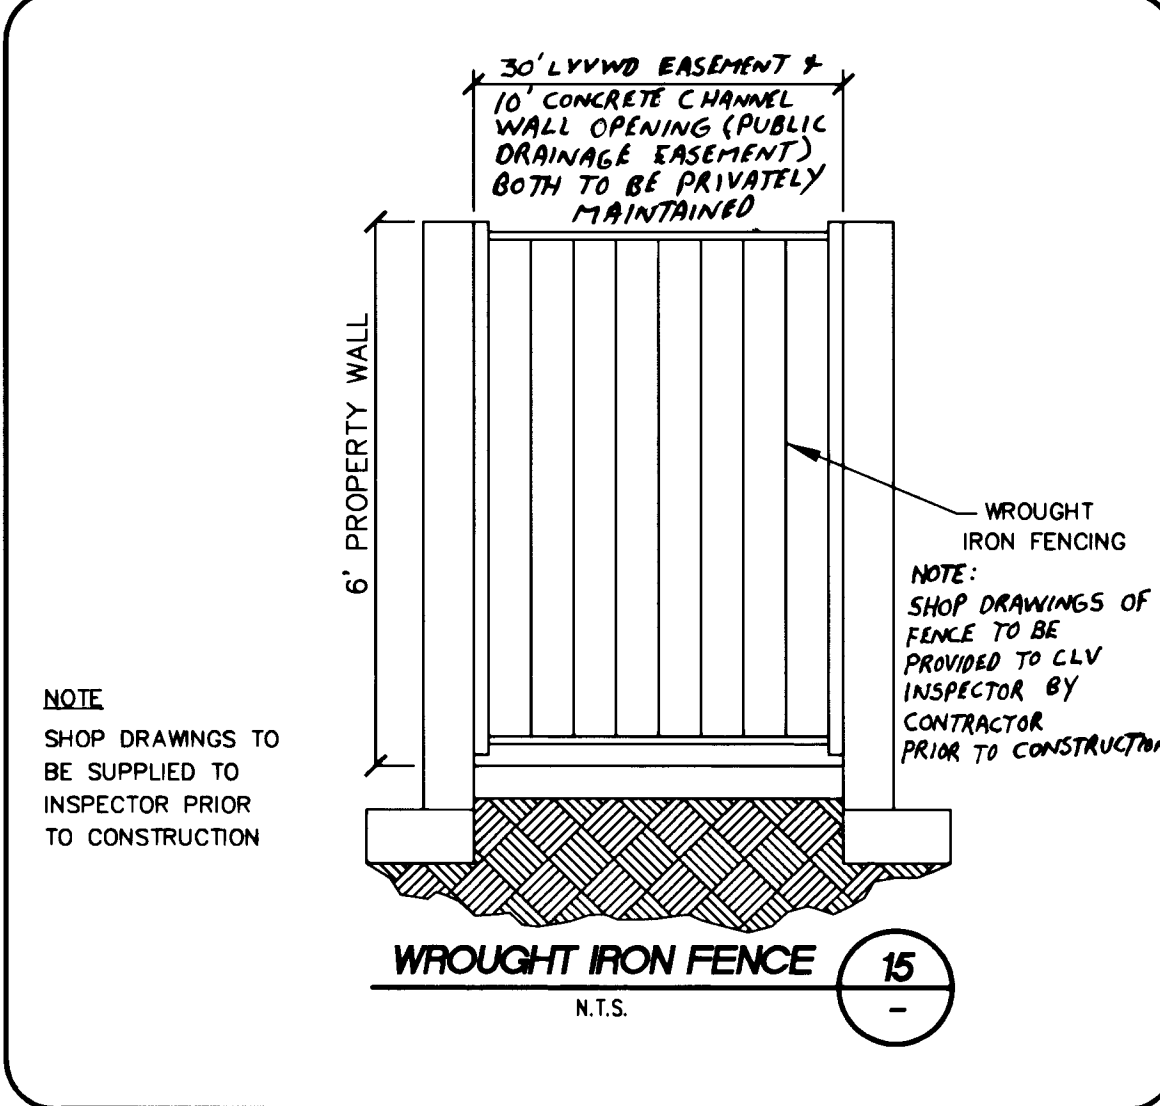
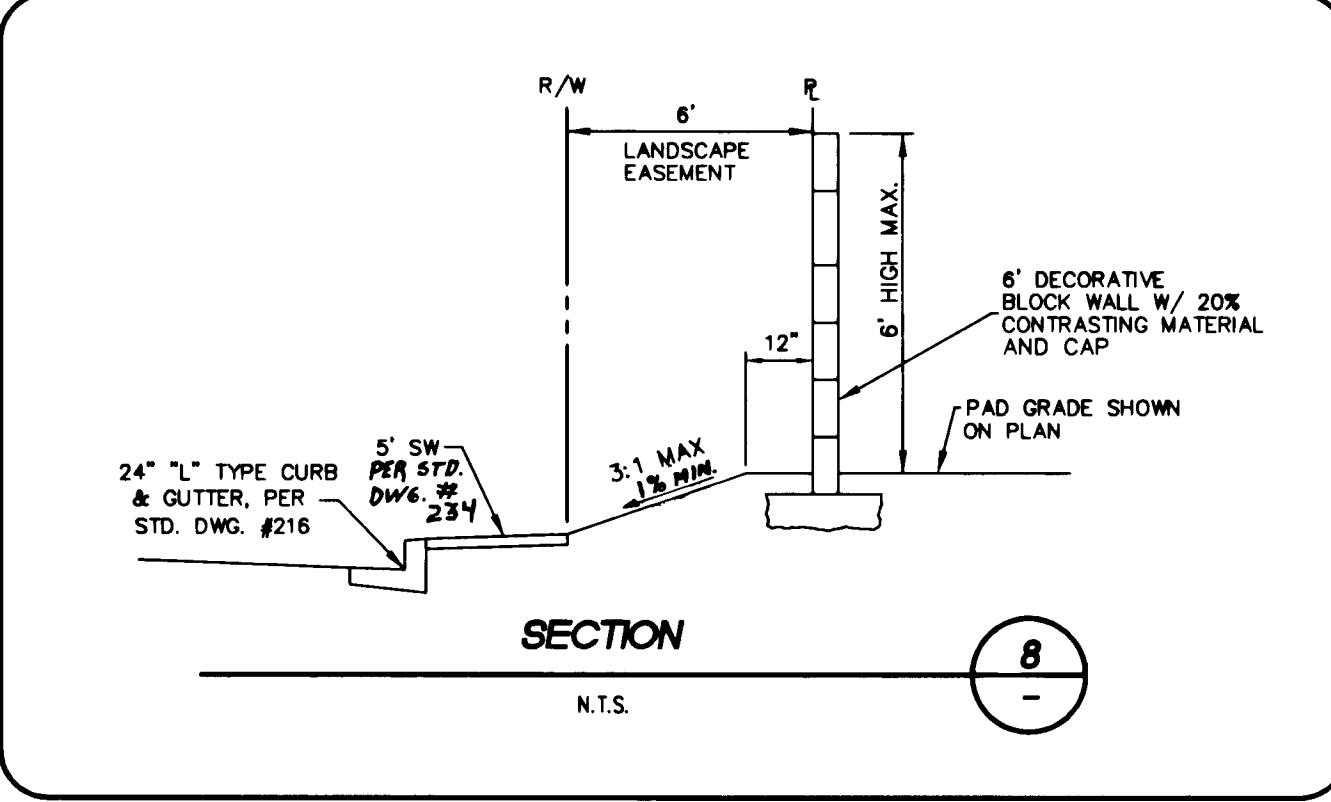
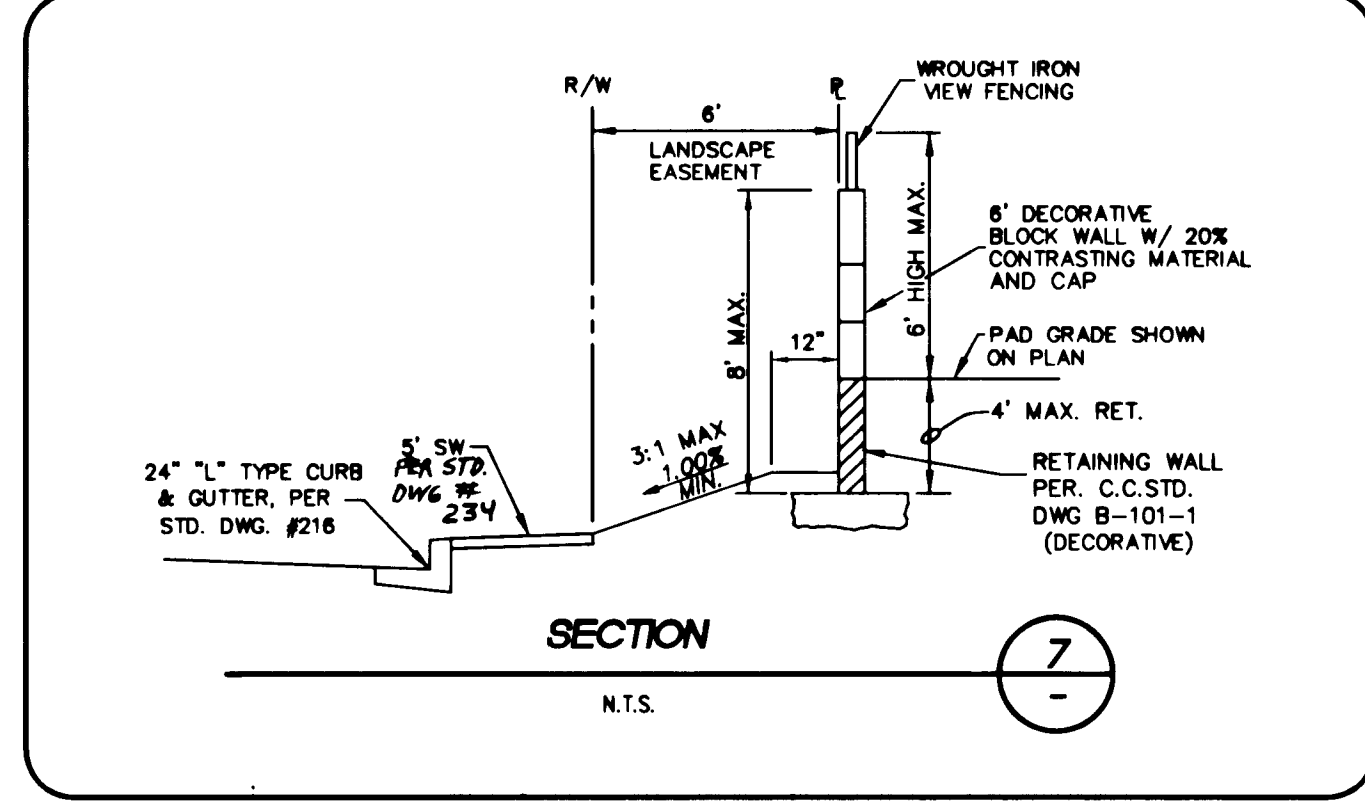
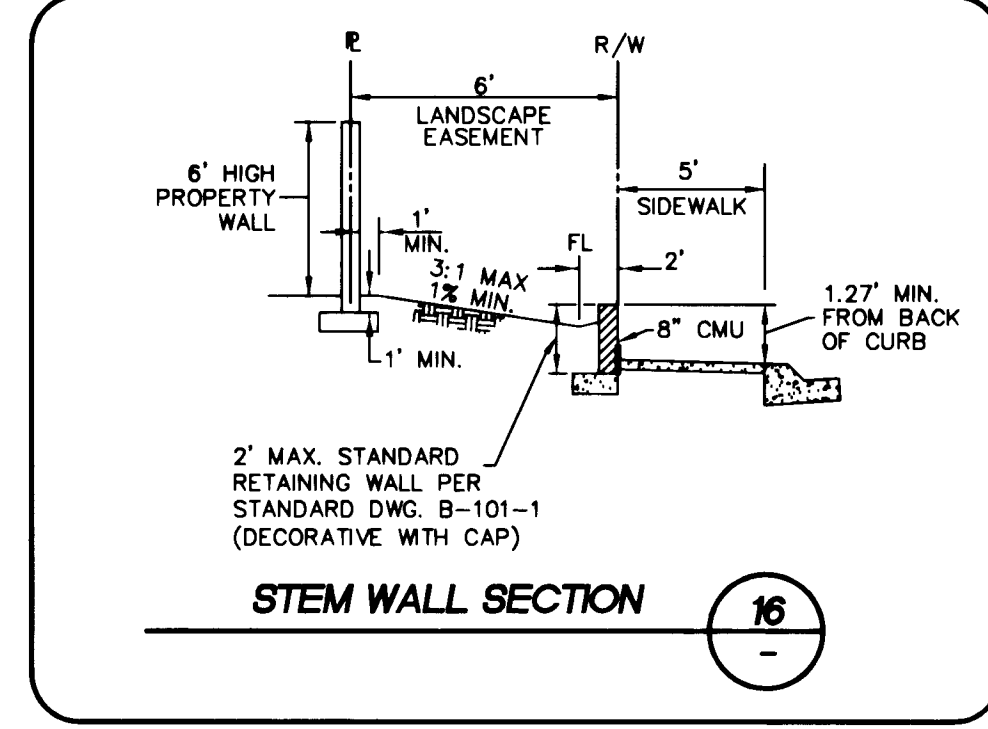
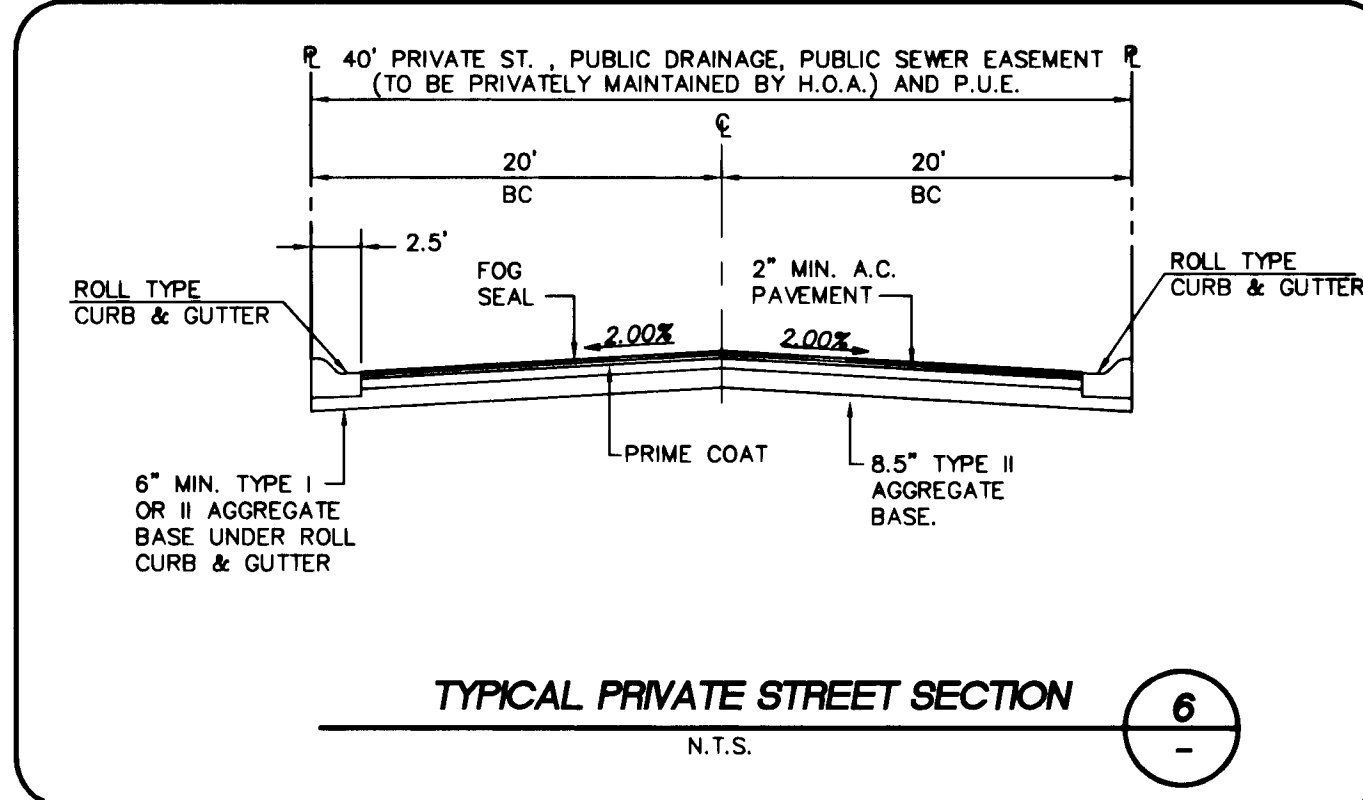
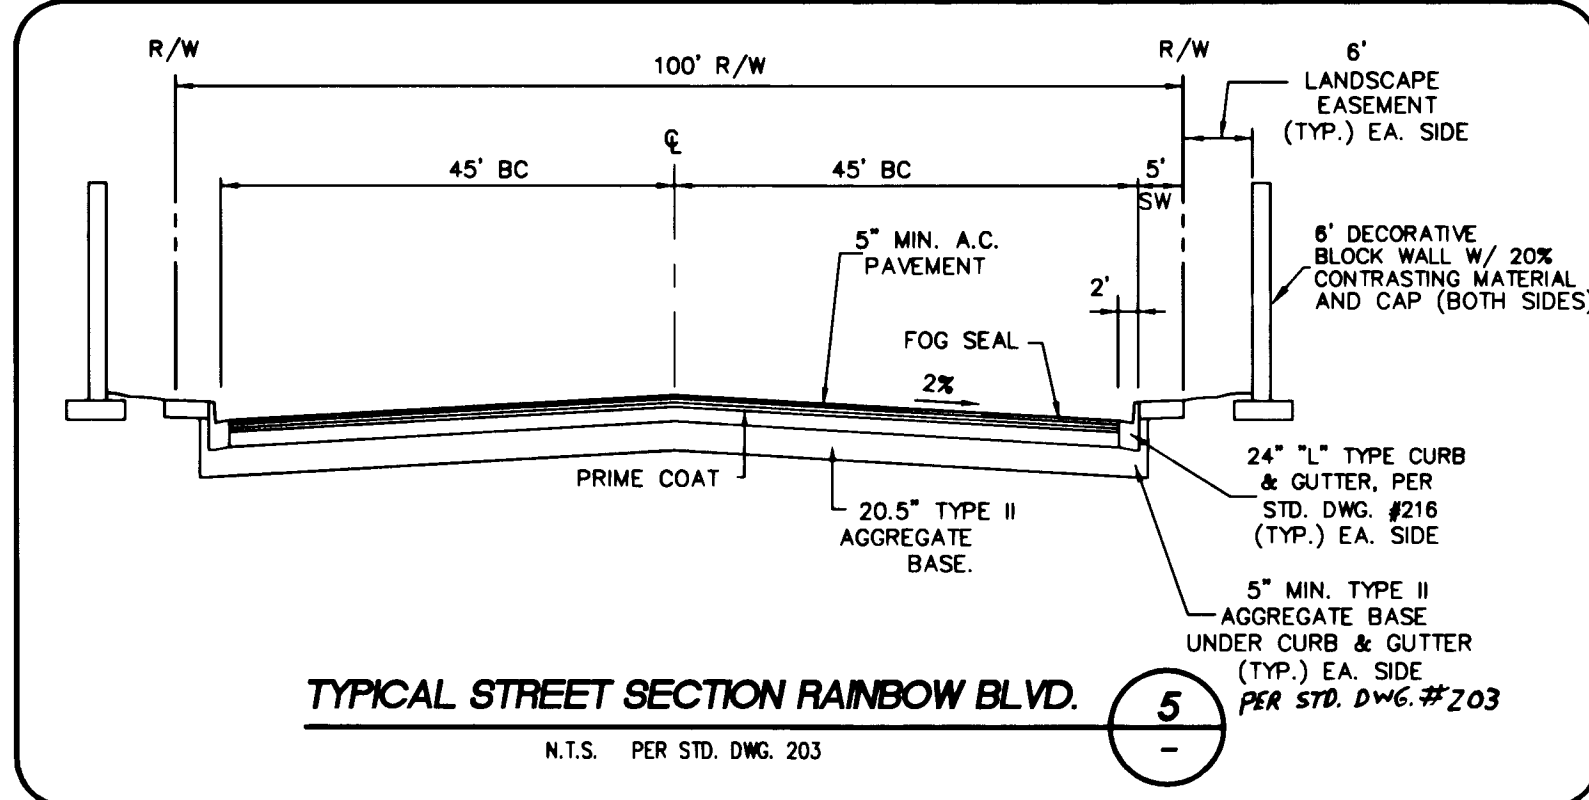
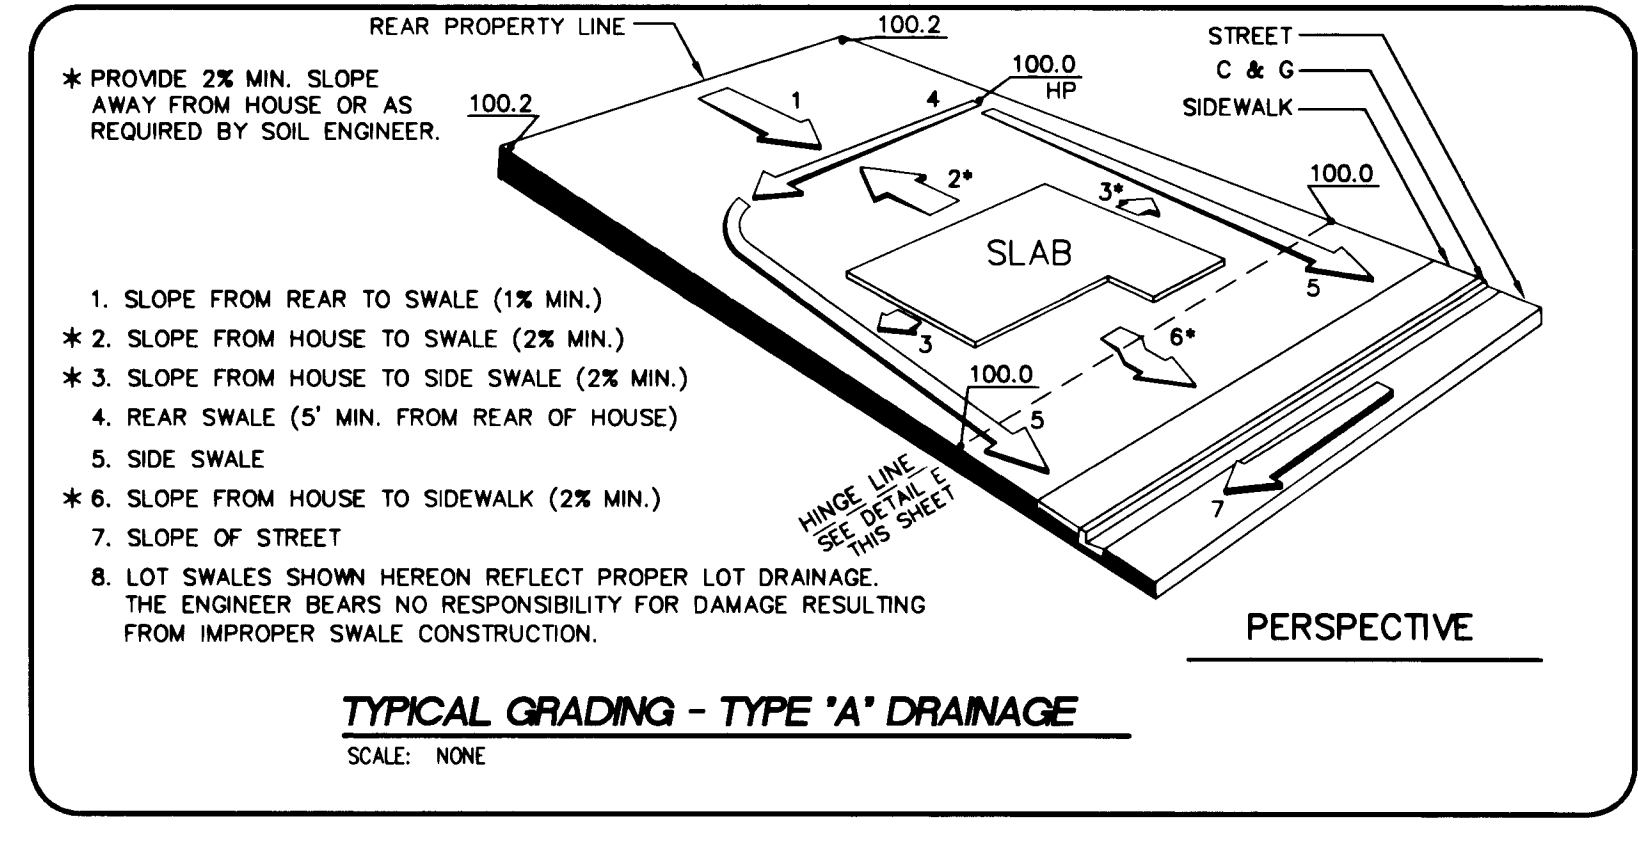
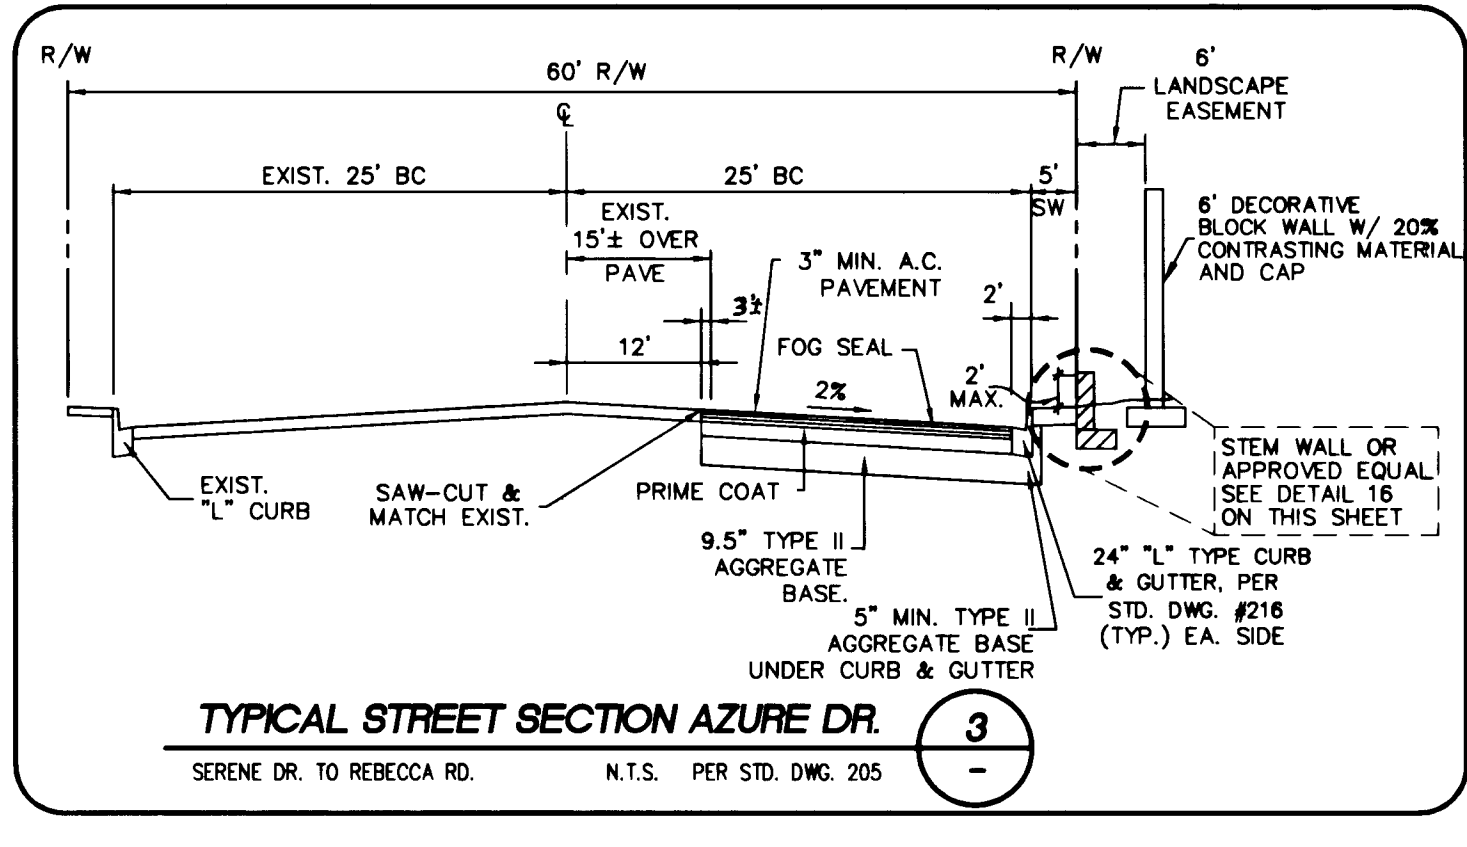


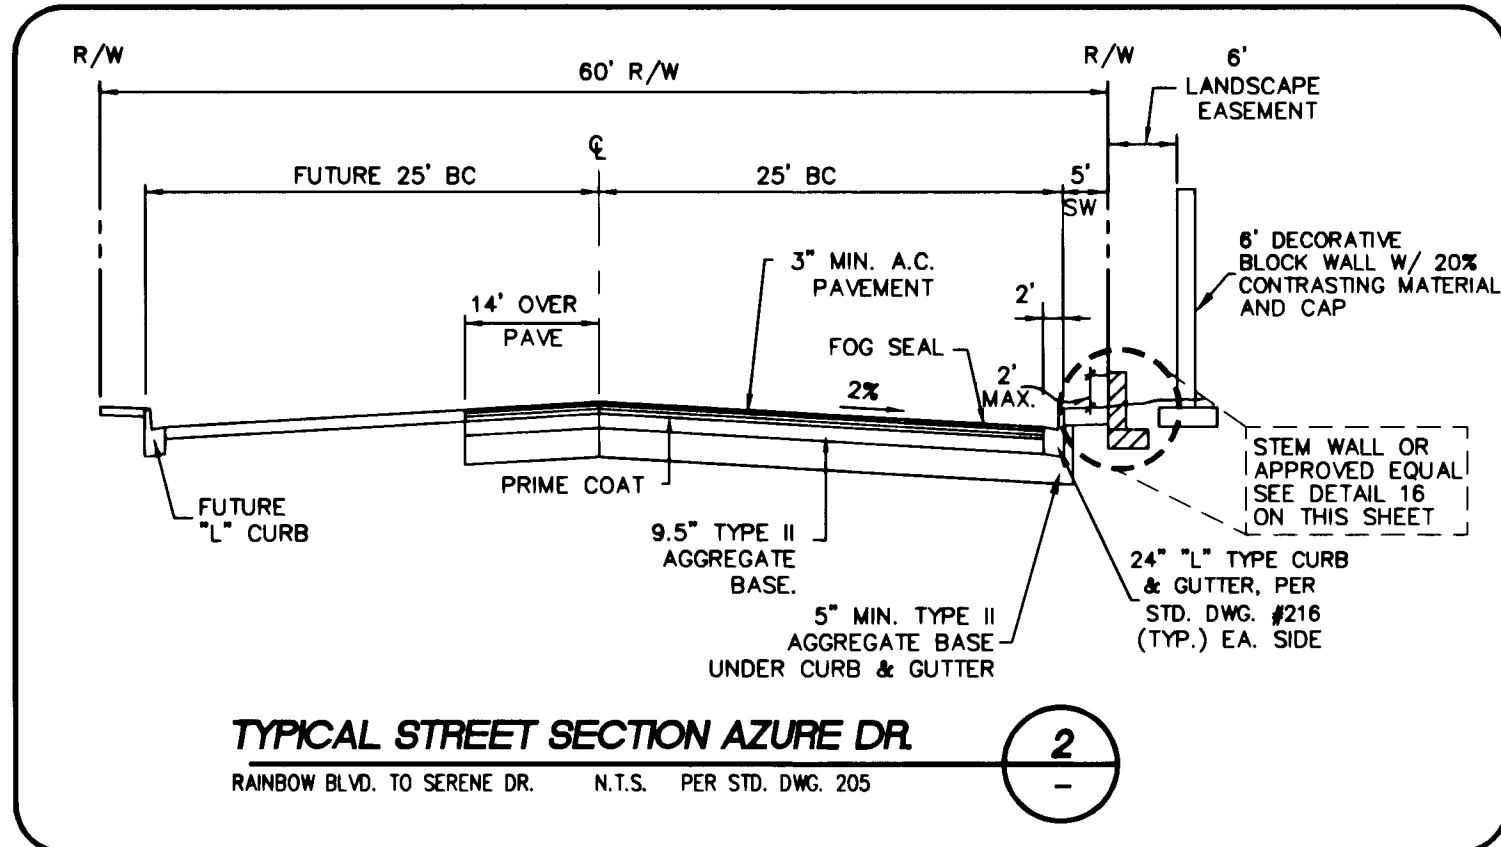

APPROVAL

11/6/03

LAS VEGAS VALLEY WATER DISTRICT

DATE

US HOME CORPORATION		LOCHSA ENGINEERING	
3765 EAST SUNSET BLVD., SUITE B-1		5828 SPRING MTN. RD. SUITE 308	
LAS VEGAS, NEVADA 89120		LAS VEGAS, NV 89146	
(702) 458-7700		PHONE: (702) 365-9312, FAX: (702) 365-9317	
DETAIL SHEET		TORREY PINES II	
DRAWN BY:	C. CRONQUIST	CHECKED BY:	M. VALPANDO
DATE:	6/25/03	DATE:	6/25/03
SHEET:	9	PROJECT No.:	9005
SHEET 9 OF 20		SCALE: 1"=30'	
DRAWING No. 10744780-1		SHEET No. 9	