
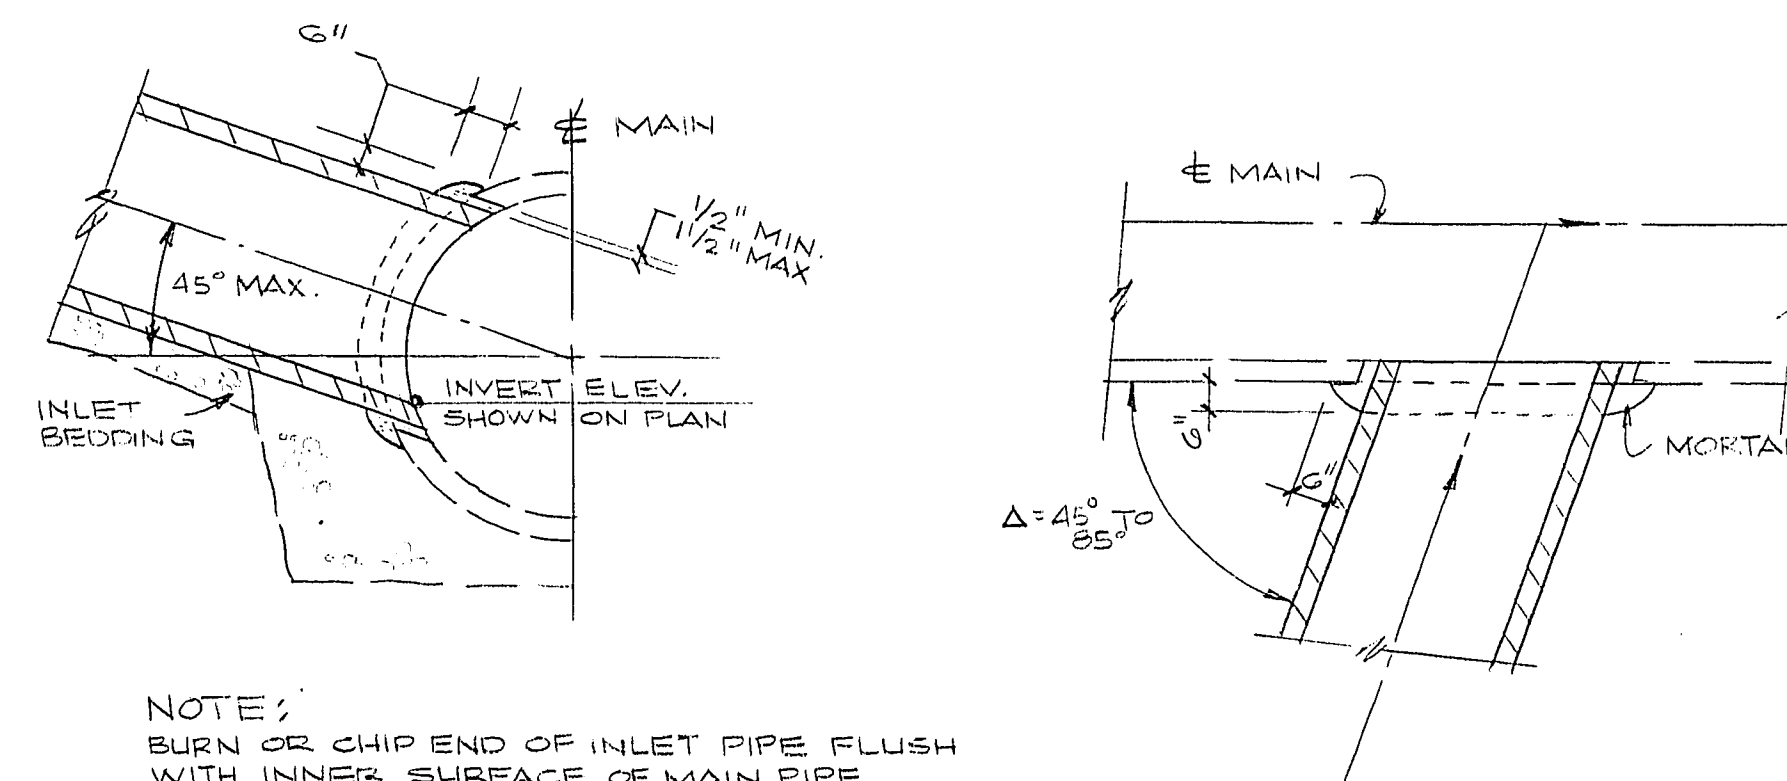


No.	Δ	P	L	T
135	$52^{\circ} 05' 54''$	$270.00'$	245.51	131.97
136	$09^{\circ} 45' 26''$	$620.00'$	105.22	52.74
137	$52^{\circ} 05' 54''$	$250.00'$	227.32	122.20
138	$110^{\circ} 02' 28''$	$400.00'$	104.80	52.53
139	$32^{\circ} 43' 20''$	$230.00'$	131.35	67.52
140	$09^{\circ} 57' 52''$	$280.00'$	40.00	20.05
141	$08^{\circ} 17' 43''$	$380.00'$	83.97	42.06
A	$180^{\circ} 00' 00''$	$2.50'$	7.86	-

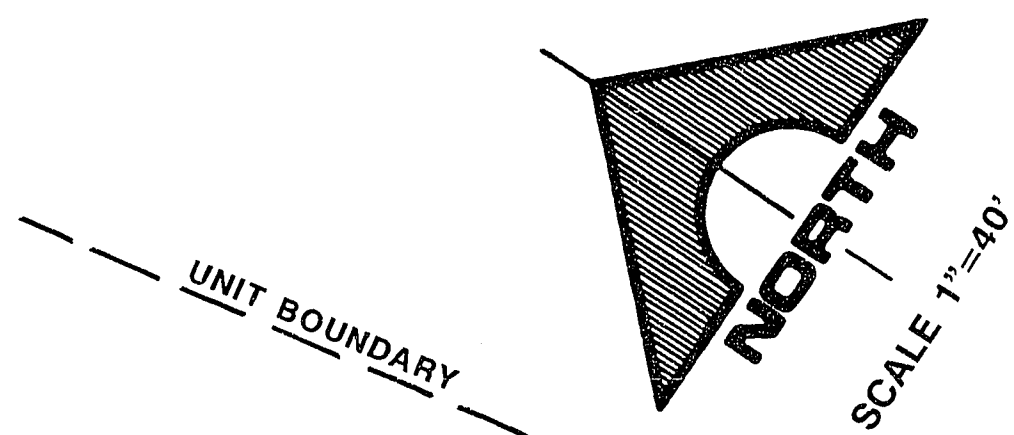

2' CONG. BAND SEE NOTE 1 (TYP.)

5' SPECIAL PAVING SEE NOTE 2

2' CONG. BAND

A.C. PAVE

6' MIN. TYPE 2, G.E.

THICKENED EDGE REC STD. DRG C-18 (TYP.)

FOR NOTES & DETAILS - SEE SPECIAL PAVING DETAIL - SHT. 1-1

DEL. SAWCUT TYPE 'C' JOINT PER STD. DWG 504, 4 PLACES

PAVING - SEE NOTE 2

8' 0"

12" CURB • GUTTER

6"

1/4" EXPAN. JT.

WHEEL CHAIR RAMP (BY OTHERS)


TYPE 2 C & G

	2654
	2650
	2646
	2642
	2638

NOTES:

- A. REMOVE EXIST. "A" TYPE CURB AS SHOWN,
- B. REMOVE EXIST. "L" TYPE CURB AND GUTTER.
REPLACE WITH 1" WD. VALLEY GUTTER
- C. SAWCUT EXIST. AC PAVE TO PROVIDE CLEAN
EDGE MATCH NEW AC PAVE TO EXIST. AC PAVE
- D. CONSTRUCT "A" TYPE CURB PER SUMMERLIN
STD. DWG. NO. S-50.

DETAIL "A"

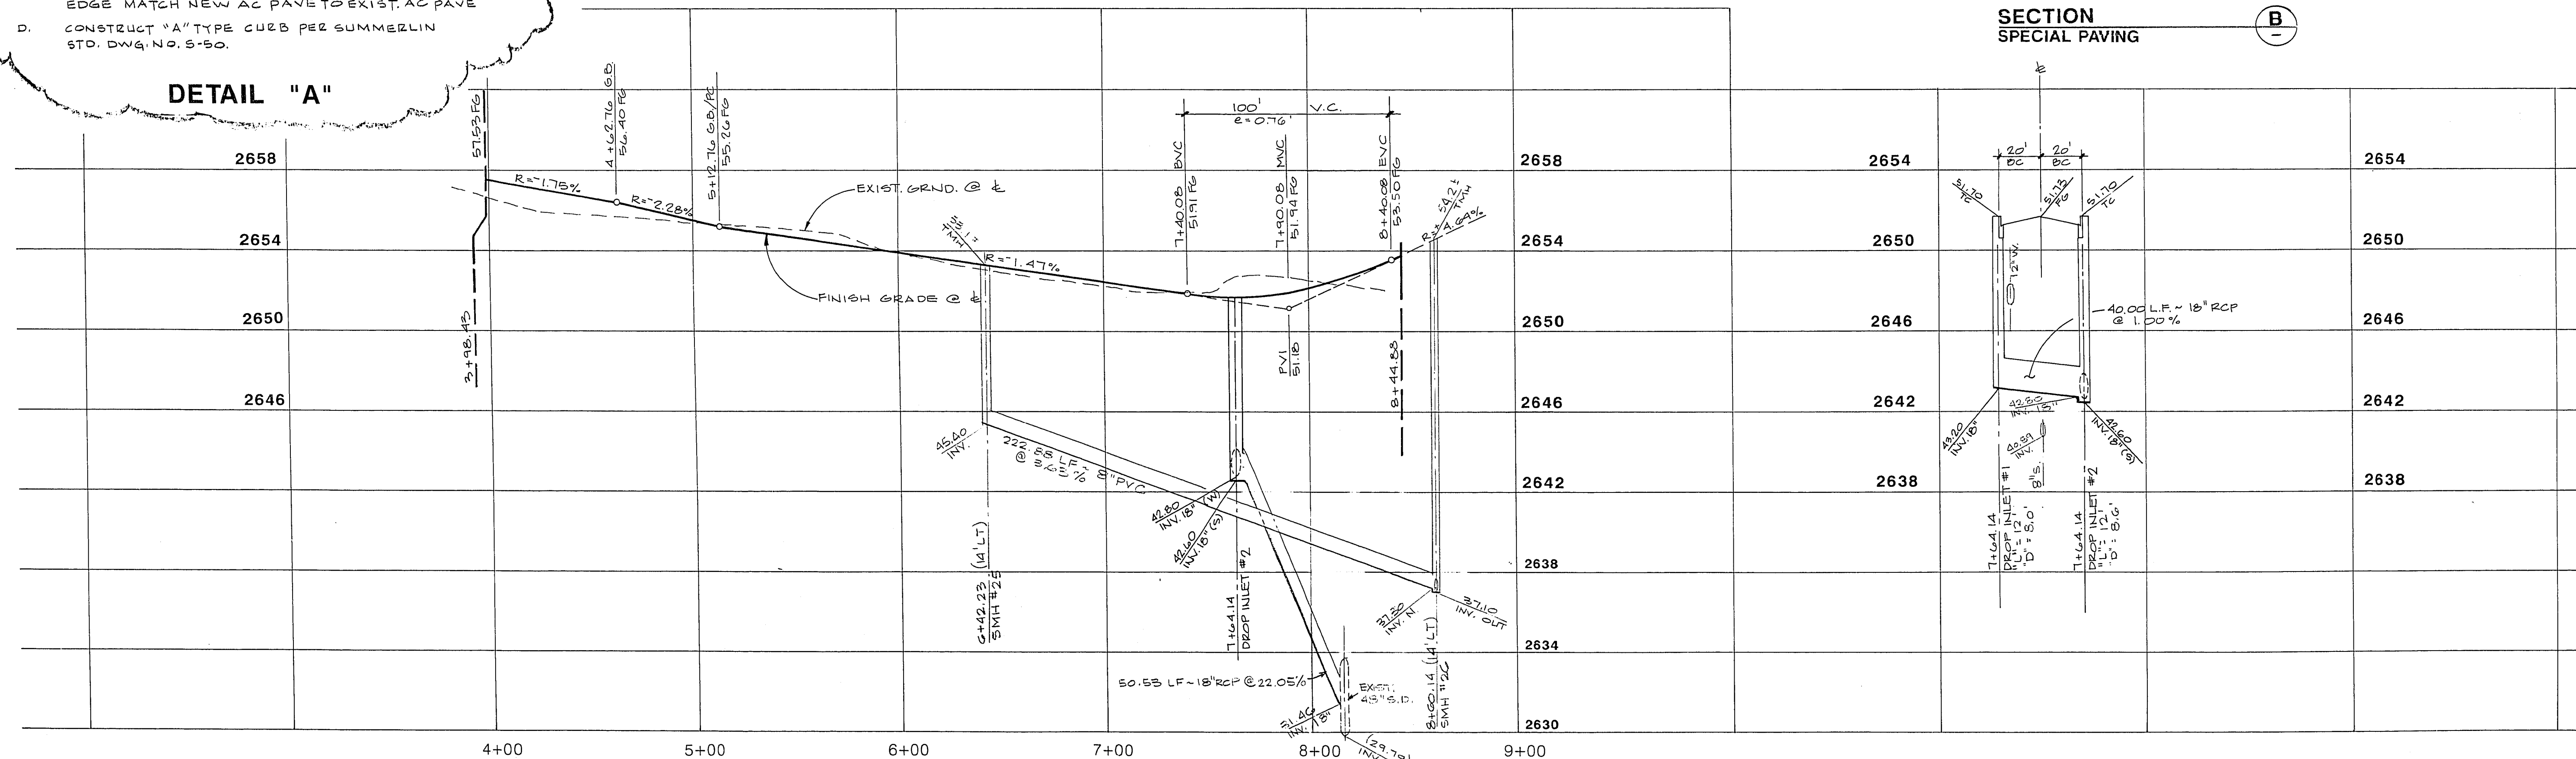

REV.	DATE	DESCRIPTION	DATE APPROV.
3	1/15/94	ADDED PAVING	2/11/94
3	2/1/94	REV. V.C. 8 UNIT BODY	2/23/94
		REV. 3000S AT UNIT BODY	
		CHG 5' LONG ON UNIT 12	
		SPECIAL FINISHES V.C. 201	10/6/94
3	3/11/94	ADDED	10/6/94
3	4/1/94	ISSUE TO BID	
3	5/22/94	REVISED SHT. N.O.	
3	7/10/94	ADDED 8" SEWER	
3	8/6/94	ISSUE TO CONSTRUCT	
REV.	DATE	DESCRIPTION	

RECOMMENDED Amundson
CHRISTOPHER W. ANDERSON
5071 7-10-91 R.E. NO. DATE
JOB NO. 620 704



G.C. WALLACE, INC.
Engineering/Architecture

**SUMMERLIN VILLAGE 1 SOUTH
TOURNAMENT HILLS
TROPHY HILLS DRIVE**

SHEET
I-3
SHT 9 OF 18

107Y-4172