
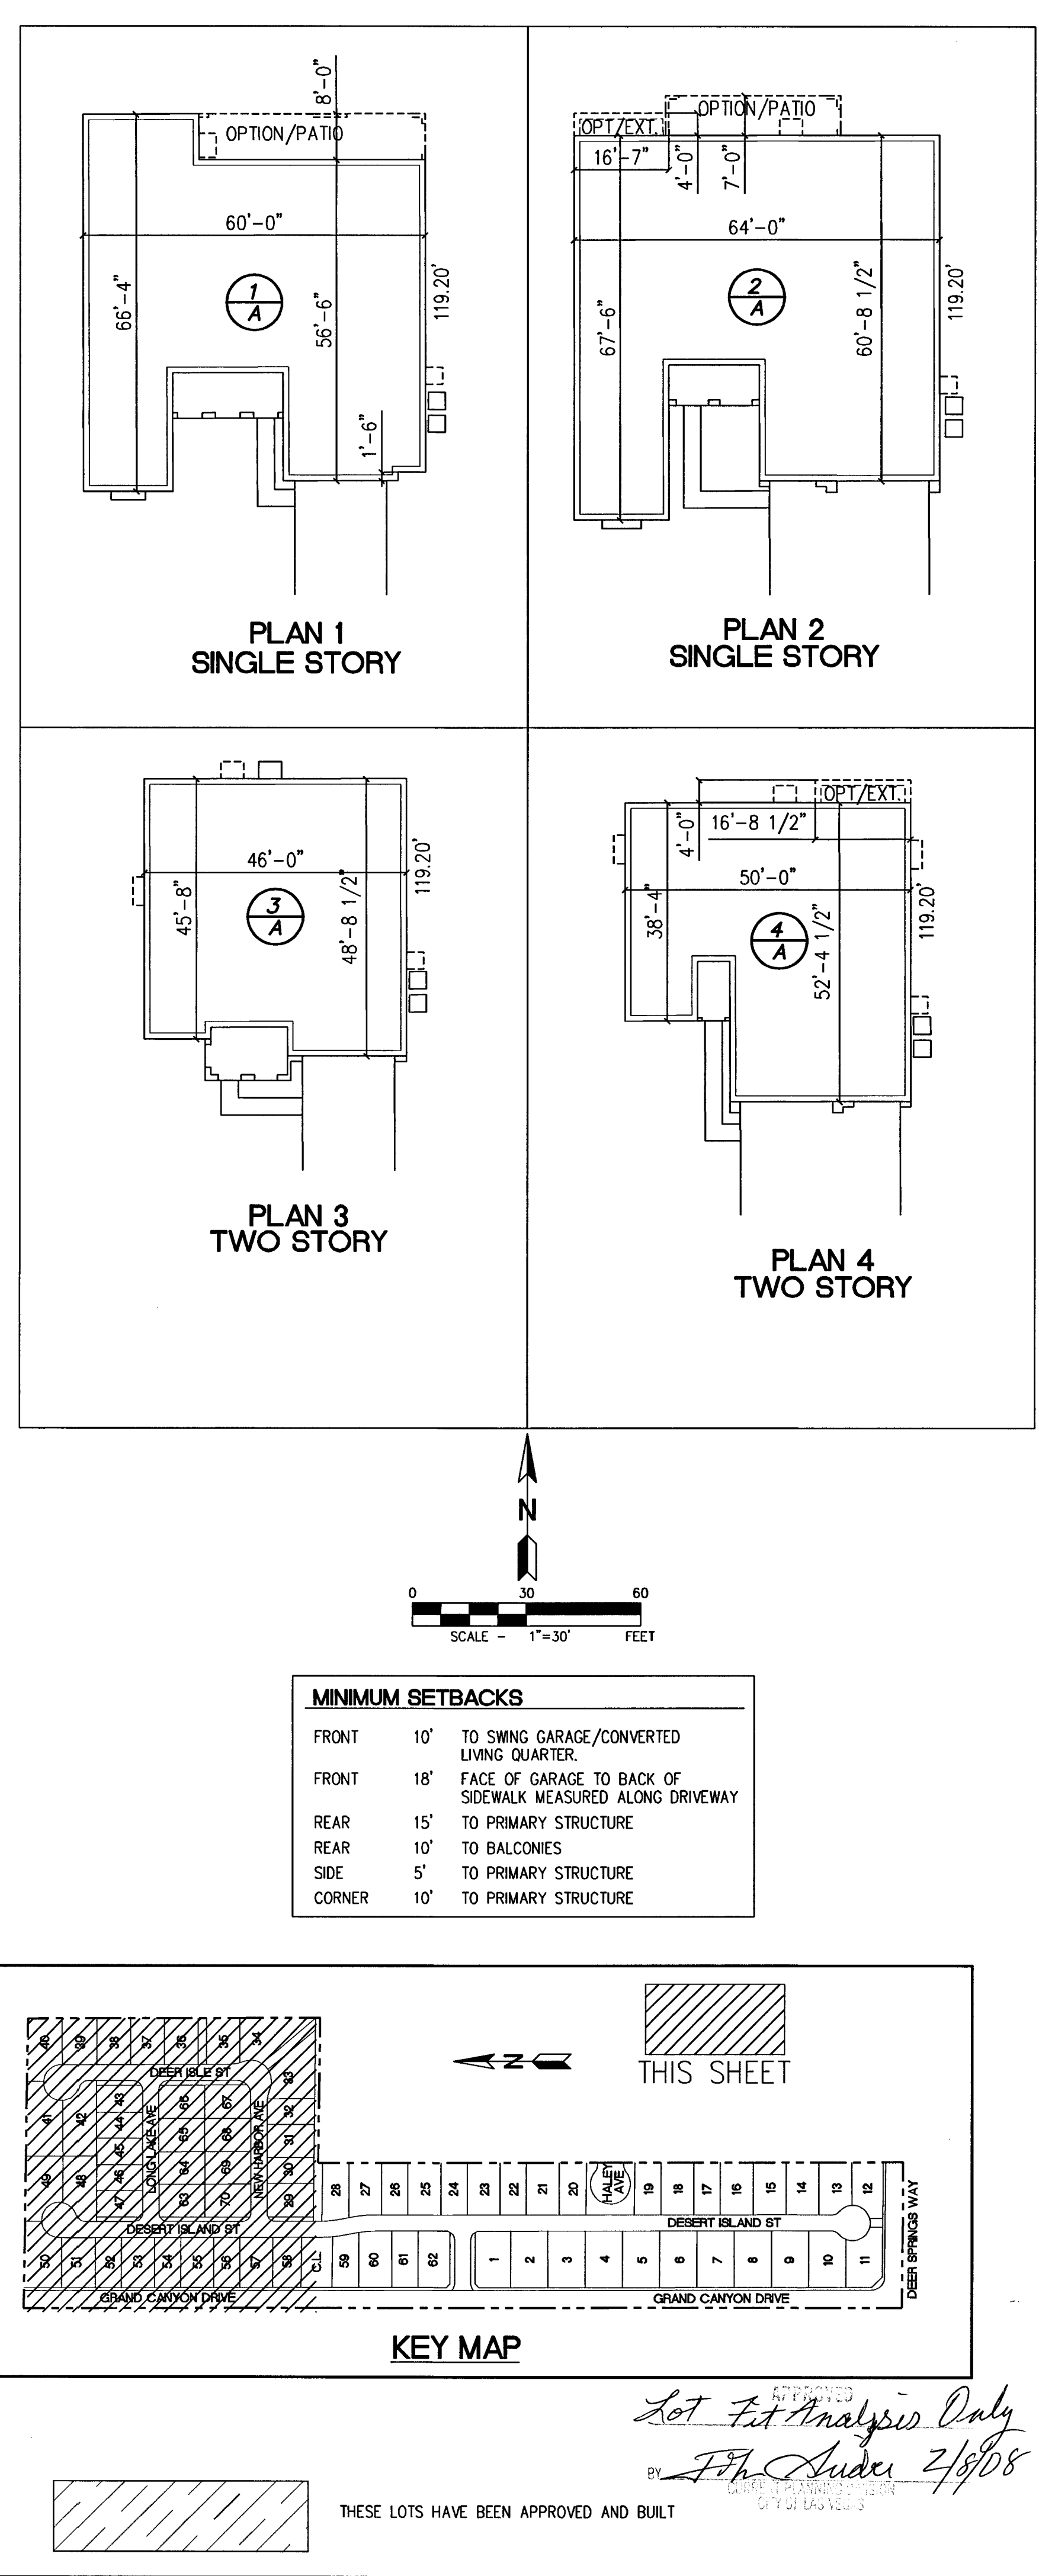


1:\proj\302-007\dwg\plan\plan2\plan2.dwg, 1/8/2008 10:22 AM ELIAS MUNOZ

GRAND CANYON DRIVE

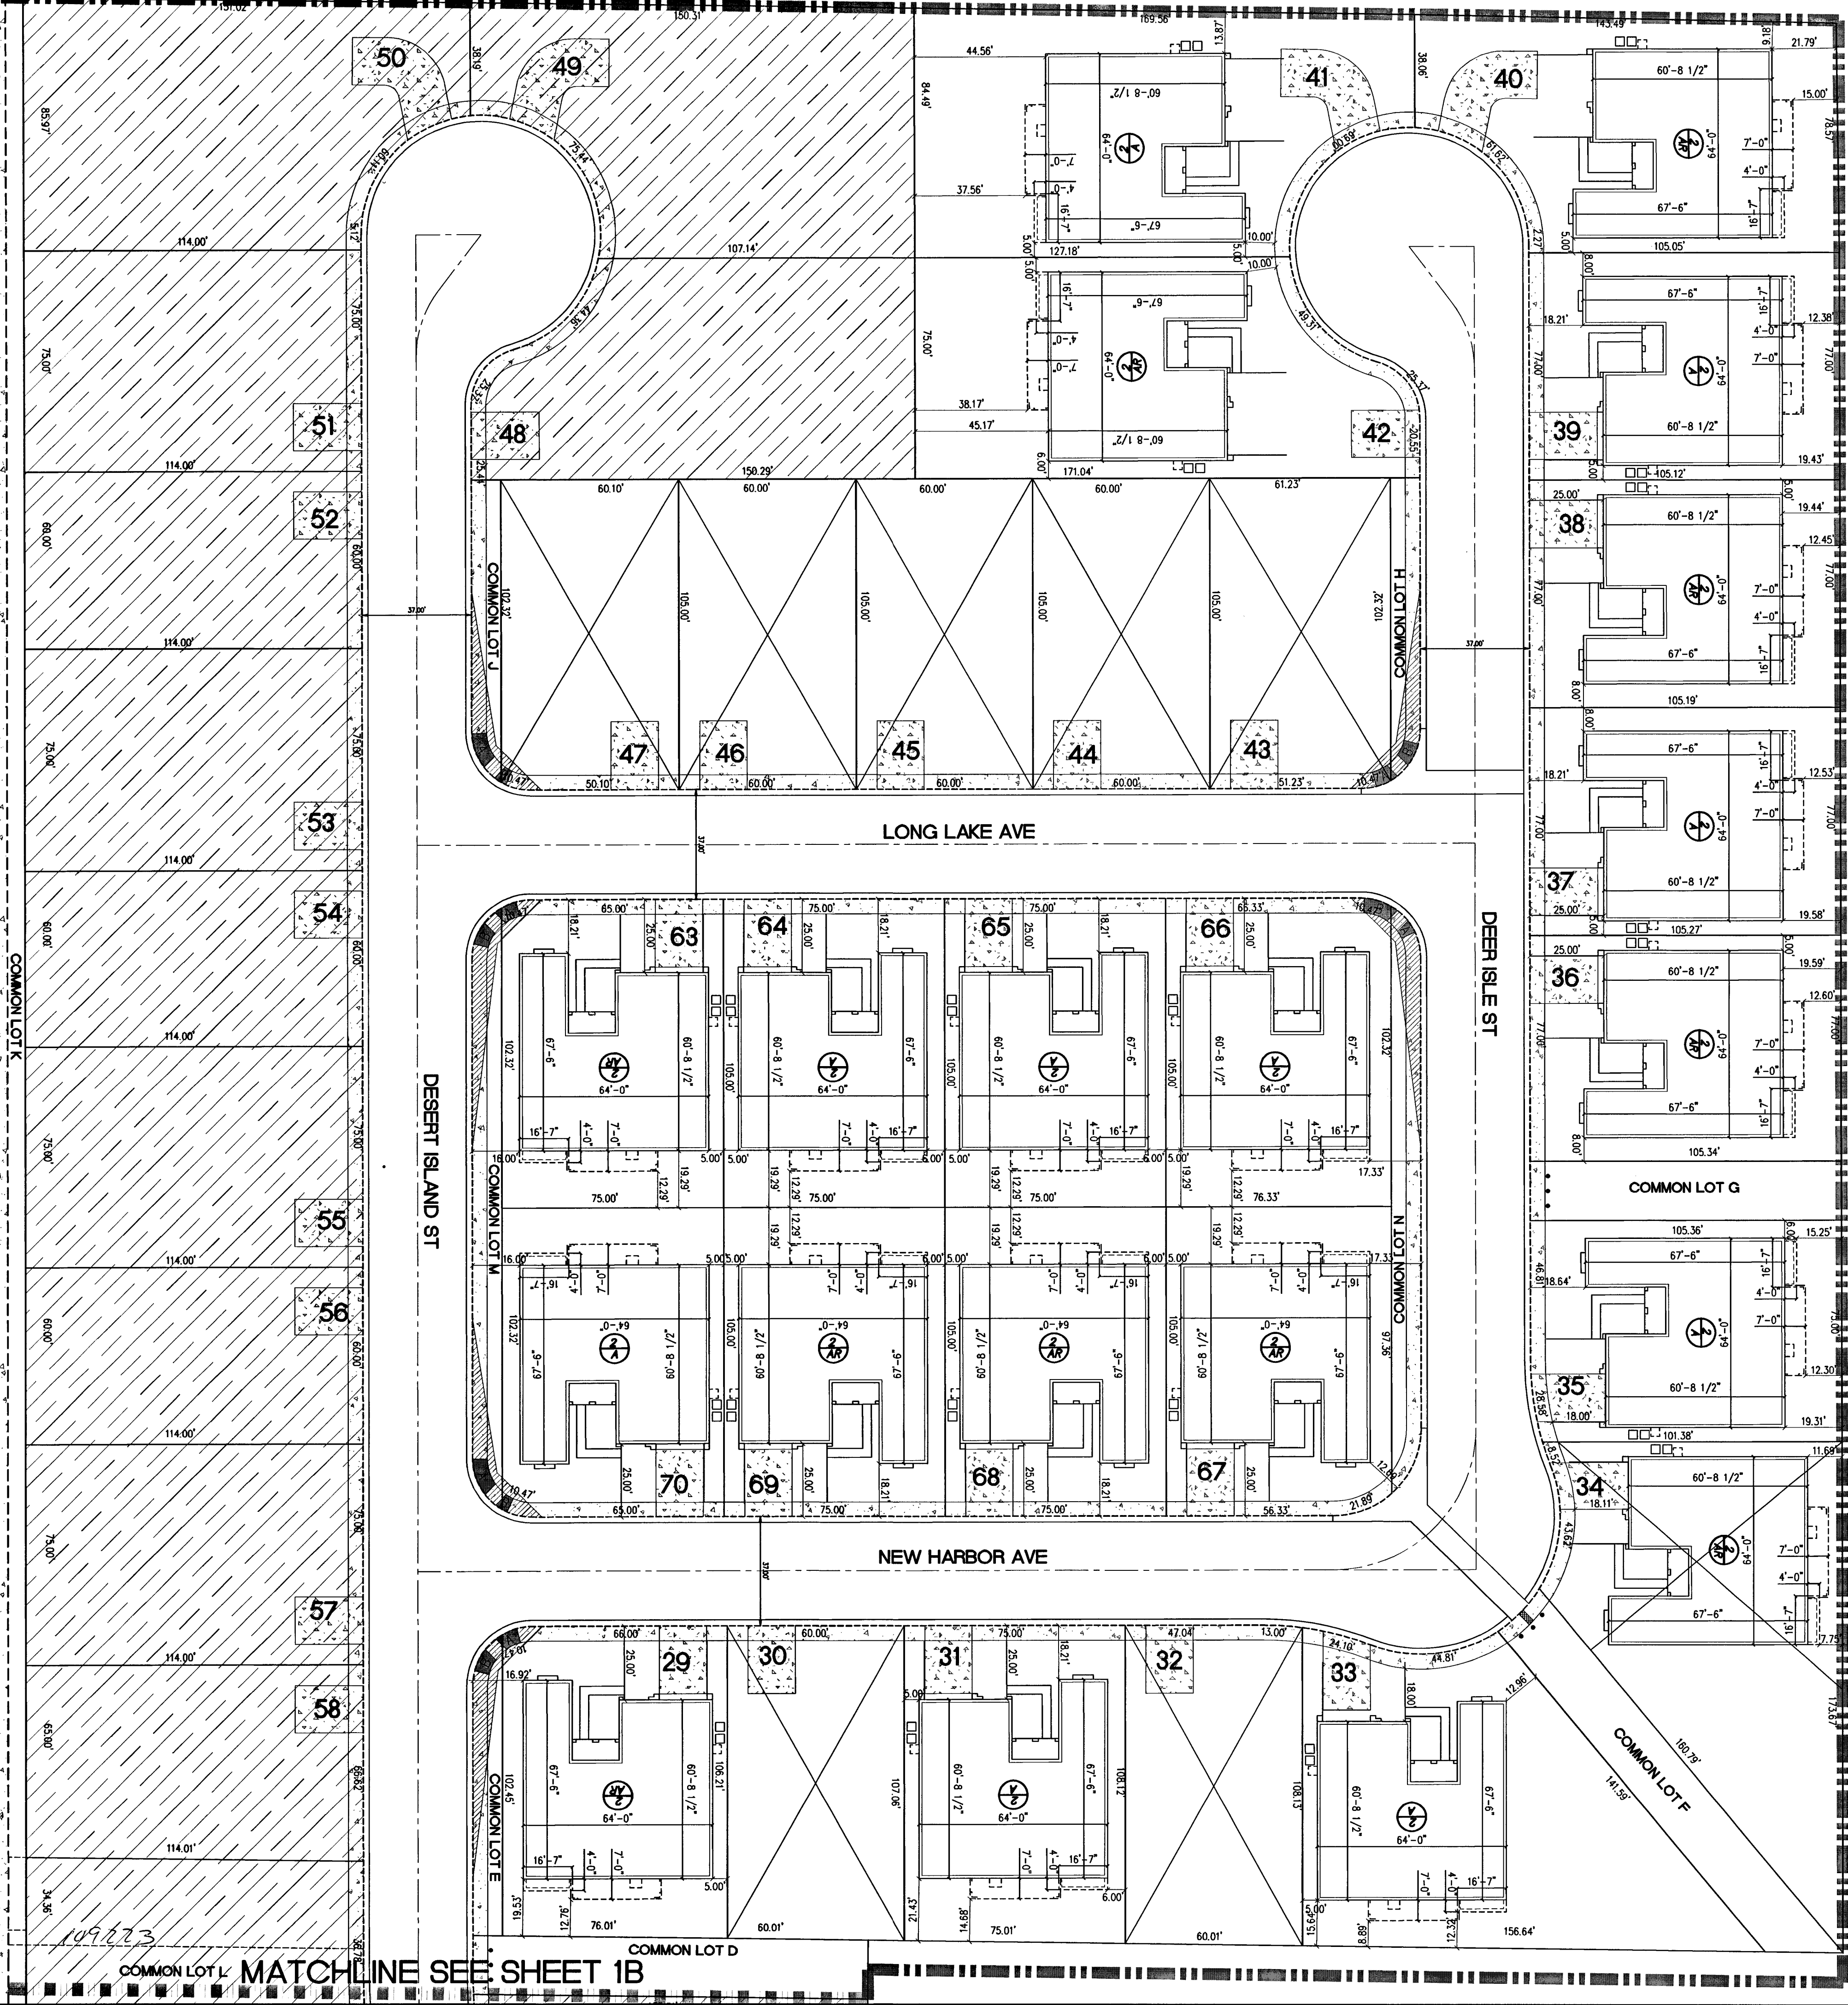

SLATER
HANIFAN
GROUP
CONSULTING ENGINEERS & PLANNERS
5740 S. ARVILLE STREET #216, LAS VEGAS, NV 89118
PHONE (702) 284-5399

NO.	DESCRIPTION	DATE	BY	APP.

PARDEE HOMES OF NEVADA
TOWN CENTER 60/75 NO. 5
PLAN 2 LOT FIT ANALYSIS

DATE: 01/03/08
DRAFTER: EMM
DESIGNER: EMM
CHECKED: TJS
PROJECT NO.
PAR0302.007

RECEIVED
JAN 24 2008 2 55 PM
CITY OF LAS VEGAS

P-2A
SHEET 3 OF 8