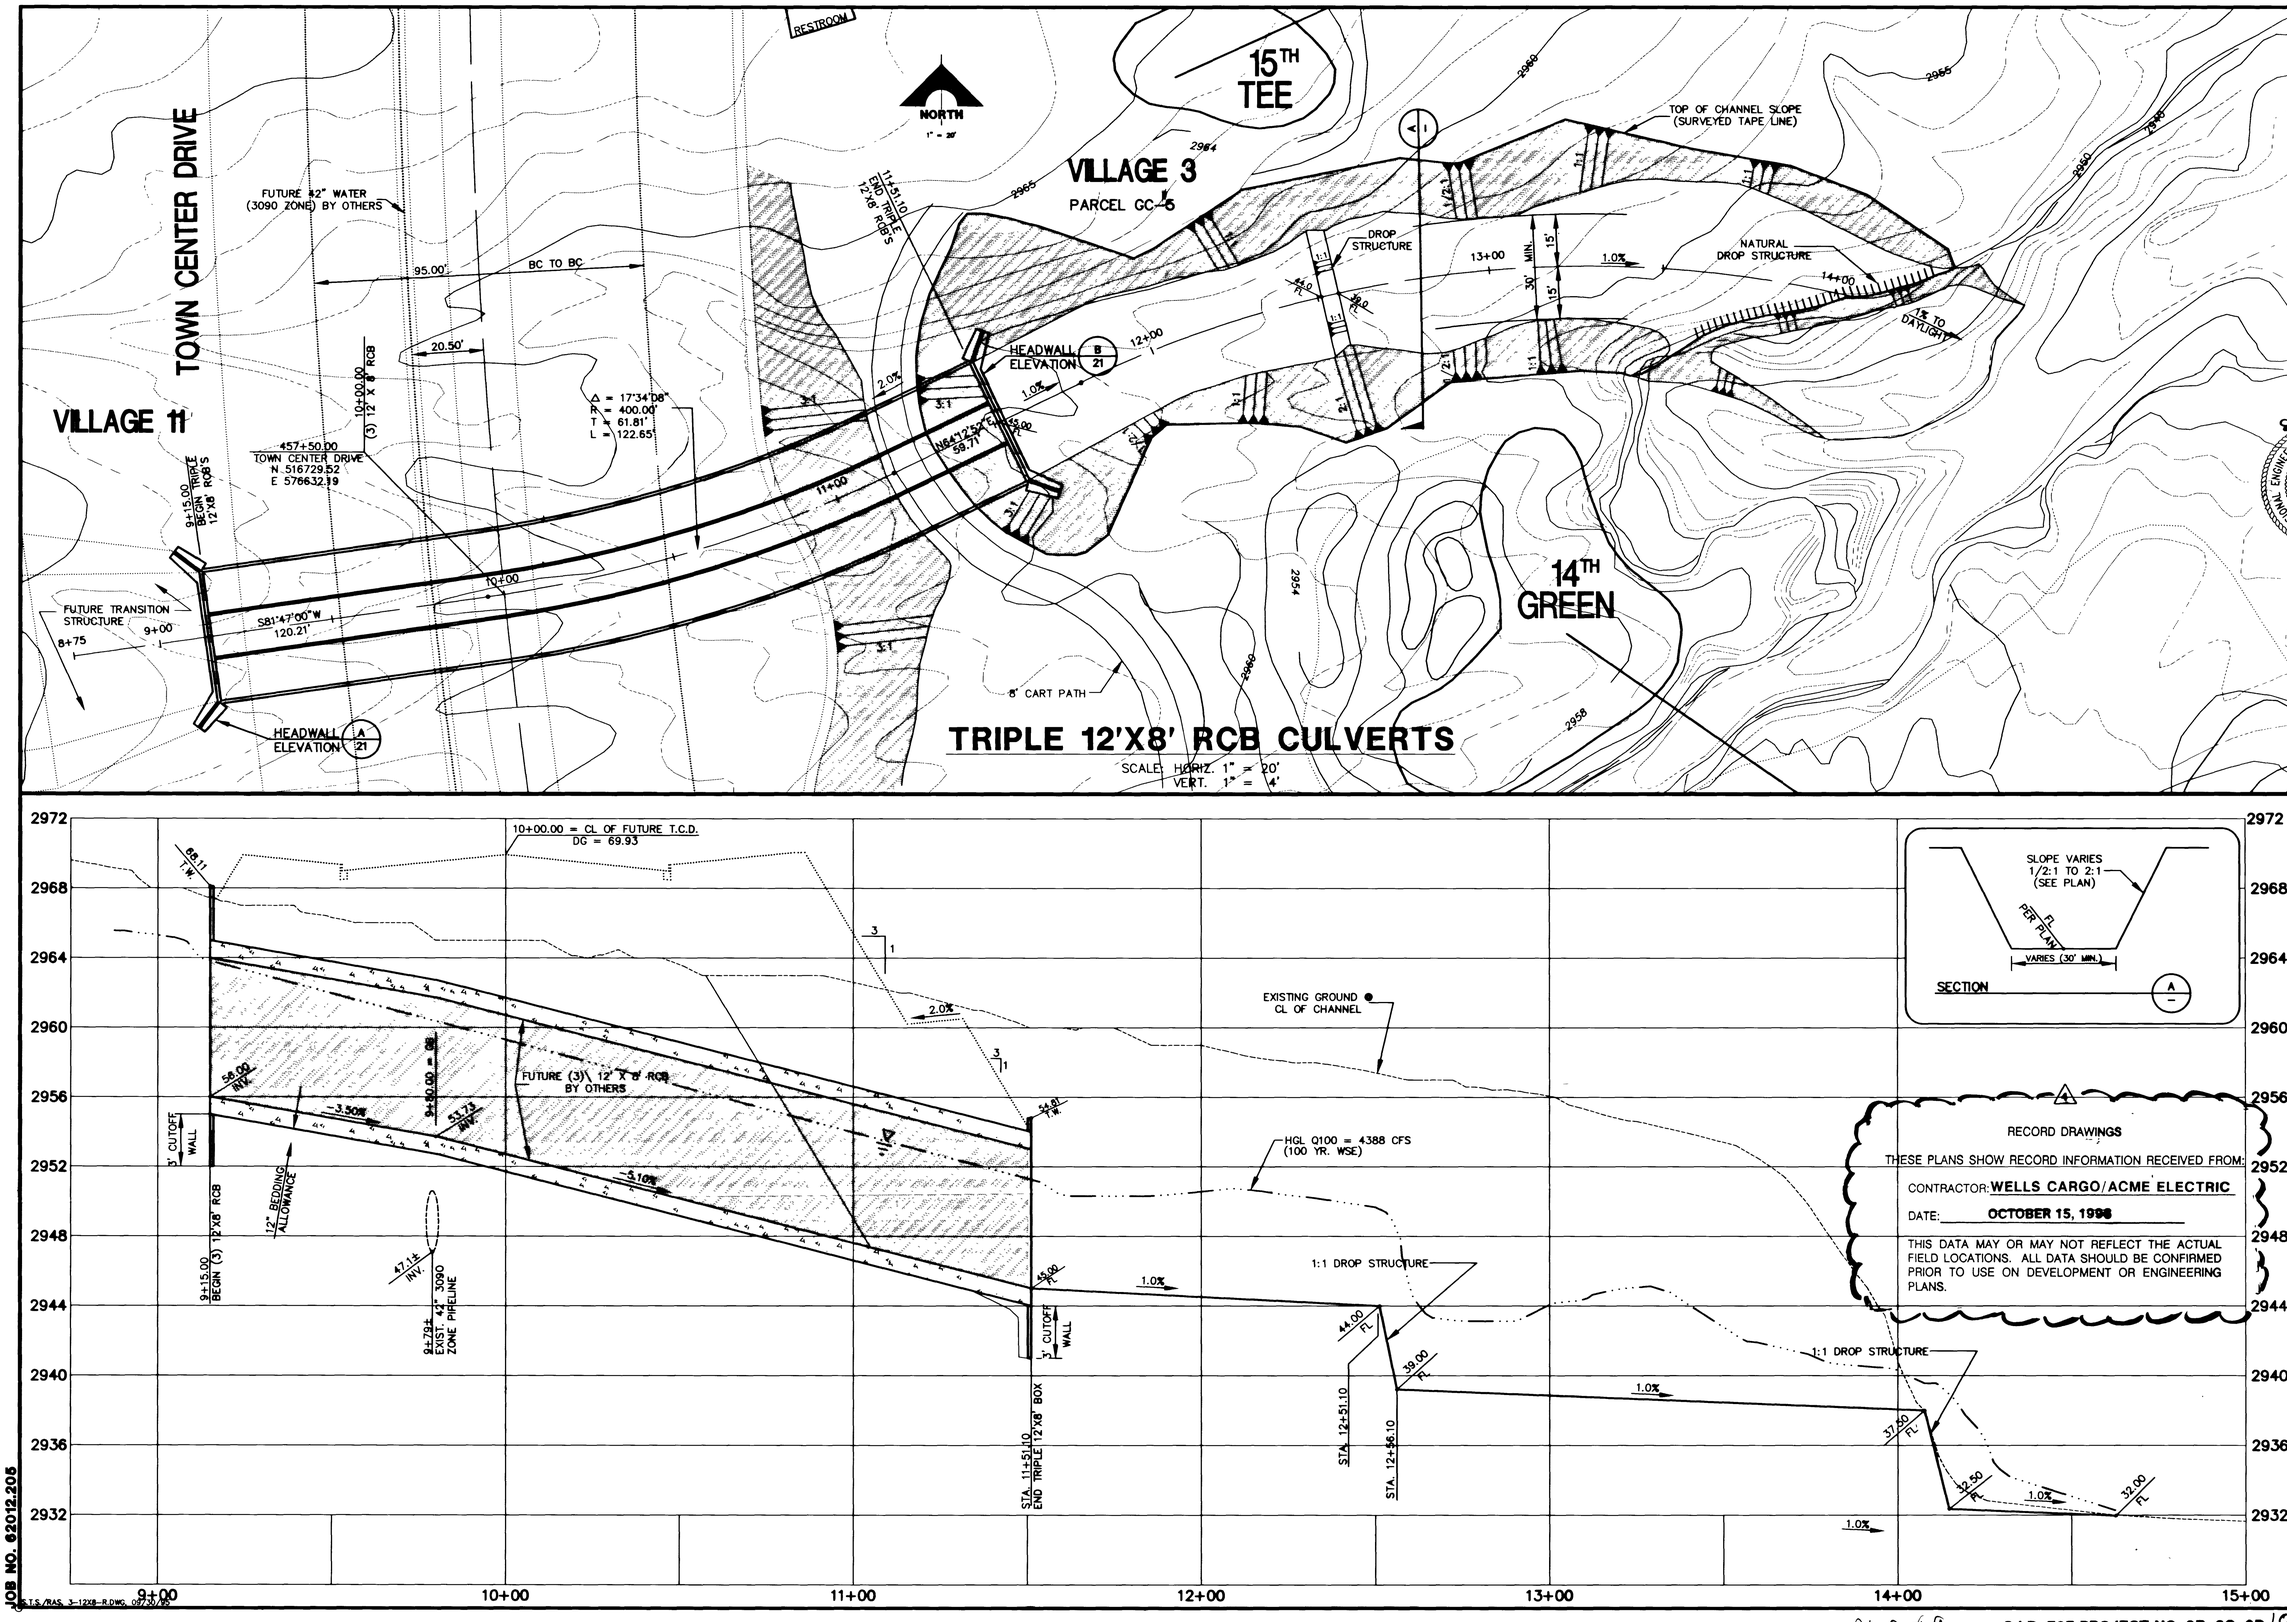

FINAL SUBMITTAL

REV.	DATE	DESCRIPTION	DATE	APPROVAL
1	10/15/98	RECORD DRAWINGS		

RECOMMENDED FOR ISSUANCE: CHRISTOPHER M. WEBSON, PROJECT ENGINEER — DATE

APPROVED FOR ISSUANCE: CHRISTOPHER M. WEBSON, PROJECT MANAGER — DATE

SUMMERLIN STATE OF NEVADA

G.C. WALLACE, INC.
Engineering/Architecture
1555 SOUTH RAINBOW BLVD./LAS VEGAS, NEVADA 89102

SUMMERLIN
TOWN CENTER DRIVE
TRIPLE 12'X8' RCB'S
PLAN & PROFILE
STA 9+15.00 TO 11+51.10

SHEET 20
SHT 20 OF 21

JOB NO. 62012.205

S.I.D. 707 PROJECT NO. 2B, 2C, 2D

26-2-89

107-V2425

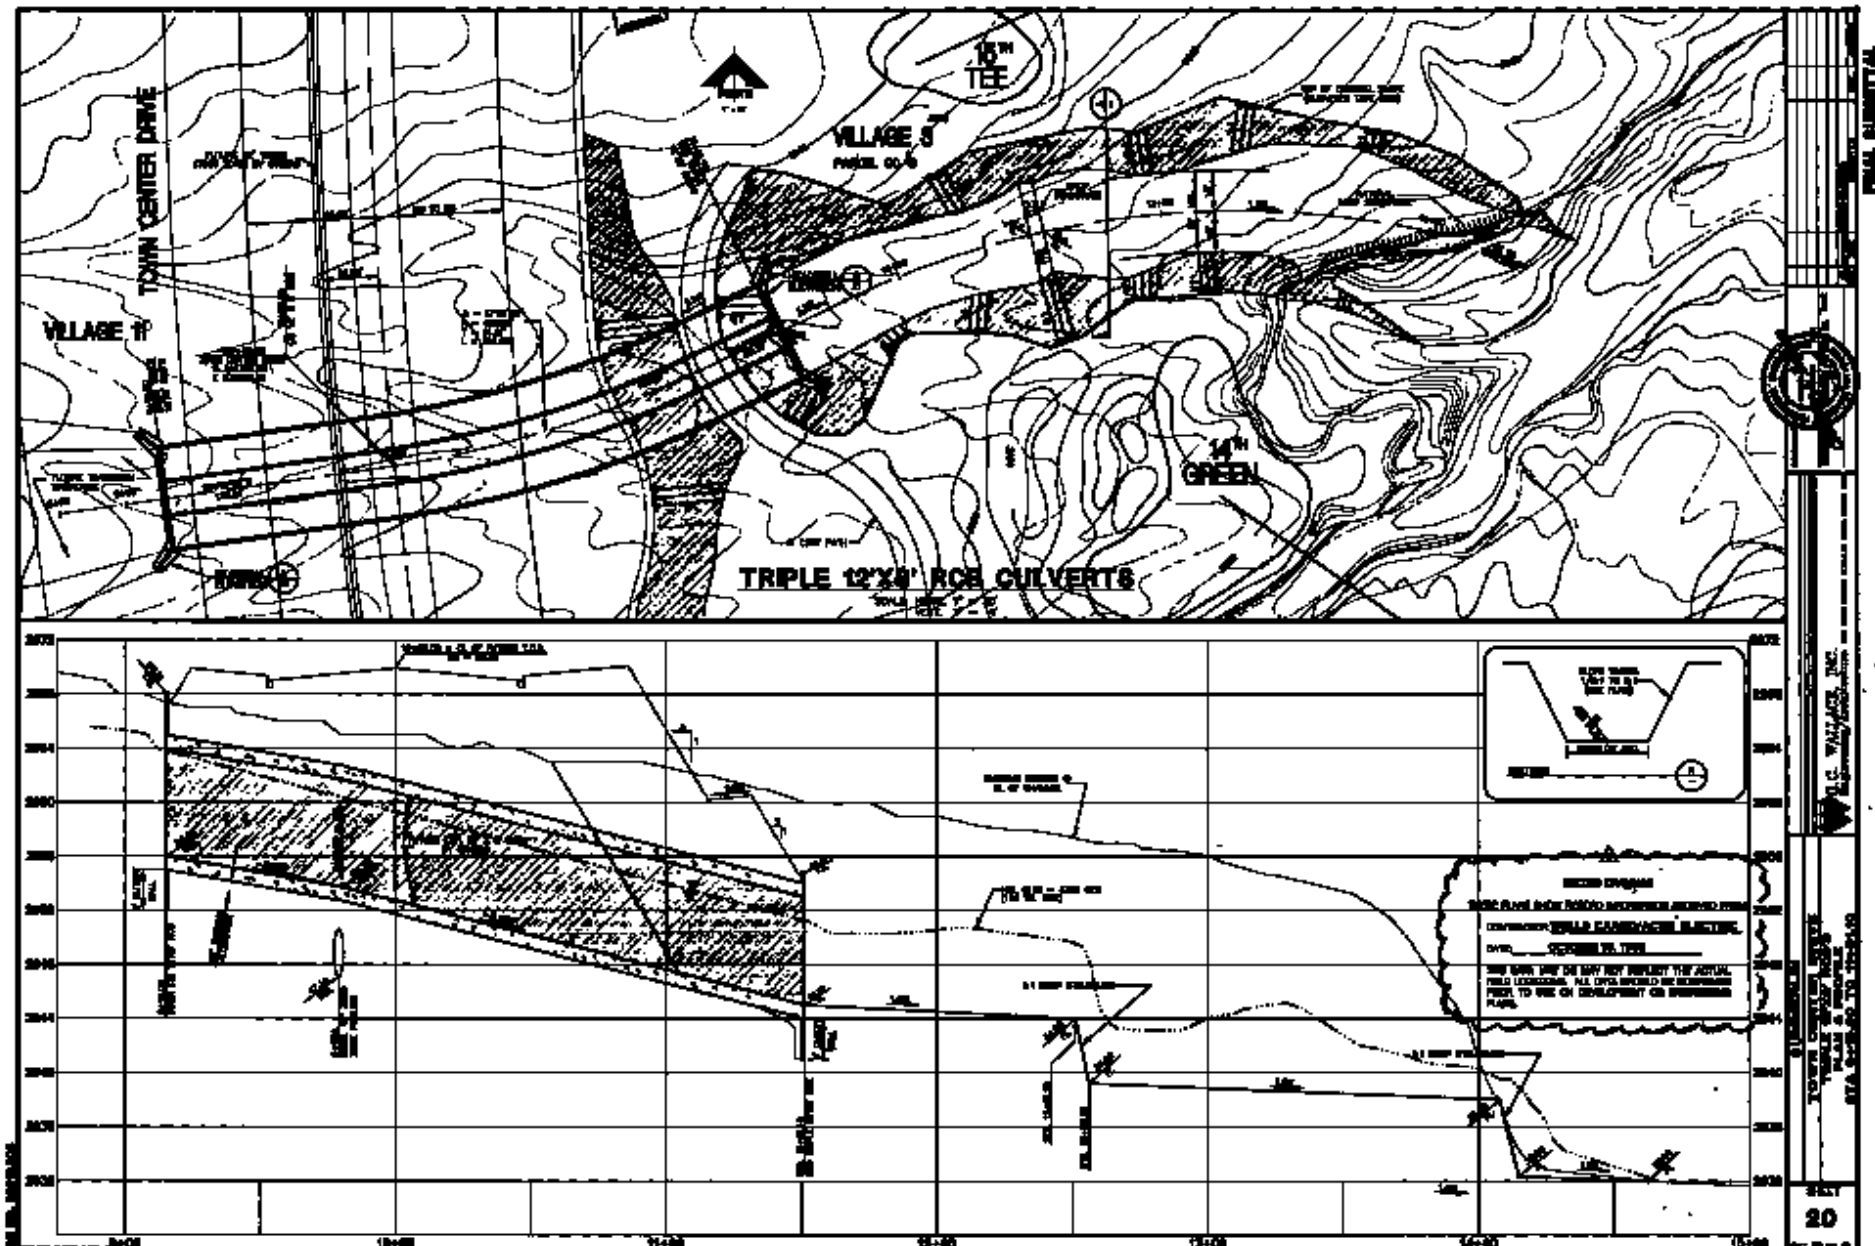
TOWN CENTER DRIVE
VILLAGE 11
VILLAGE 3
15TH TEE
14TH GREEN
TRIPLE 12'X8' RCB CULVERTS
FINAL SUBMITTAL
TOWN CENTER DRIVE
PLAN & PROFILE
SHEET
20