



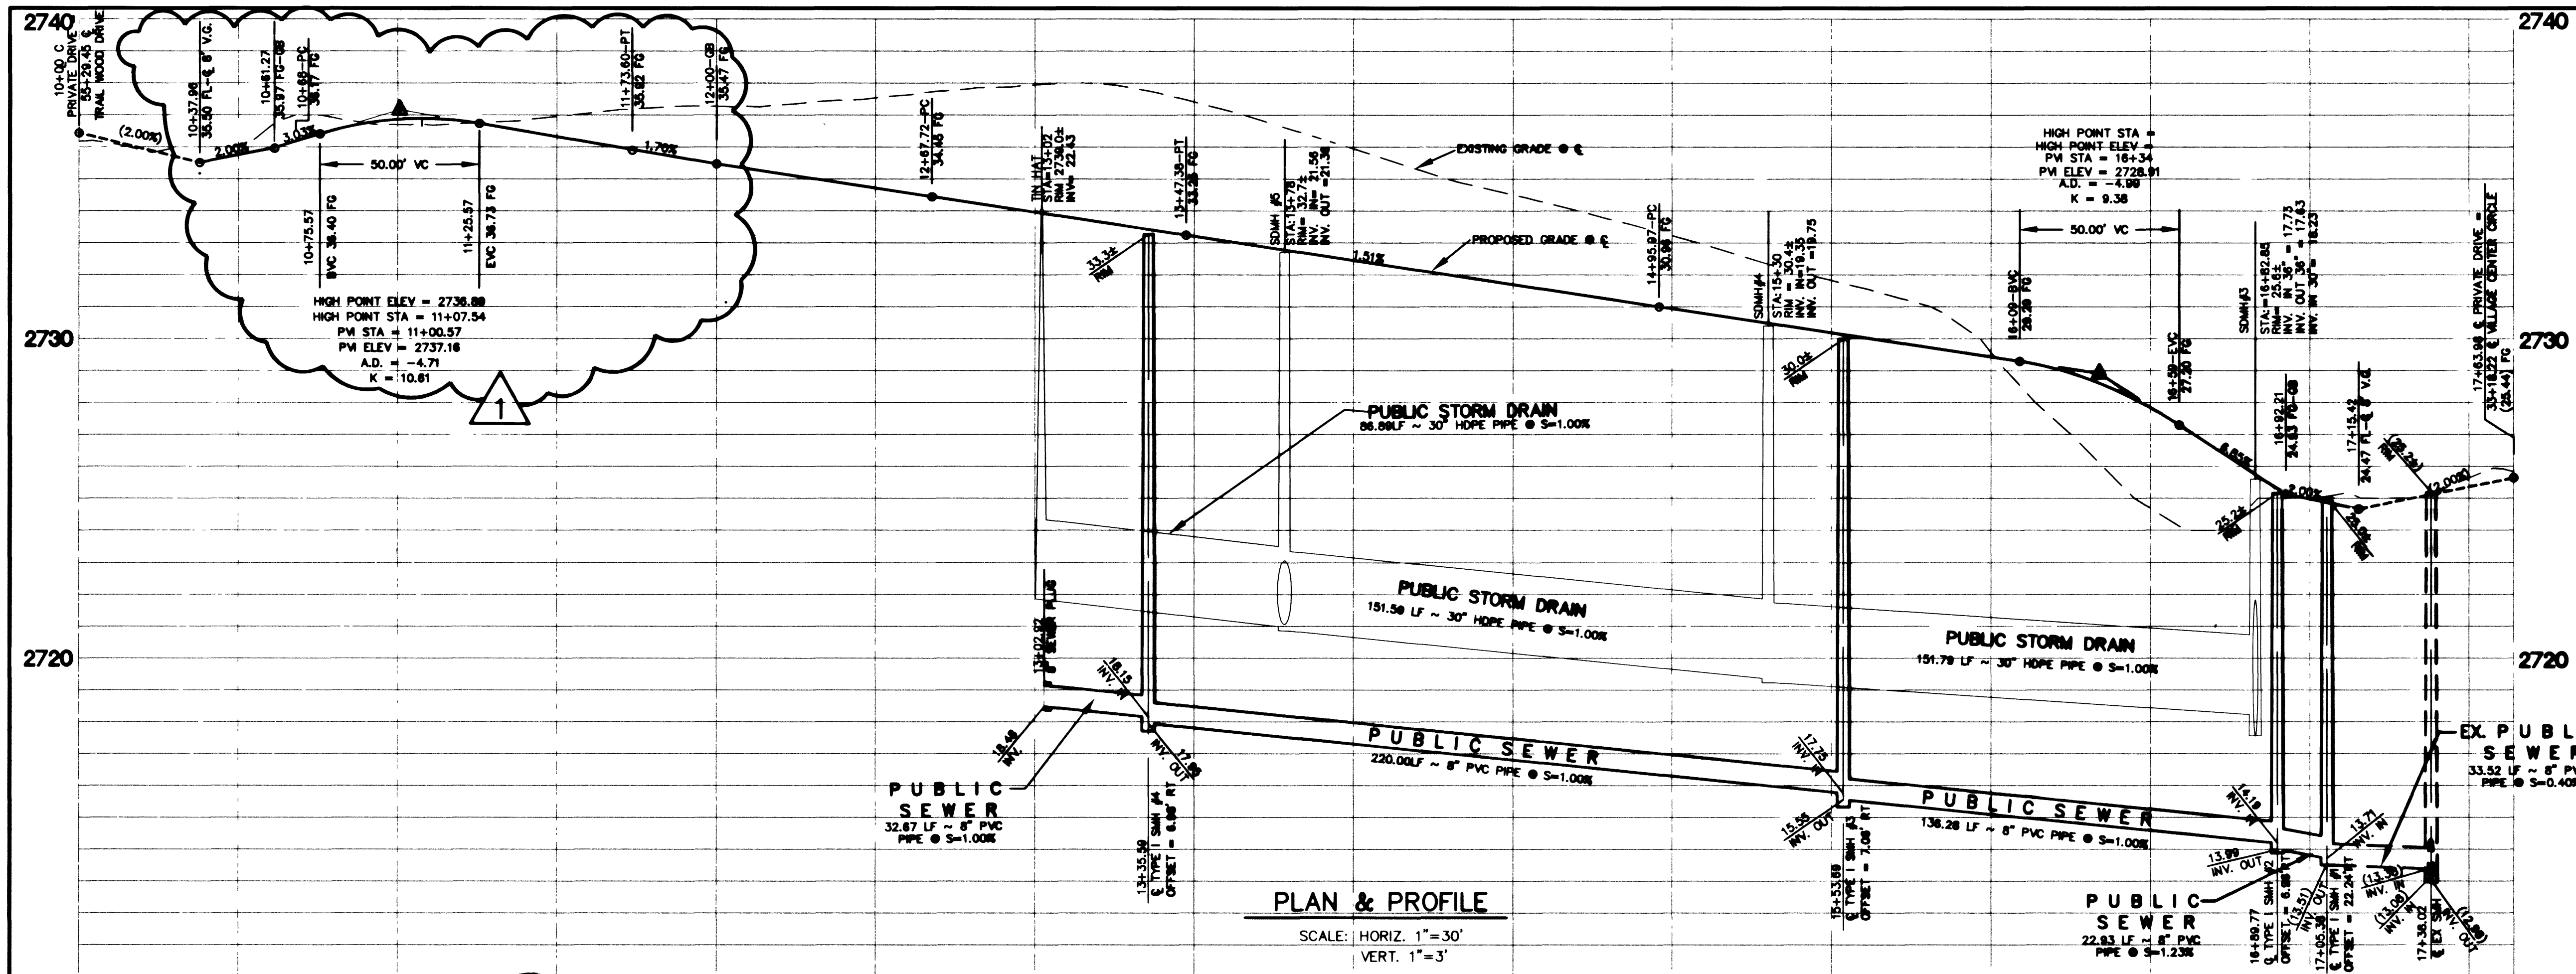

- ### GRADING NOTES
1. SAWCUT EXISTING CURB & MATCH. CONTRACTOR SHALL VERIFY EXISTING CURB ELEVATION AND REPORT ANY DISCREPANCIES TO THE ENGINEER PRIOR TO COMMENCEMENT OF CONSTRUCTION.
 2. CONSTRUCT COMMERCIAL DRIVEWAY & 8' WIDE VALLEY GUTTER PER SUMMERLIN DWG NO. S-81, AND S-84.
 3. CONSTRUCT "L" TYPE CURB PER SUMMERLIN DWG. S-47.
 4. CONSTRUCT 3" AC PAVING OVER 4" TYPE II AGGREGATE BASE OVER COMPACTED SUBGRADE PER DETAIL 1, SHEET C-7. SEE SOILS REPORT PREPARED BY TERRACON DATED APRIL 24, 1998, PROJECT NO. 64985137 FOR MORE INFORMATION.
 5. CONSTRUCT TYPE "A" CURB PER DETAIL 2, SHEET C-7.
 6. EXISTING SIDEWALK TO BE REMOVED.
 7. EXISTING TREES TO BE REMOVED BY OWNER PRIOR TO DEMOLITION.
 8. CONSTRUCT DECORATIVE PAVING, SEE LANDSCAPE PLANS FOR EXACT LOCATION, COLOR, AND FINISH.

- ### NOTES
1. ALL DIMENSIONS ARE TO BACK OF CURB.
 2. ALL GRADING SHALL BE IN ACCORDANCE WITH THE SOILS REPORT AS PREPARED BY TERRACON DATED APRIL 24, 1998, PROJECT NO. 64985137

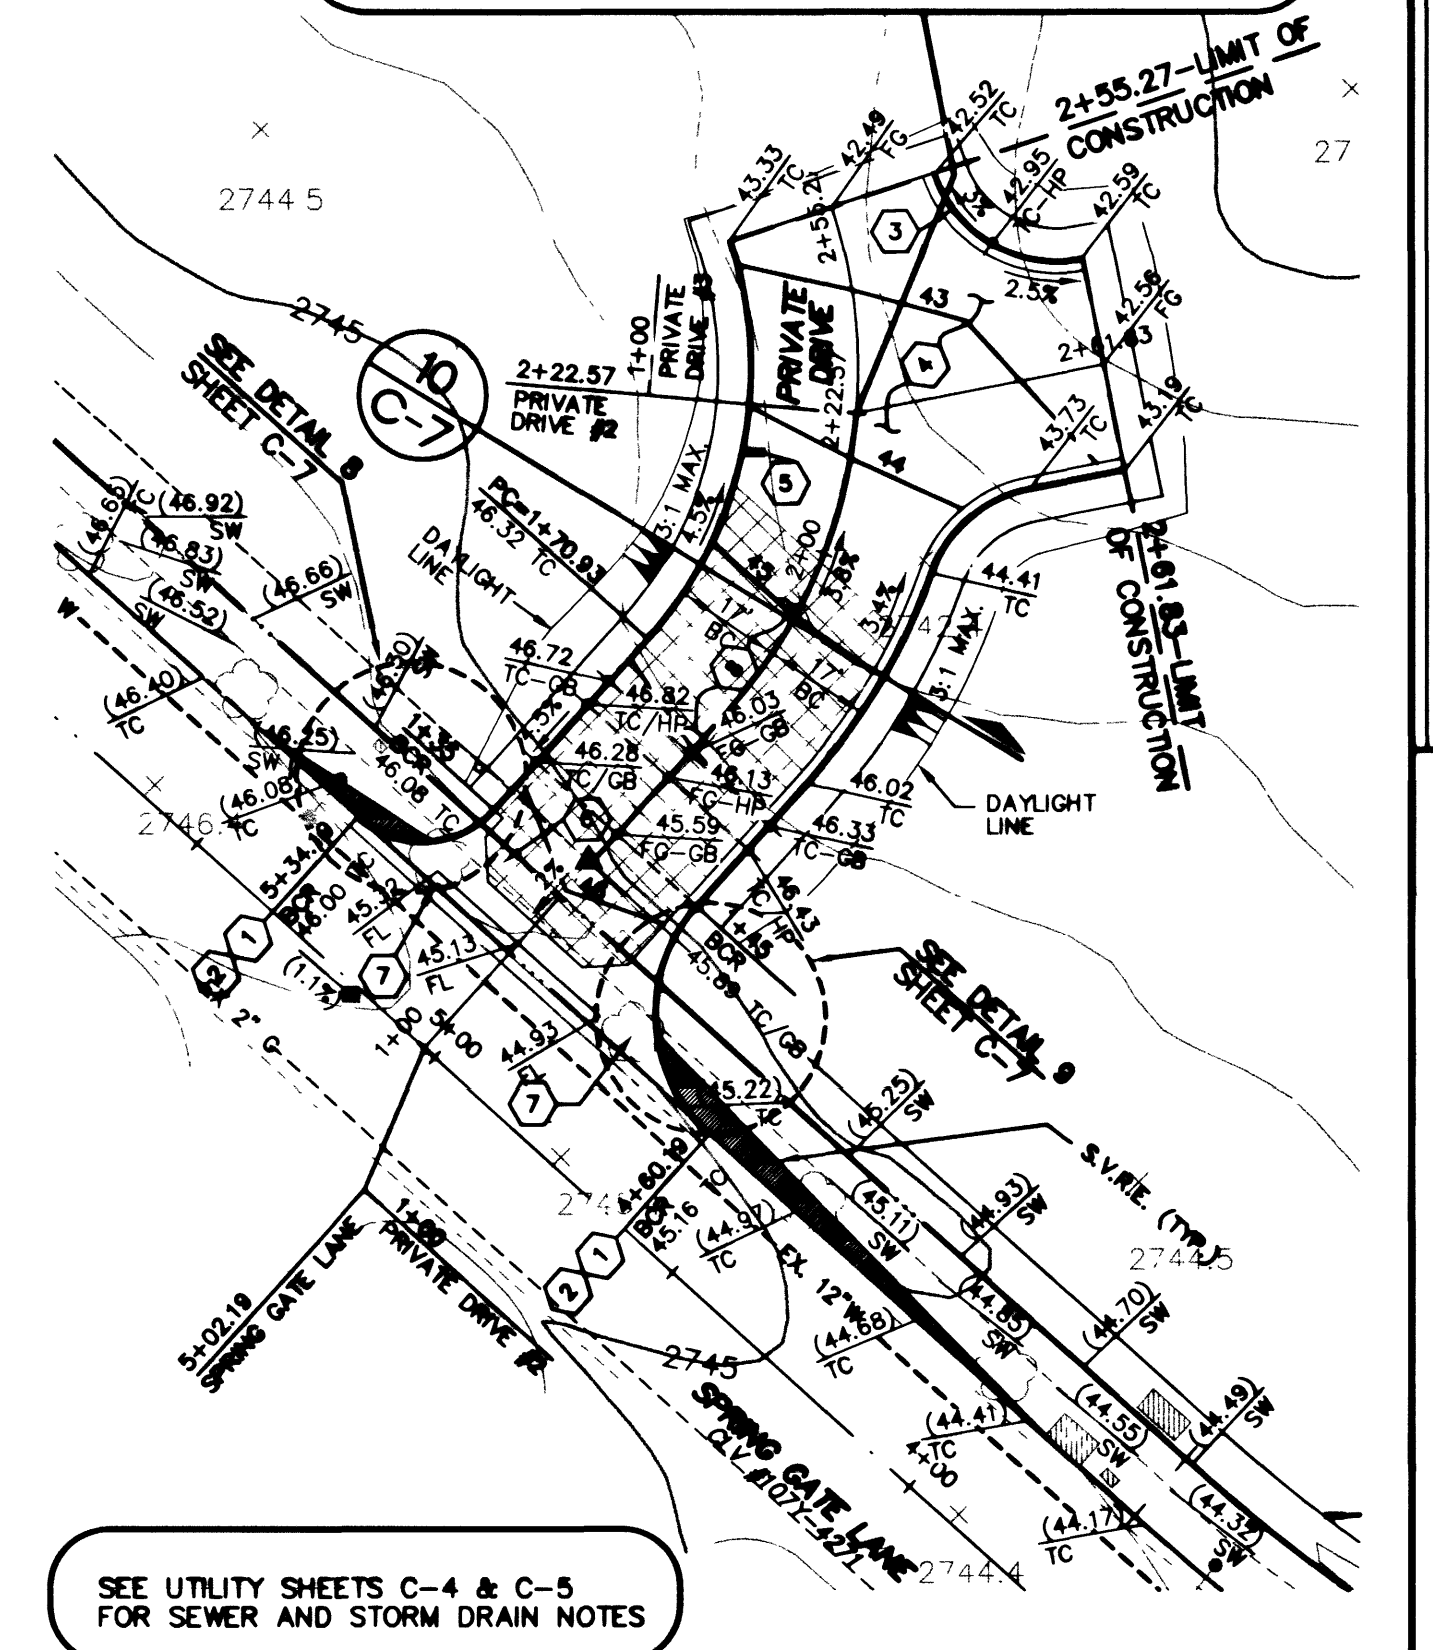

DRAINAGE CERTIFICATION
I CERTIFY THESE GRADING PLANS ARE IN CONFORMANCE WITH THE APPROVED DRAINAGE STUDY ON FILE WITH THE CITY OF LAS VEGAS FOR THIS PROJECT.

Gregory Patch
10170 P.E. NO. 12/18/2000 DATE



Call before you Dig.
1-800-227-2600
UNDERGROUND SERVICE (USA)

THE HOWARD HUGHES CORPORATION
PARCEL E
PLAN AND PROFILE

G.C. WALLACE, INC.
Engineers/Planners/Surveyors
1555 SOUTH RAINBOW BLVD., LAS VEGAS, NEVADA 89146
TEL: 702-734-1000 FAX: 702-734-2299
H. VERA-PARCEL - E. G. WALLACE, INC. (P) 00000000

REVISIONS

NO.	DATE	DESCRIPTION
1	12/18/2000	ISSUE FOR PERMIT

DATE: 12/18/2000

SHEET C-6
6 OF 10 SHEETS