

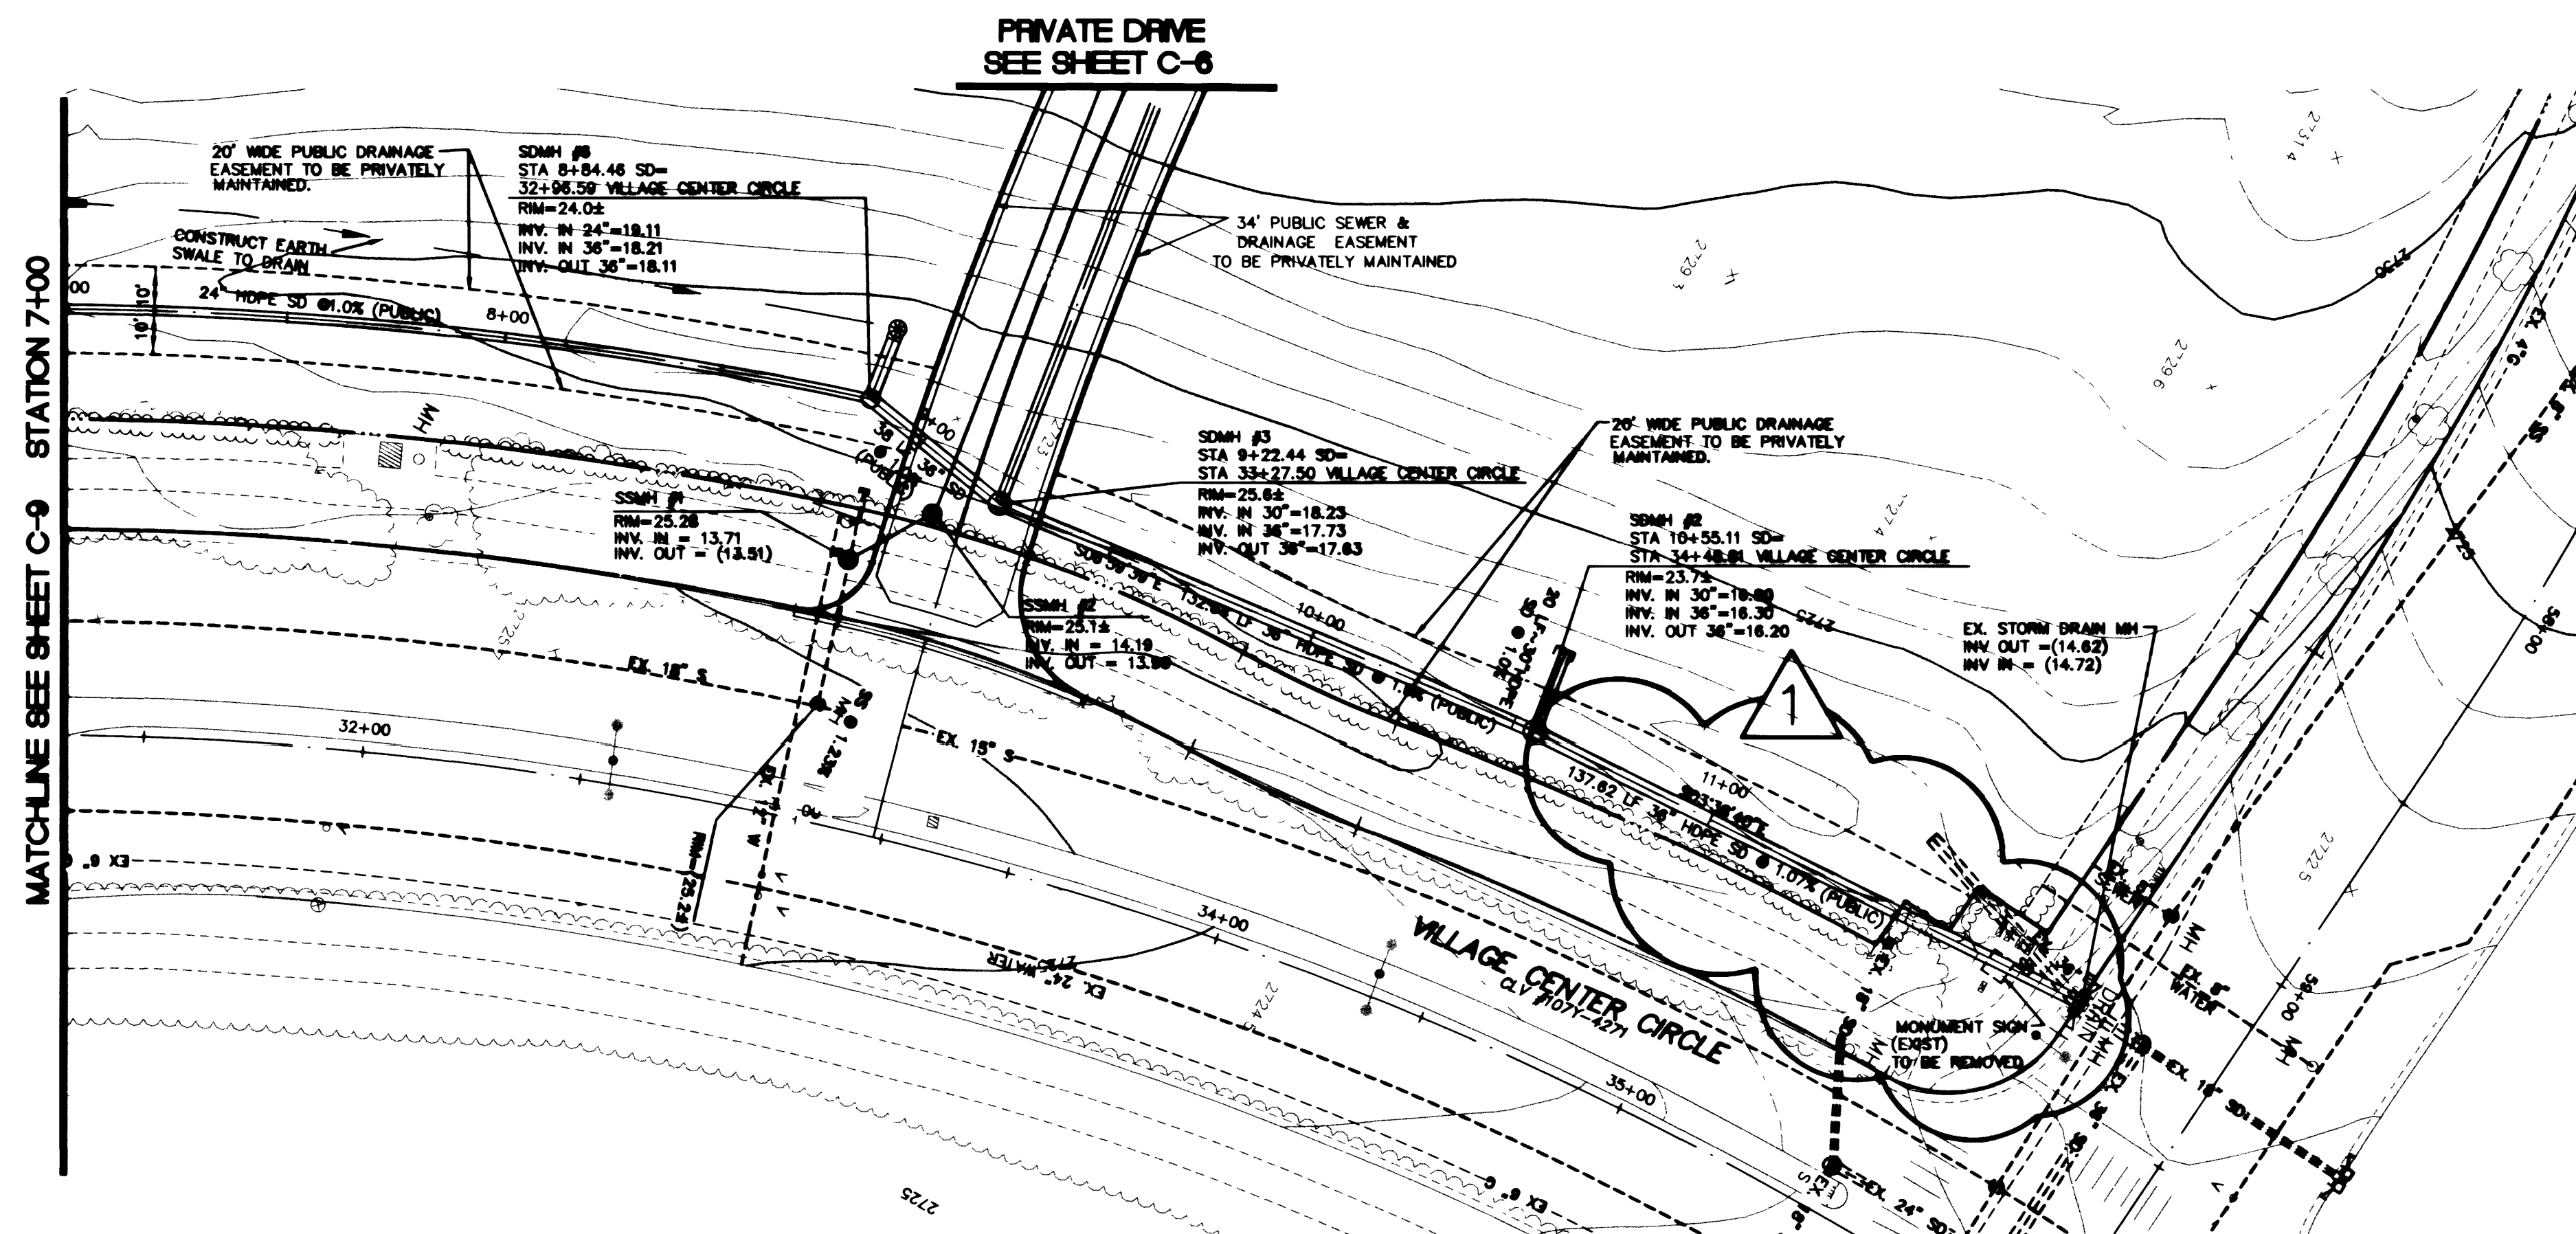


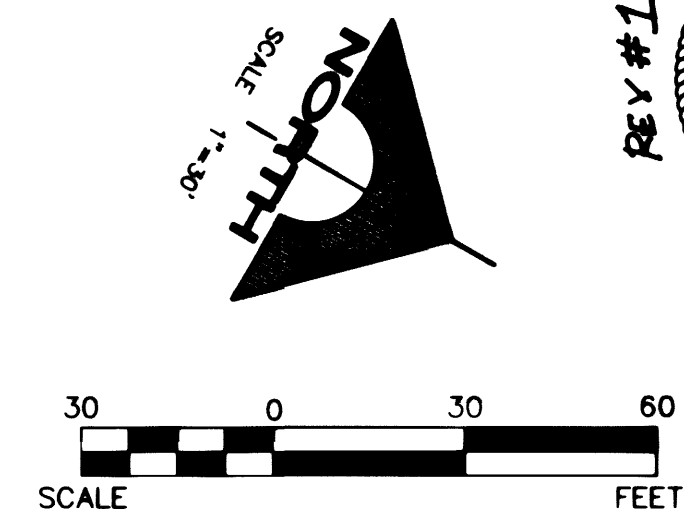


PLAN & PROFILE

SCALE: HORIZ. 1"=30'  
VERT. 1"=3'

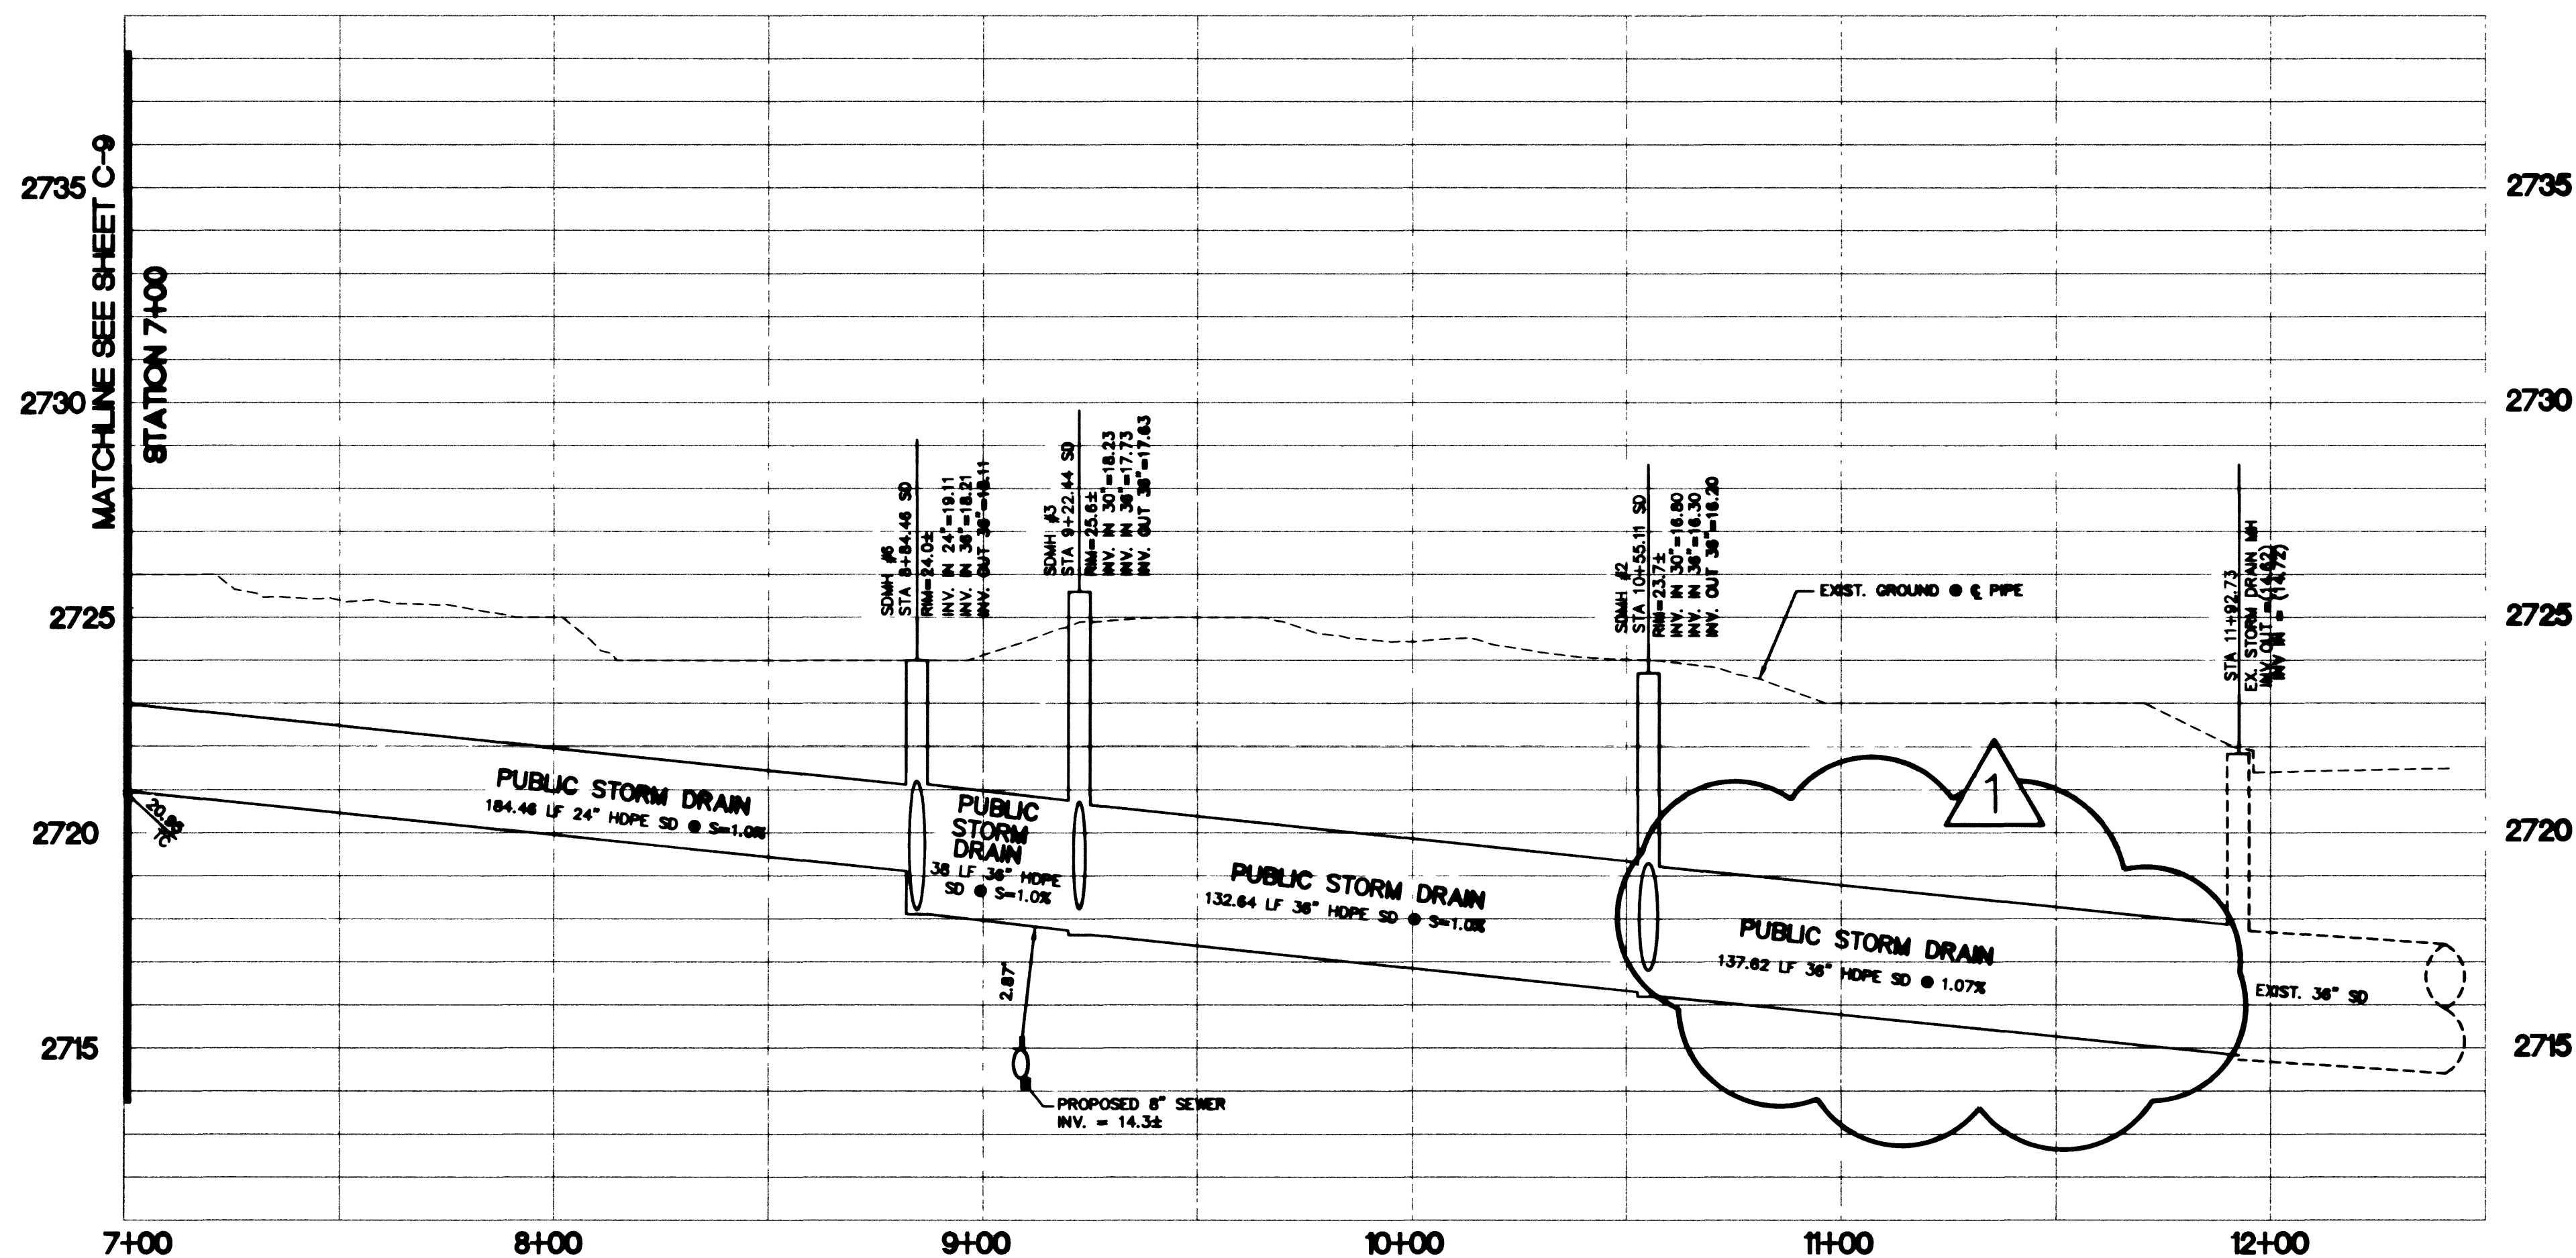

REV #1

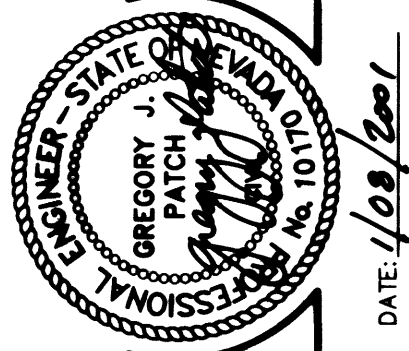

DATE: 1/09/2001

| REV | DATE      | DESCRIPTION             |
|-----|-----------|-------------------------|
| 1   | 1/09/2001 | ISSUED FOR CONSTRUCTION |

|        |       |       |            |           |           |
|--------|-------|-------|------------|-----------|-----------|
| DESIGN | DRAWN | CHECK | ISSUE DATE | PLOT DATE | PLOT TIME |
|        |       |       | 01-09-01   | 07-09-01  | 07:09:55  |

G.C. WALLACE, INC.  
Engineers/Planners/Surveyors  
1000 S. RAMPART BLVD., SUITE 200  
LAS VEGAS, NV 89102  
TELEPHONE: (702) 864-2000 FAX: (702) 864-2289  
H:\063\PARCEL-E\dwg\improvement\PARC010.dwg kaimposon

THE HOWARD HUGHES CORPORATION  
PARCEL E  
STORM DRAIN  
PLAN + PROFILE I

SHEET  
C-10  
10 OF 10 SHEETS

# DRAINAGE CERTIFICATION

I CERTIFY THESE GRADING PLANS ARE IN CONFORMANCE WITH THE APPROVED DRAINAGE STUDY ON FILE WITH THE CITY OF LAS VEGAS FOR THIS PROJECT.

Gregory J. Patch 10170 1/09/01  
GREGORY J. PATCH P.E. NO. DATE

SEE UTILITY SHEET C-4  
FOR STORM DRAIN NOTES

