
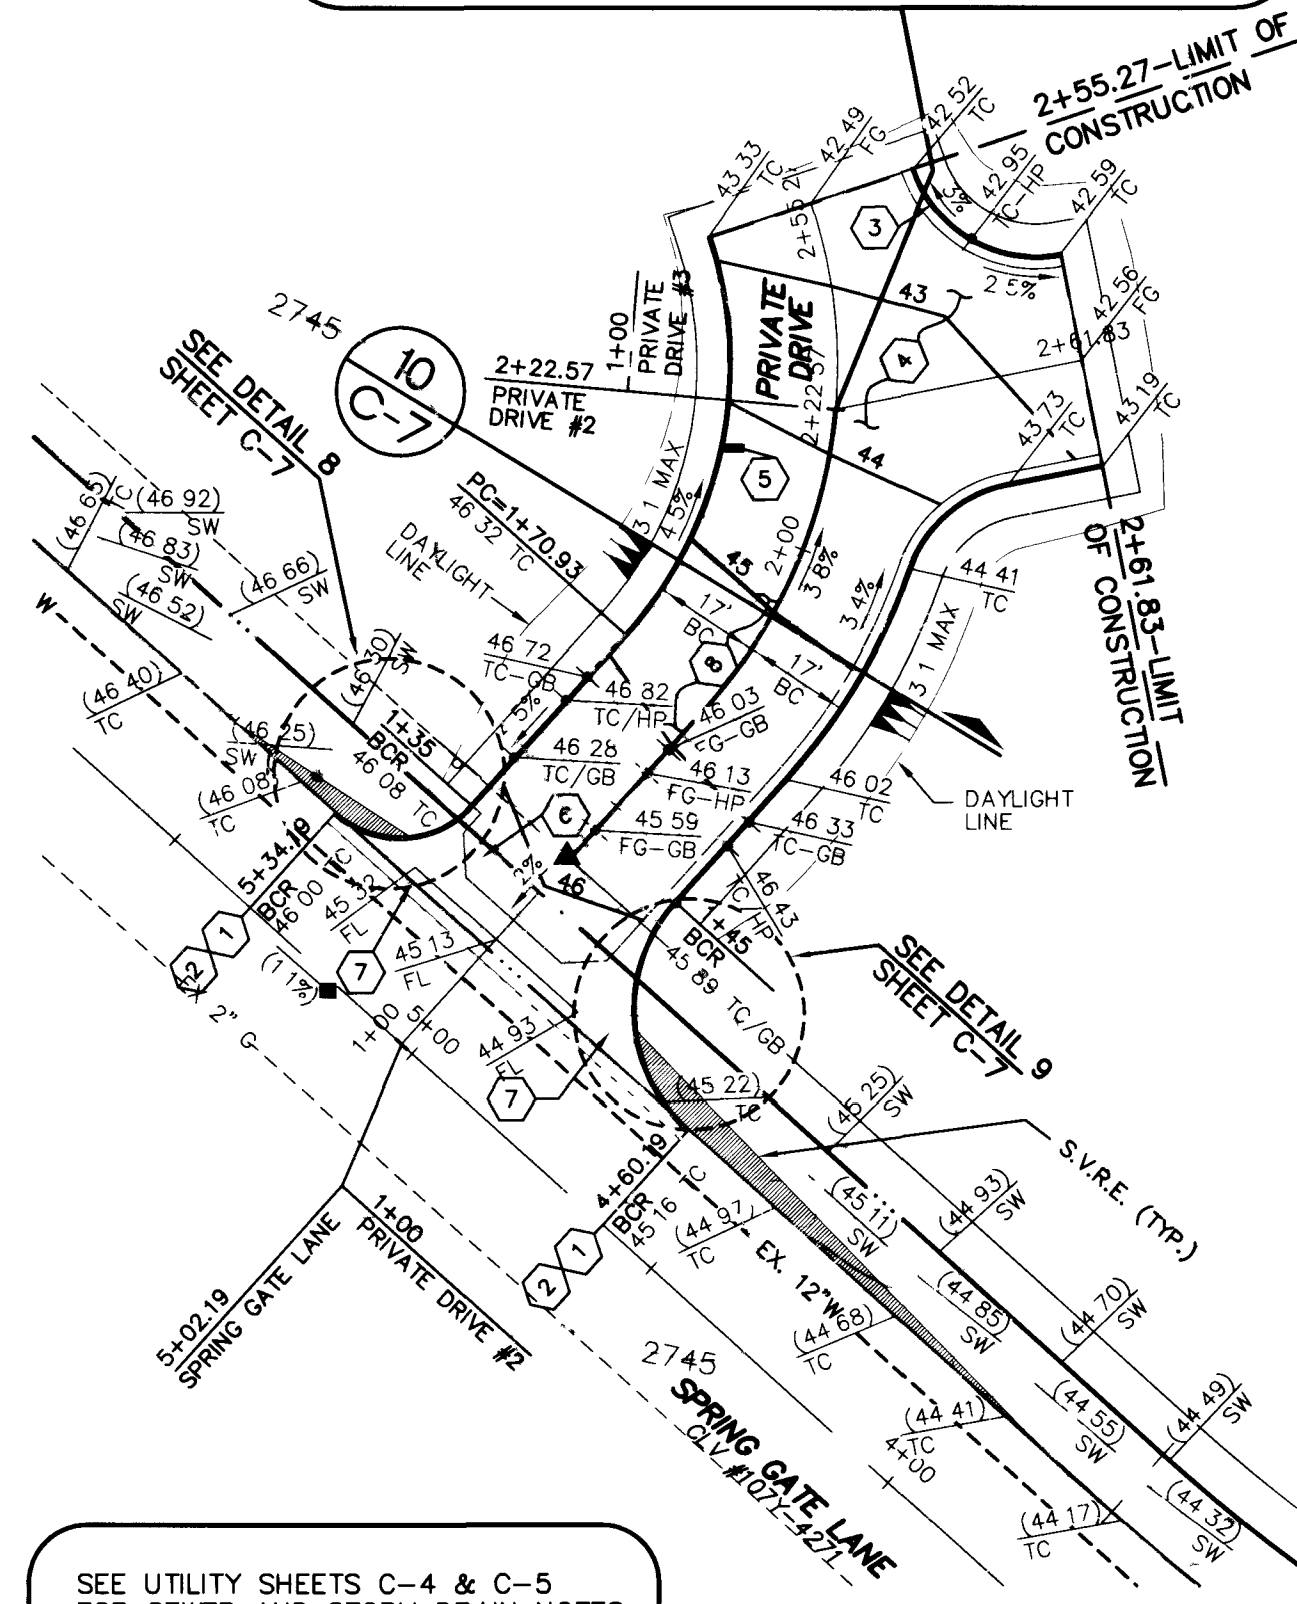


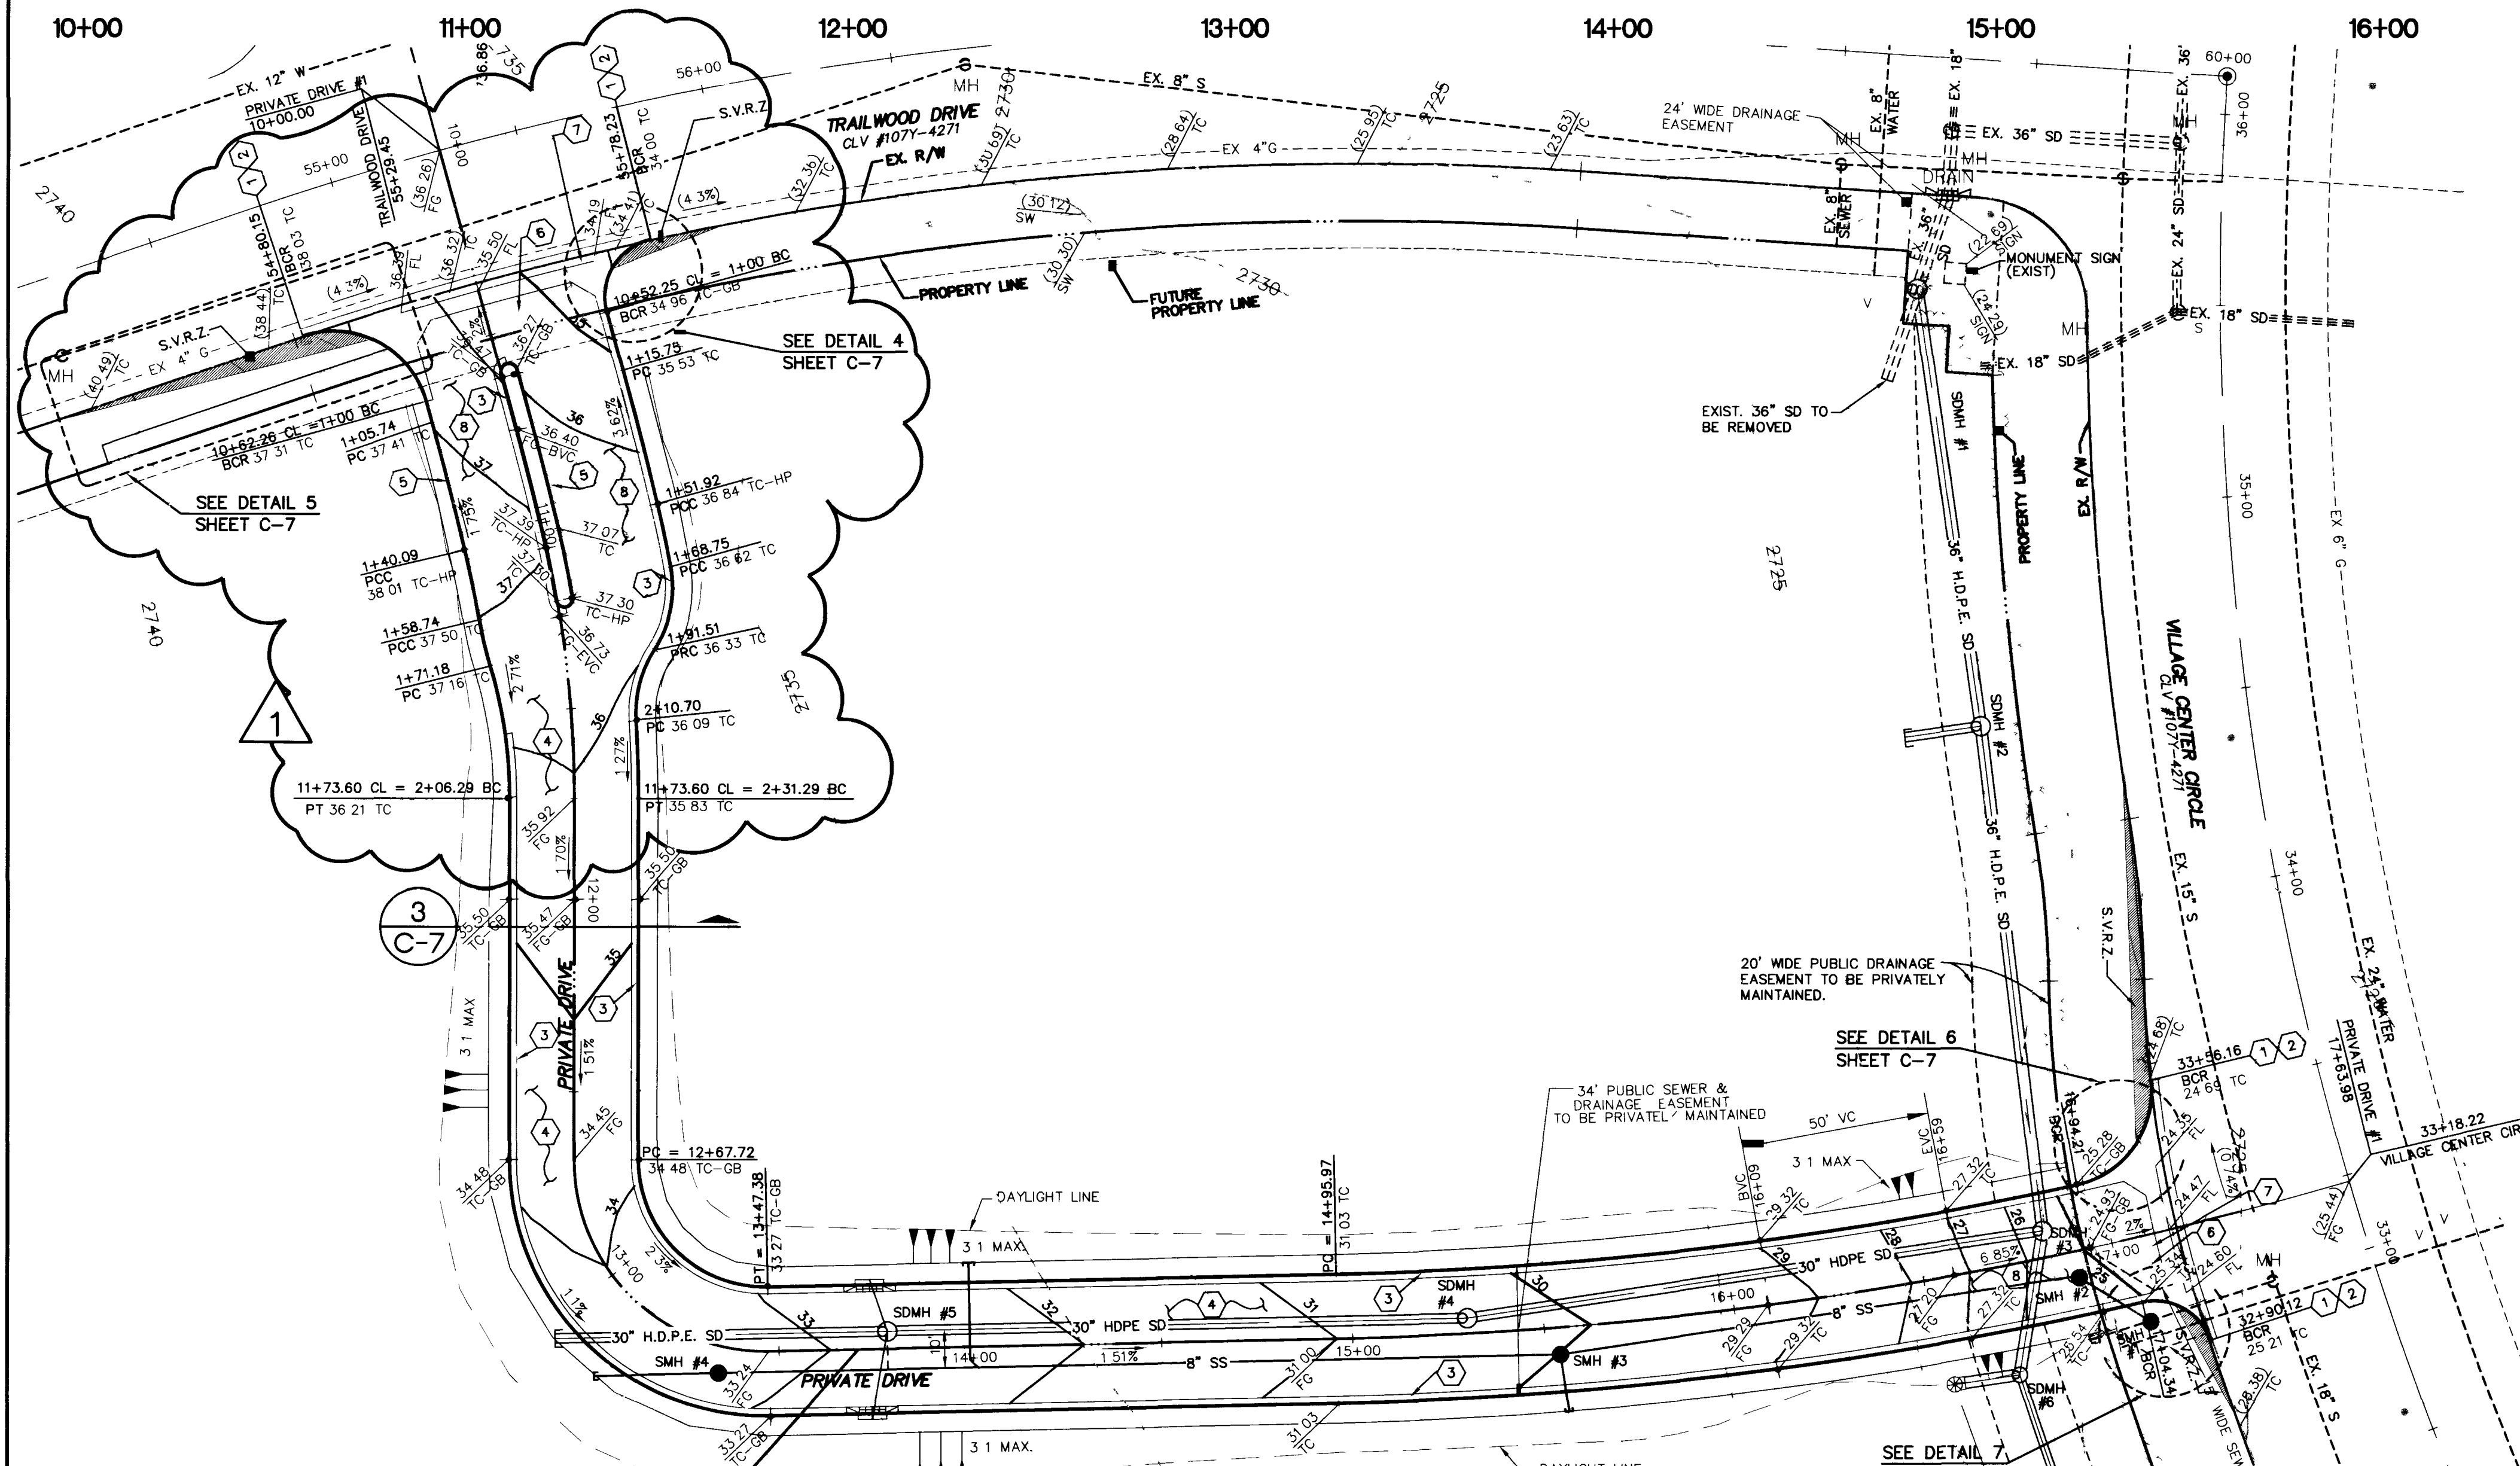

Avoid cutting underground utility lines. It's costly.

**Call  
before you  
Dig.**

**1-800-227-2600**

**UNDERGROUND SERVICE (USA)**