
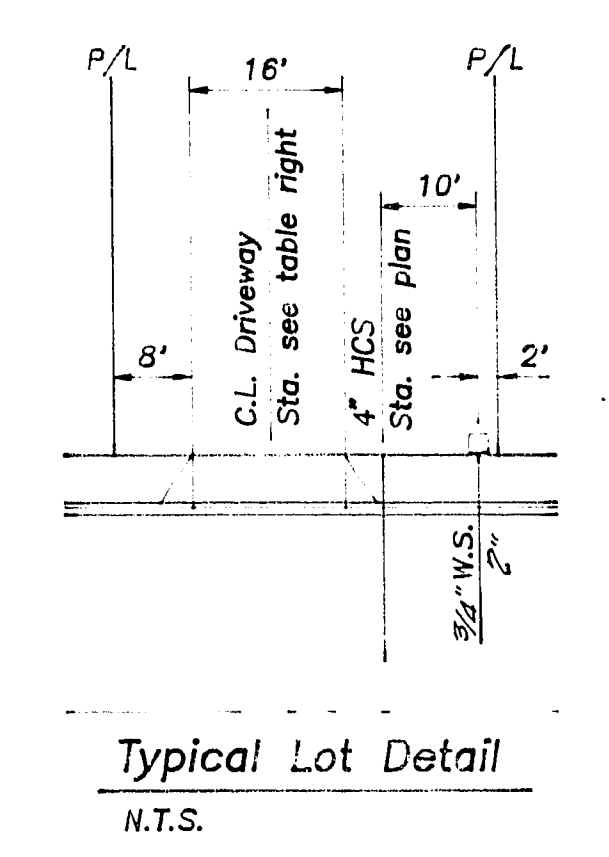


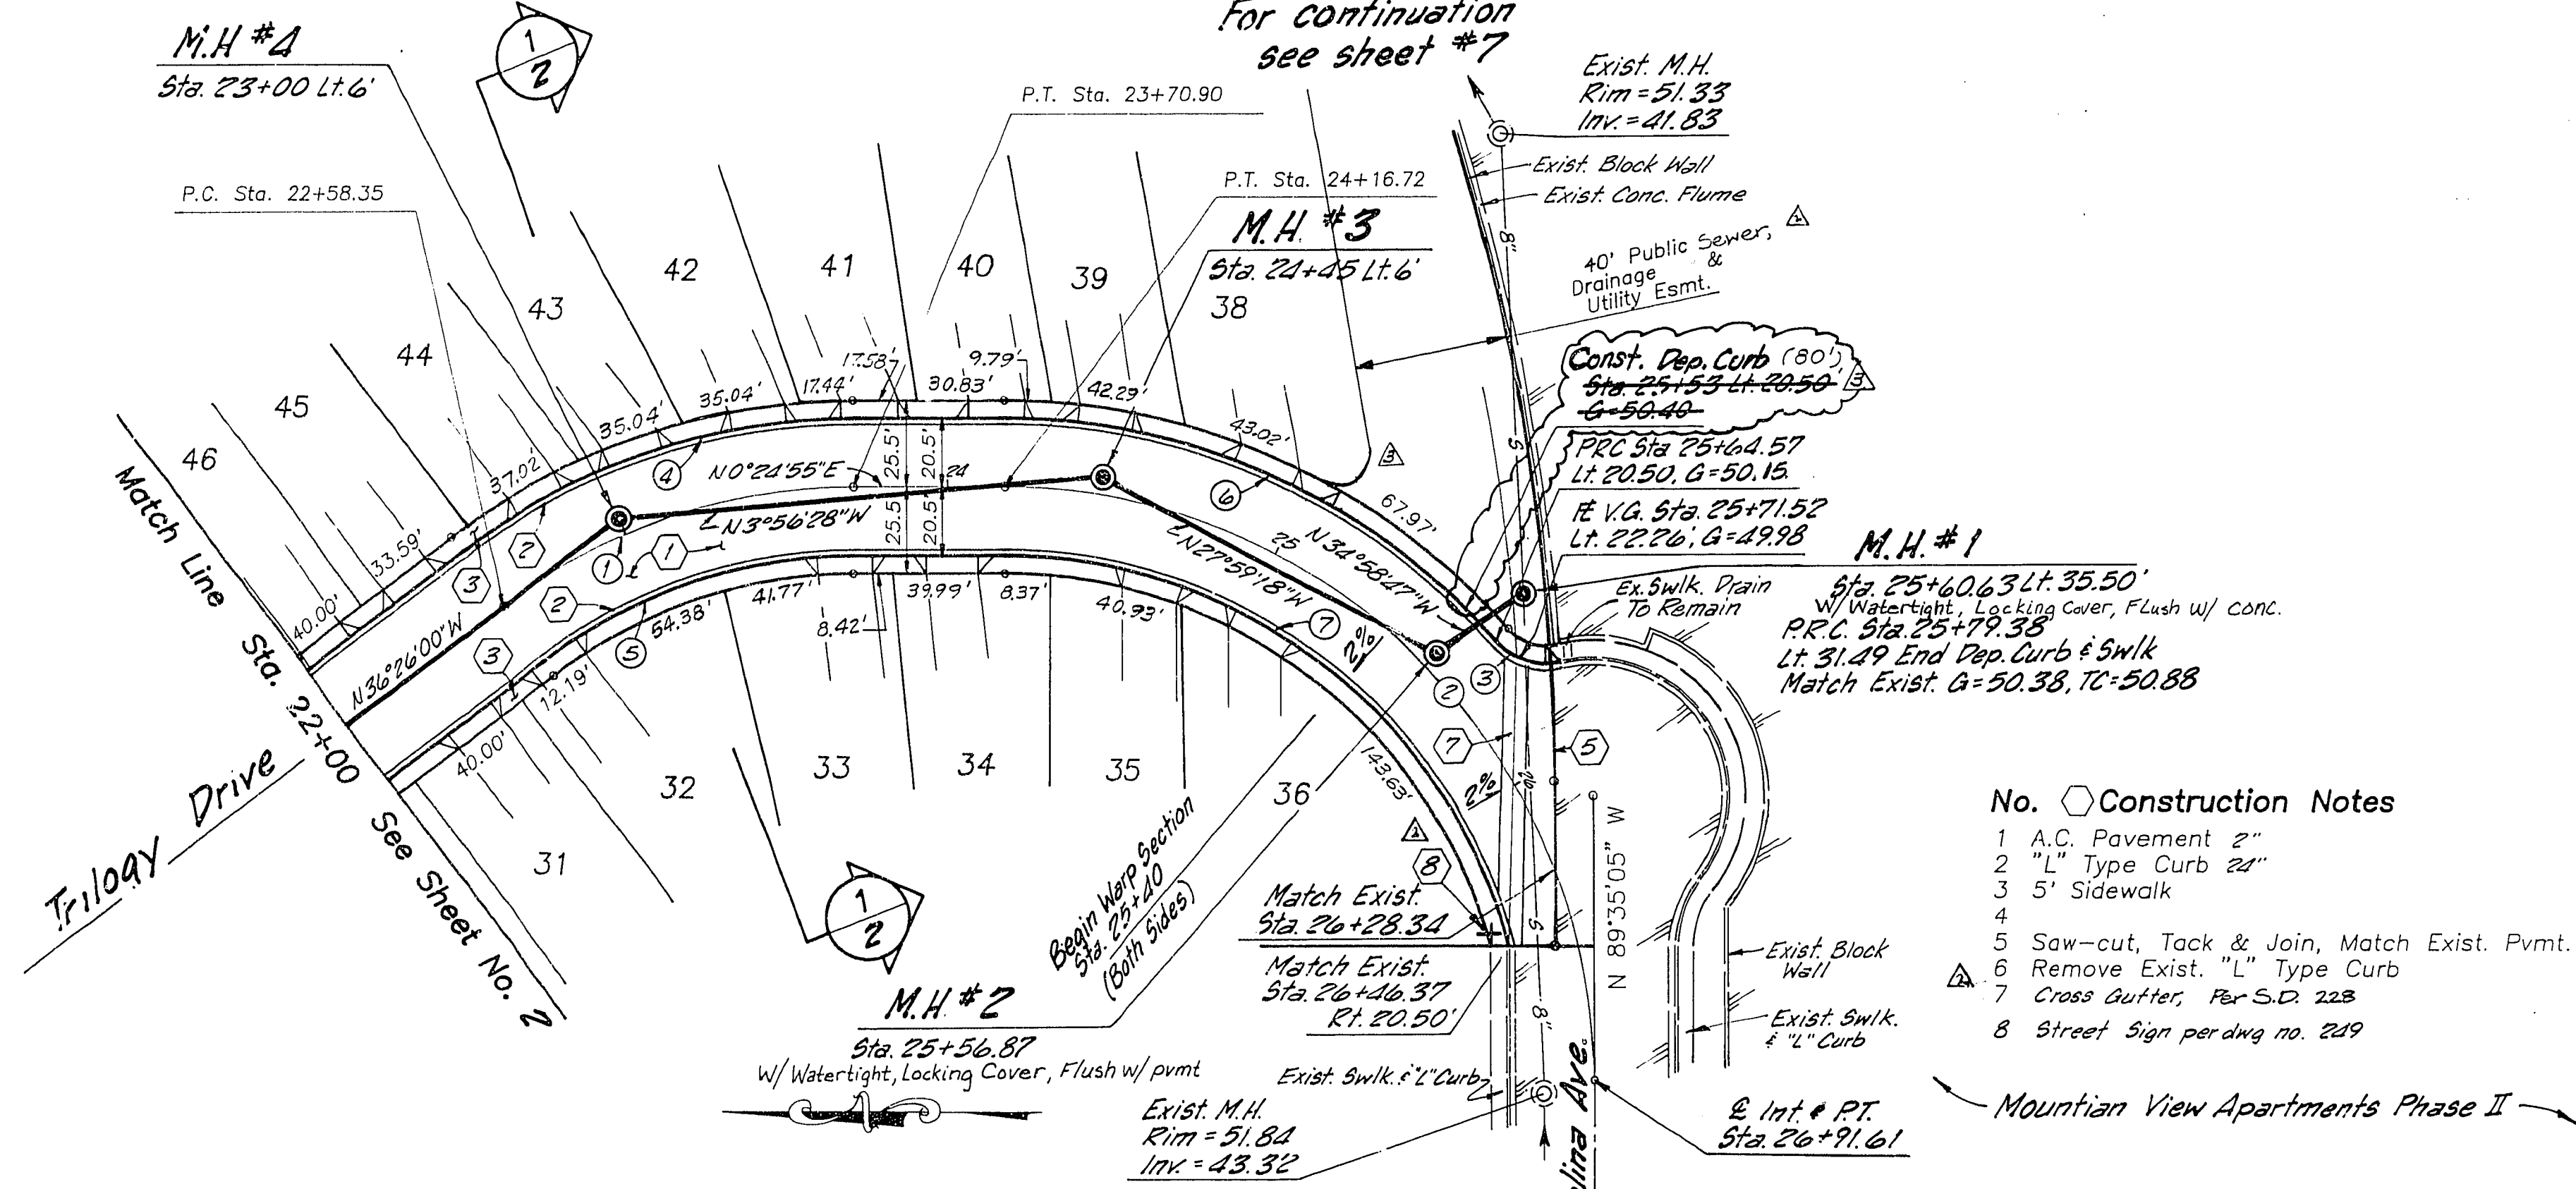

DRIVEWAY LOCATIONS

LOT NO.	STATION	STATION
1	10+51.55	10+64.70
2	10+79.16	10+91.67
3	11+11.98	11+26.11
4	11+42.11	11+58.11
5	11+90.11	12+06.11
6	12+22.11	12+38.11
7	12+70.11	12+86.11
8	13+02.11	13+18.11
9	13+46.11	13+64.11
10	13+80.11	13+96.11
11	14+28.11	14+44.11
12	14+60.11	14+76.11
13	15+10.17	15+27.33
14	15+44.58	15+61.95
15	15+92.91	16+05.28
16	16+23.50	16+38.67
17	16+65.17	16+84.17
18	17+00.17	17+16.17
19	17+46.17	17+62.17
20	17+78.17	17+94.17
21	18+26.17	18+42.17
22	18+58.17	18+74.17
23	19+06.17	19+22.17
24	19+38.17	19+54.17
25	19+64.17	20+00.17
26	20+16.17	20+32.17
27	20+64.17	20+80.17
28	20+96.17	21+12.17
29	21+42.17	21+58.17
30	21+74.17	21+90.17
31	22+22.17	22+38.17
32	22+54.17	22+72.19
33	22+55.98	23+76.79
34	23+92.39	24+88.99
35	24+52.29	24+76.63
36	24+97.19	25+18.80

DRIVEWAY LOCATIONS

LOT NO.	STATION	STATION
37	25+14.37	25+34.07
38	24+79.82	24+86.48
39	24+36.04	24+50.76
40	24+06.15	24+21.67
41	23+67.60	23+84.52
42	23+90.30	24+06.15
43	23+04.63	23+19.28
44	22+76.19	22+90.30
45	22+32.76	22+48.76
46	22+00.76	22+16.76
47	21+54.76	21+70.76
48	21+22.76	21+38.76
49	20+74.76	20+96.76
50	20+42.76	20+58.76
51	19+94.76	20+10.76
52	19+62.76	19+78.76
53	19+16.76	19+32.76
54	18+84.76	19+00.76
55	18+36.76	18+52.76
56	18+04.76	18+20.76
57	17+58.76	17+74.76
58	17+26.76	17+42.76
59	16+78.76	16+94.76
60	16+44.51	16+61.62
61	15+92.68	16+10.08
62	15+60.14	15+75.57
63	15+14.45	15+29.60
64	14+84.29	14+99.35
65	14+36.70	14+52.70
66	14+04.70	14+20.70
67	13+58.70	13+74.70
68	13+26.70	13+42.70
69	12+70.70	12+94.70
70	12+48.70	12+62.70
71	11+88.70	12+14.70
72	11+66.70	11+82.70
73	11+26.70	11+42.70

Data to Back of curb where applicable

NO.	DELTA	RADIUS	TANGENT	LENGTH
1	36°50'55"	175.00'	58.30'	112.55'
2	90°00'00"	175.00'	175.00'	274.89'
3	60°50'11"	20.00'	11.74'	21.24'
4	36°50'55"	195.30'	65.13'	125.73'
5	36°50'55"	154.50'	51.47'	99.36'
6	48°24'20"	195.50'	87.87'	165.17'
7	75°11'14"	154.50'	118.95'	202.74'

