


**RETAINING WALL SCHEDULE**


WALL HEIGHT	LOT #S
1.5'	5, 6, 17-22, 24-25, 28-30, 34-36
2.0'	7, 8, 13-16, 23, 26, 27, 31-33
2.5'	9-12

**CURVE DATA**

NO.	DELTA	RADIUS	TANGENT	LENGTH
1	34°47'49"	135.00'	42.30'	81.99'
2	14°12'55"	407.22'	50.78'	101.03'
3	14°12'55"	407.22'	50.78'	101.03'
4	36°50'55"	175.00'	58.30'	112.55'
5	90°00'00"	175.00'	175.00'	274.89'

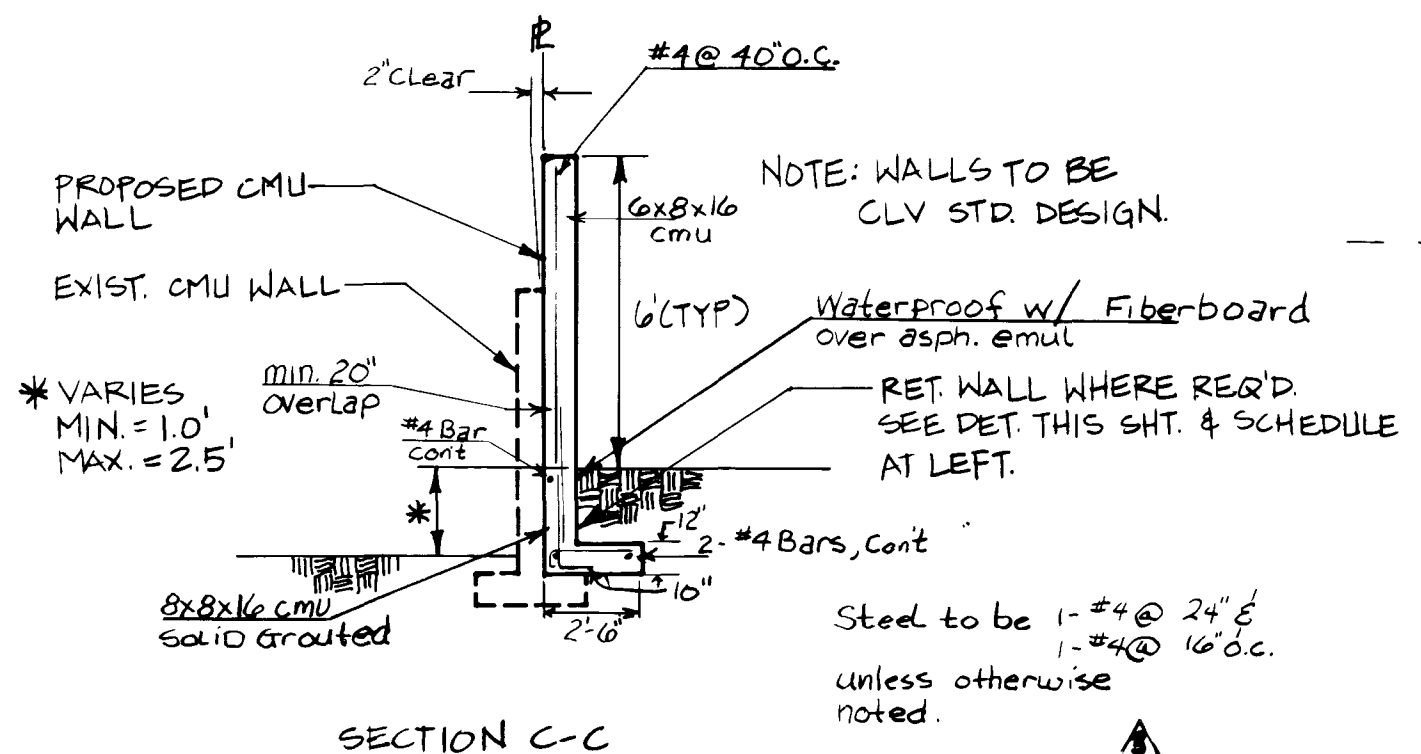

**Rancho Road**

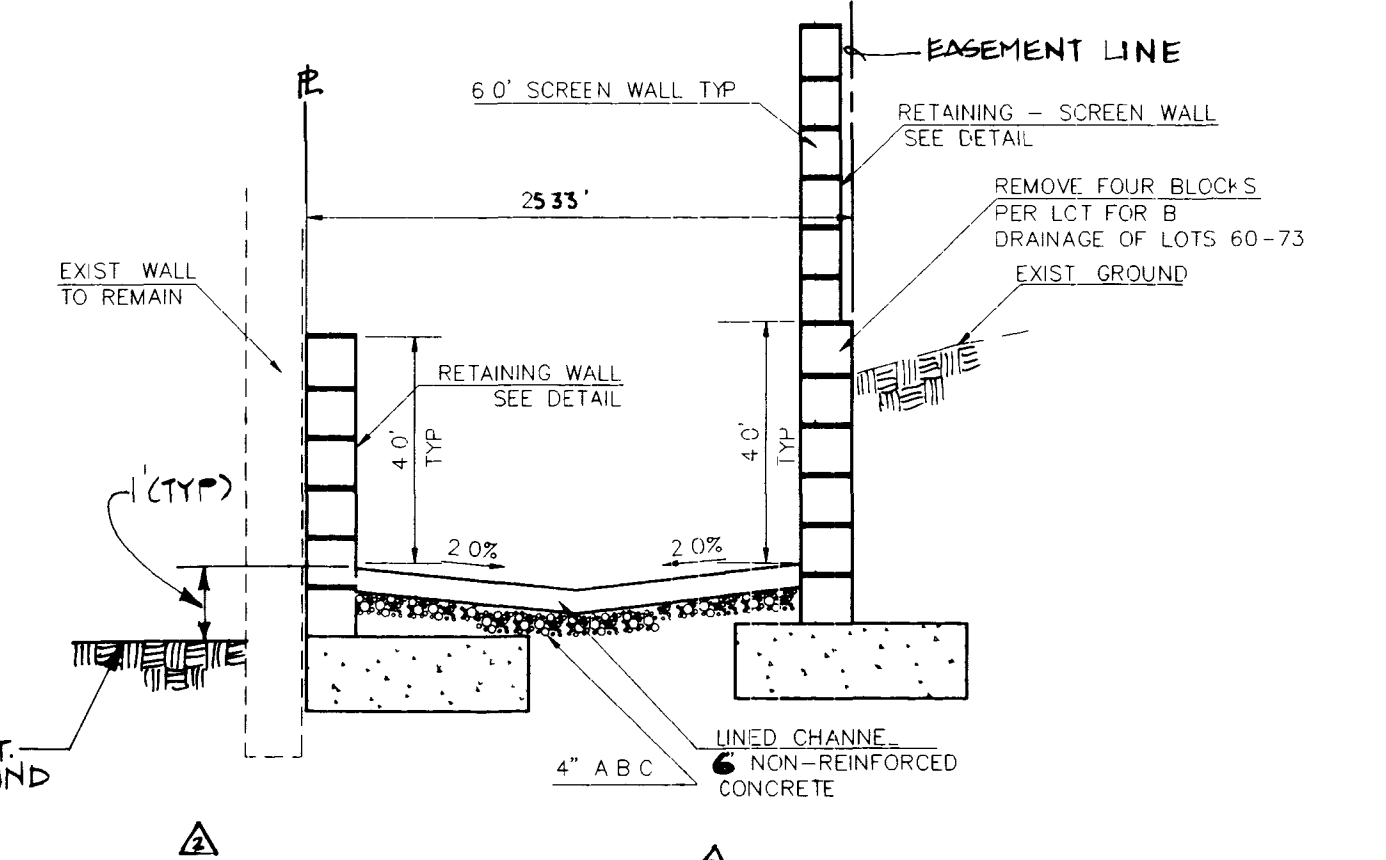

Match Line See Sheet No. 5


INSPECTIONS REQUIRED

- FOOTING PRIOR TO PLACING CONCRETE
- WALL STEEL AT EACH CHANGE OF BLOCK SIZE BEFORE GROUTING
- FINAL INSPECTION AFTER COMPLETION


TYPICAL SECTION - 5' MAX.

H	S	T	B	X	Y
3'	6"	8"	3/8"	#4@32" OC	#4@24" OC
4'	6"	8"	3/8"	#4@24" OC	#4@16" OC
5'	6"	6"	3/16"	#5@16" OC	#5@16" OC

**TYP. RETAINING WALL DETAIL**

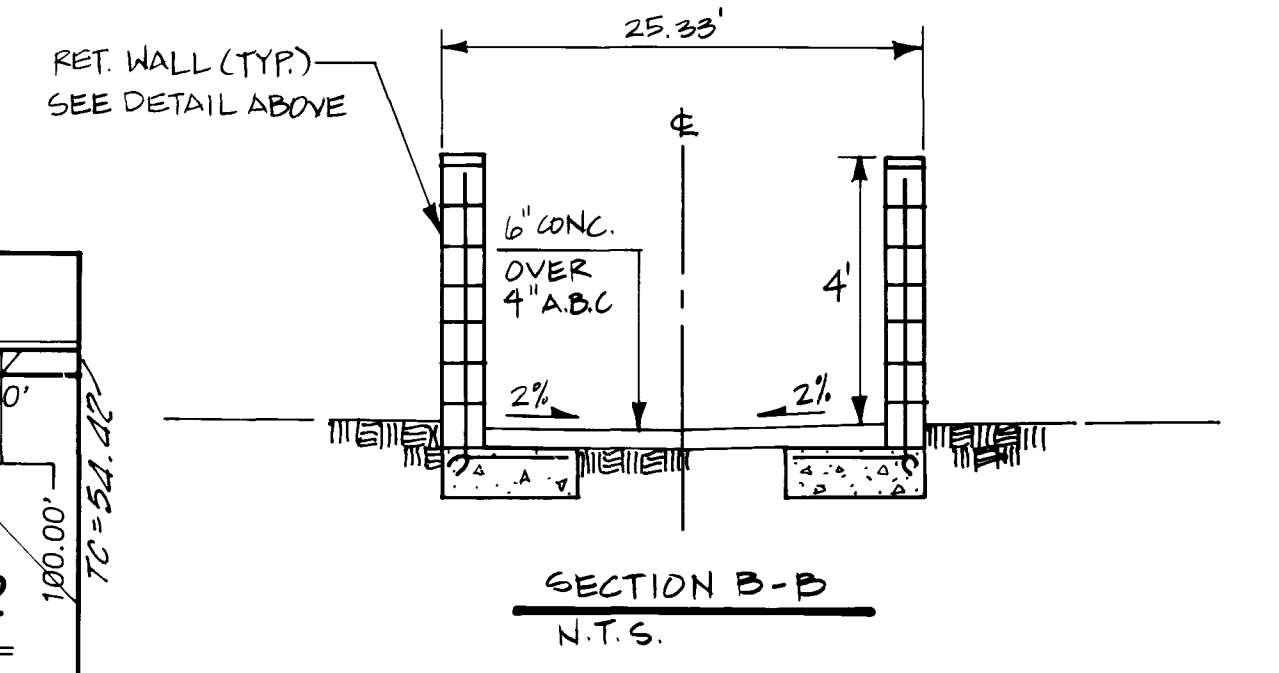

"I CERTIFY THAT THIS GRADING PLAN IS IN CONFORMANCE WITH THE APPROVED DRAINAGE STUDY ON FILE AT THE CITY OF LAS VEGAS FOR THIS PROJECT."

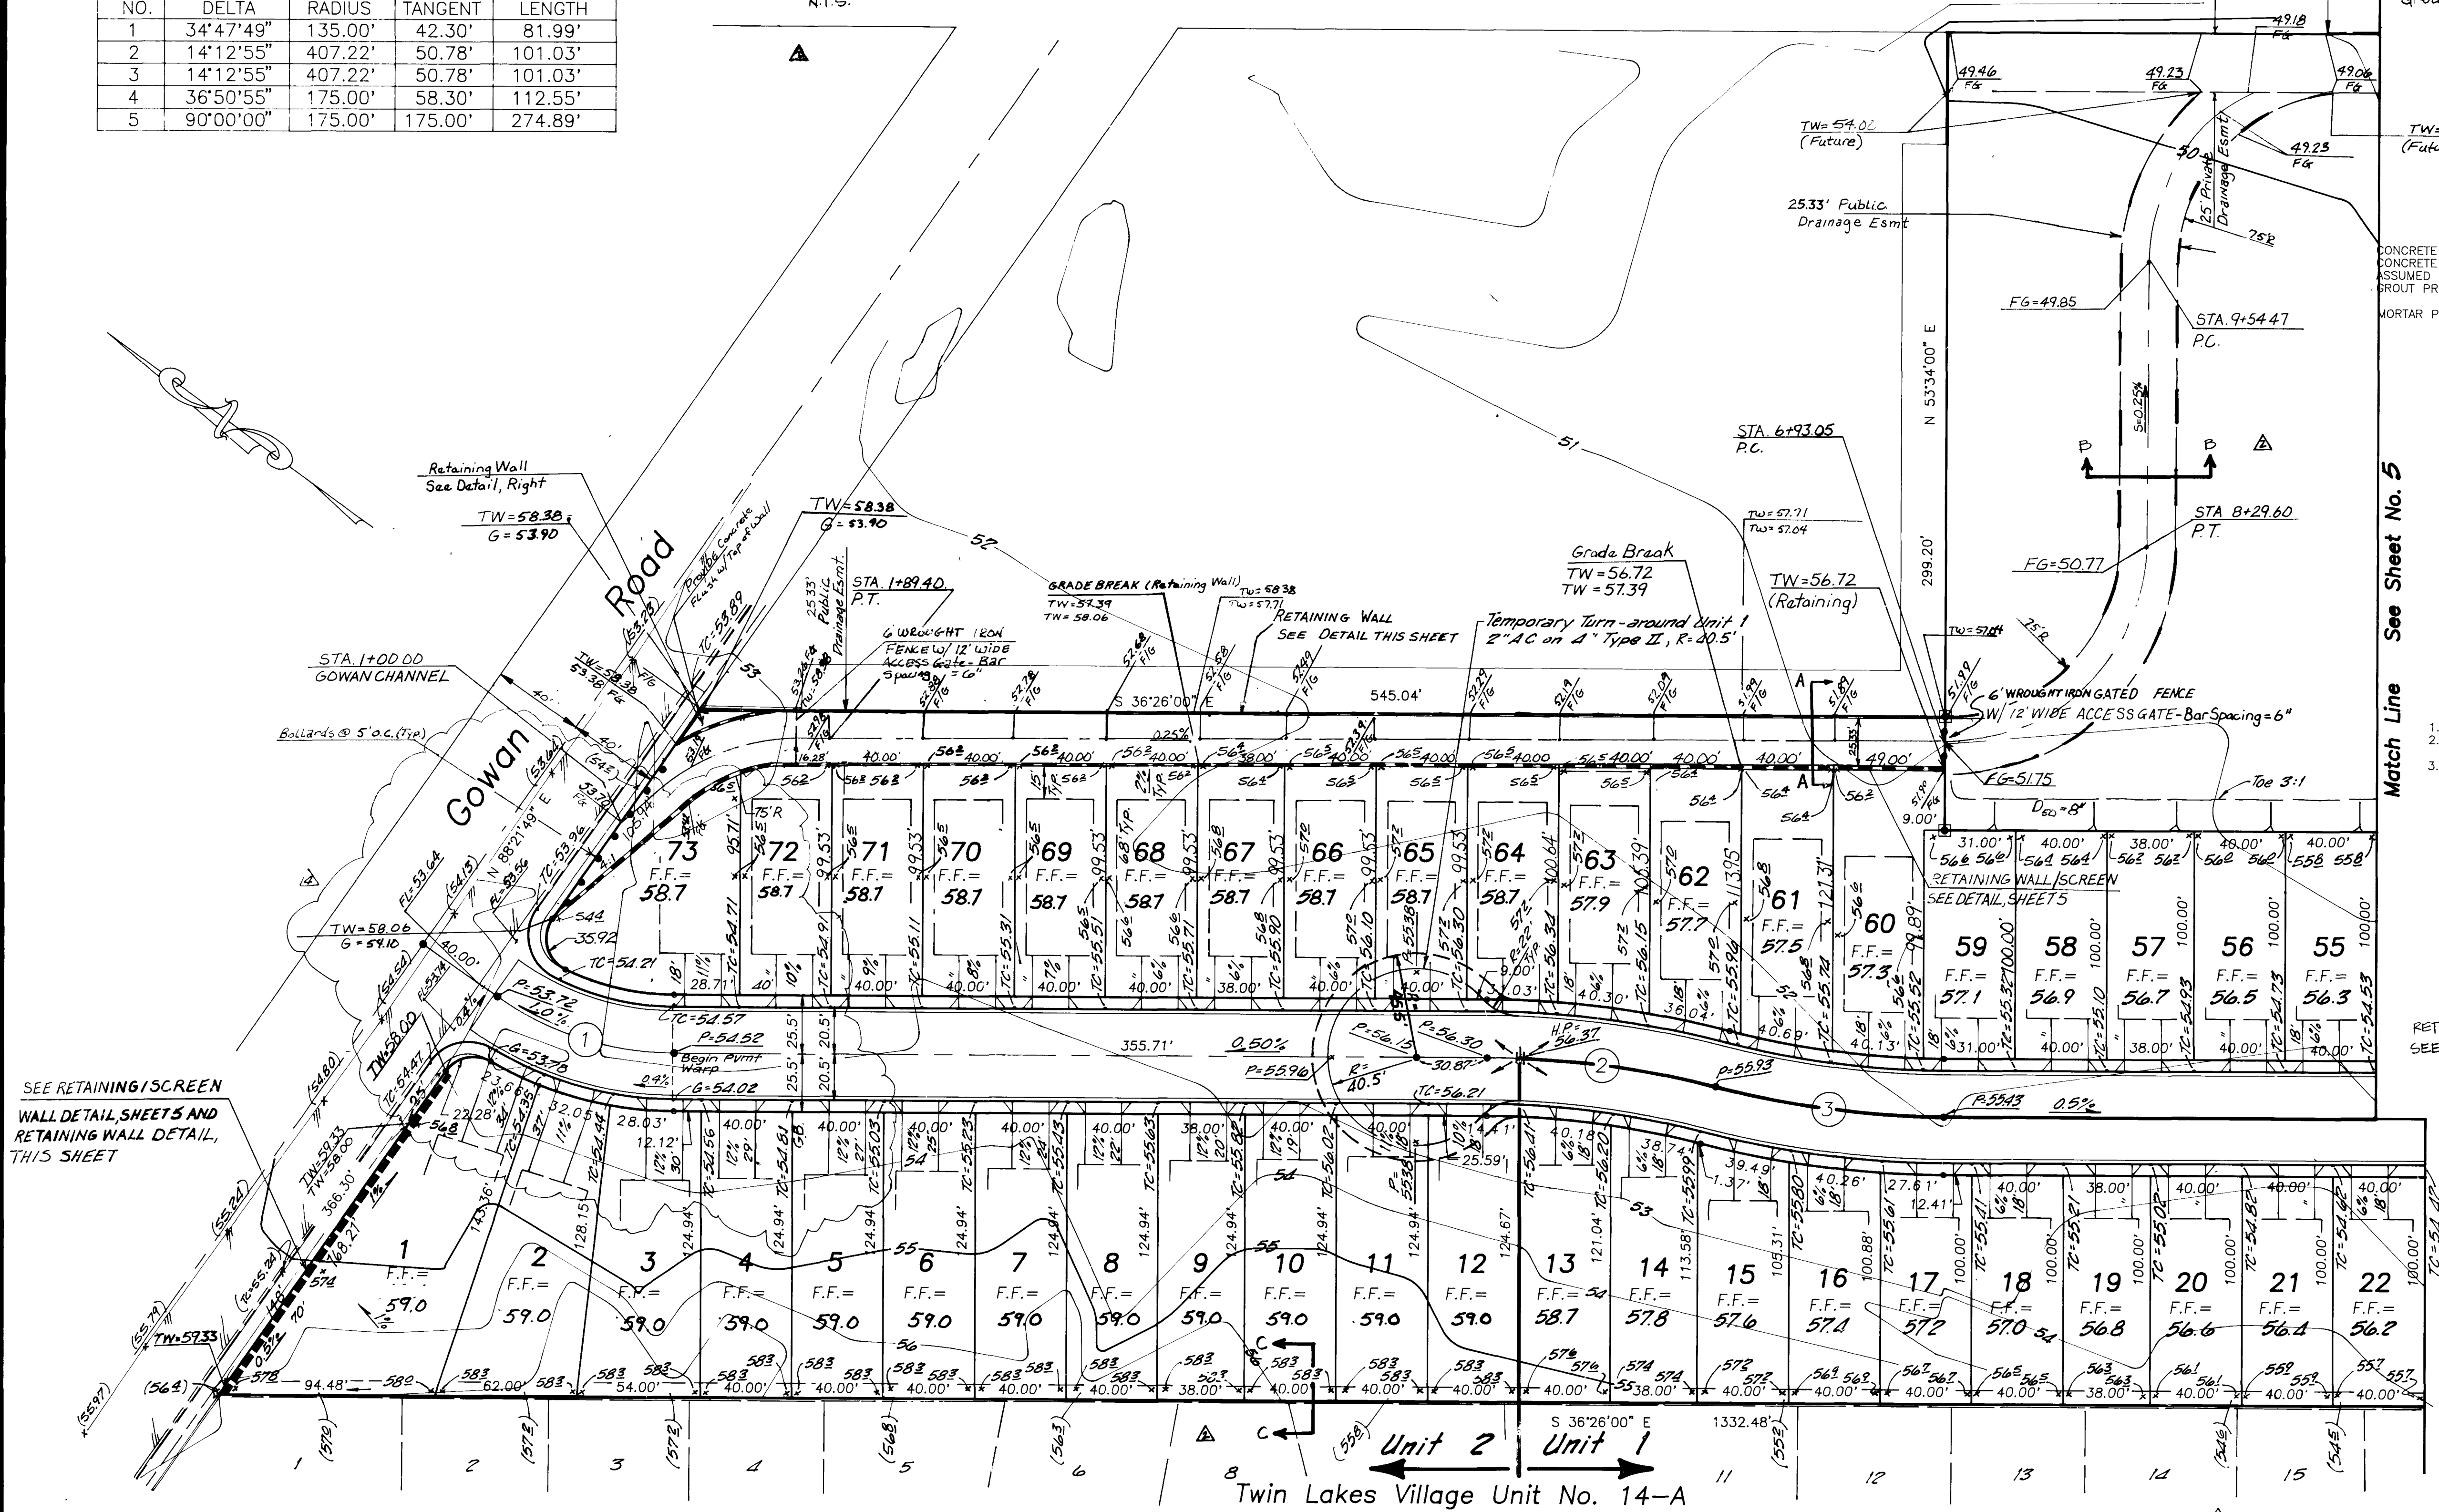

Engineering - Planning - Surveying  
Landscape Architecture - Urban Design  
Offices located in Tucson, Phoenix  
Las Vegas, and Victor Valley, CA

Trilogy

Grading & Drainage Plan

No.	Date	Item	Scale
1	4/21/94	MRO	FF. ELEV. - LOTS 1-12, 68-73
2	9-8-94	ADD SECTIONS	
3	10-11-94	CLARIFY SECTION C-C WALL DETAIL	

Job No. 193019-A-001  
Date 8/93  
Drawn by RCH  
Checked by ROB



SECTION 101.000  
 JUNE 1962  
 1.0' 1/4" = 1'-0"  
