




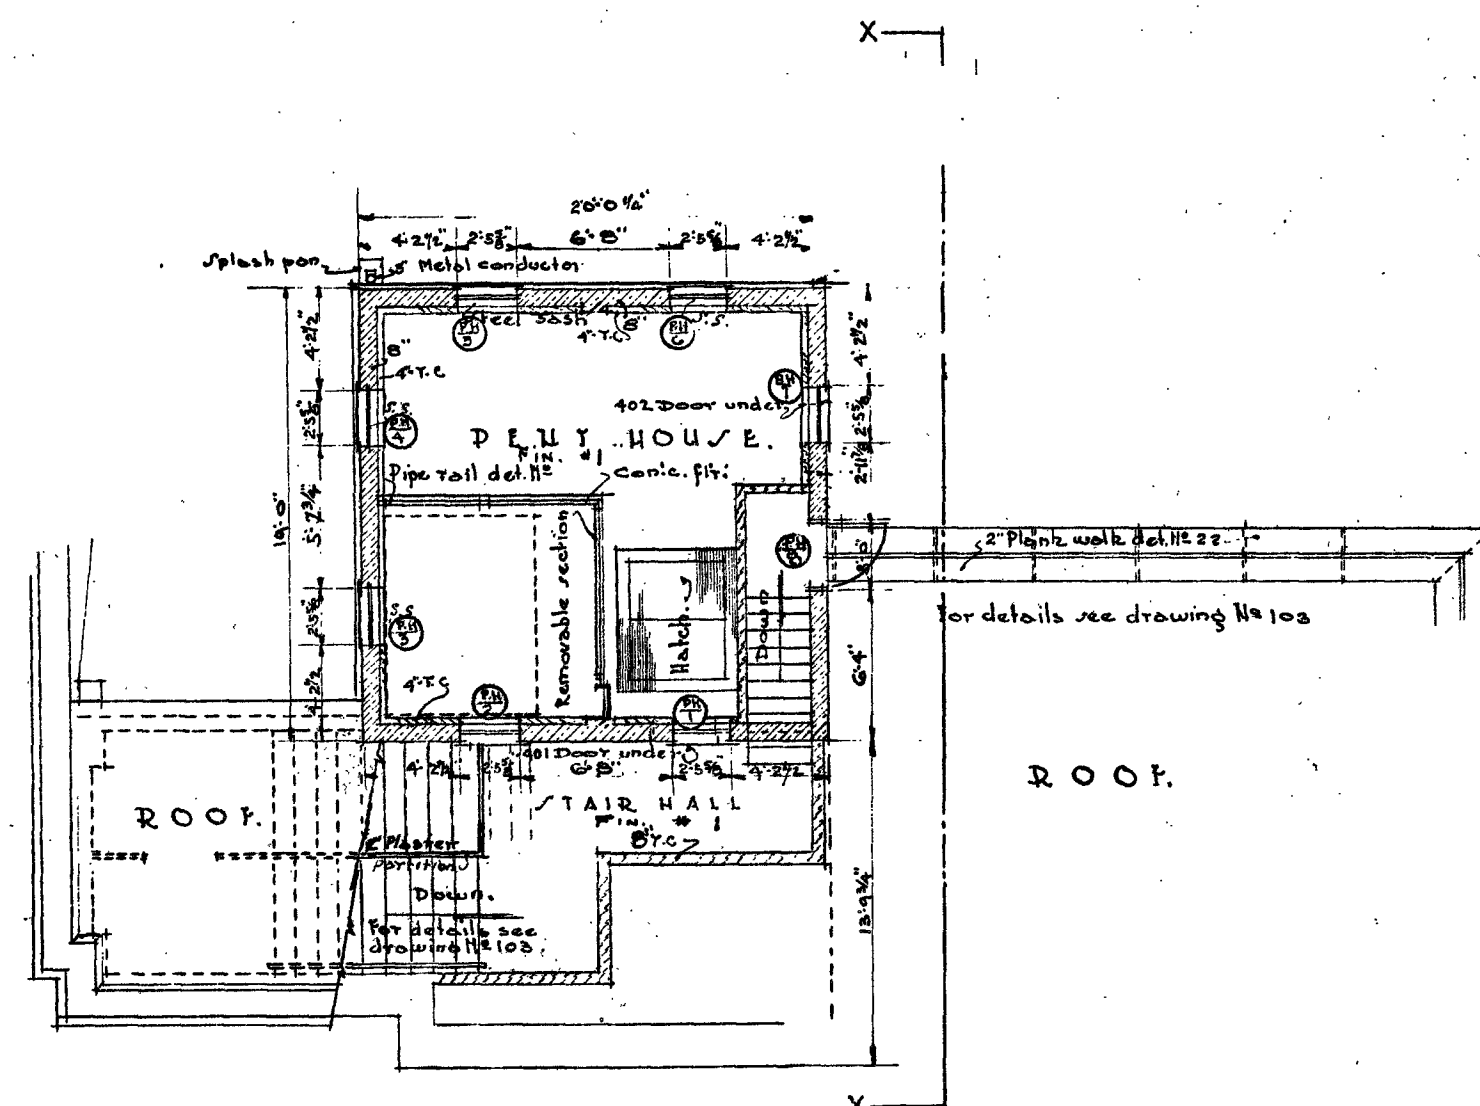

PLAN ABOVE ATTIC SLAB.
Scale 1/8"=1'-0"

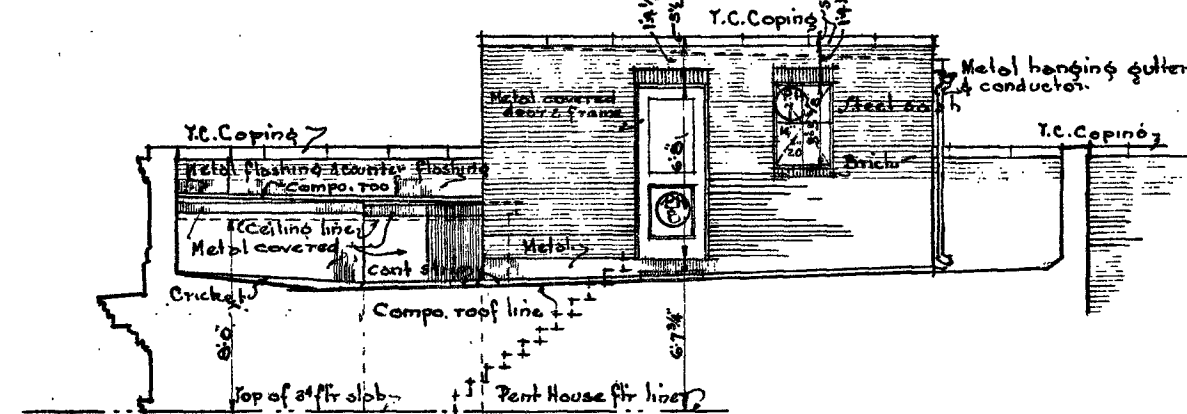


SECTION X-X
Scale 1/8"=1'-0"

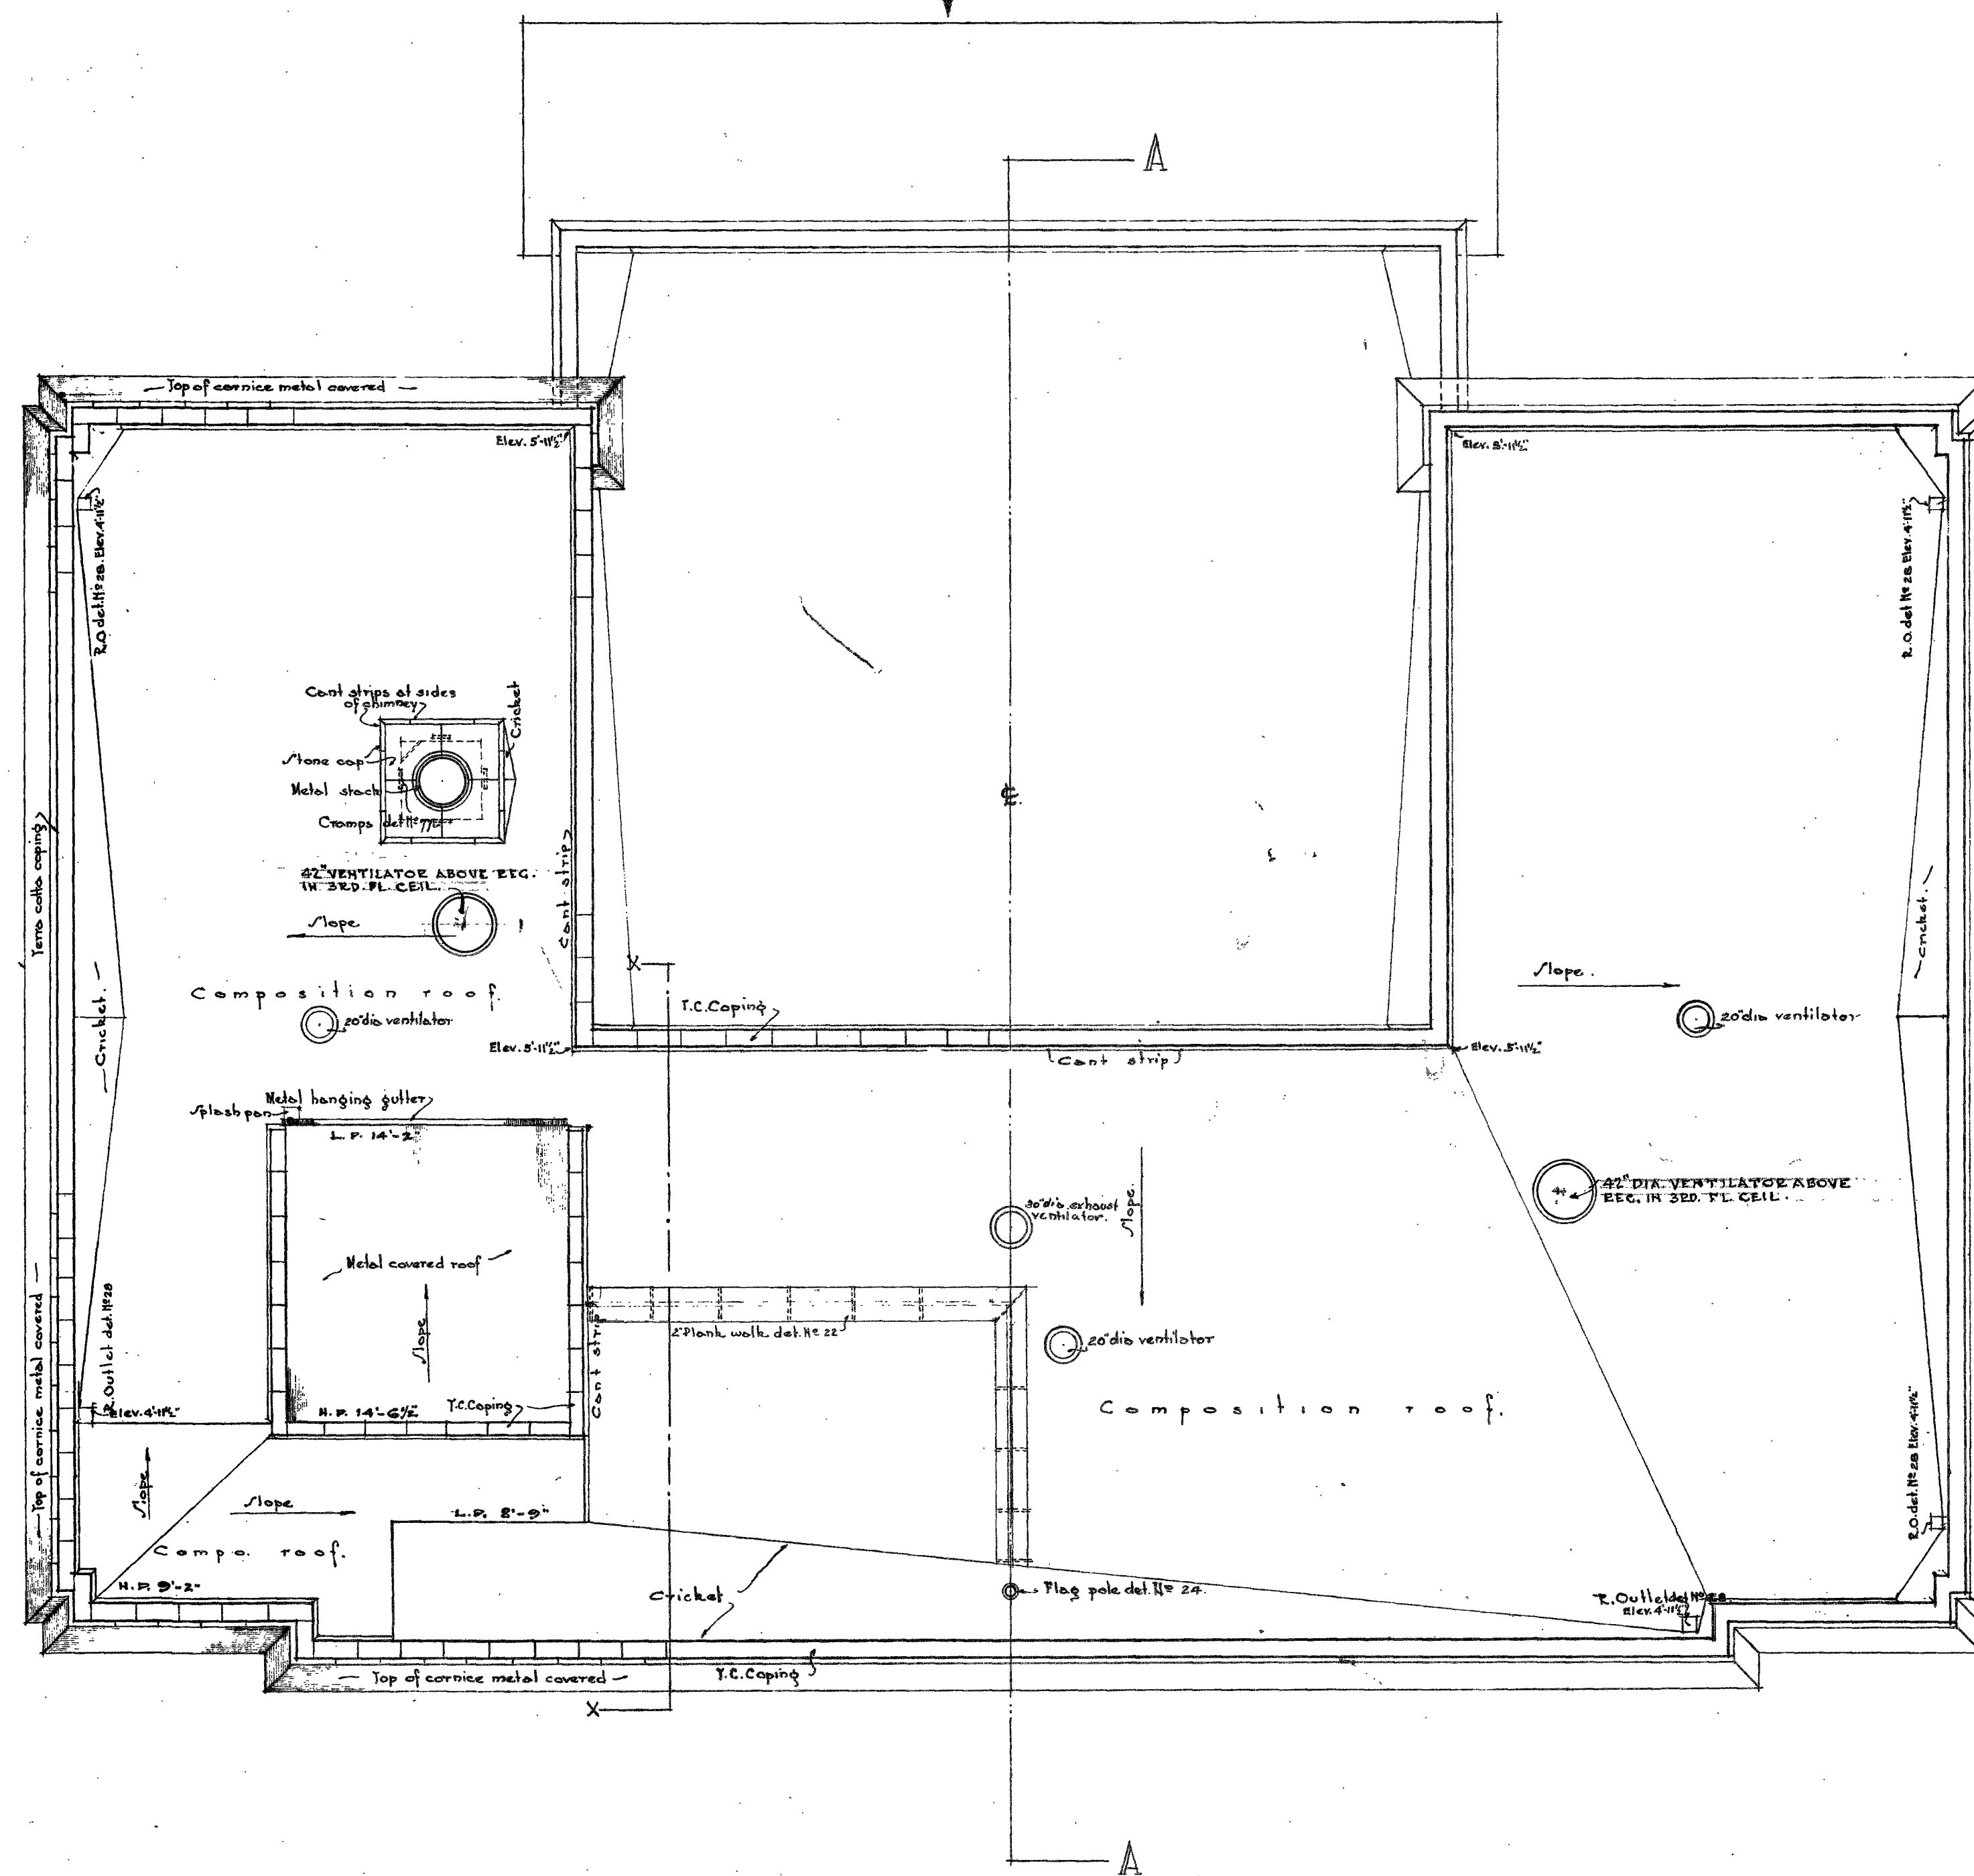


ROOF PLAN
Scale 1/8"=1'-0"

NOTES:
All roof elevations given from top of third floor ceiling slab to top of roof sheathing or concrete slab.

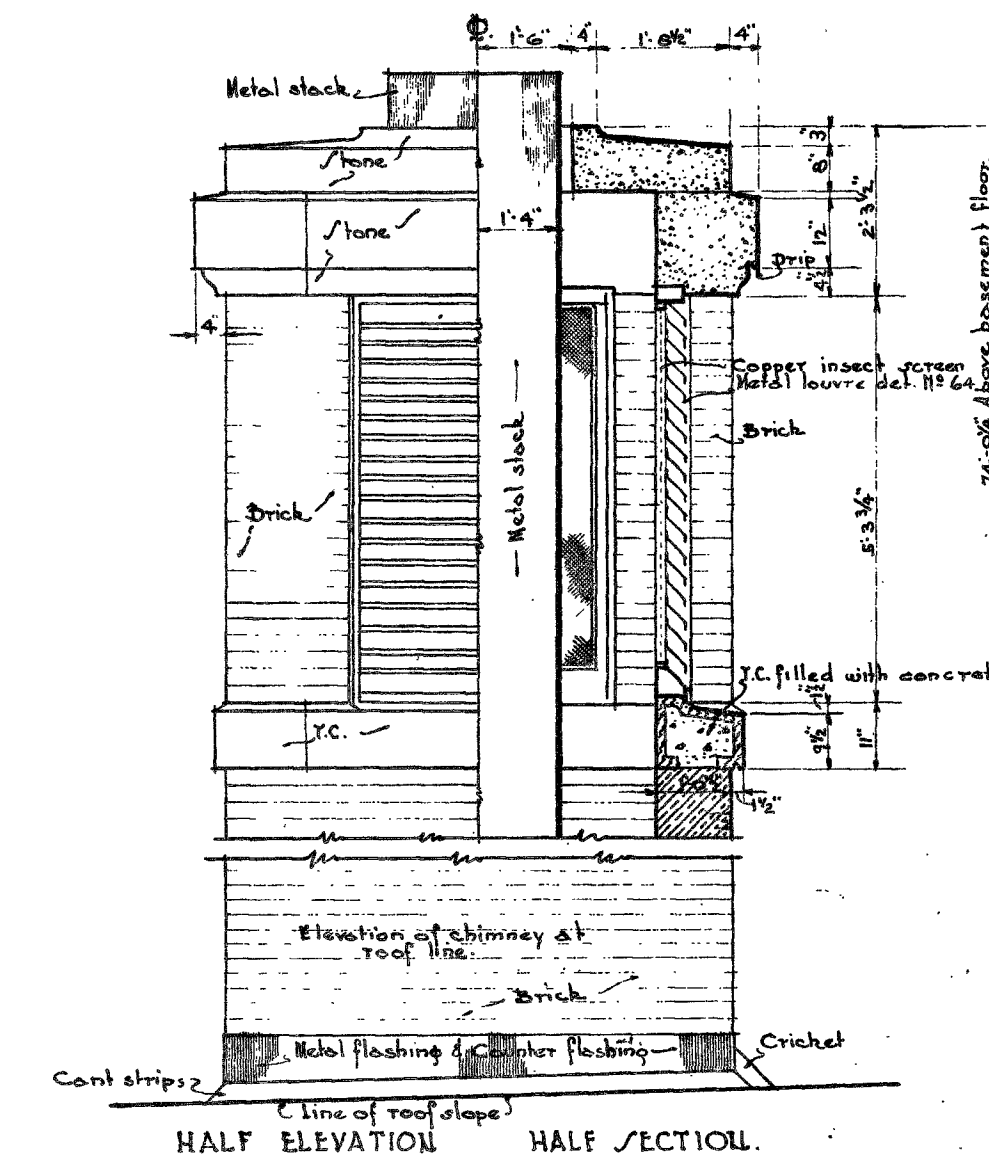

HALF ELEVATION HALF SECTION

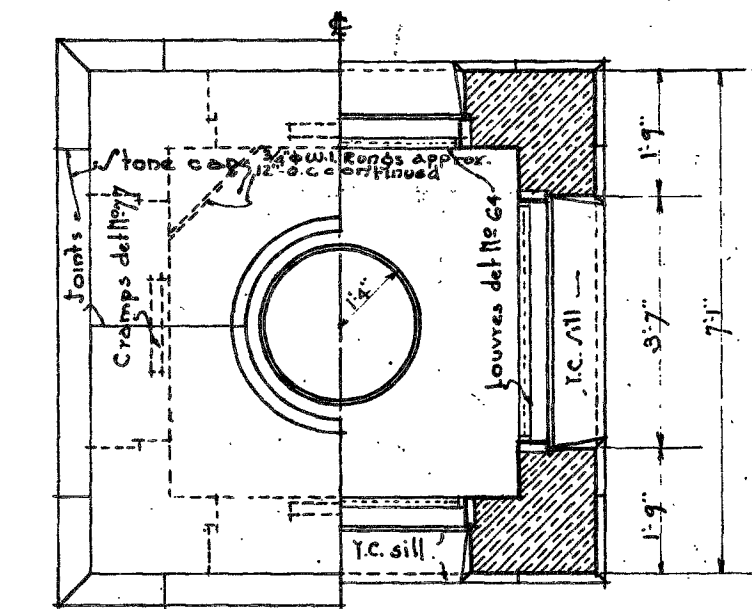

HALF PLAN OF CAP. HALF PLAN OF LOUVRE.

STACK DETAILS
Scale 3/8"=1'-0"


REVISION.
DRAWING # GSA CANCELS # G.
CHANGES -
FAN ROOM OMITTED.
21" DIA. VENTILATORS ADDED.

Scanned by GSA Region 9

FEB 3 1998

J. A. Thompson
ACTING SUPERVISING ARCHITECT
TREASURY DEPARTMENT
APPROVED: LOUIS A. SIMS
SUPT. ARCHITECTURAL DIVISION
T. C. BROOKS, 7/25/44
SUPT. STRUCTURAL DIVISION
N. S. THOMPSON
SUPT. MECHANICAL DIVISION

58498

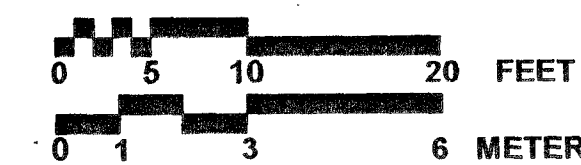

BUILDING: U.S.D.O. C.T.H. ETC.
CITY: L.A. VEGA, UEV.
DRAWN BY: S.L.P. DATE: 11-23-32
CHECKED BY: S.L.P. DATE: 11-23-32
No. 6A
521-279-1

J. M. D.
11-23-32
COR. 1/26/32

RETURN TO ROOM 411 0016 24X