


CITY PARK

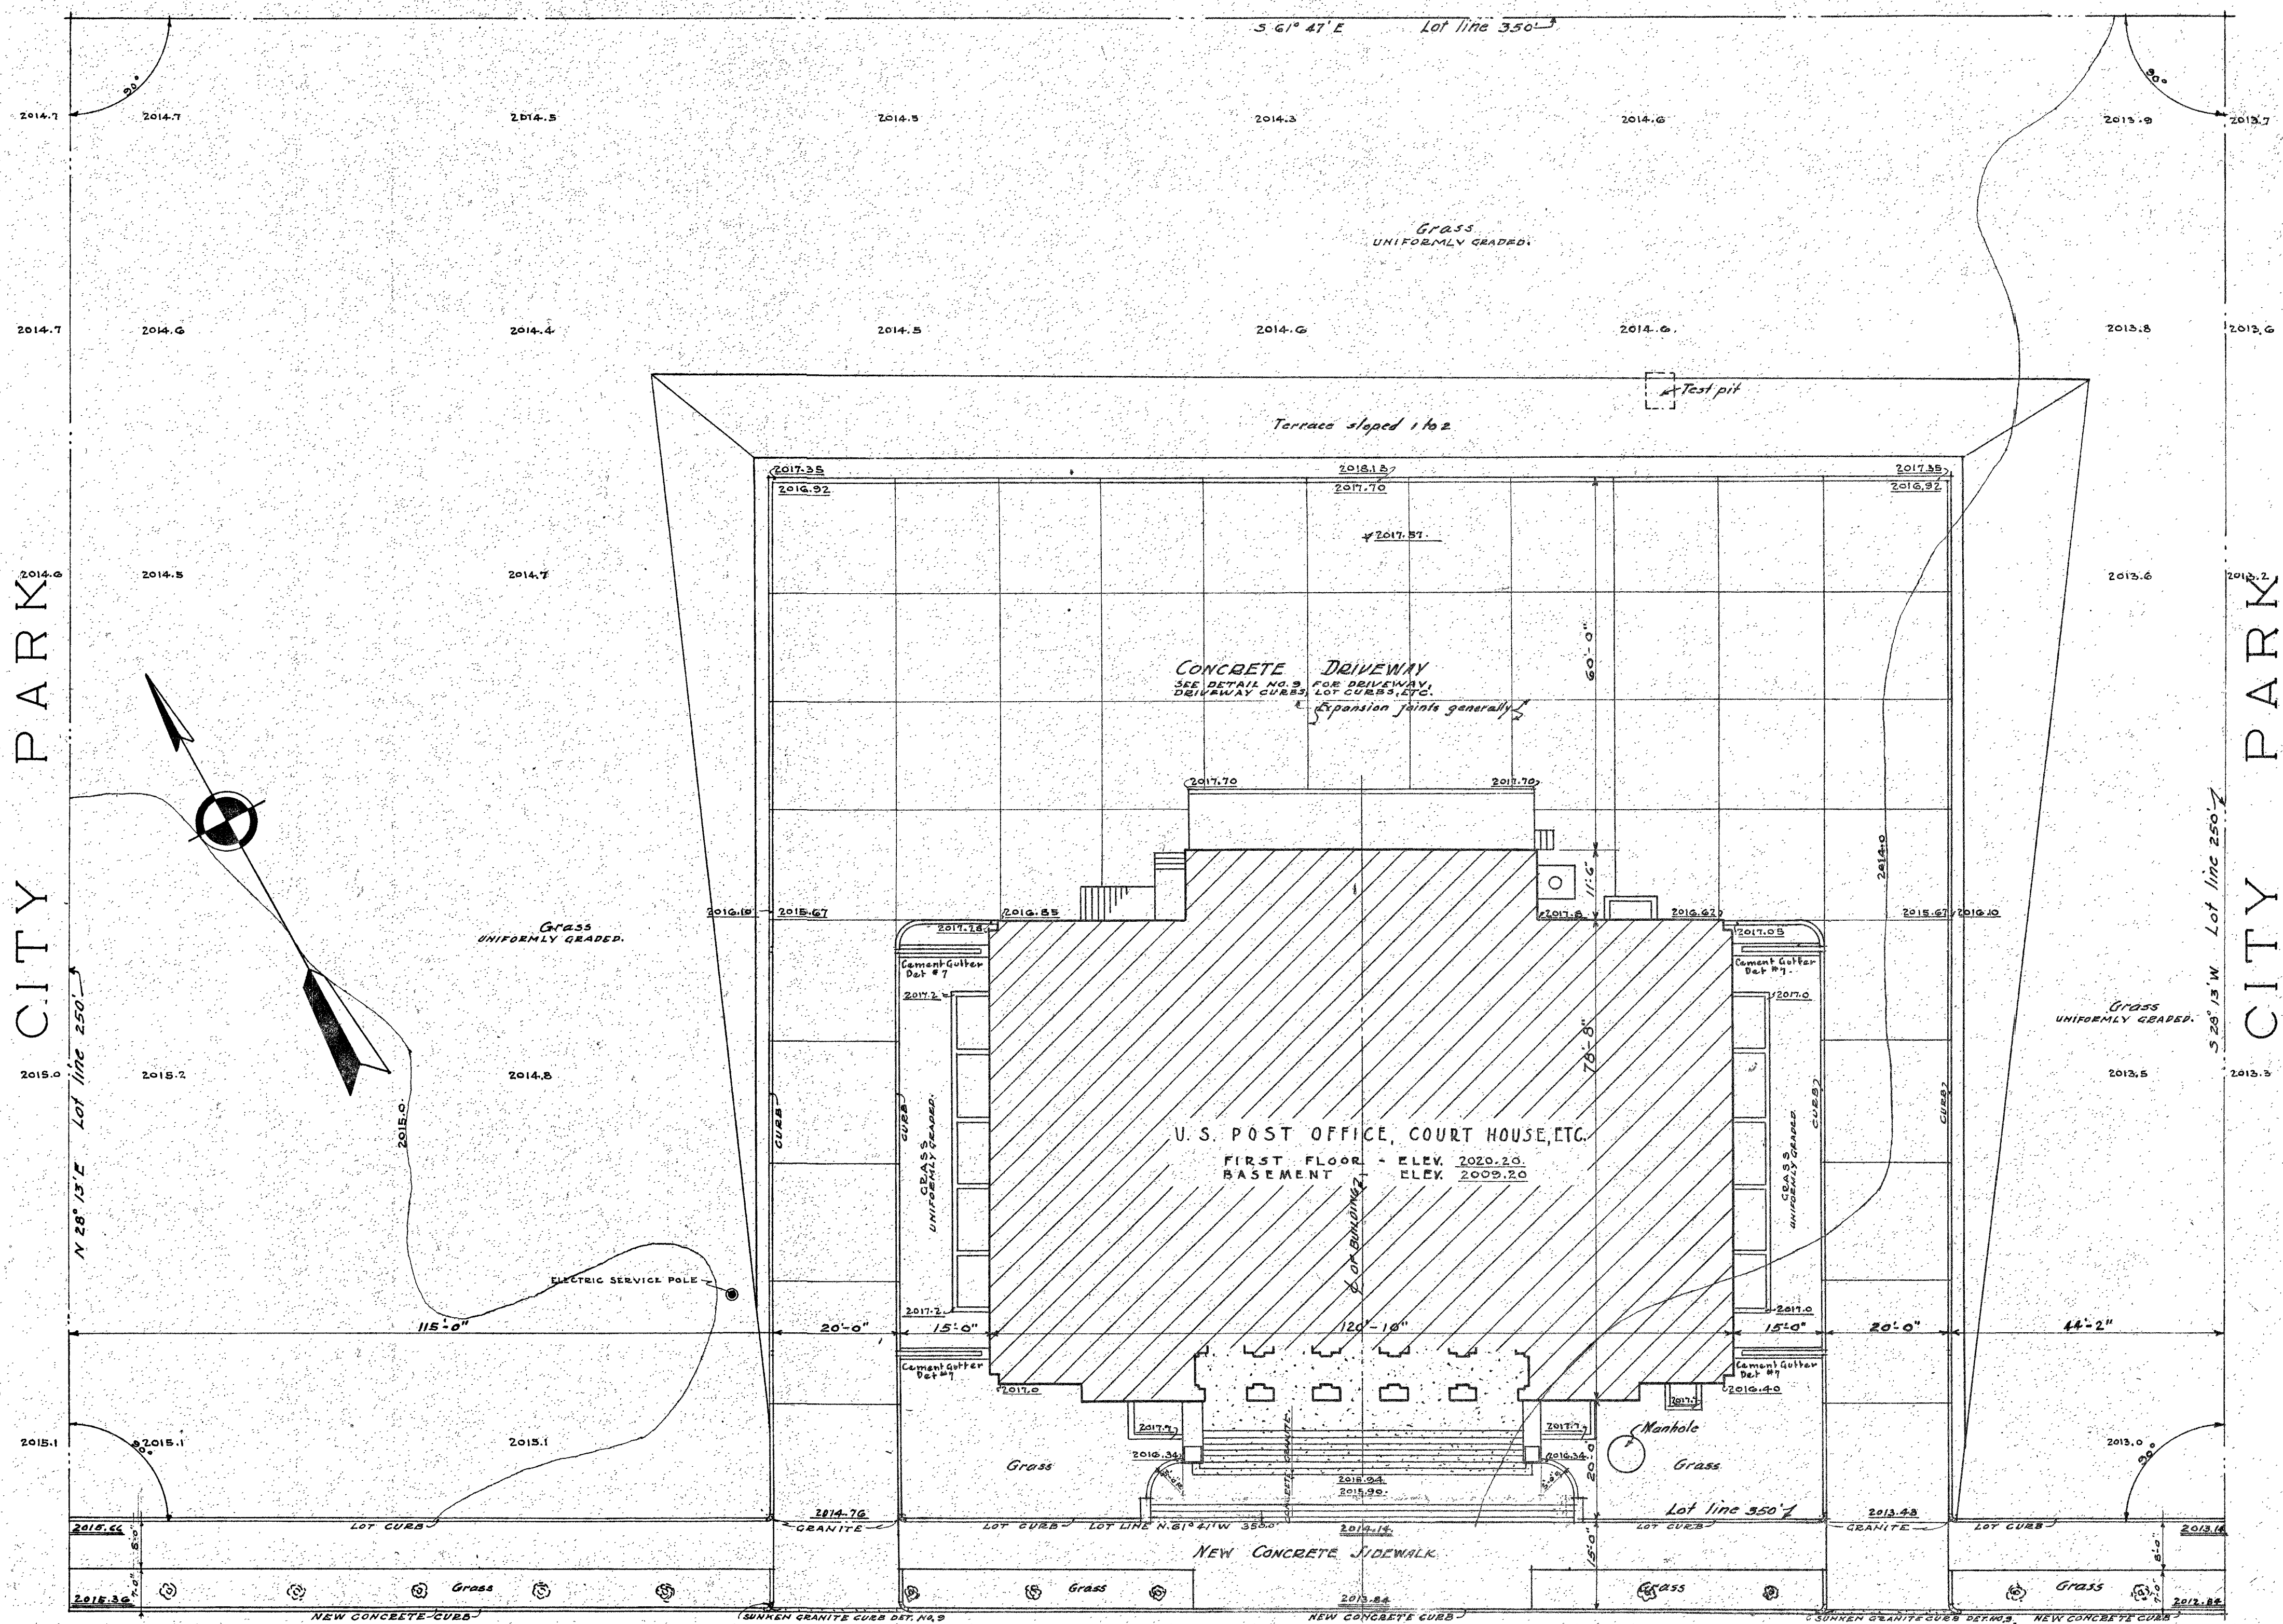

THE FOLLOWING MISC. DETAILS APPLY TO THIS CONTRACT.

M 352 G	VAULT DOORS.
M 370 B	5, 7, 9, 15, 16, 17, 18, 19, 22, 23, 24.
M 371 C	28, 35, 36, 38, 39, 40, 41, 42, 43, 45 C, 27, 29.
M 372 F	55, 56, 58, 61 MODIFIED (SEE NOTE), 64, 65, 70, 72, 73, 74, 77, 81.
M 373 C	82, 83, 84, 93, 94, 100, 104, 107, 110, 112, 113.
M 374 F	117, 118 A, 121, 124, 129 C, 130, 131 A, 133.
M 375 B	141.
M 376	150, 151 MOD., 152, 153, 154, 156, 158 MOD., 161 FOR ELEV. 103 MODIFIED.
SEE DRAWINGS LISTED ABOVE FOR MATERIAL INDICATIONS & ABBREVIATIONS.	
M 378 B	204.

NOTE: DETAIL NO. 61 MODIFIED TO BE CAST IRON.

NOTES:
OFFICIALLY ESTABLISHED GRADES ARE INDICATED THUS 2013.00.
NEW GRADES ARE INDICATED THUS 2015.0.
PRESENT GRADES ARE INDICATED THUS 2013.5.
ALL GRASS SURFACES TO BE GRADED UNIFORMLY TO CORNERS,
WALLS, AREAS, ETC.
CONTRACTOR SHALL VERIFY ALL MEASUREMENTS, GRADES, ETC.
AT THE SITE BEFORE STARTING ANY WORK.
MONUMENTS IN PLACE AT CORNERS OF LOT TO BE REMOVED.
PROVIDE NEW CONCRETE MONUMENTS AS PER DETAIL NO. 18.
PRESENT TREES TO REMAIN.

REVISIONS
DRAWINGS REVISED.
DRAWINGS NOS. 1AA, 2AA, 3A, 101A, 101A & 101A CANCELS DRAWINGS
NOS. 1A, 2A, 3, 100, 101 & 101
CHANGES:
1- CHANGES IN DRIVEWAY & GRADES AT BUILDING, REQUIRED TO RAISE
BASEMENT FLOOR ABOVE SUBSOIL WATER.
2- WOOD BLOCK FLOOR SUBSTITUTED FOR CONCRETE FLOOR IN
MAILING VESTIBULE & LOADING PLATFORM.
3- ADDITION OF WOOD BUMPER TO LOADING PLATFORM.
4- CHANGE IN MAILBOXES TO PROVIDE 6'-0" PROJECTION PAST
LOADING PLATFORM.
5- CHANGE OF TOILET ROOM ETC. IN BASEMENT.
6- PIPE RAIL AT AREAS ADDED.


APPROACH PLAN
STEWART STREET
Scale 1/4" = 1'-0"
Not Paved

ASPIRING SUPERVISING ARCHITECT
TREASURY DEPARTMENT
APPROVED: LOUIS A. SIMMONS
CITY ARCHITECTURAL DIVISION
T. C. BROOKS, 7/23/63
N. S. THOMPSON,
CITY ARCHITECTURAL DIVISION

58487

BENCH MARK
Elev top of hydrant 2016.37

THIRD STREET
1/2 OF STREET

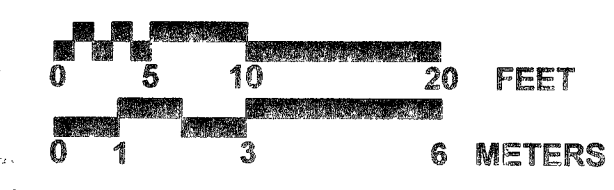

Elev top of hydrant 2014.41

Scanned by GSA Region 9
FEB 6 1998

U.S. P.O. C. H. ETC.
CITY LAS VEGAS, NEV.
DRAWN BY: DATE:
CHECKED BY: S. J. POWELL, DATE 2-20-32
DRAWING NO. 1-AA
521-279-1 2