




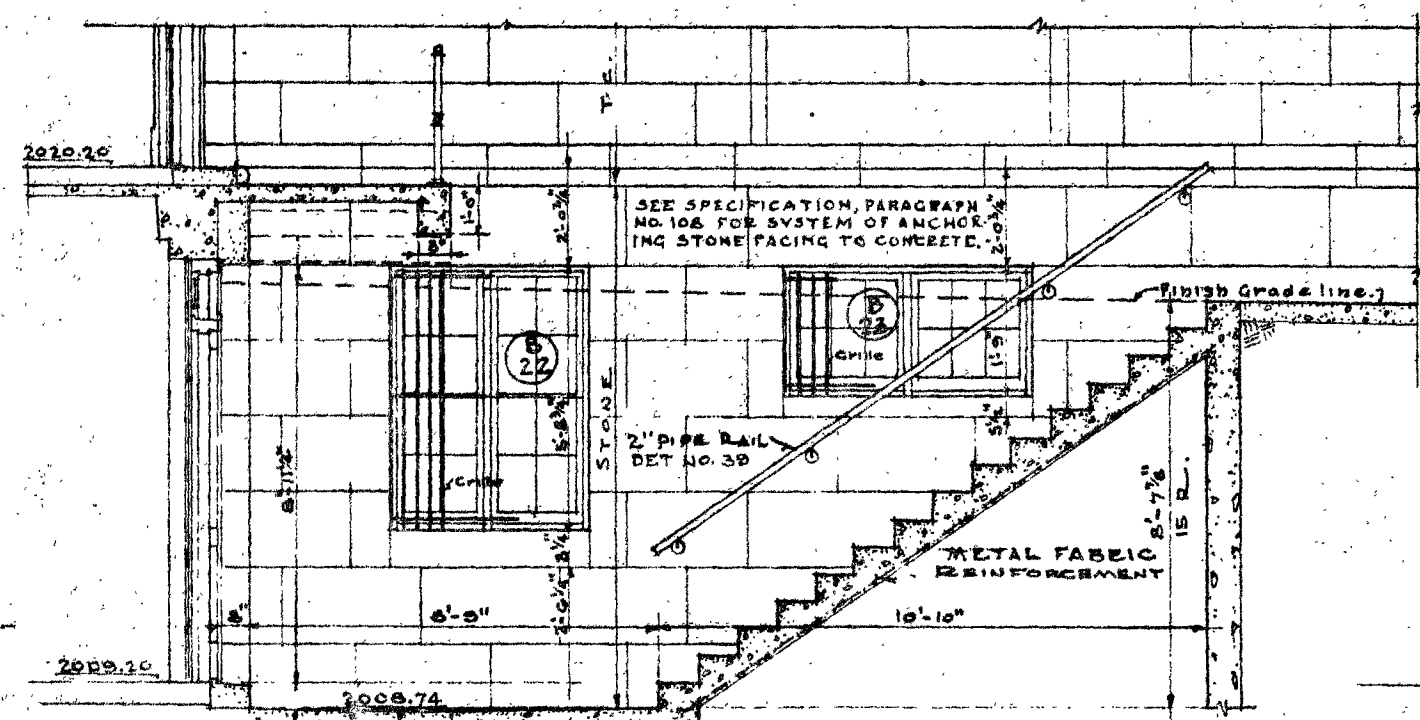


SCALE 1/4" = 1'-0"

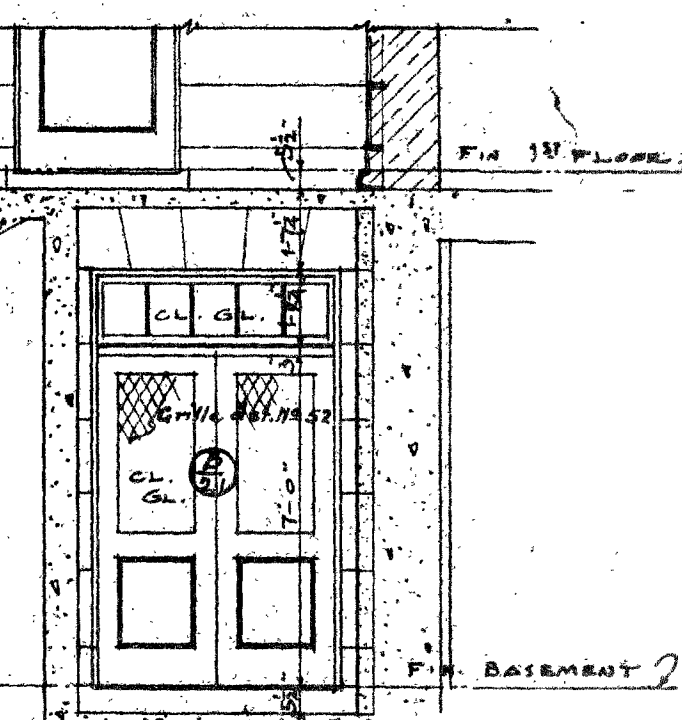


SECTION E-E

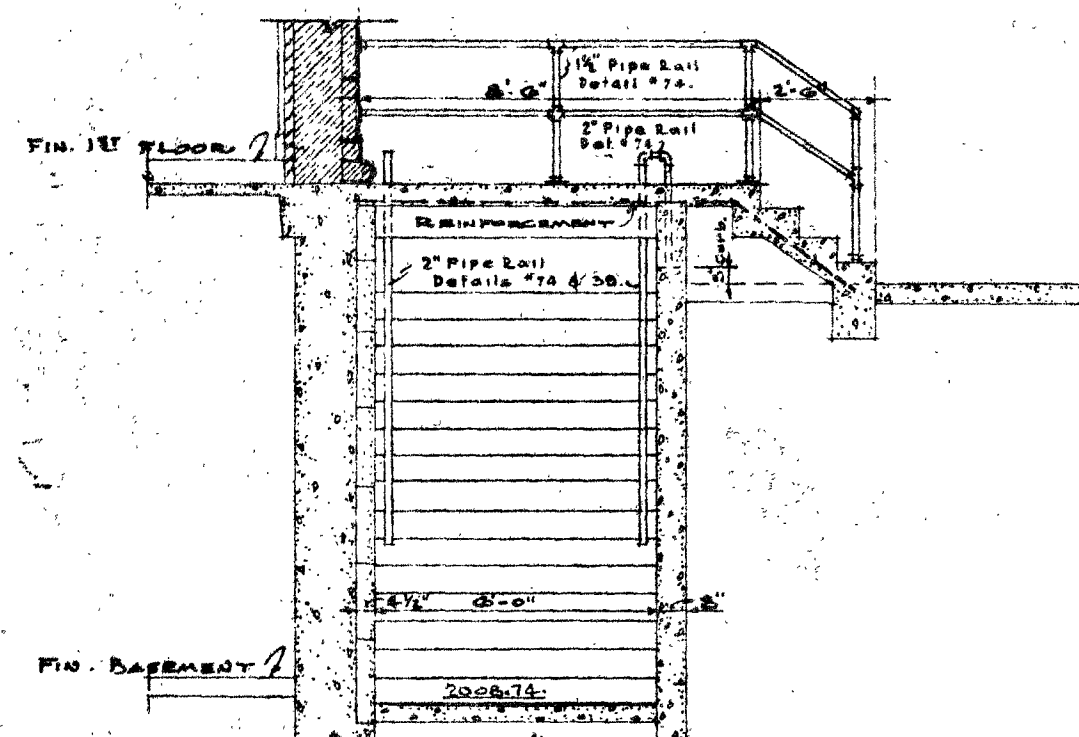

SECTION C-C
SCALE 1/4" = 1'-0"

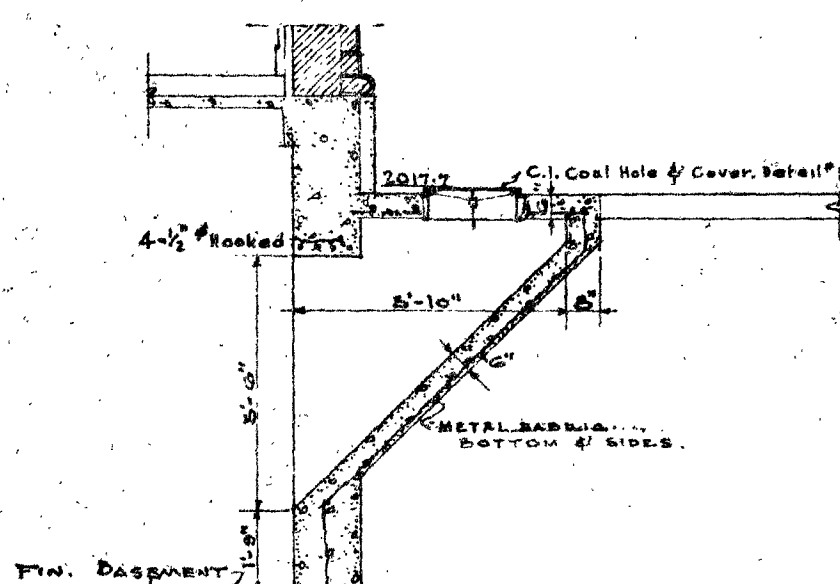


SECTION D-D
SCALE 1/4" = 1'-0"

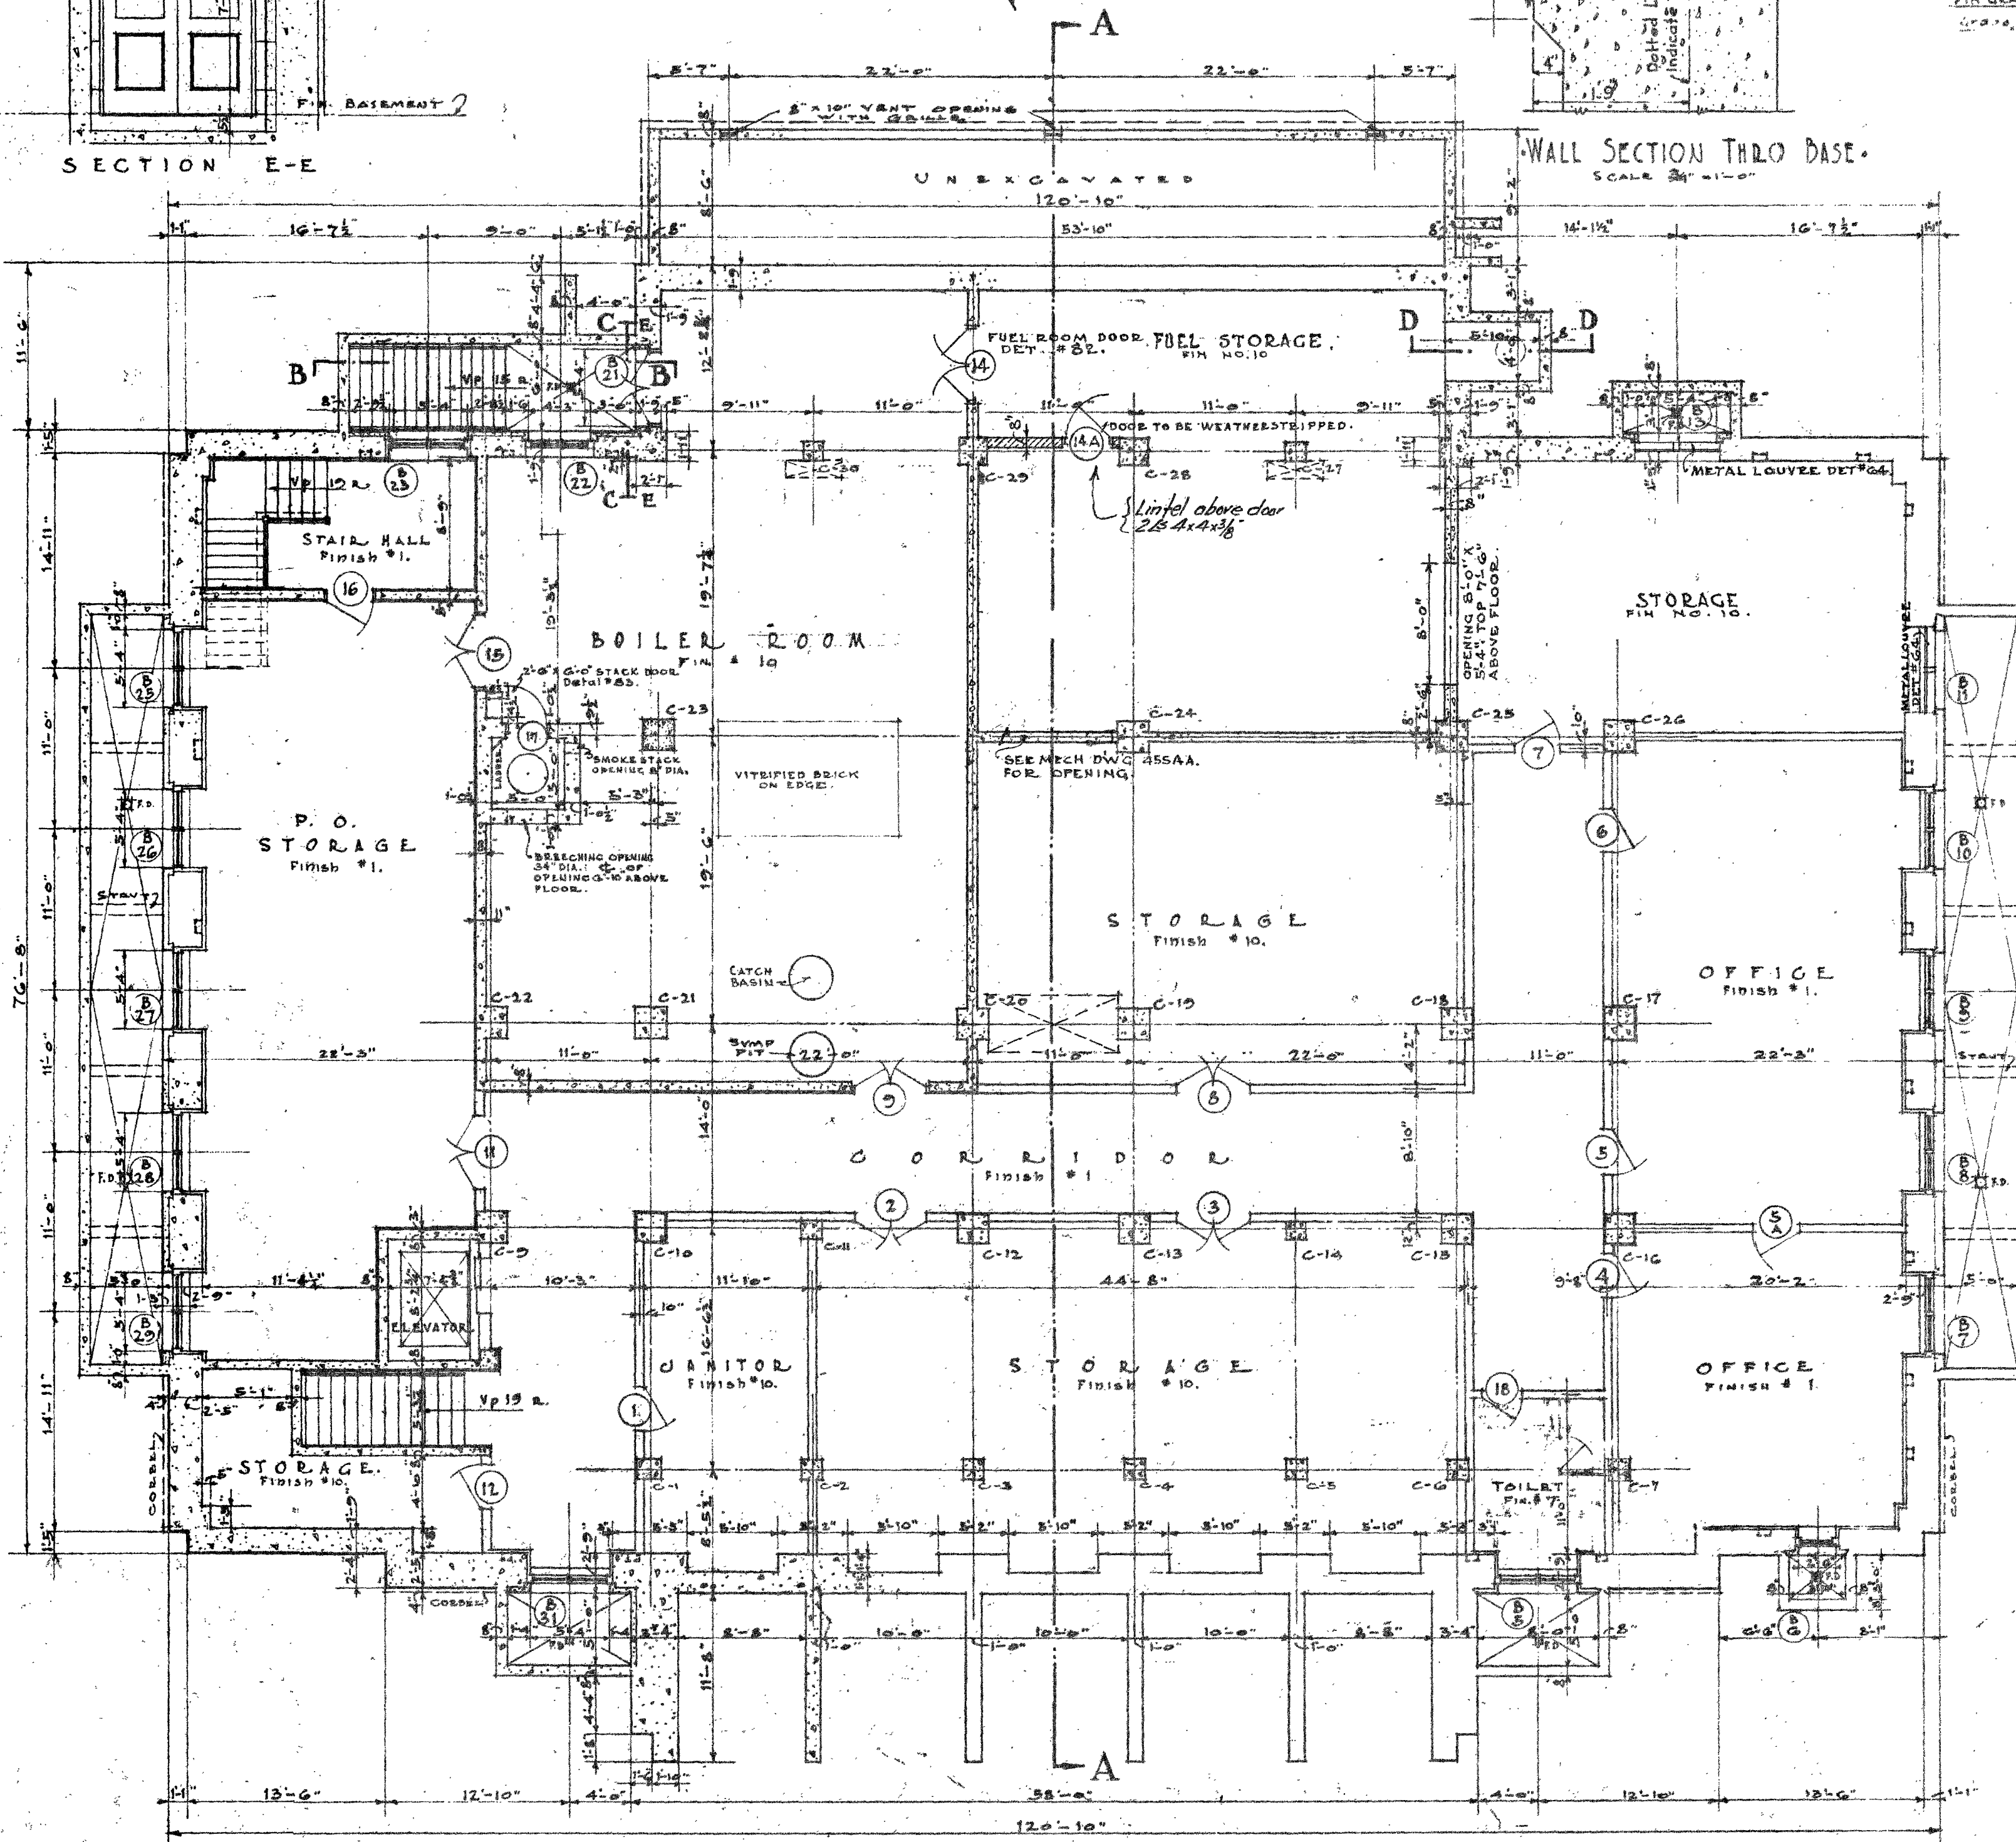

BASEMENT PLAN
SCALE 1/8" = 1'-0"

For structural steel reinforcement & etc. see structural drawings.
Partitions set otherwise noted or indicated to be 4" T.C.
ALL PIPE CHASES TO START 8'-0" BELOW FIN 1ST FL.
SEE NOTE PAGE 3 FOR SIZES

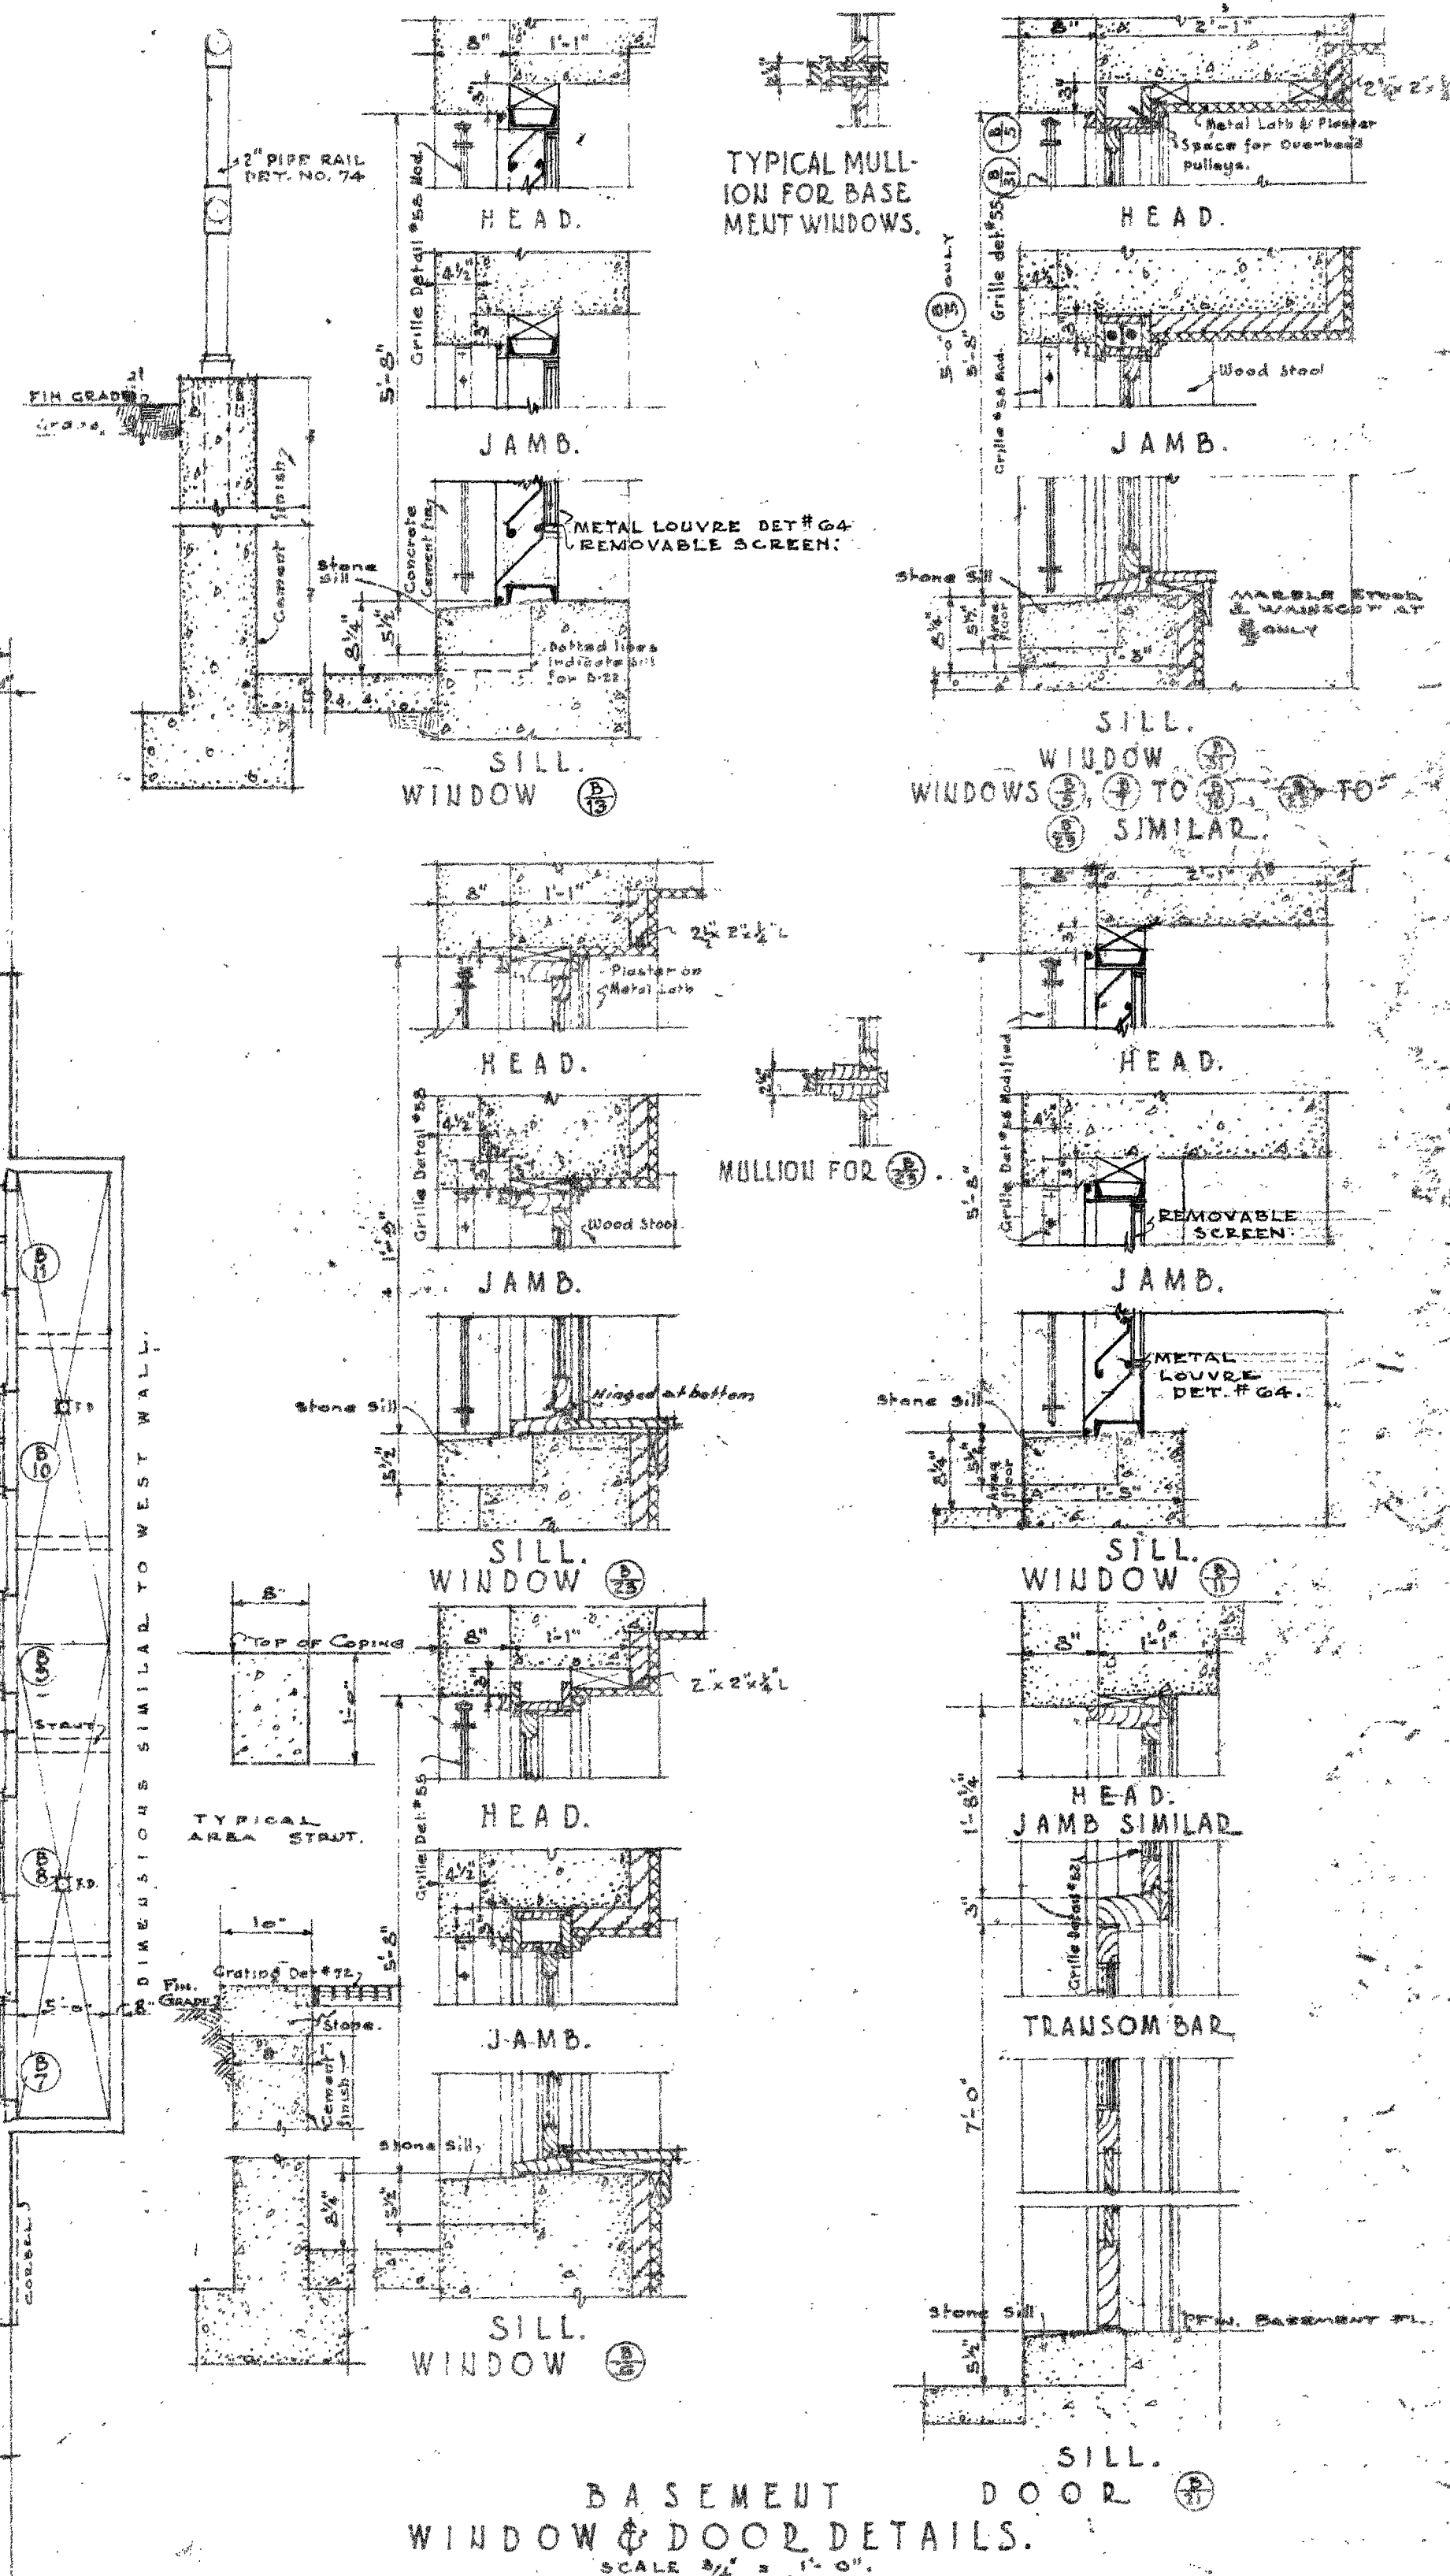

BASEMENT WINDOW & DOOR DETAILS.
SCALE 3/4" = 1'-0"

REVISIONS.
DRAWING NO. 244A CANCELS NO. 24A.
CHANGES:
METAL LOUVRES IN WINDOWS NO. 11 & 12.
OPENING IN WALL NEAR C-23.
OPENING IN WALL NEAR C-24.
WALL BETWEEN C-23 & C-24.
DOOR NO. 13 OMITTED.
DOOR NO. 14 MOVED.

Scanned by GSA Region 9

FEB 8 1998

J. A. Williams
ACTING SUPERVISING ARCHITECT
TREASURY DEPARTMENT
APPROVED FOR
SEPT 10 1942
U.S. DEPT. OF THE INTERIOR
N. E. F. L. DIVISION

58491

0 5 10 20 FEET
0 1 3 6 METERS

J.M.D.
12-7-32
wc: [signature]
1/14/32

U.S. P.O. G.H. ETC.
LAS VEGAS, NEV.
DRAWN BY: S.L.P. DATE: 11-23-32.
CHECKED BY: S.L.P. DATE: 11-23-32.
DRAWING NO. 244A
521-279-1
6