

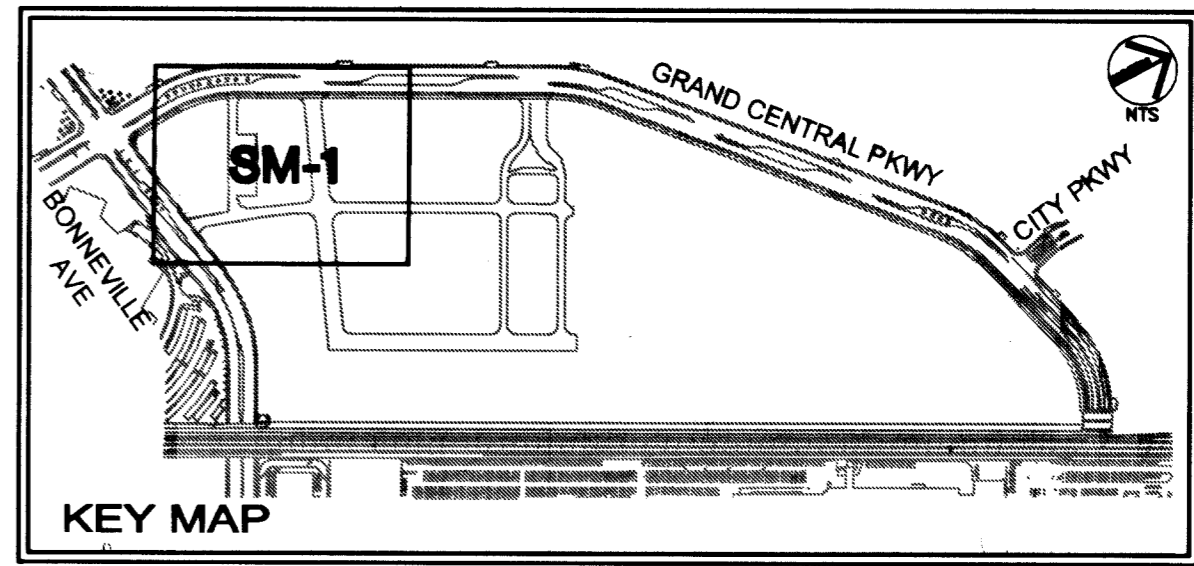


Path: K:\Civil\092587 - Newland\003 - Phase 1\CA00\087003sm.dwg
 This document, together with the concepts and designs presented herein, is an instrument of service, as an instrument of service, is intended only for the specific purpose and client for which it was prepared. Reason of and improper reliance on this document without written authorization and approval by Kimley-Horn and Associates, Inc. shall be without liability to Kimley-Horn and Associates, Inc.

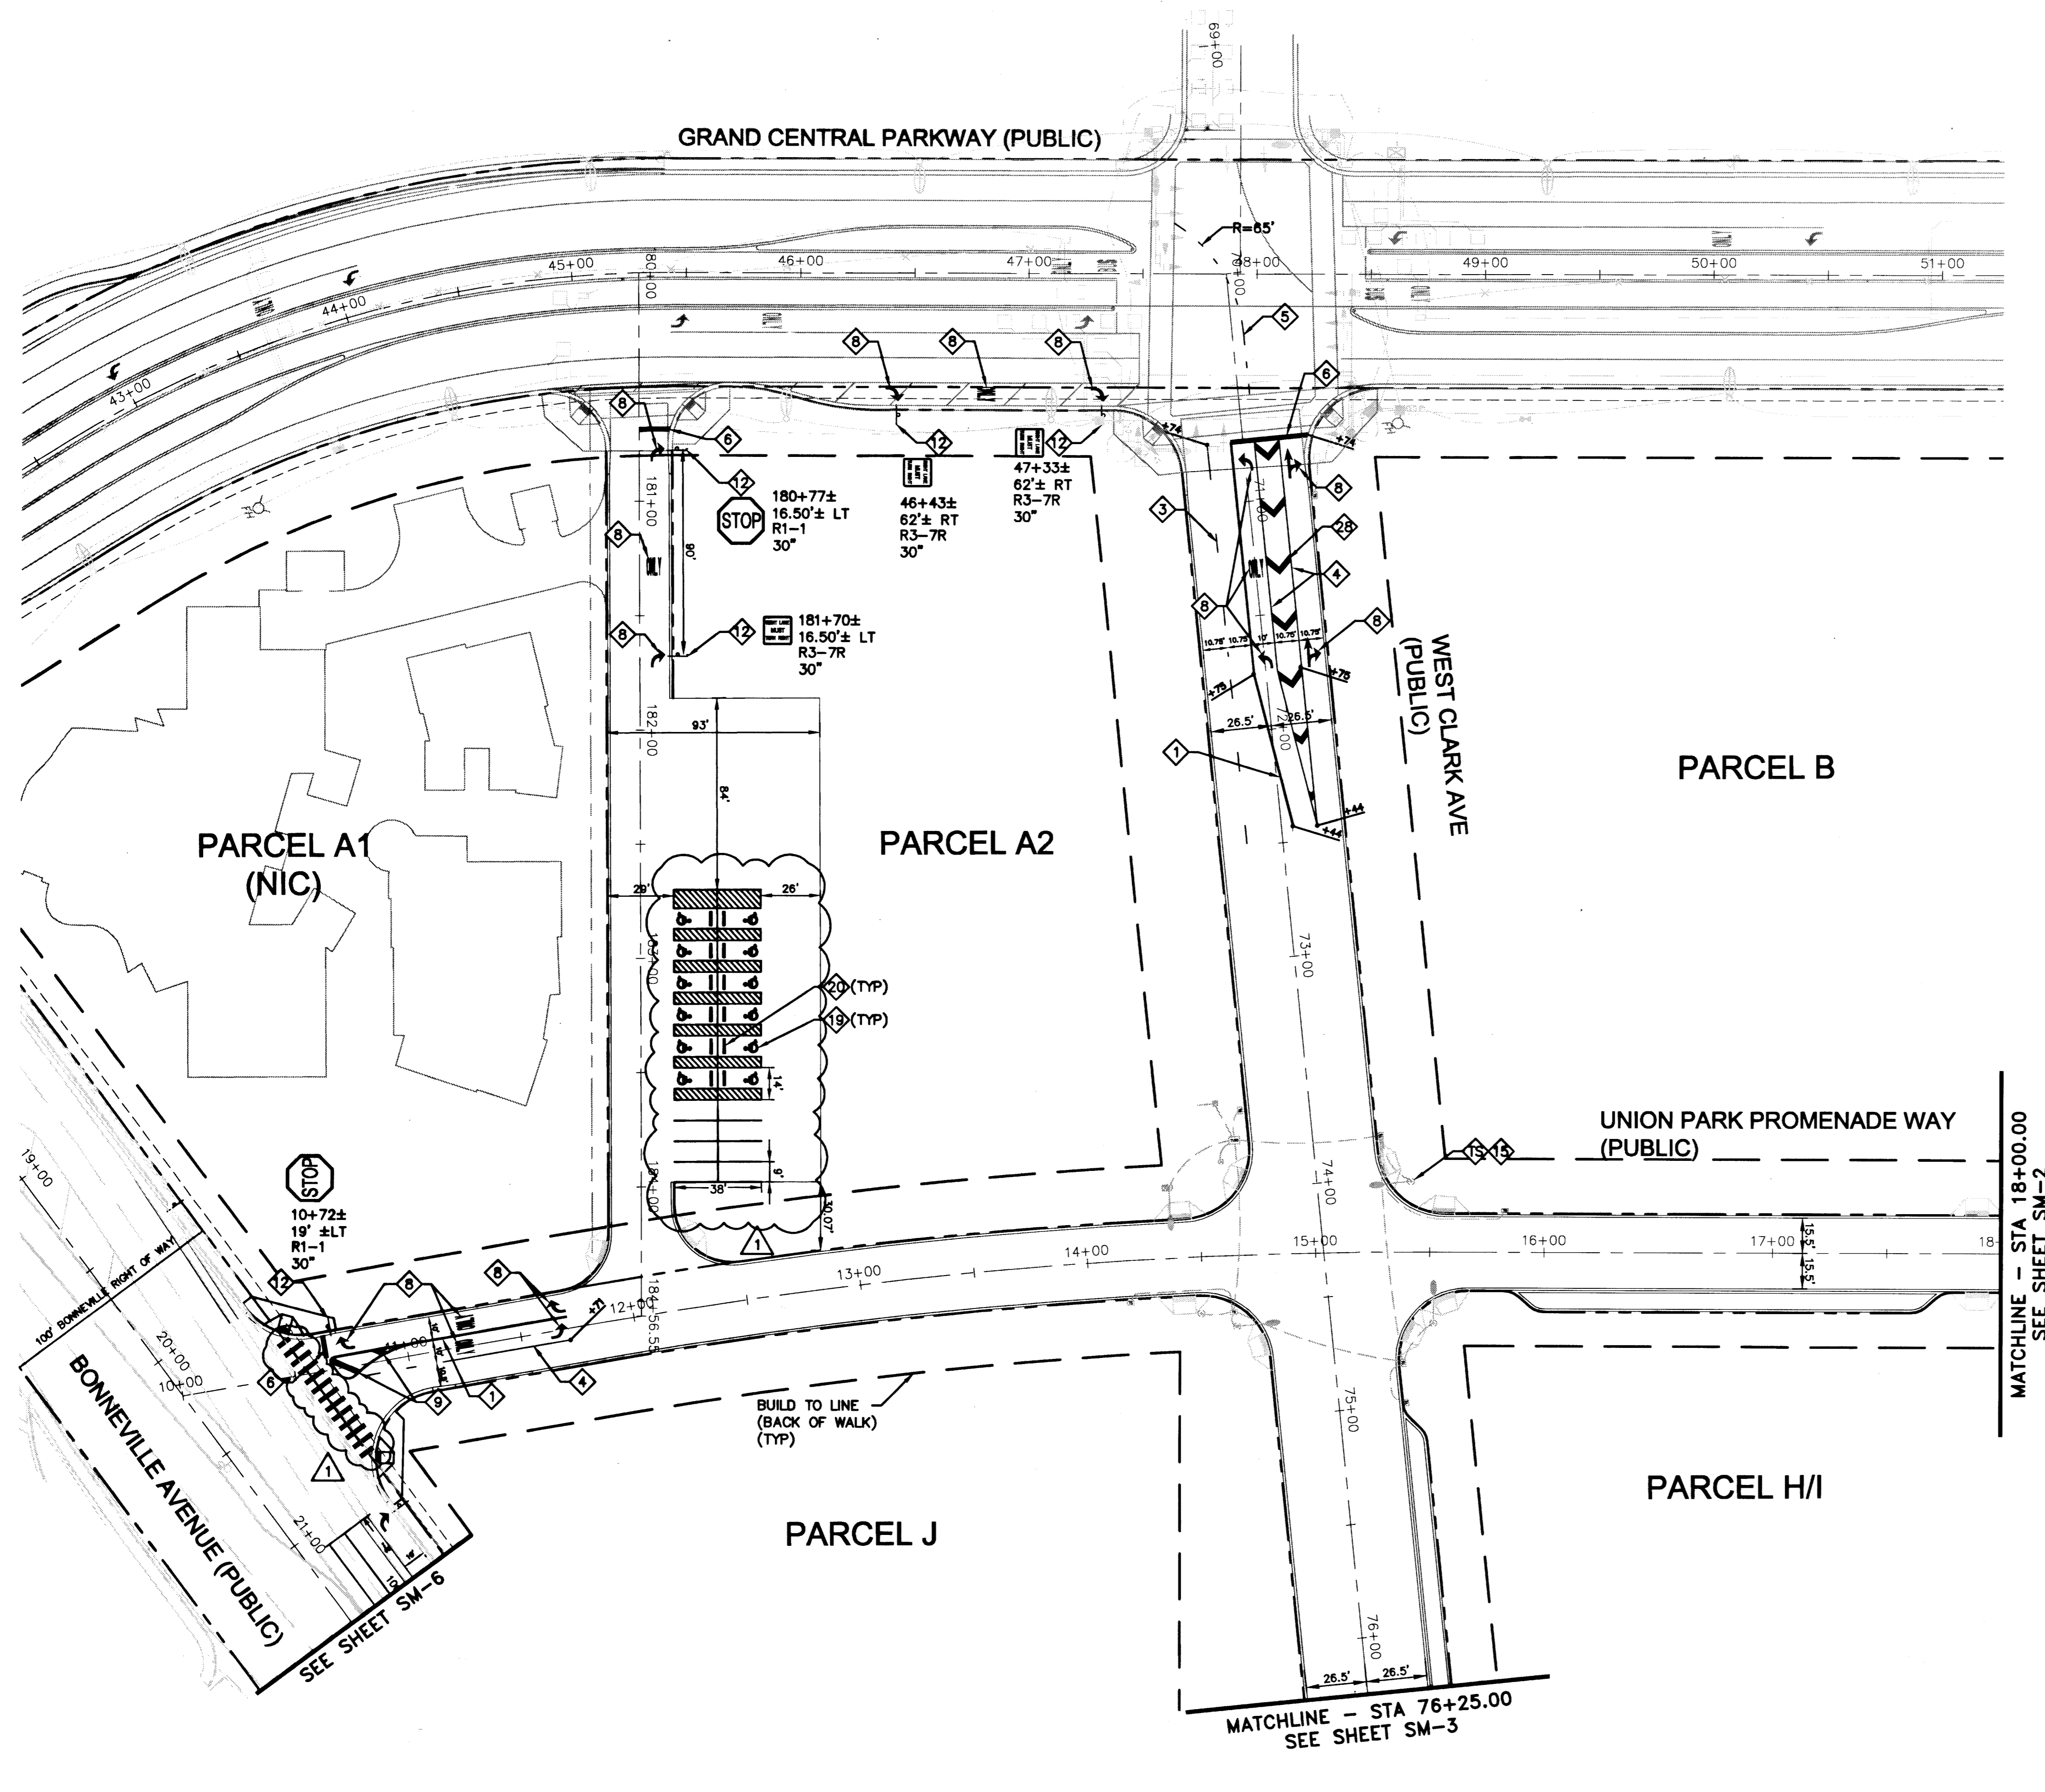

SIGNING AND MARKING NOTES

- 1) INSTALL TYPE 1 CENTERLINE (YELLOW PAINT) PER CCAUSD No. 244.
 - 3) INSTALL TYPE 4 LANE LINE (WHITE PAINT) PER CCAUSD No. 244A.
 - 4) INSTALL STORAGE LINE (WHITE PAINT) PER CCAUSD No. 246.
 - 5) INSTALL "CAT-TRACKS" (WHITE PAINT) PER DETAIL ON SHEET SM-7.
 - 6) INSTALL STOP LINE, WHITE (24" WIDE, WHITE PAINT) PER CCAUSD No. 254.
 - 8) INSTALL ARROW AND "ONLY" SYMBOLS PER CCAUSD No. 246. SYMBOLS SHALL BE PAINT.
 - 12) INSTALL NEW SIGN ENCAPSULATED LENS RETROREFLECTIVE SHEETING (CLASS 6 REFLECTIVE SHEETING OR EQUAL). SIGN SHALL BE MOUNTED ON POST, STREET LIGHT POLE, OR AS DIRECTED BY THE ENGINEER.
 - 15) TRAFFIC SIGNAL SHALL BECOME OPERATIONAL UPON DIRECTION FROM THE CITY.
 - 19) INSTALL ACCESSIBLE STALL SYMBOLS AND LINES (YELLOW PAINT) PER DETAIL ON SHEET SM-7.
 - 20) INSTALL CURB STOP.
 - 25) INSTALL 24" WIDE (WHITE PAINT) CHEVRON PER CCAUSD No. 245 (SHEET 2 OF 3).
 - 26) TRAFFIC SIGNAL (SEE TS SHEETS).
- NOTE**
- 1) PHASE 1 STRIPING IS TEMPORARY AND SHALL BE COVERED UPON INSTALLATION OF THE 1" UTAC.

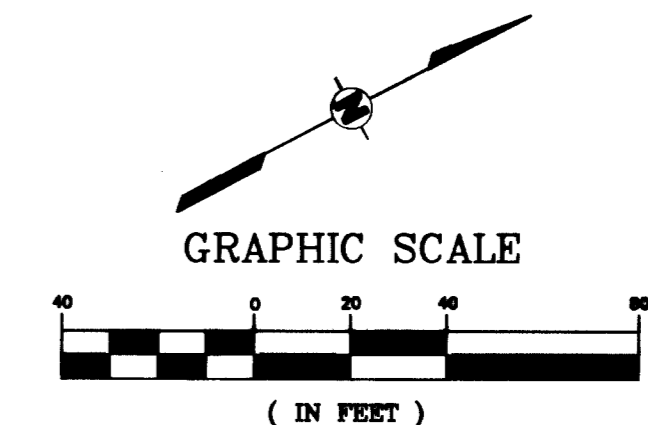

Avoid cutting underground utility lines. It's costly.
Call before you Dig
 811

SAFETY ALERT
 Call Before You Overhead
 1-702-455-7511
 1-702-229-2929

Call before you UnderGround
 1-702-455-7511
 CLARK COUNTY TRAFFIC OPERATIONS AND
 1-702-229-6611
 LAS VEGAS AREA COMPUTERIZED TRAFFIC SYSTEM

DEPARTMENT OF PUBLIC WORKS
UNION PARK PHASE 1
SIGNING AND MARKING PLAN WEST CLARK AVE AND PROMENADE

PROJECT: UNION PARK PHASE 1
 SHEET: SM-1
 SHEET NO. OF 186
 DRAWING NO. 107V4816

DRAWN BY: KHA
 DESIGNED BY: PAB
 CHECKED BY: DDW
 SCALE: 1"=40'
 DATE: February 2008

Kimley-Horn and Associates, Inc.
 Engineering, Planning, and Environmental Consultants
 2080 East Flamingo Road, Suite 210
 Las Vegas, Nevada 89119
 TEL No. (702) 734-6666
 FAX No. (702) 735-4949

REVISIONS:
 1. REVISED PARCEL A2 STALLS AND CROSSWALK LINES
 2. REVISED PARCEL A2 STALLS AND CROSSWALK LINES

REV DATE BY
 7/19/08 PAB
 092587003 - UNION PARK PHASE 1

109103

H# 18393

BIDD 08/7901