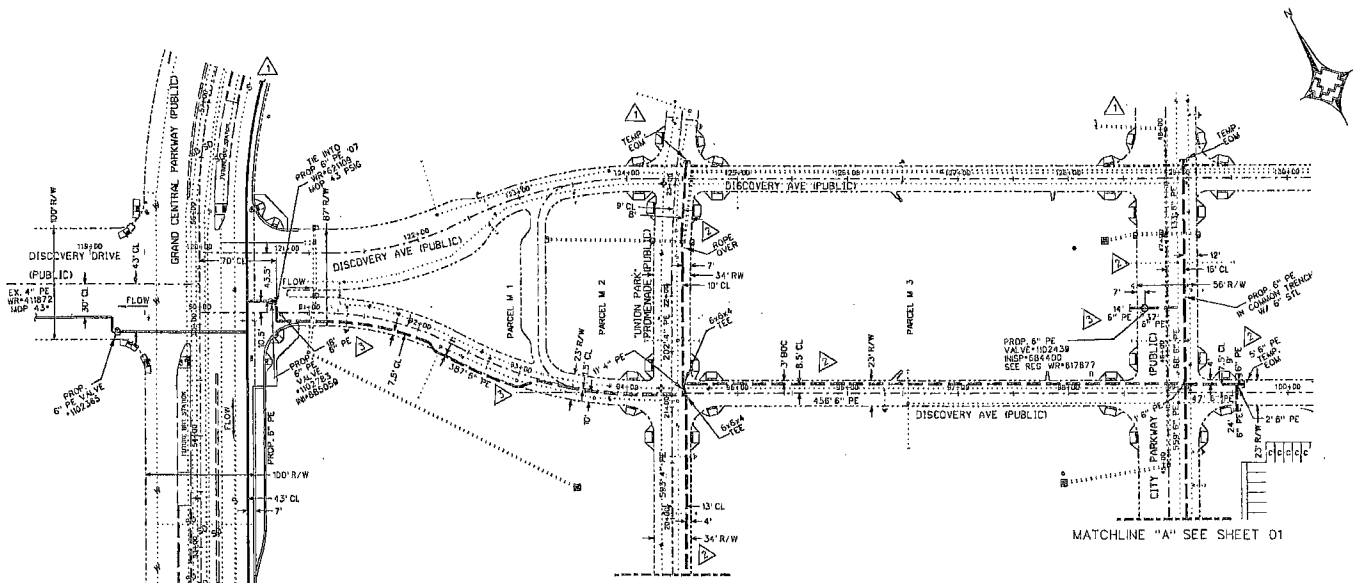

ATTENTION
DO NOT SCALE
CONFIRM ALL LOCATIONS
BEFORE CONSTRUCTION WITH
SOUTHWEST GAS

10/15/08 DATE INITIAL

REVISED

Call before you Dig
Avoid costly interruptions
Call 811 three days before digging
Call 811
1-800-227-2600
OR
Call 1-800 Rule required
1-702-405-7584

3	UPDATED NOTES, ADDED 8" VALVE.	DN	09/24/08
2	MOVED 8" PER CLV COMMENTS.	RI	05/27/08
1	RE-DESIGN. CIVILS CHANGED.	TH	06/23/07
NO.	DESCRIPTION	BY	DATE APPRV.

121965
REVISIONS

Southwest Gas Corporation

SEE SHEET 01

UNIT NO.	UNIT TYPE	INSTL. PROPOSED	RET. PROPOSED	INSTL. COMPLETED	RET. COMPLETED

PROPERTY UNITS

SYSTEM: D-VALLEY-WIDE
DR. NO. 336-1-DR
SYSTEM M.A.O.P. 43#
SEGMENT M.A.O.P. N/A
SYSTEM M.O.P. 43#

AS-BUILT DRAWING-PRESSURE TEST DATA
PIPE DIA.
PIPE LENGTH
PIPE TYPE
MIN. DURATION
TEST MEDIUM: AIR, NITROGEN, WATER, SOAP, GAS, PRESSURE SHP
START END
TEST PRES. (PSIG)
TIME
DATE
PERFORMED BY

I REVIEWED THE PROCEDURES PERFORMED AND FOUND THEM: ACCURATE / INACCURATE SW
INACCURATE COMMENTS
SIGNATURE DATE
SIGNATURE DATE

VISUAL INSPECTION CERTIFICATION
I HAVE VISUALLY INSPECTED ALL HEATED FUSIONS, SOLVENT CEMENT, MECHANICAL JOINTS, AND WELDS. THAT I HAVE PERFORMED
NAME DATE
AS-BUILTS ACCEPTED BY DATE
POSTED BY DATE
POSTING DTD BY DATE

CONSTRUCTION
INSPECTOR
FOREMAN
REVIEWED BY

PERMIT INFORMATION
Tax Code Area-02-0203
CITY OF LAS VEGAS

LOCATION AREA	W. R. NO.	TILC NO.
95	602492	
T20S, R61E S34	x624y516 x627y516 x627y518	

7JD-002CKK3

CUSTOMERS N/A CYCLE ROUTE AREA 35 LV 21.16

ENG. TECH. BILL CRENNAN	PHONE 365-2173
ACCOUNT REP. JOHN WRIGHT	PHONE 528-1729
PROJECT CONTACT MARC JOHNSON	702-220-8090
SHEET NO. 02 OF 02	SCALE 1" = 40' DATE 4/18/07
DWN. BY CMC	CHKD. BY BLA APPVD. BY

TITLE
UNION PARK PHASE 1
GRAND CENTRAL & W. CLARK
10N4816-1-SWG