



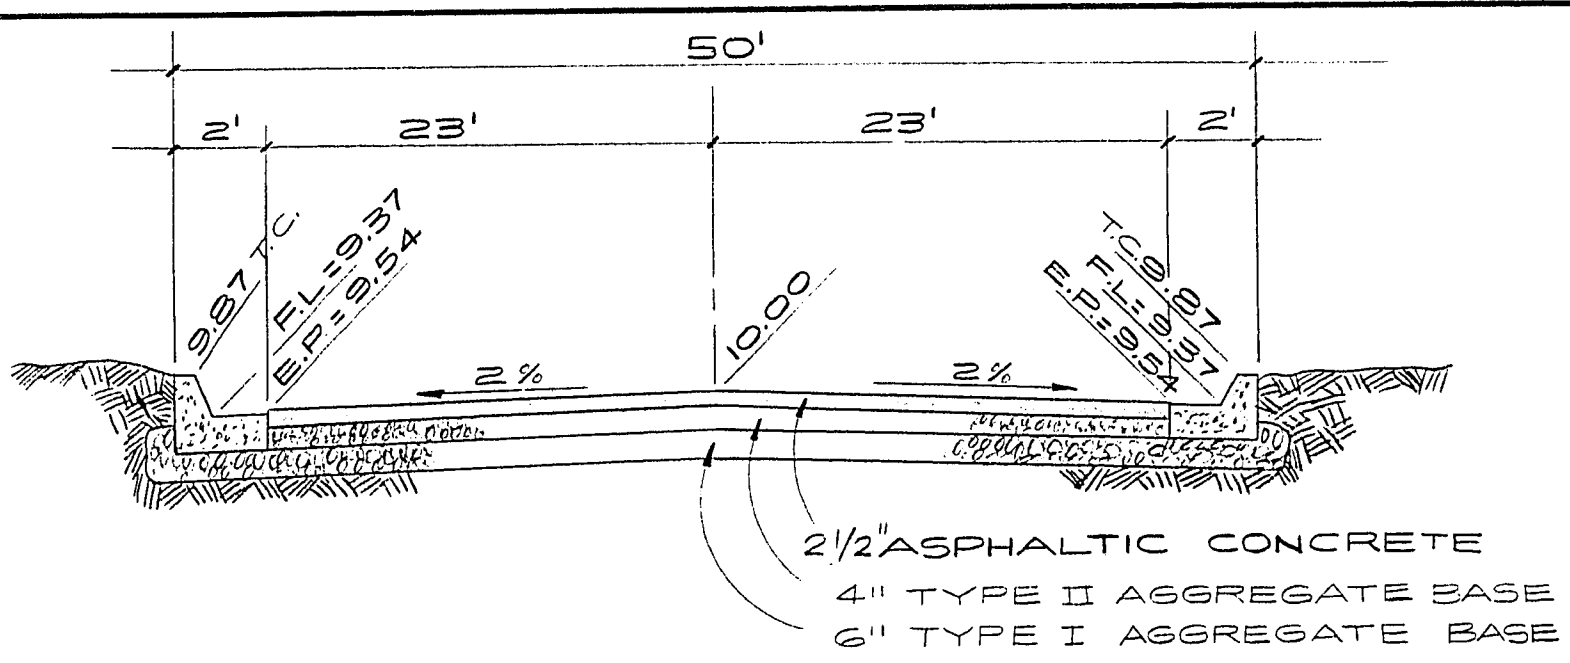


50' R/W WESTWOOD STREET SECTION
NO SCALE

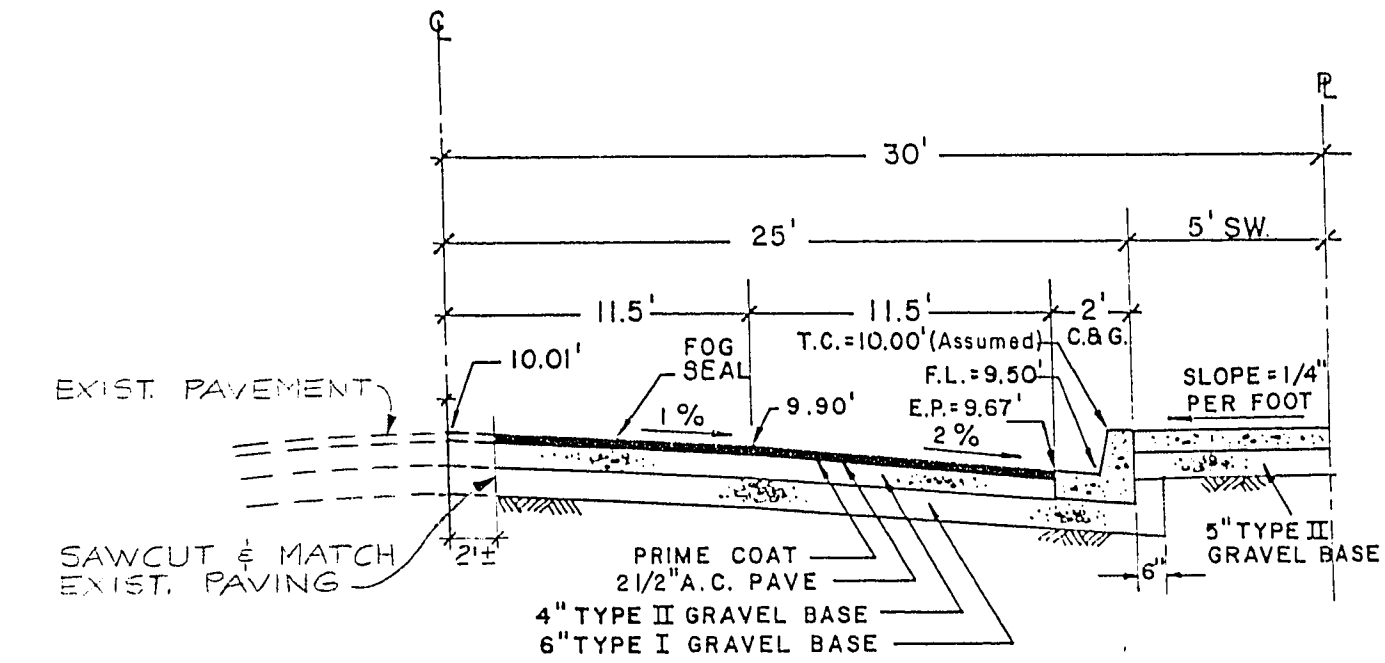


60' R/W TYPICAL HALF STREET SECTION
NO SCALE

SCALE:
1" = 50' HORIZ.
1" = 5' VERT.

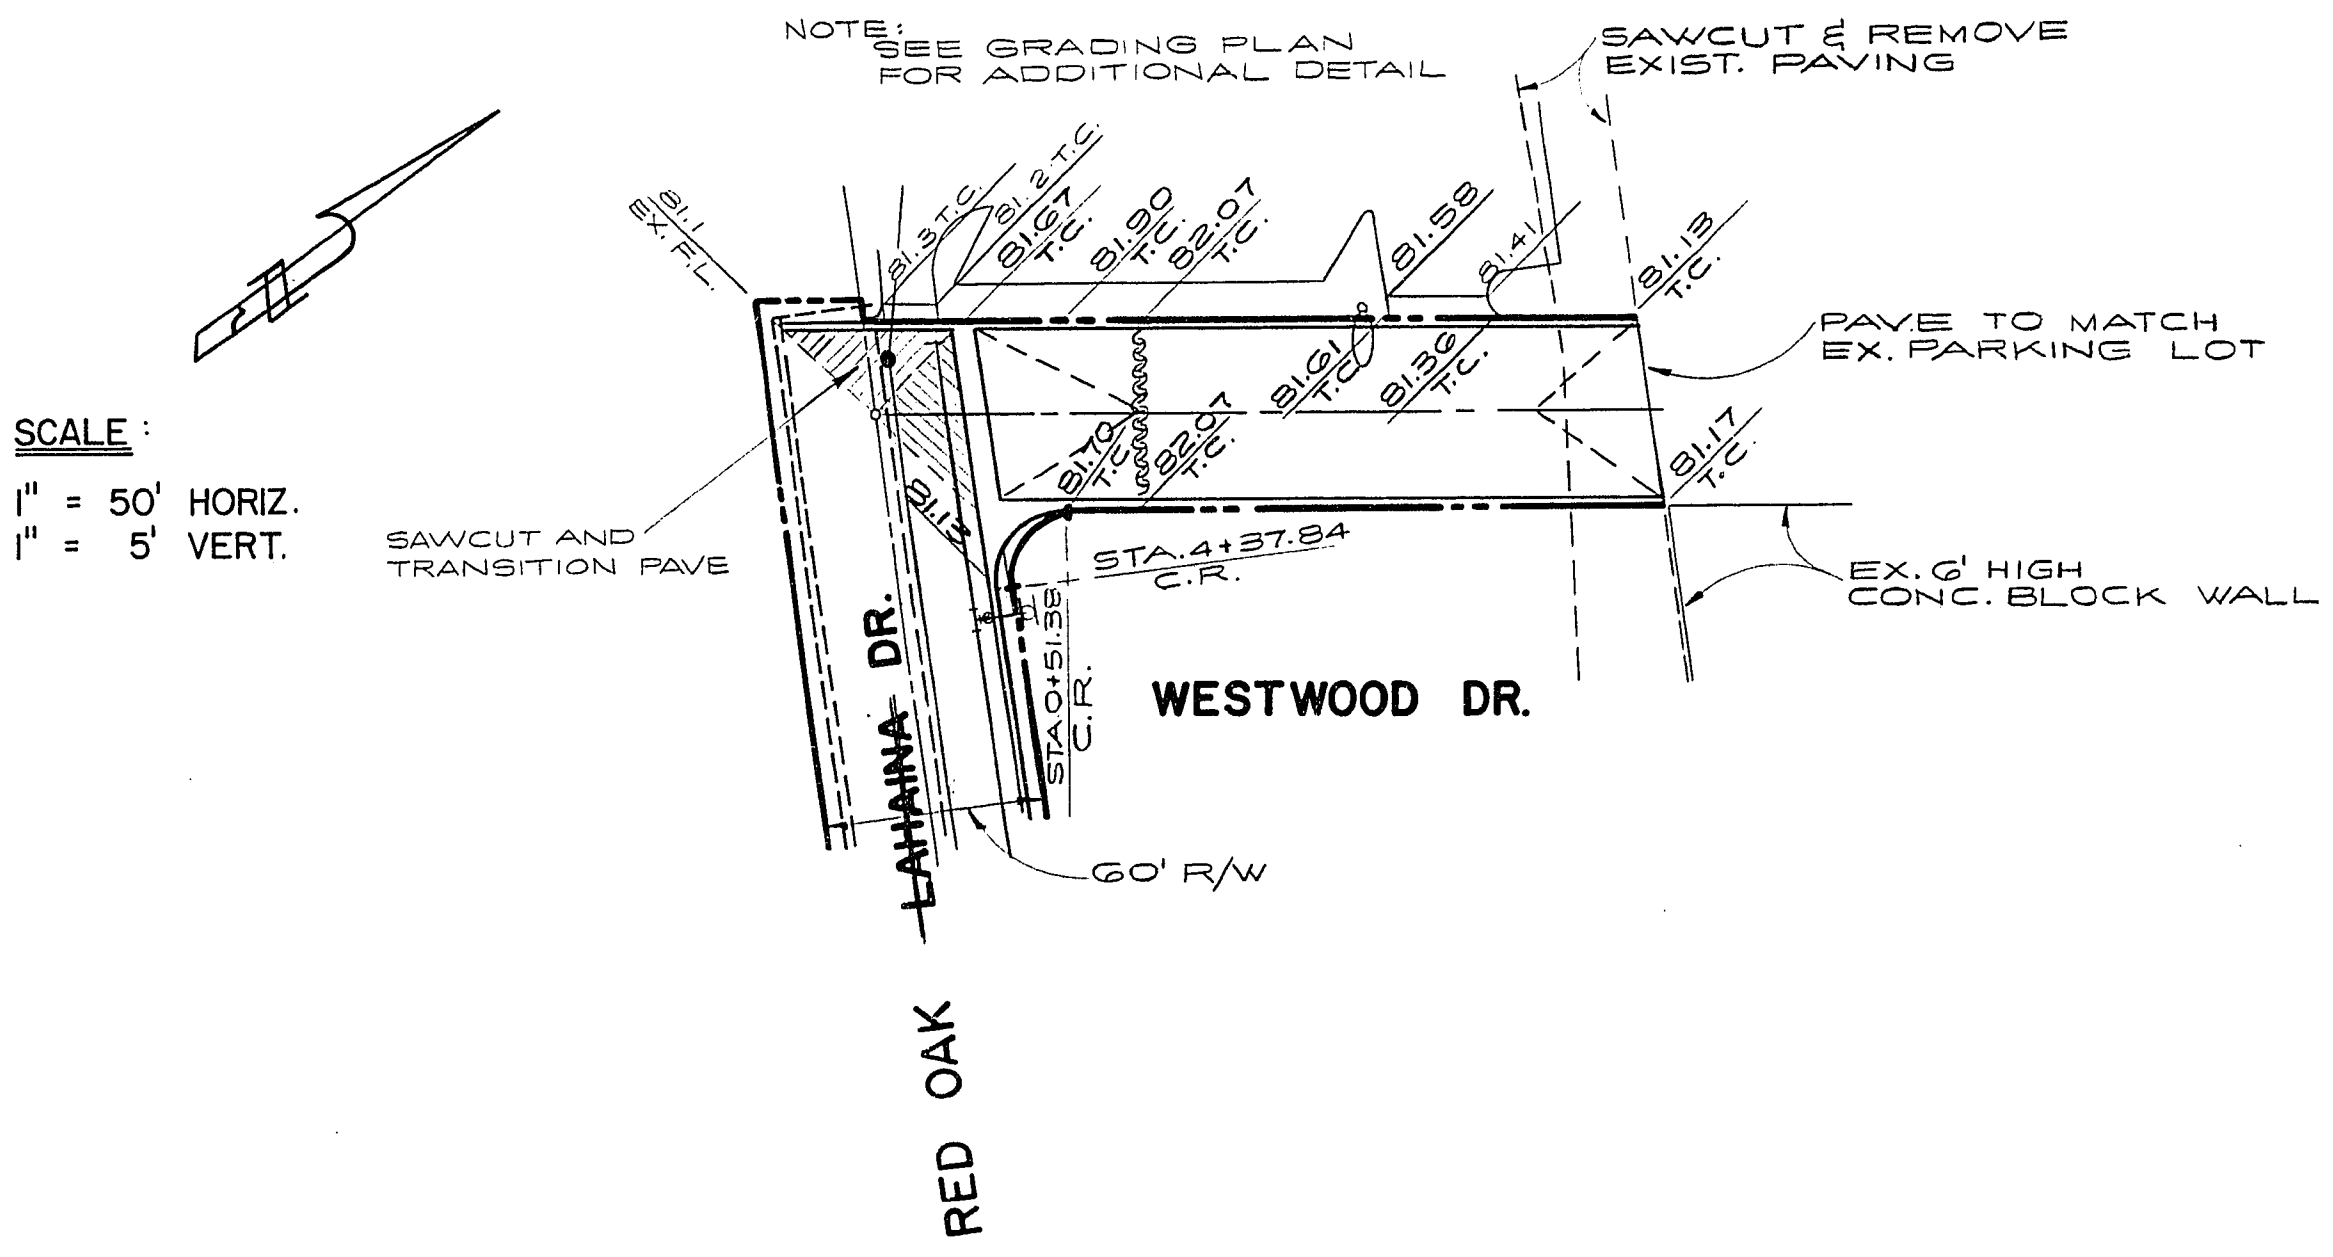


SCALE:
1" = 50' HORIZ.
1" = 5' VERT.

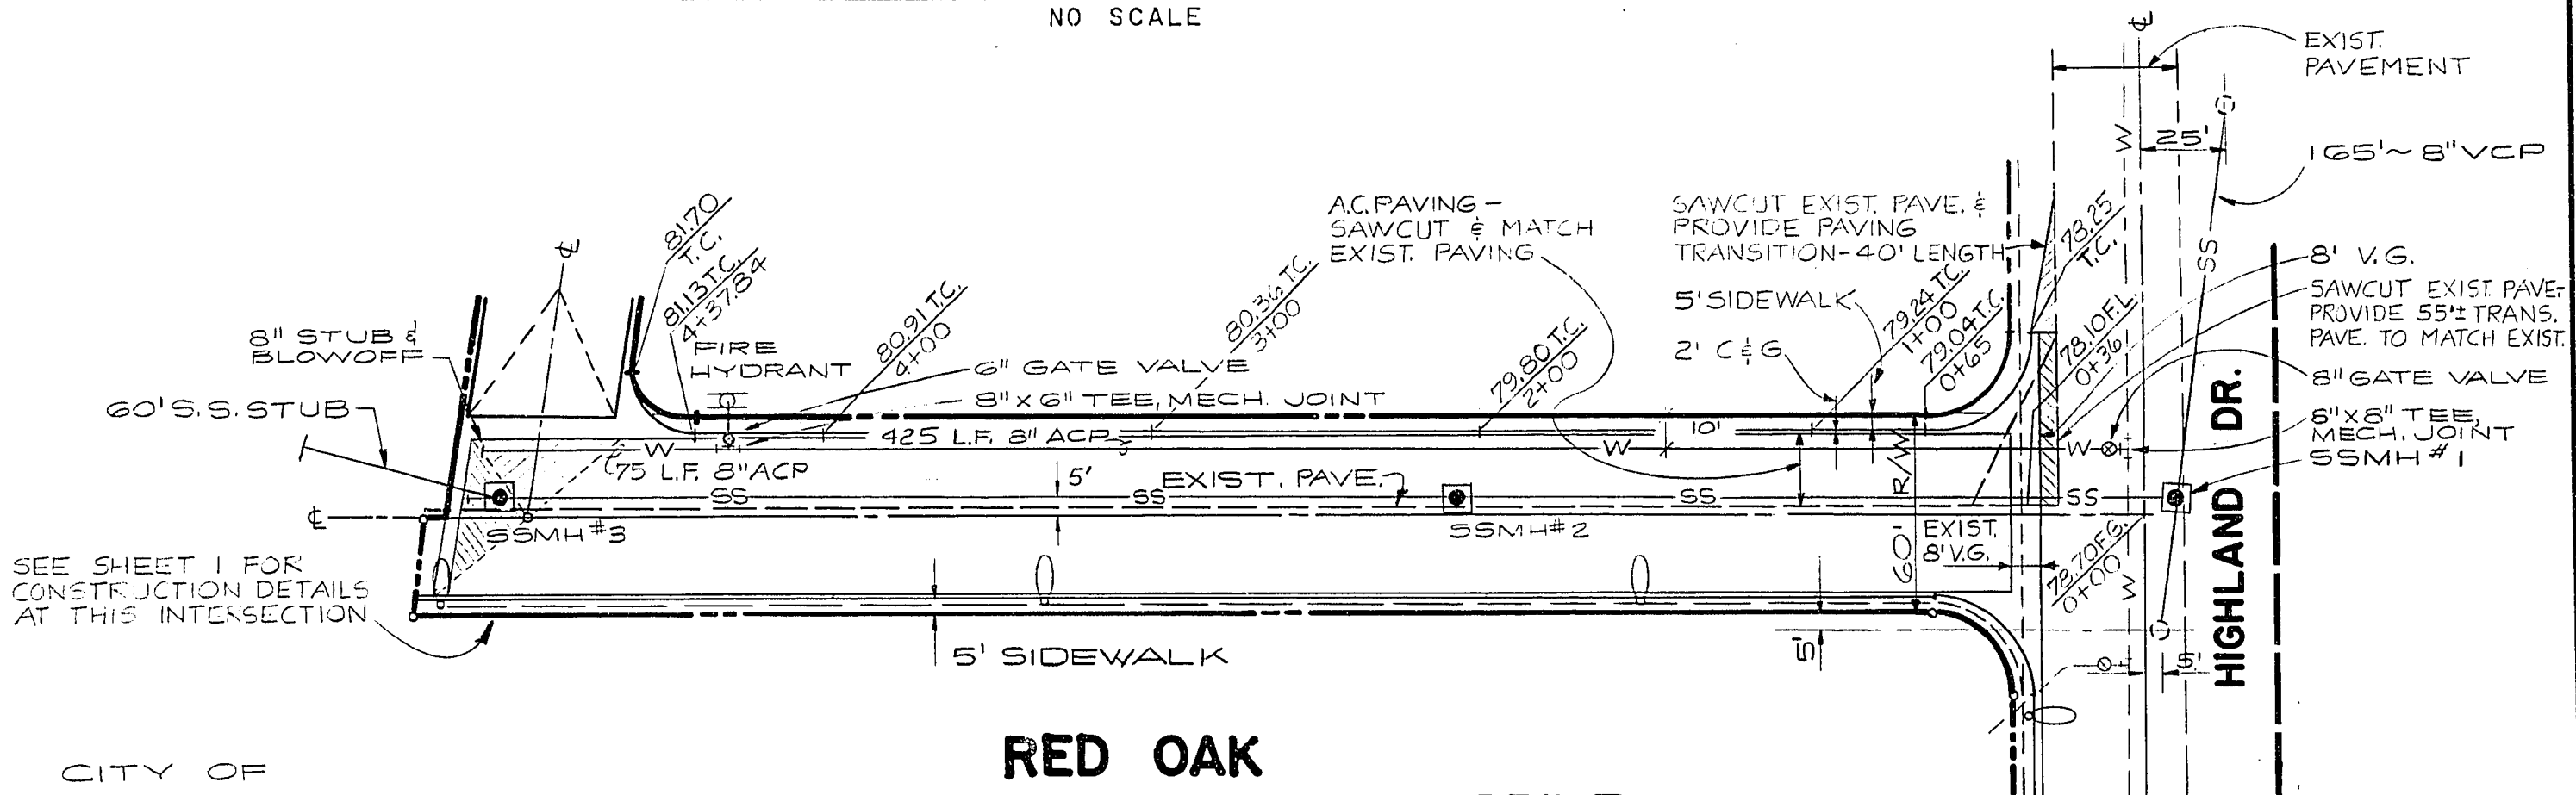

CITY OF
LAS VEGAS
APPROVALS

EXISTING	RED OAK LAHAINA	DRIVE
TRAFFIC ENGINEER	DATE	DATE
N/A	3-28-79	4-9-79
FIELD OPERATIONS ENG.	DATE	DATE
N/A	4-6-79	4-3-79
ELECTRICAL COORDINATOR	DATE	DATE
Stephen Hampton	3-27-79	DATE
FIRE MARSHALL	DATE	DATE

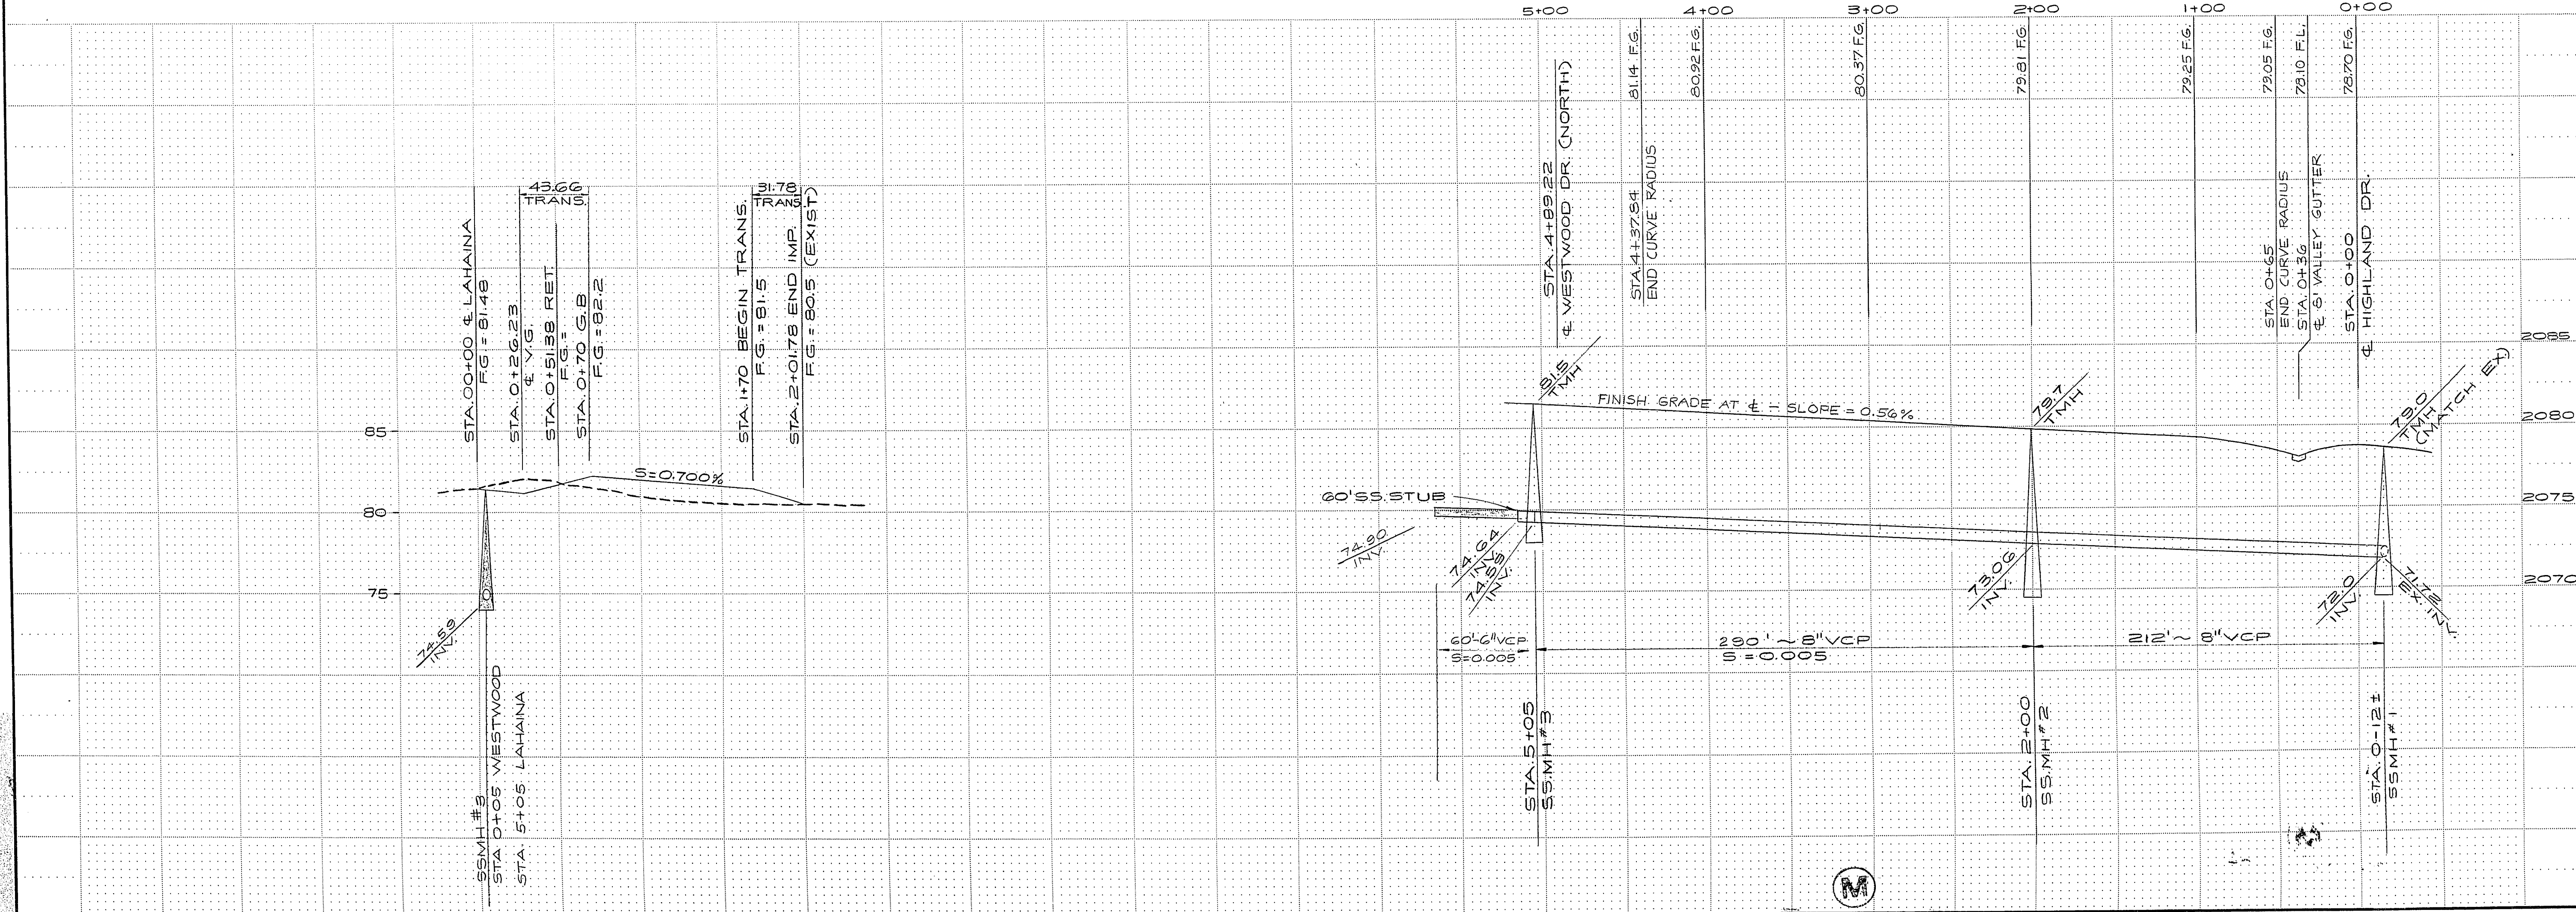

REVISIONS	NO.	DESCRIPTION/DATE	BY
ADD V2 STREET	1	1/22/79	RET

1/22/79

SPARKS, NEVADA
LAS VEGAS, NEVADA
SEATTLE, WASHINGTON
PORTLAND, OREGON
INCORPORATED
ENGINEERS/PLANNERS

UNITED OUTDOOR ADVERTISING
STREET PLAN / PROFILE & SEWER WATER
WESTWOOD DR. & EXIST. LAHAINA DR.

JOB NO. 2-0169-002-814
DESIGNED E.D.
DRAWN P.J.
COMP.
CHECKED
DATE