
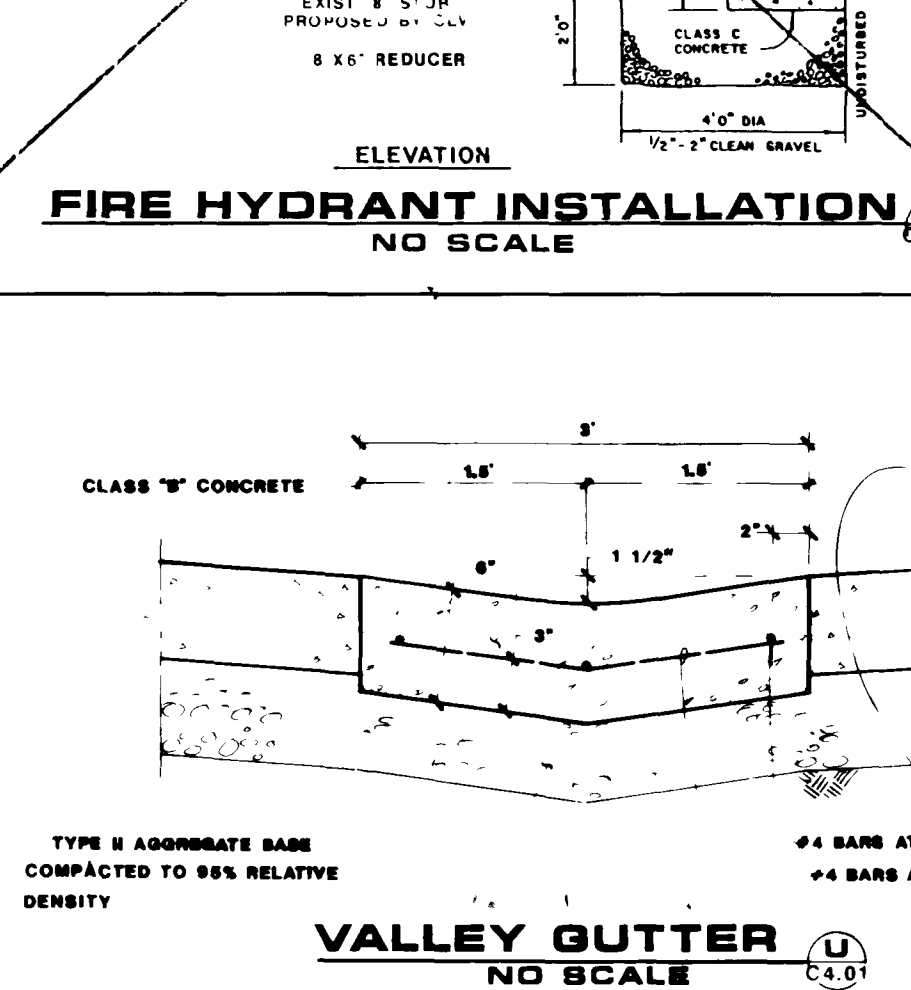
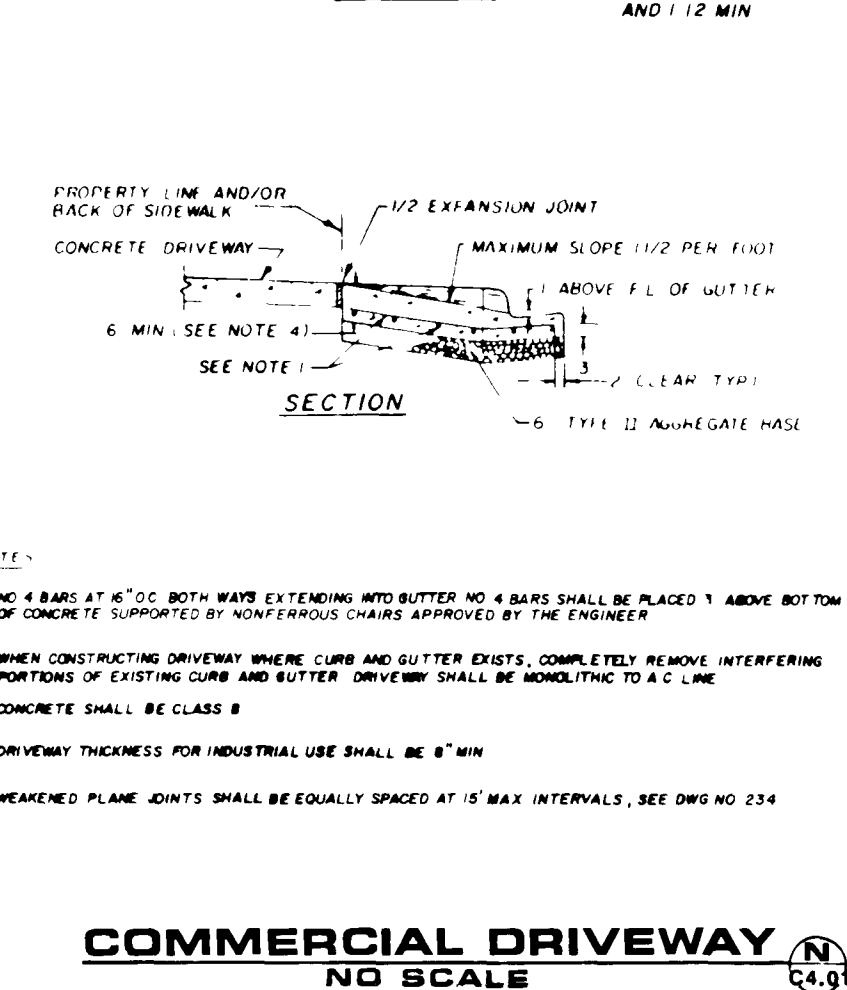
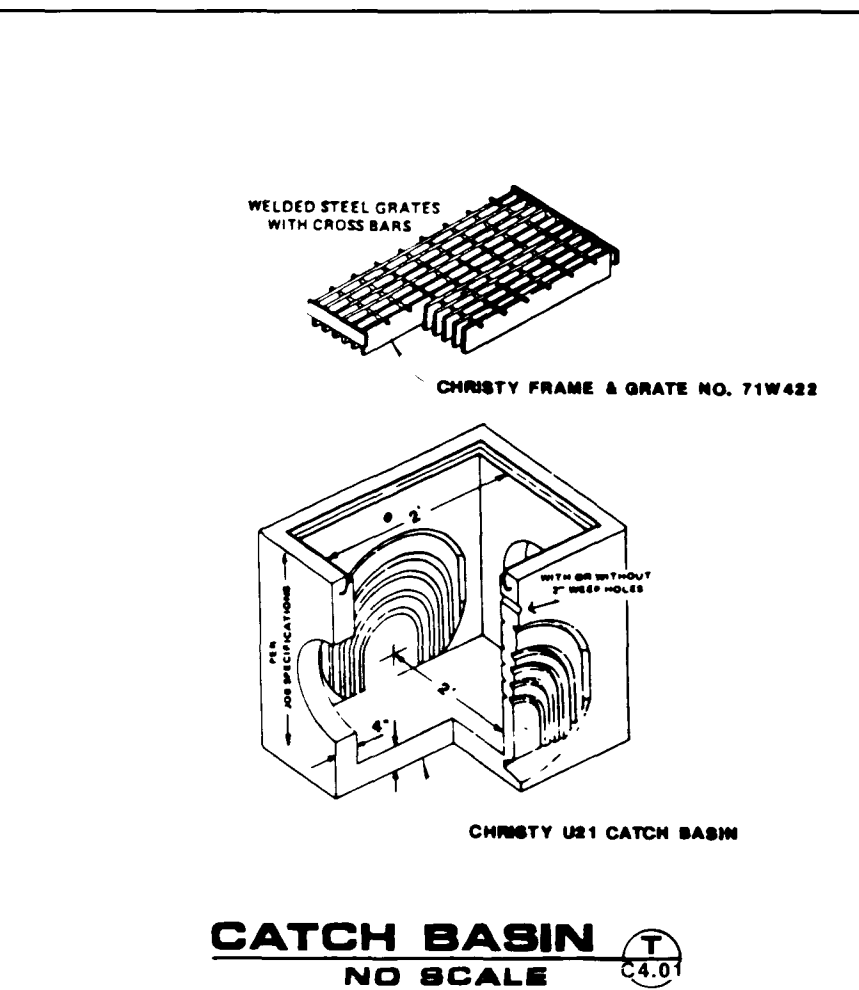
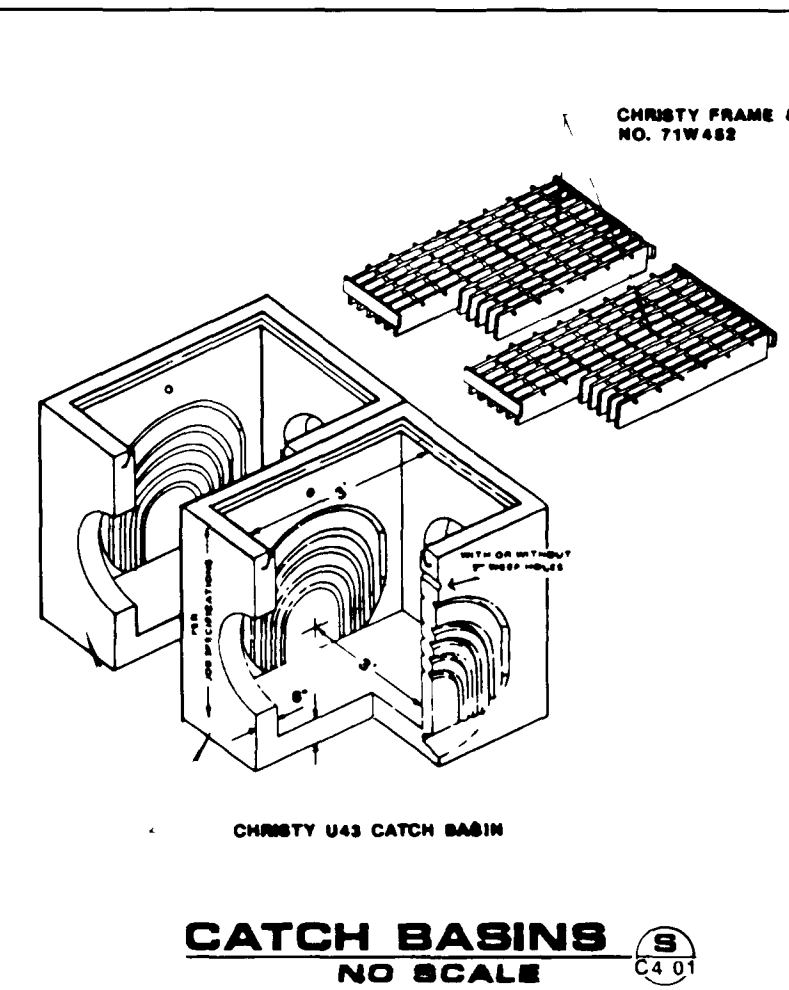
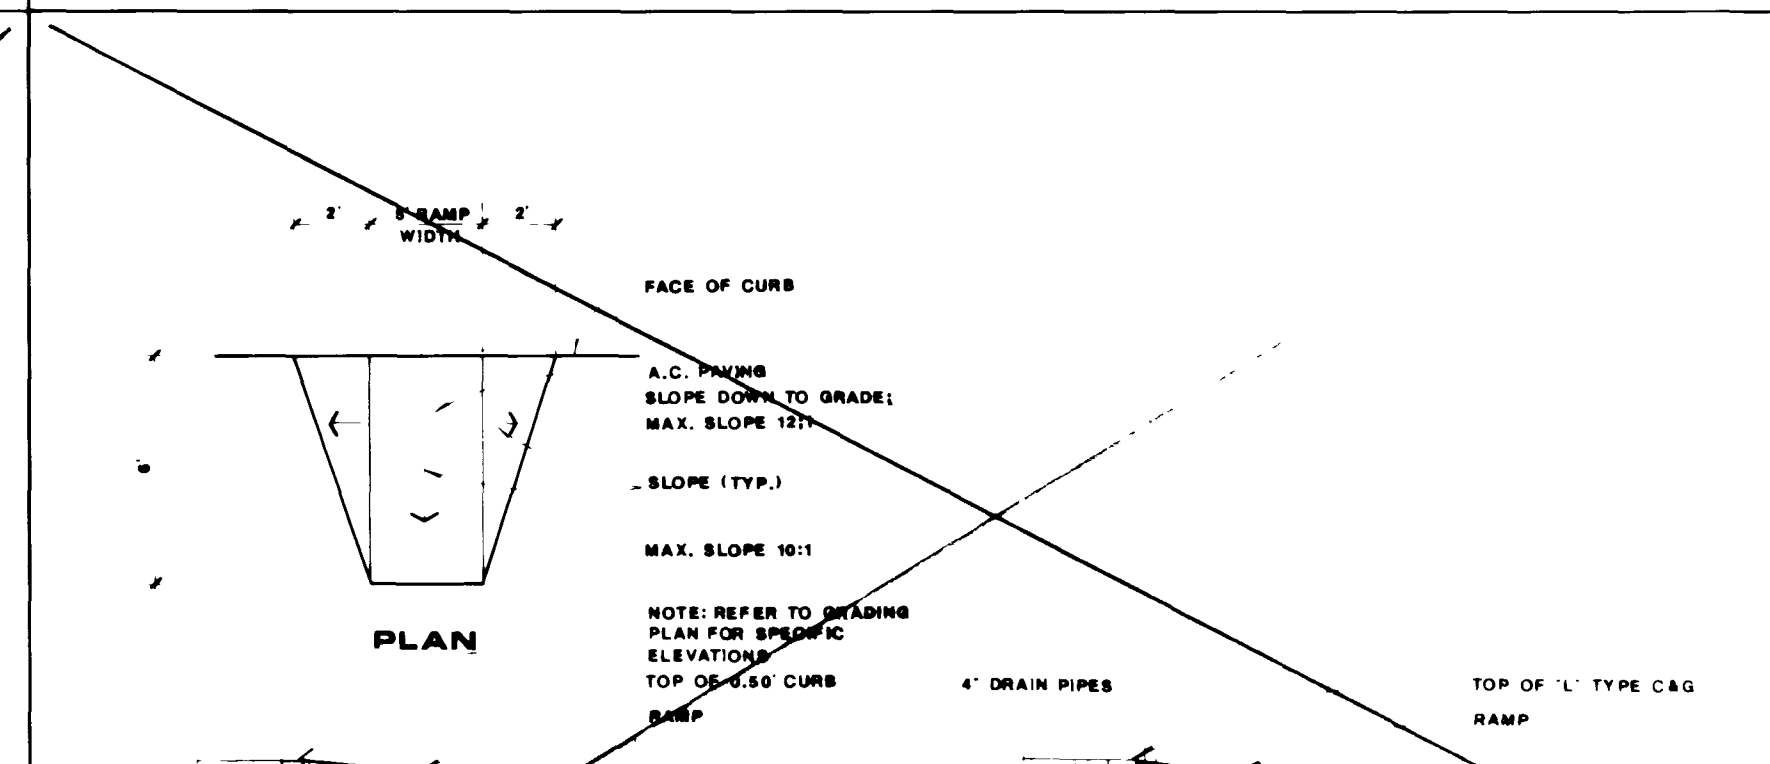
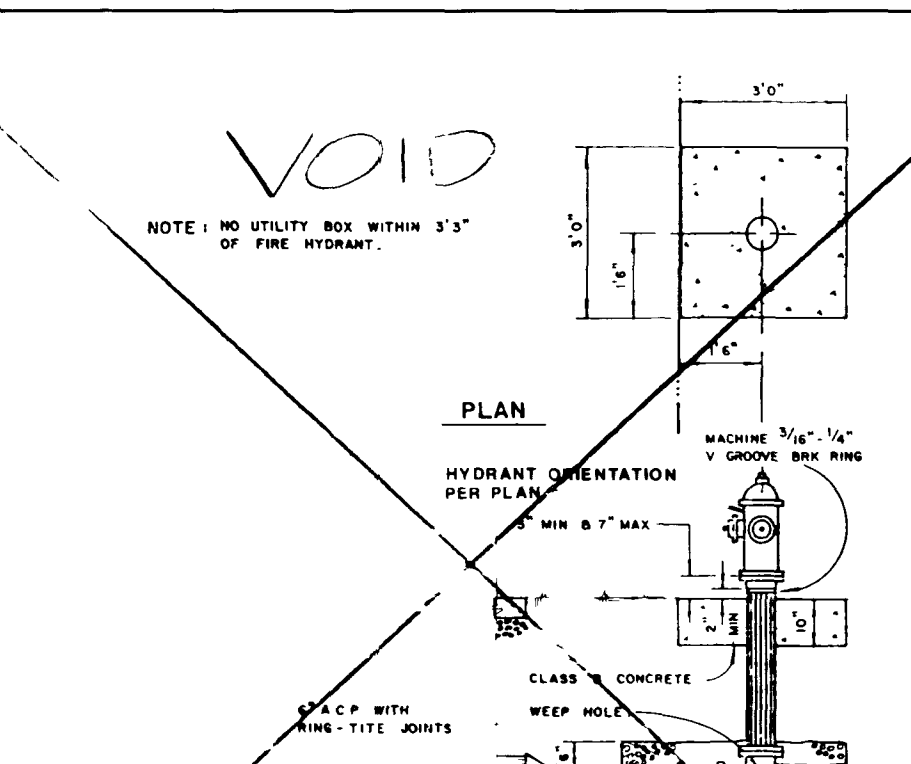
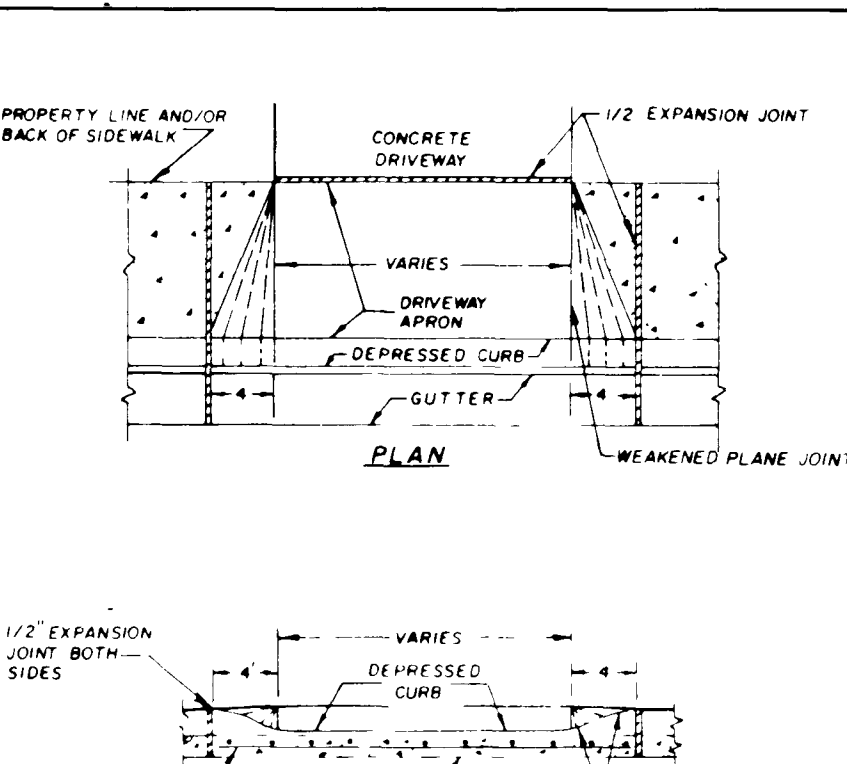
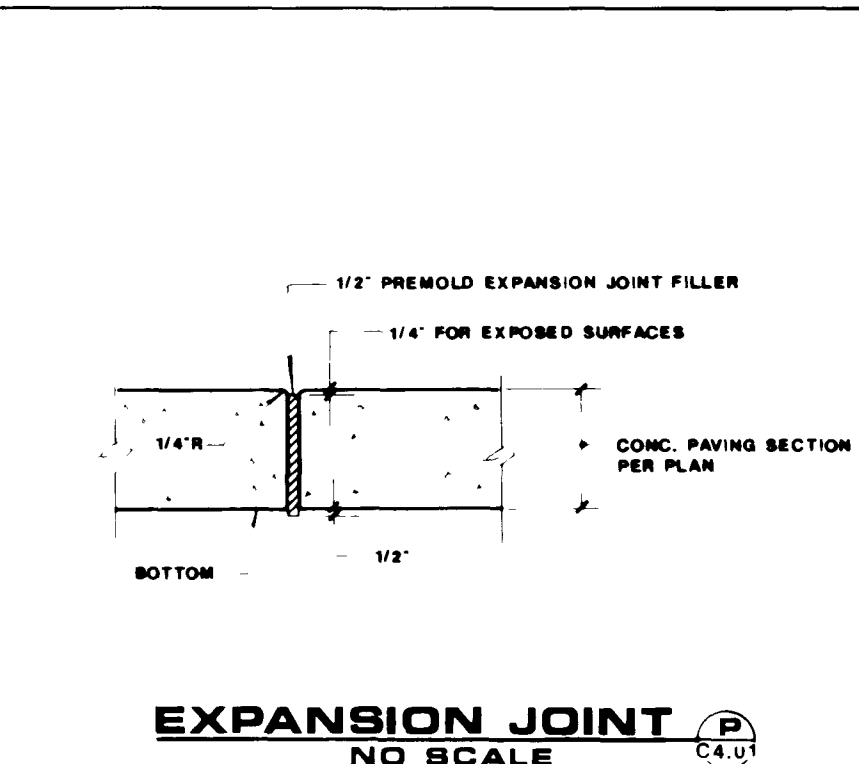
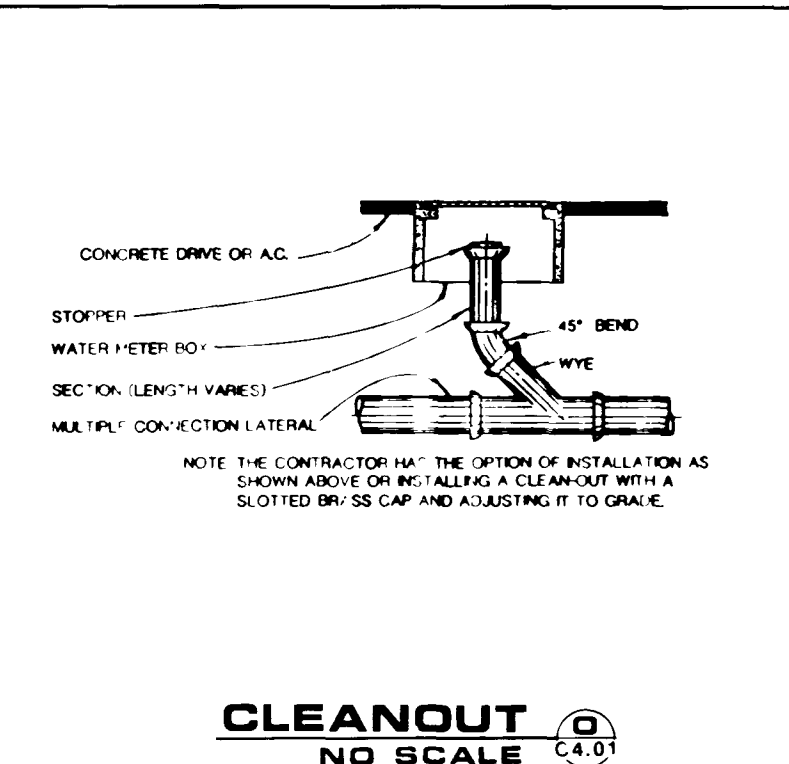
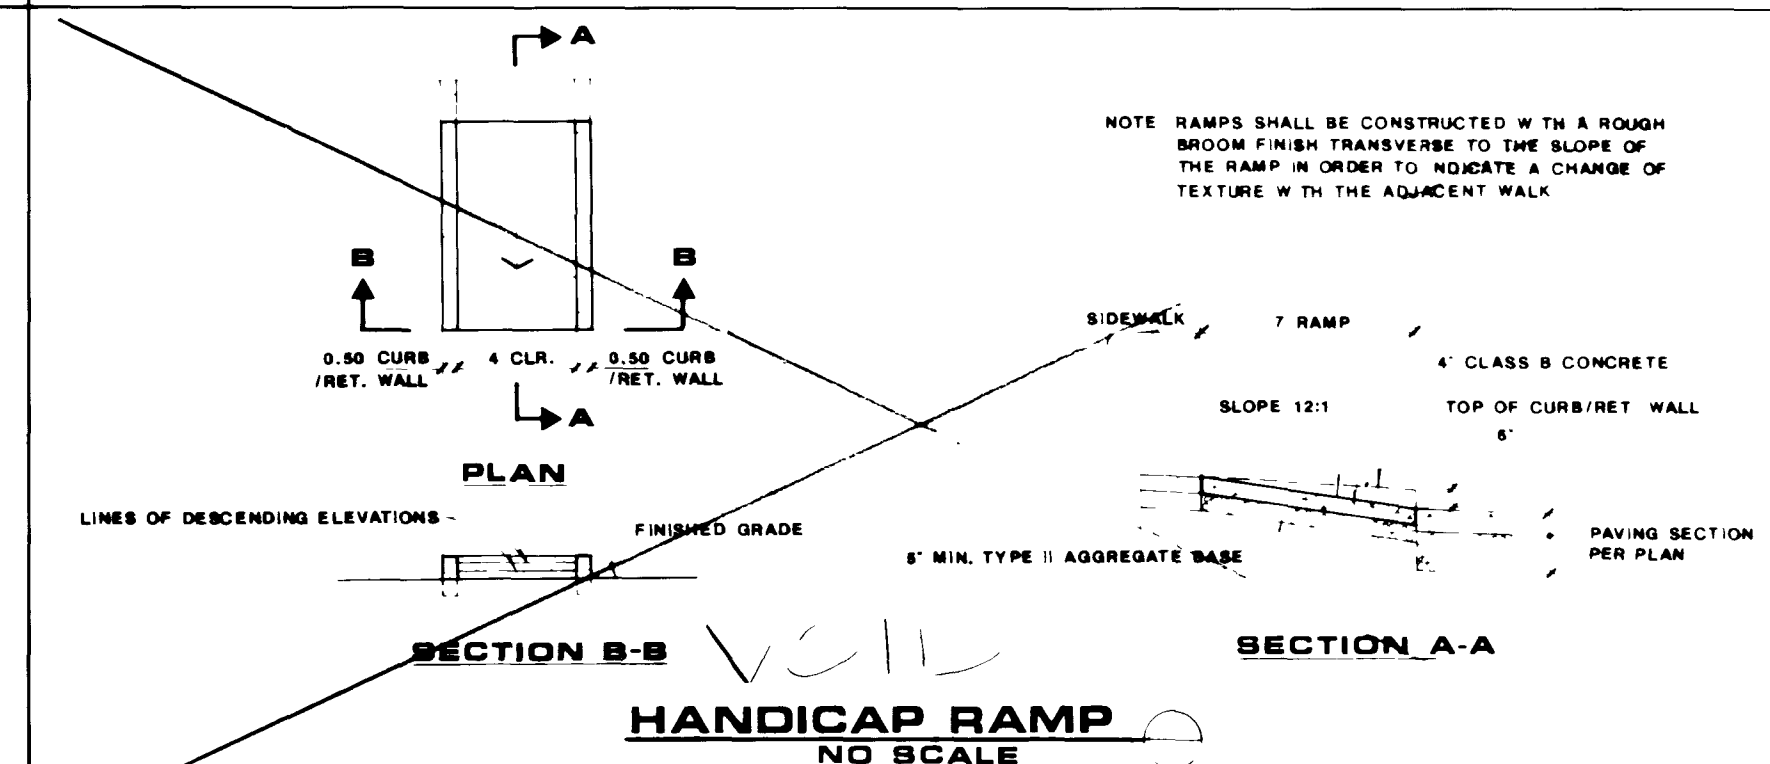
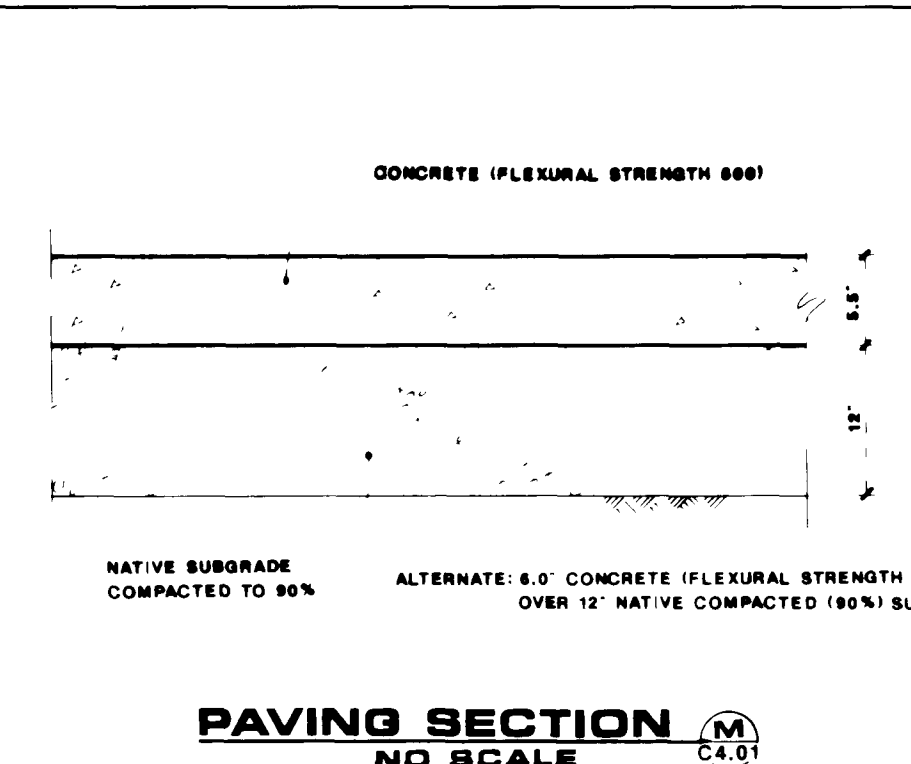
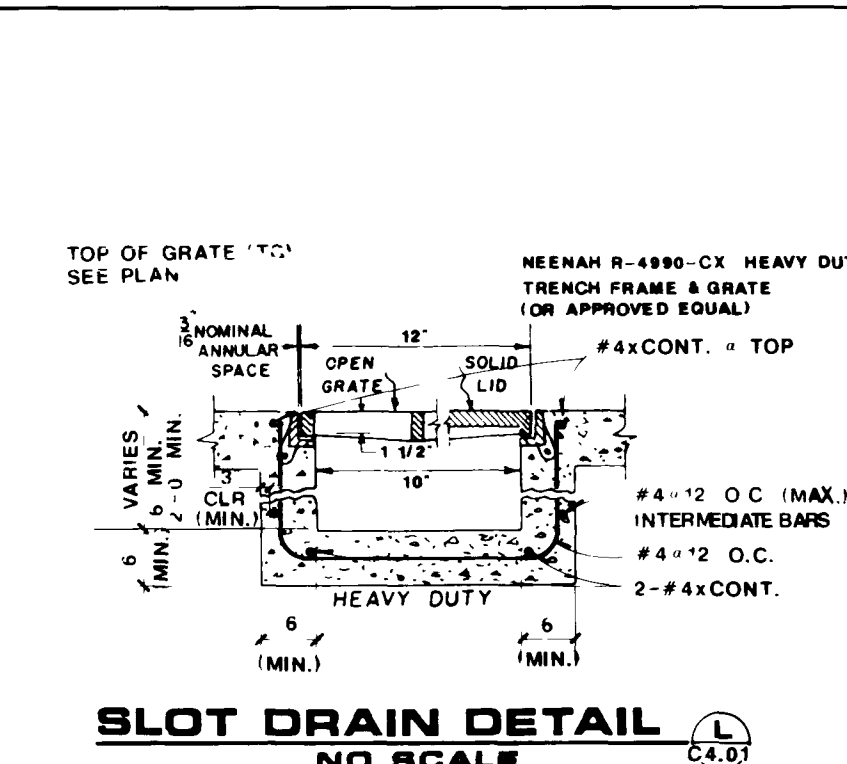
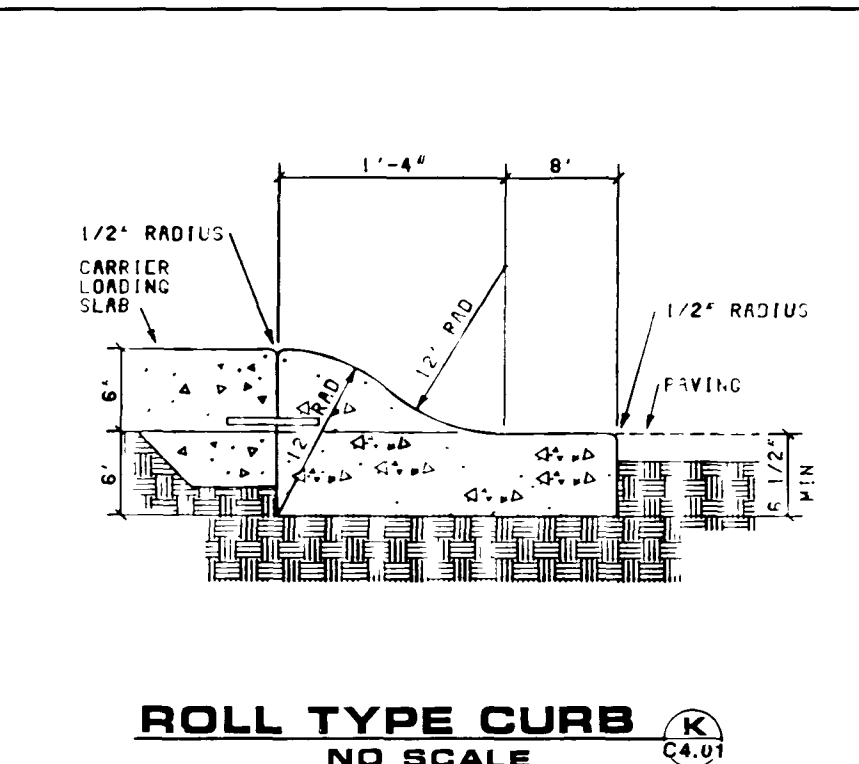
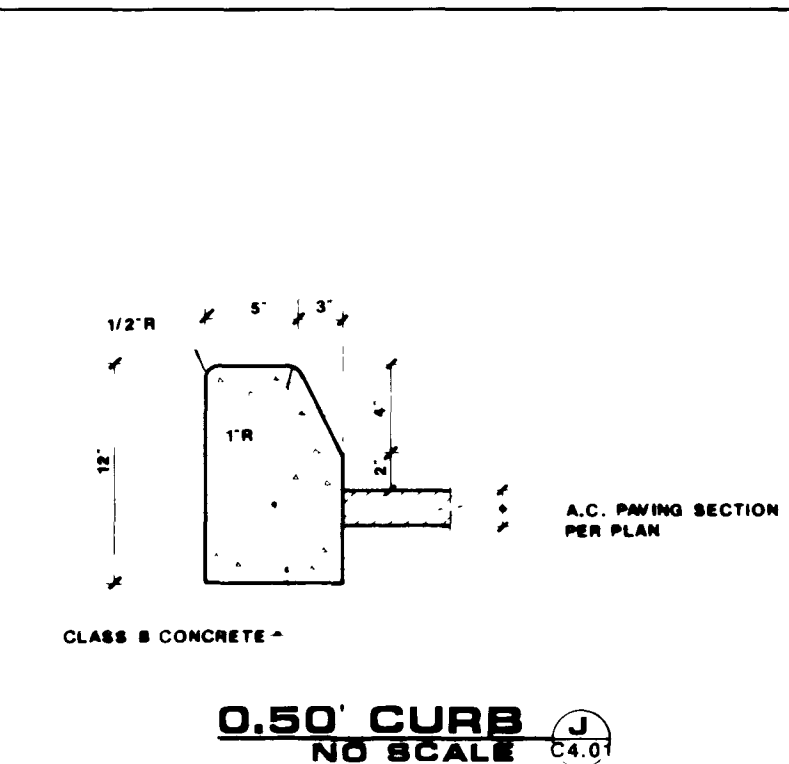
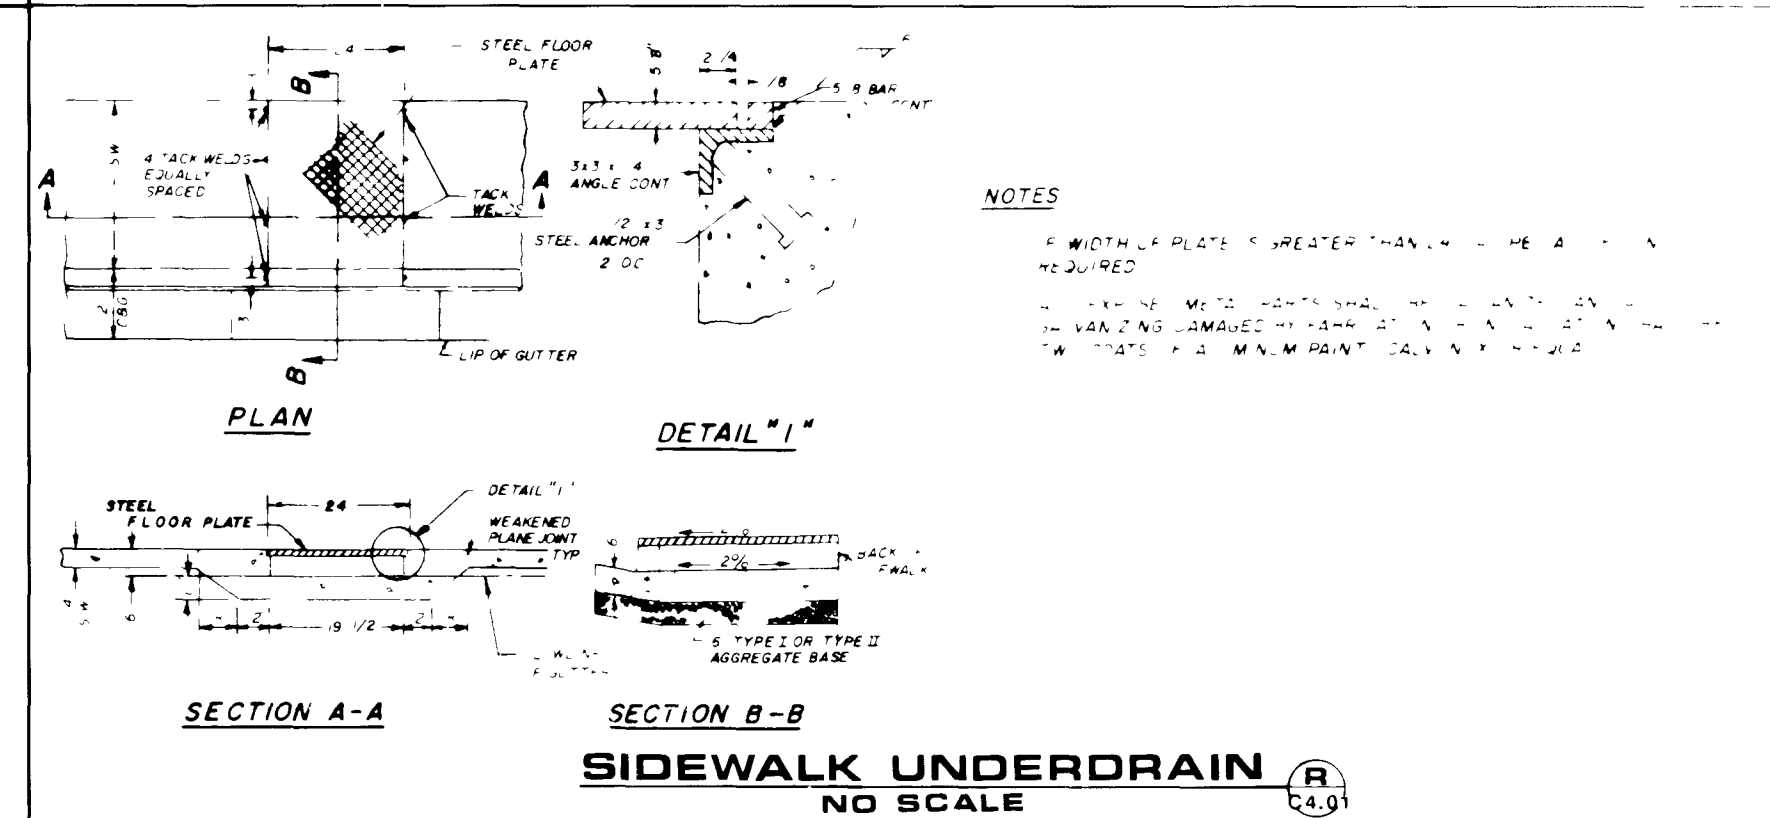
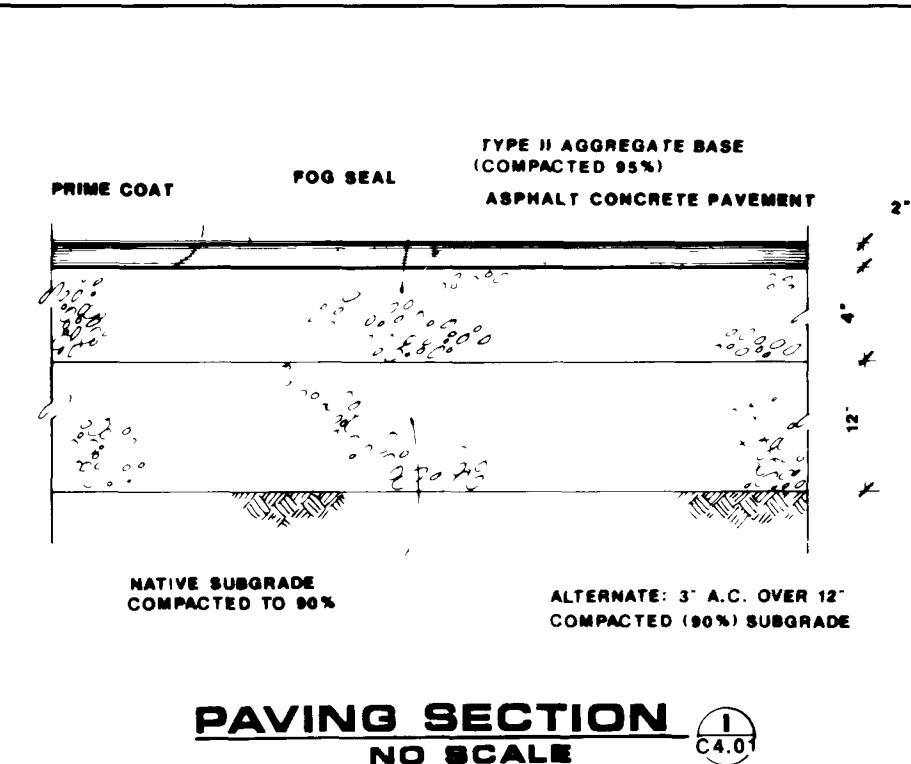
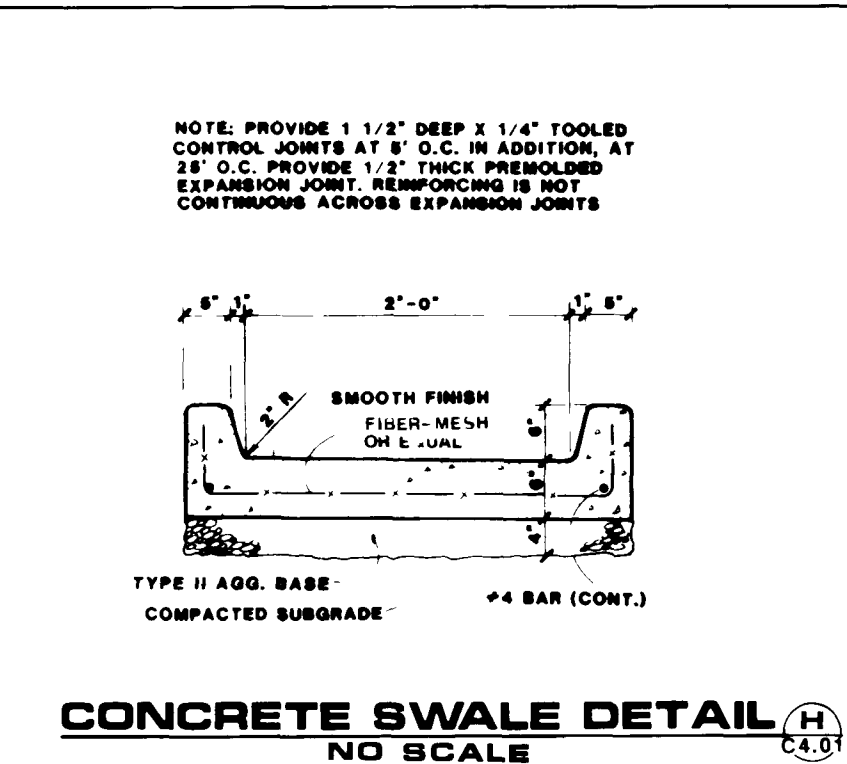
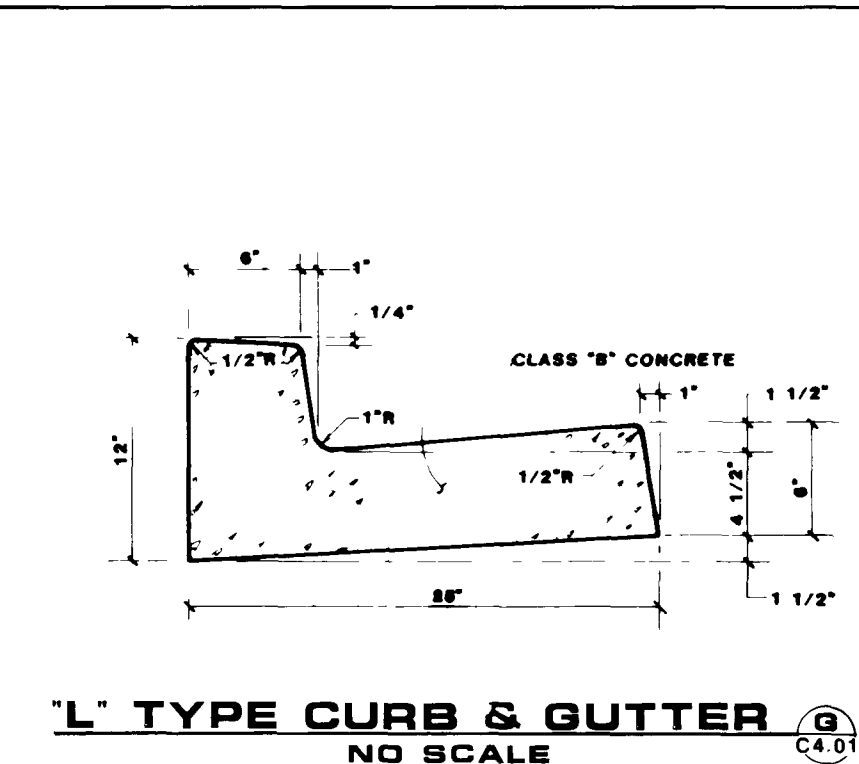
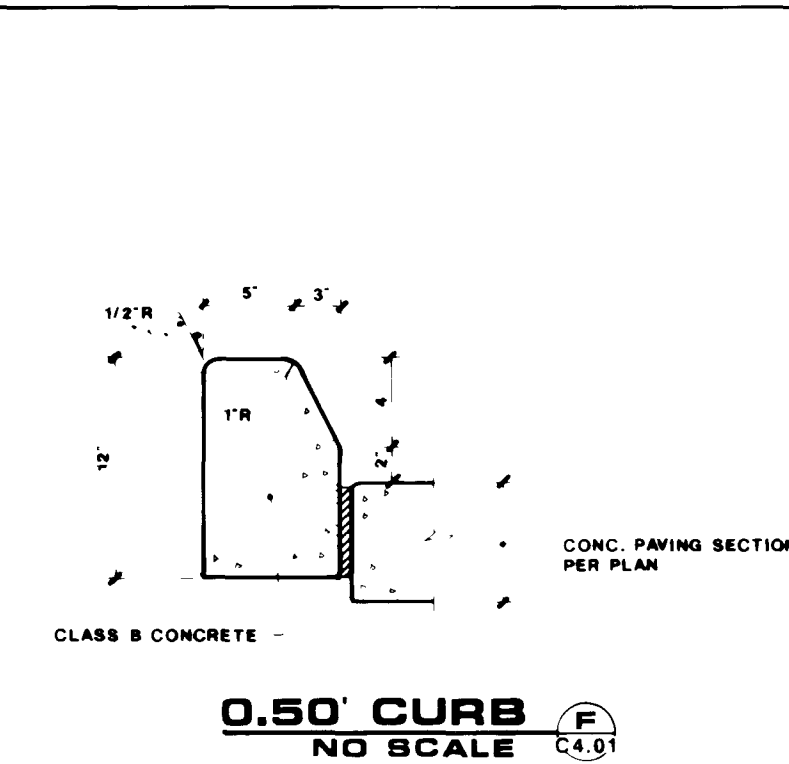
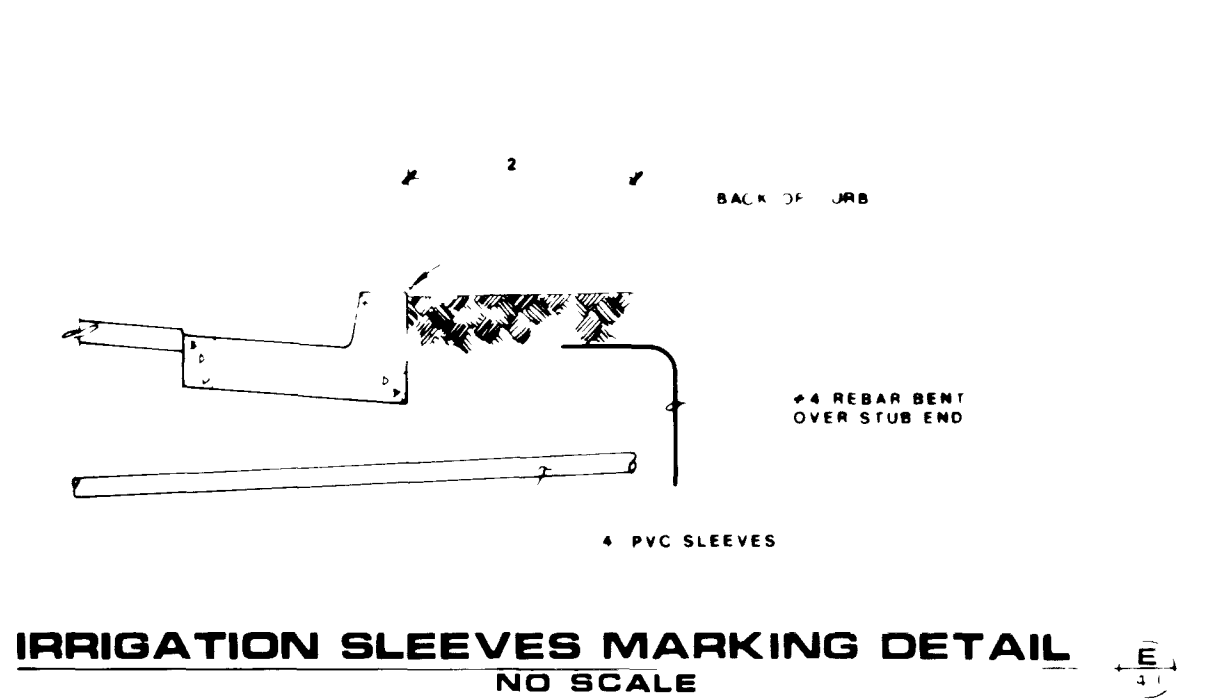
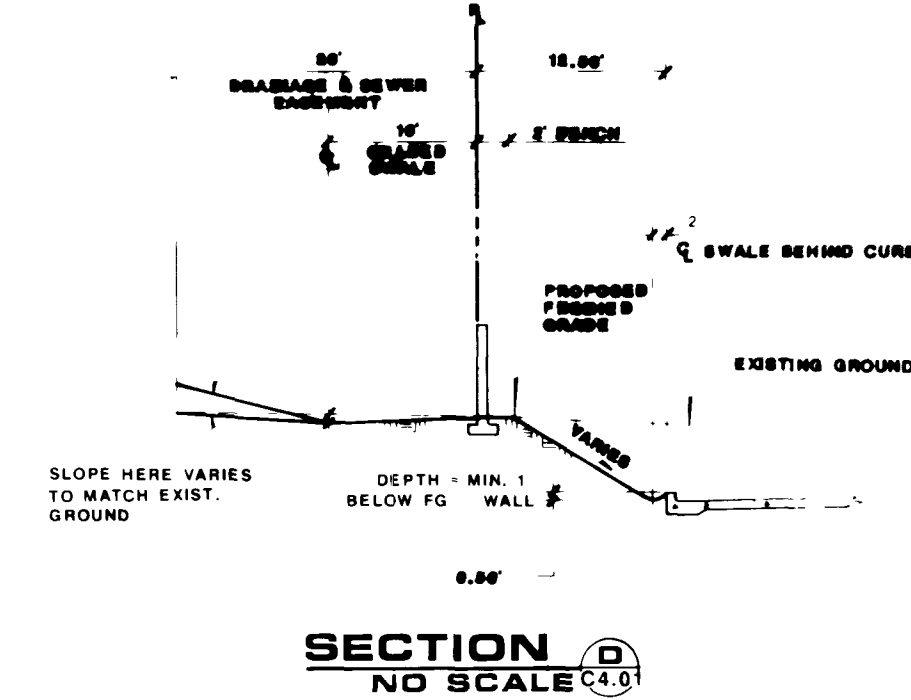
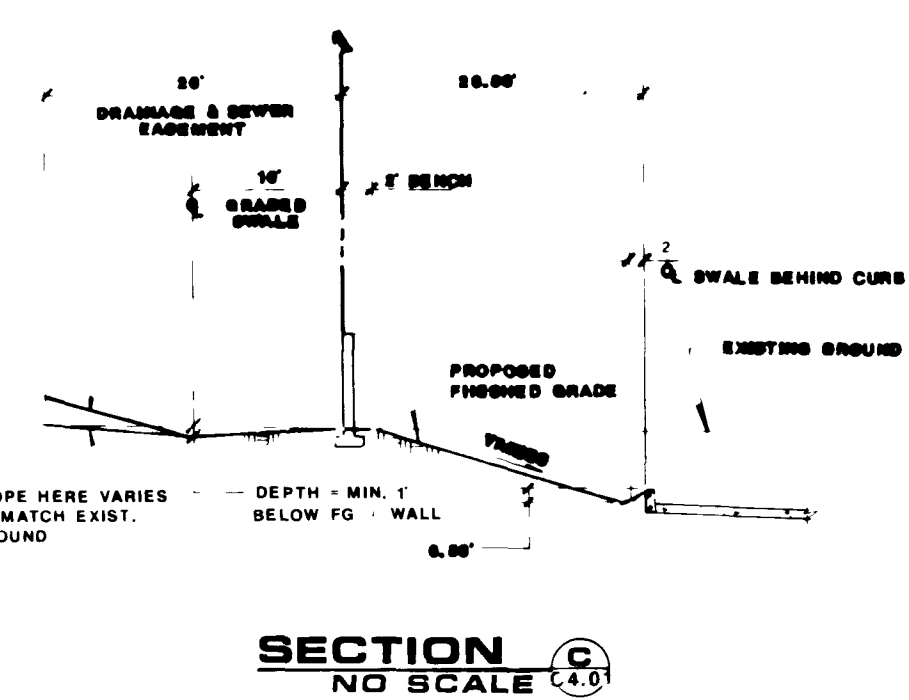
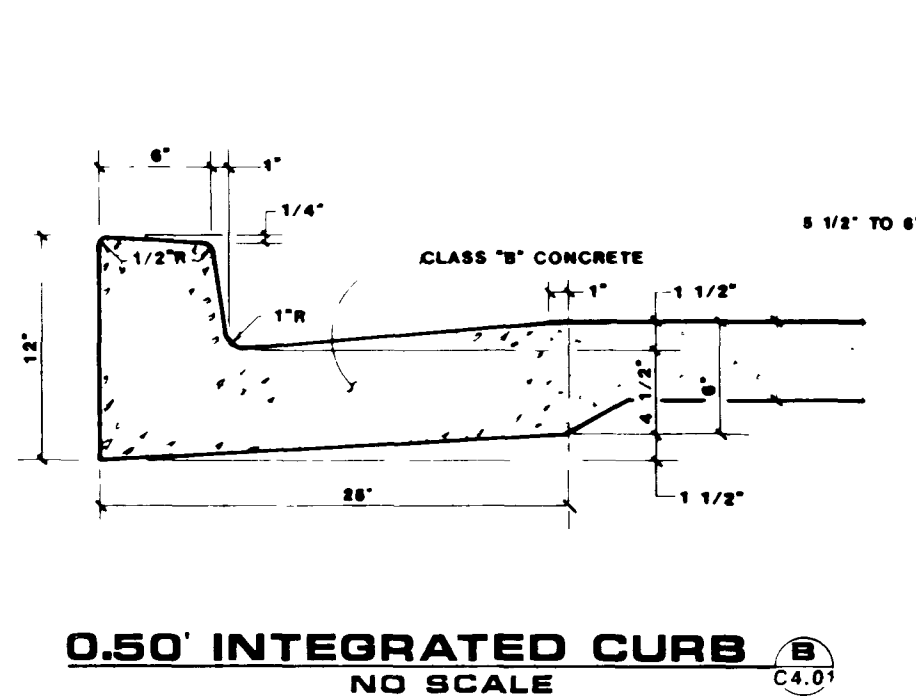


[illegible]

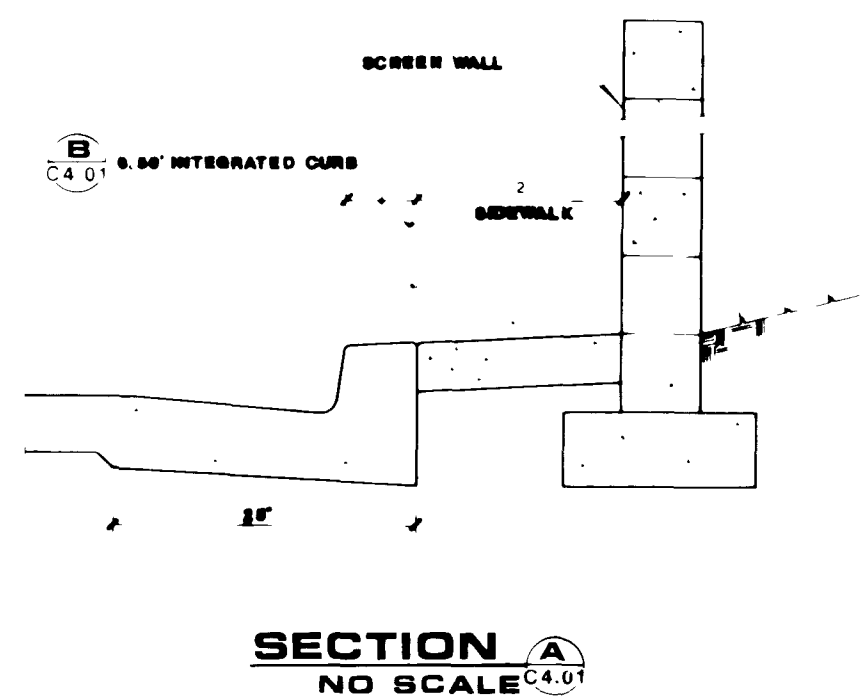