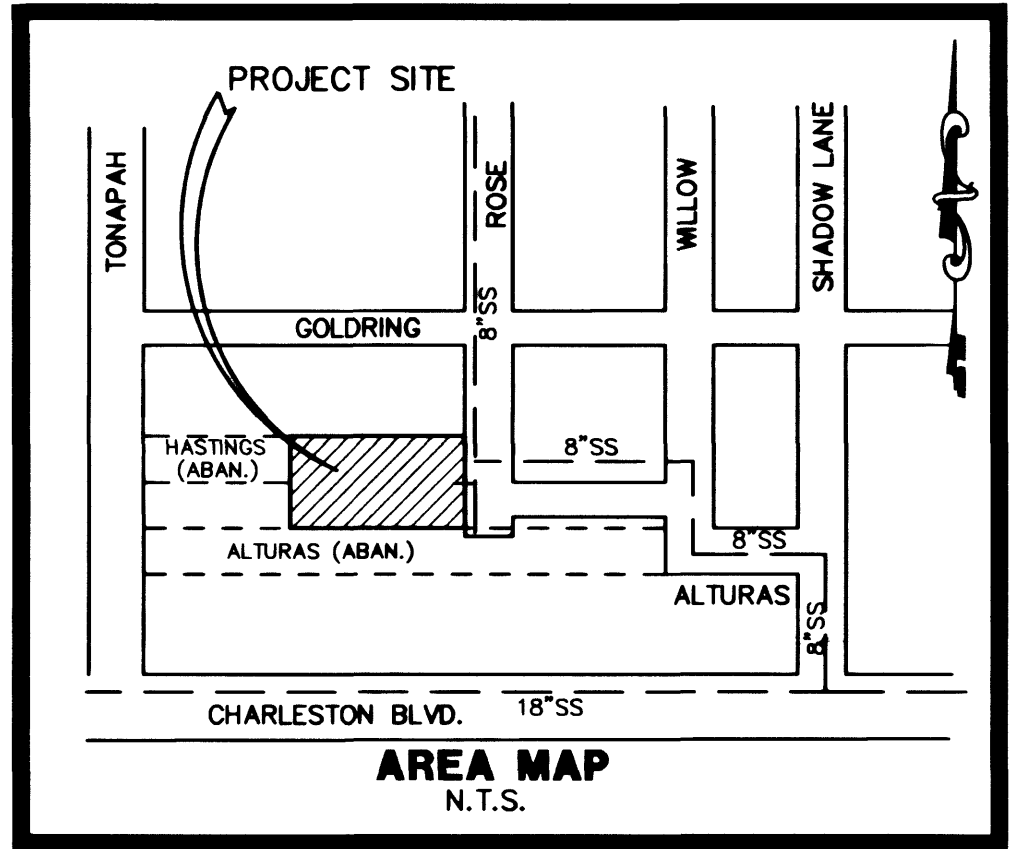
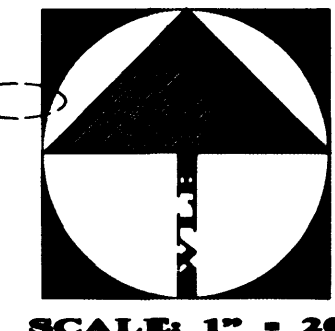
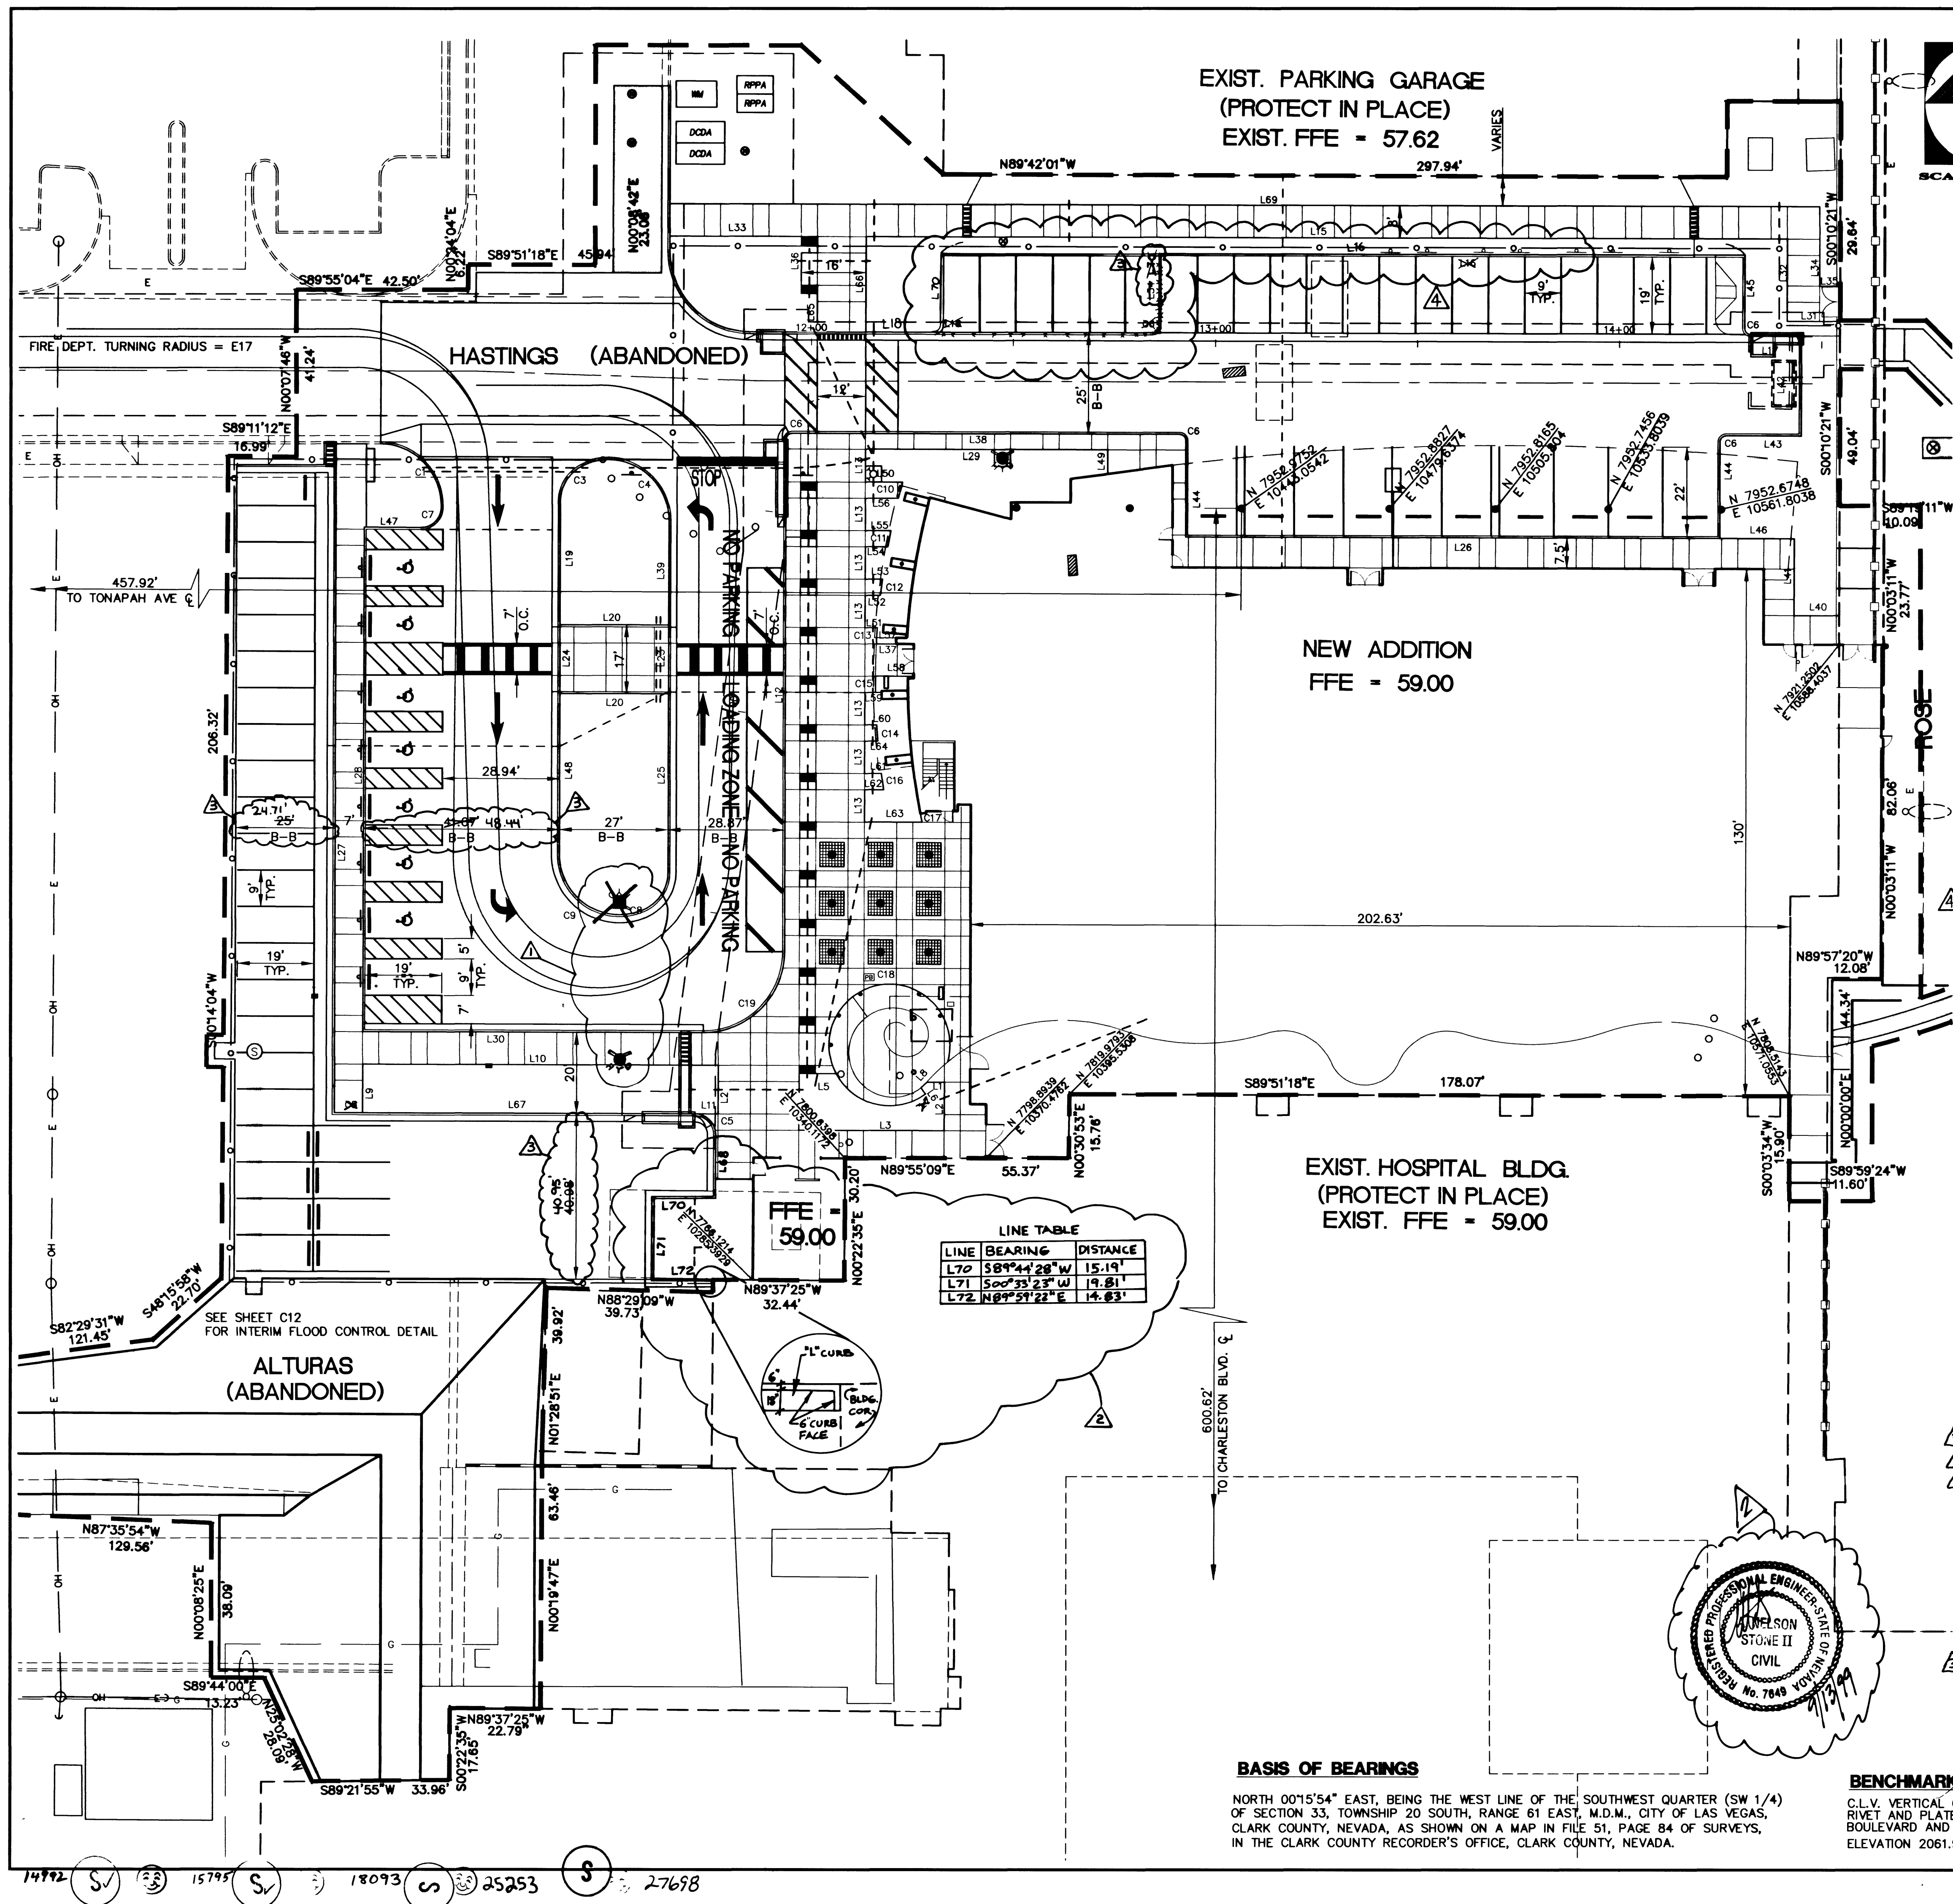


LINE TABLE		
LINE	BEARING	DISTANCE
L1	N89°51'18\"W	4.33'
L2	N0°08'42\"E	12.00'
L3	S89°51'18\"E	36.00'
L4	S0°08'42\"W	12.00'
L5	N89°51'18\"W	10.42' 9.18'
L6	S34°51'18\"E	1.91'
L7	S47°36'20\"W	1.57'
L8	S42°16'23\"W	4.48' 1.57'
L9	S0°08'42\"W	11.84' 17.00'
L10	N89°51'18\"W	96.99' 88.60'
L11	S89°51'18\"E	5.71'
L12	S0°08'42\"W	126.37'
L13	N0°08'42\"E	8.00'
L14	N89°51'18\"W	3.63'
L15	S89°51'18\"E	228.00'
L16	N89°51'18\"W	16.00' 19.00'
L17	N89°51'18\"W	9.00' 12.50'
L18	N89°51'18\"W	39.50' 45.10'
L19	N0°08'42\"E	36.99' 30.45'
L20	N89°51'18\"W	27.00'
L21	N89°51'18\"W	1.50'
L22	S89°51'18\"E	1.50'
L23	N0°08'42\"E	16.00' 17.00'
L24	S0°08'42\"W	16.00' 17.00'
L25	S0°08'42\"W	61.99' 44.08'
L26	N89°51'18\"W	132.25'
L27	N0°08'42\"E	160.00' 165.18'
L28	S0°08'42\"W	127.56' 124.50'
L29	S89°51'18\"E	60.00'
L30	S89°51'18\"E	92.33' 84.31'
L31	N89°51'18\"W	13.14'
L32	S0°08'42\"W	20.27'
L33	S89°51'18\"E	32.54'
L34	S0°08'42\"W	19.53'
L70	S0°08'42\"W	18.00'

LINE TABLE		
LINE	BEARING	DISTANCE
L35	N89°51'18\"W	5.14'
L36	S0°08'42\"W	12.00' 8.31'
L37	N89°51'18\"W	4.90'
L38	N89°51'18\"W	95.98'
L39	S0°08'42\"W	39.47' 25.87'
L40	S89°51'18\"E	11.21'
L41	N0°08'42\"E	19.00'
L42	S0°08'42\"W	25.00'
L43	N89°51'18\"W	16.00' 18.50'
L44	N0°08'42\"E	23.77'
L45	S0°08'42\"W	18.00'
L46	N89°51'18\"W	18.33'
L47	S89°51'18\"E	14.00'
L48	N0°08'42\"E	48.00' 39.50'
L49	S0°08'42\"W	5.80'
L50	S89°51'18\"E	9.26'
L51	S89°51'18\"E	3.06'
L52	S89°51'18\"E	3.80'
L53	S89°51'18\"E	4.30'
L54	S89°51'18\"E	5.58'
L55	S89°51'18\"E	6.36'
L56	S89°51'18\"E	8.20'
L57	S89°51'18\"E	4.90'
L58	S89°51'18\"E	9.50'
L59	S89°51'18\"E	2.65'
L60	S89°51'18\"E	2.98'
L61	S89°51'18\"E	4.14'
L62	S89°51'18\"E	4.70'
L63	S89°51'18\"E	14.28'
L64	S89°51'18\"E	3.28'
L65	S0°08'42\"W	9.50'
L66	S0°08'42\"W	23.50'
L67	S89°51'18\"E	38.99' 31.11'
L68	N0°08'42\"E	35.99' 15.92'
L69	S89°51'18\"E	284.54'

CURVE TABLE							
CURVE	RADIUS	DELTA	TANGENT	LENGTH	R.P. NORTHING	R.P. EASTING	
C1	15.00'	51°18'19"	7.20'	13.43' 24.31'	7953.7661	10222.2284	
C2	10.00'	114°11'21"	15.45'	19.93'	7958.3219	10224.2887	
C3	10.00'	66°25'19"	6.55'	11.59'	7961.0742	10280.0938	
C4	15.00'	113°34'41"	22.91'	29.73'	7956.4866	10282.0822	
C5	5.00'	90°00'00"	5.00'	7.85'	7808.7787	10218.9104	
C6	1.50'	90°00'00"	1.50'	2.36'	7969.6181	10427.7629	
C7	5.00'	104°30'20"	6.46'	9.42' 7.65'	7956.2463	10231.9159	
C8	10.00'	56°15'04"	5.35'	9.92' 11.31'	7855.2799	10286.8262	
C9	1.50'	123°44'56"	27.13'	31.22' 21.13'	7859.0279	10284.3356	
C10	181.25'	01°18'31"	2.07'	4.14'	7910.3764	10533.6735	
C11	181.25'	01°17'17"	2.04'	4.08'	7910.3764	10533.6735	
C12	181.25'	01°16'28"	2.02'	4.03'	7910.3764	10533.6735	
C13	181.25'	01°16'00"	2.00'	4.01'	7910.3764	10533.6735	
C14	181.25'	01°16'05"	2.01'	4.01'	7910.3764	10533.6735	
C15	181.25'	01°15'52"	2.00'	4.00'	7910.3764	10533.6735	
C16	181.25'	01°16'37"	2.02'	4.04'	7910.3764	10533.6735	
C17	173.25'	00°42'26"	1.07'	2.14'	7910.3764	10533.6735	
C18	15.00'	233°13'47"	29.93'	62.06' 84.37'	7820.5284	10355.9689	
C19	20.00'	90°00'00"	20.00'	31.42'	7843.5485	10309.9645	

R.P. = RADIUS POINT

BASIS OF BEARINGS


NORTH 001°55'4\"E, BEING THE WEST LINE OF THE SOUTHWEST QUARTER (SW 1/4) OF SECTION 33, TOWNSHIP 20 SOUTH, RANGE 61 EAST, M.D.M., CITY OF LAS VEGAS, CLARK COUNTY, NEVADA, AS SHOWN ON A MAP IN FILE 51, PAGE 84 OF SURVEYS, IN THE CLARK COUNTY RECORDER'S OFFICE, CLARK COUNTY, NEVADA.

BENCHMARK

C.L.V. VERTICAL CONTROL NO. 9, STATION 2LV01, 33SSWS RIVET AND PLATE IN TOP OF CURB, NE RETURN CHARLESTON BOULEVARD AND TONAPAH DRIVE. ELEVATION 2061.91 FEET = 628.4724 METERS (NAVD 88)

Call before you Overhead 593-6111

Call before you Dig. 1-800-227-2600

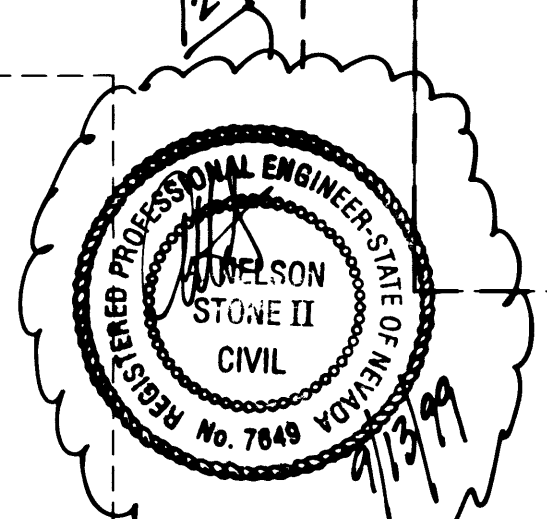

ARCH: HOLMES SABATINI ASSOCIATES
1 COMMERCE CENTER DRIVE
HENDERSON, NV 89014
(702) 498-1008

HORIZONTAL CONTROL

SHEET TITLE: UNIVERSITY MEDICAL CENTER
ER/ICU/CCU ADDITION

Drawn by: OF
Designed by: TDA
Checked by: THL
Project No.: 497024-001
Scale: 1\"= 20\" (H)
1\"= 2\" (V)

8/19/98

5 OF 13 SHEETS
DRAWING NO. 107-V2911

REVISION
REV DATE BY
1 5/14/98 JH
2 5/14/98 JH
PROJECT: UNIVERSITY MEDICAL CENTER
ER/ICU/CCU ADDITION
SHEET: 5 OF 13
DRAWING NO. 107-V2911

Engineering • Landscape Architecture
Planning • Urban Design • Surveying
2551 N. Green Valley Pkwy., Suite A425
HENDERSON, NV 89014(702) 438-2551

The WLB Group
WLB Group, Inc.