
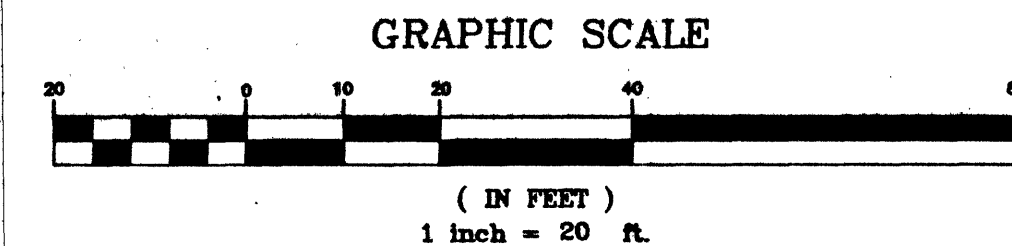


Call before you Dig.
1-800-227-2600
UNDERGROUND SERVICE (USA)

UTILITY LOCATIONS SHOWN HEREON ARE APPROXIMATE ONLY. IT SHALL BE THE CONTRACTOR'S RESPONSIBILITY TO DETERMINE THE EXACT VERTICAL AND HORIZONTAL LOCATION OF ALL EXISTING UNDERGROUND UTILITIES PRIOR TO COMMENCING CONSTRUCTION. NO REPRESENTATION IS MADE THAT ALL EXISTING UTILITIES ARE SHOWN HEREON. THE ENGINEER ASSUMES NO RESPONSIBILITY FOR UTILITIES NOT SHOWN OR UTILITIES NOT SHOWN IN THEIR PROPER LOCATION.

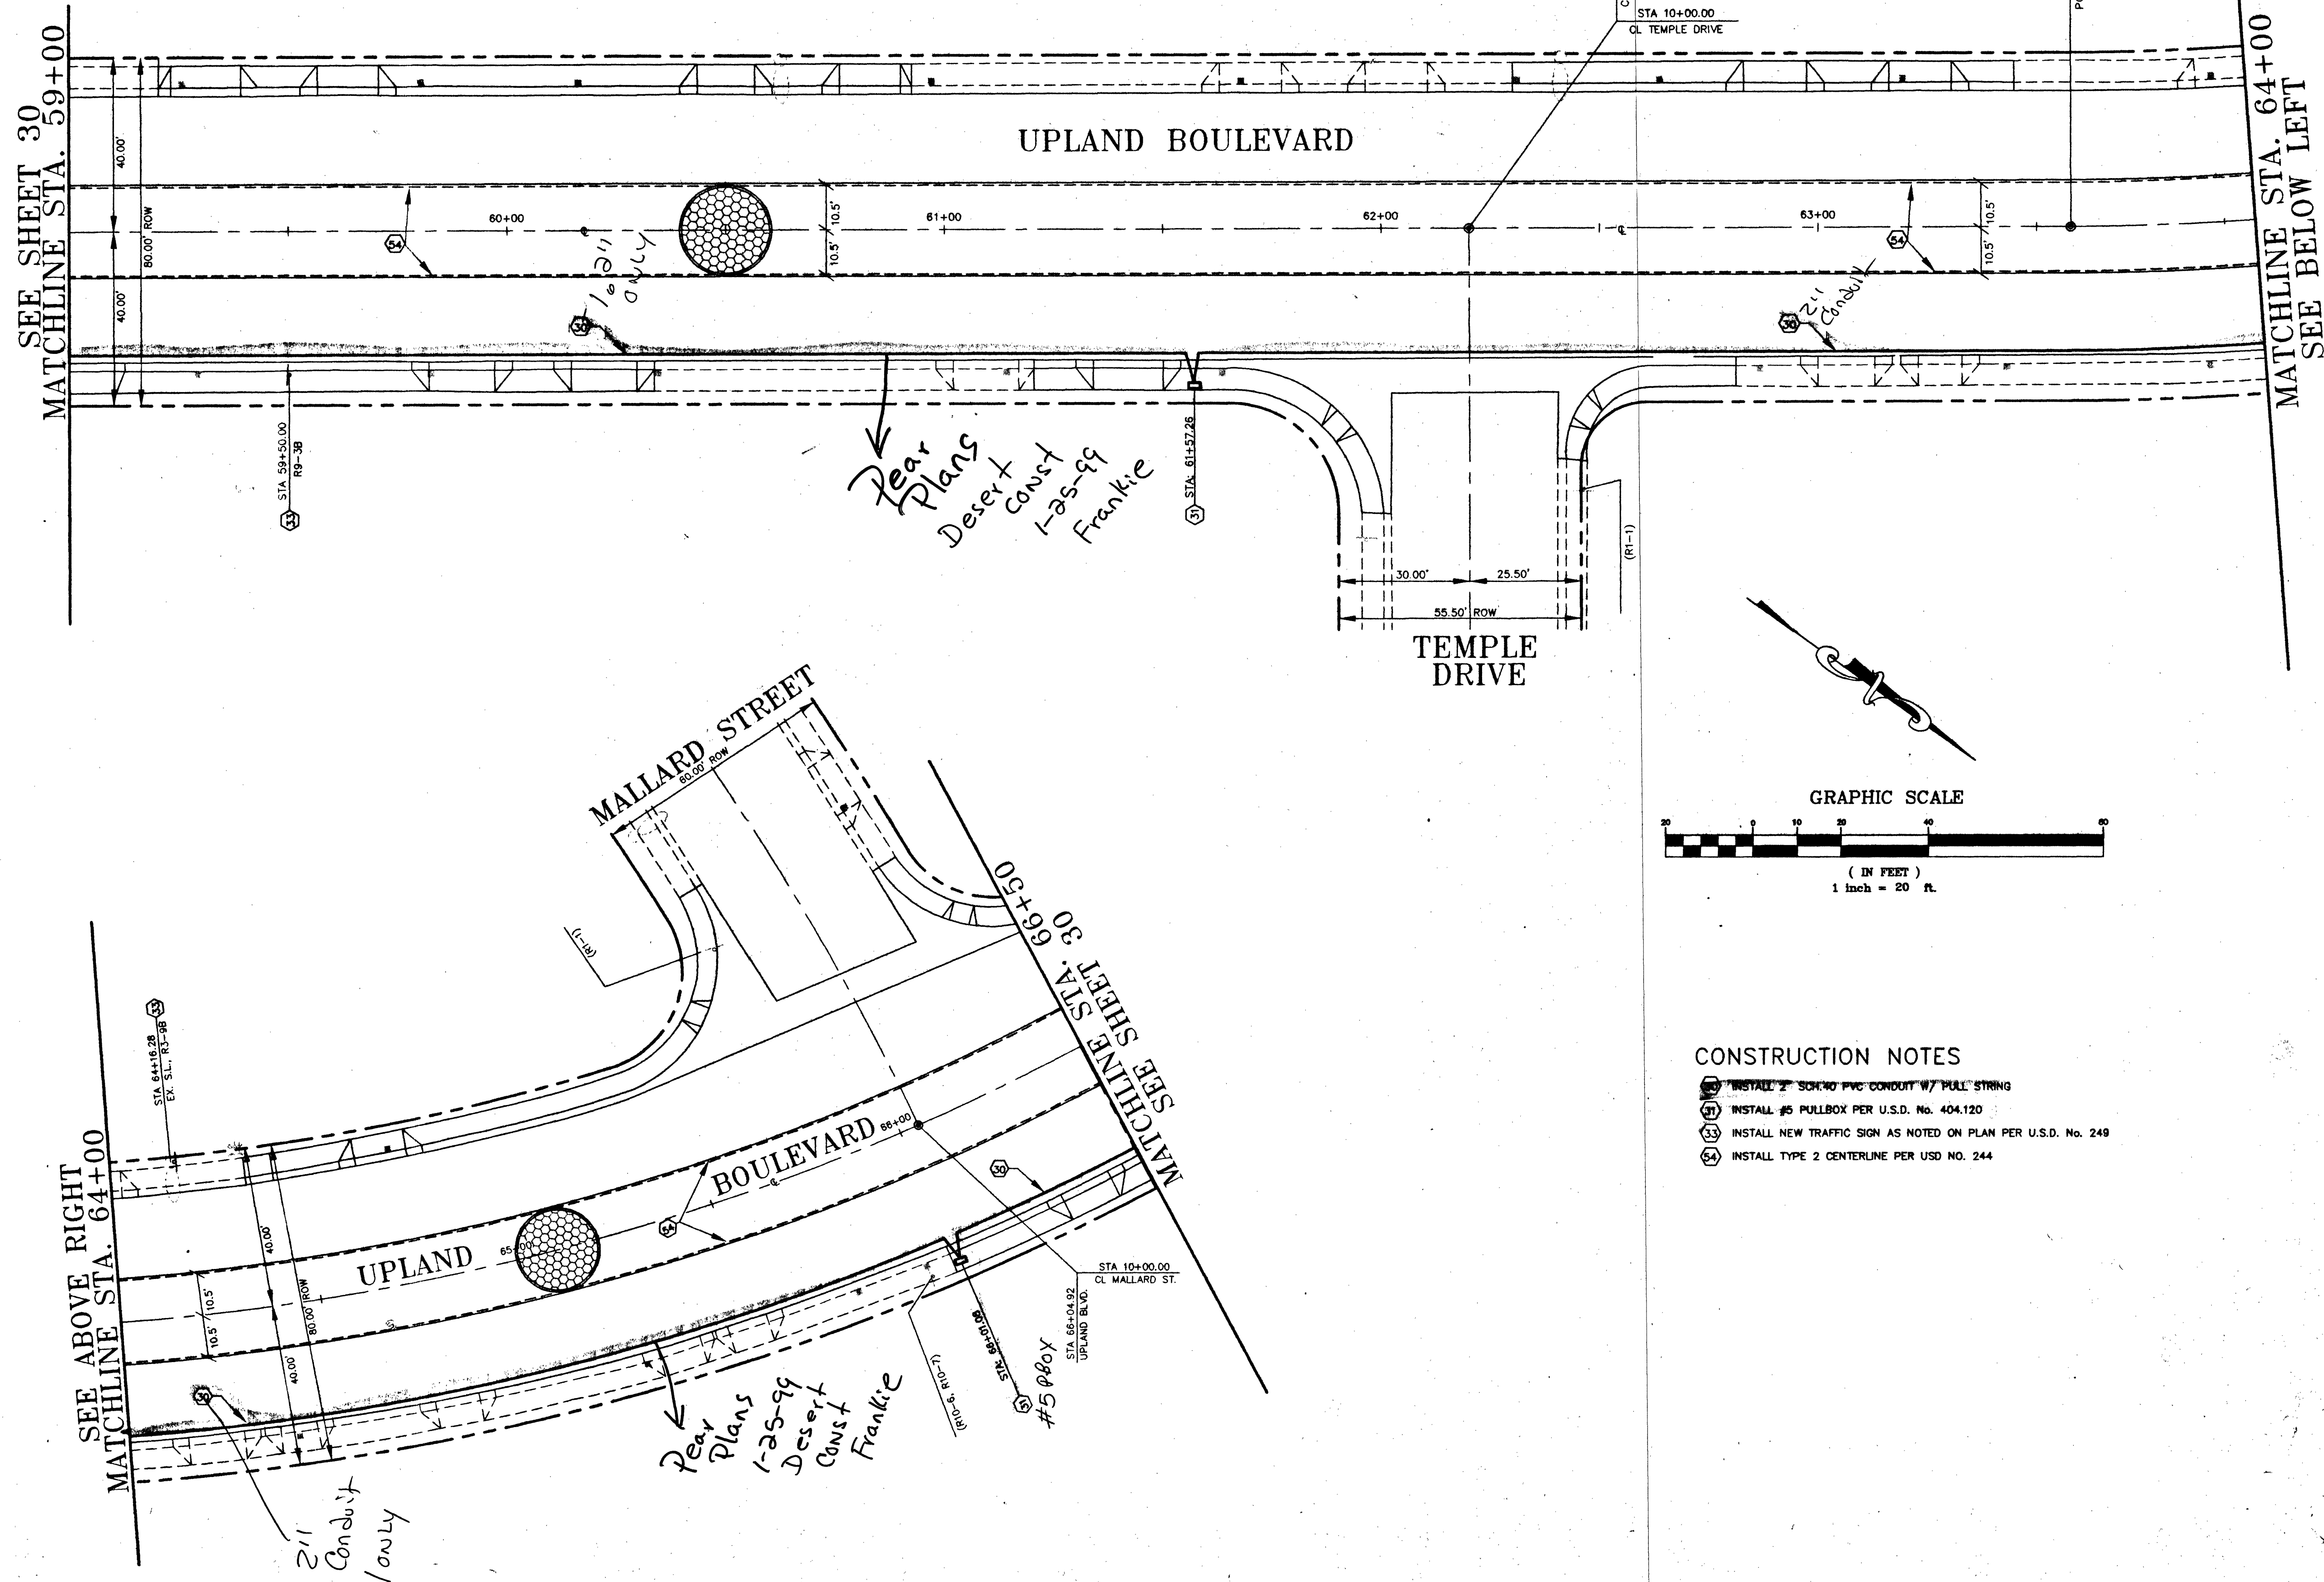

- CONSTRUCTION NOTES
- 1. INSTALL 2" SCH 40 PVC CONDUIT W/ PULL STRING
 - 2. INSTALL #5 PULLBOX PER U.S.D. No. 404.120
 - 3. INSTALL NEW TRAFFIC SIGN AS NOTED ON PLAN PER U.S.D. No. 249
 - 4. INSTALL TYPE 2 CENTERLINE PER USD NO. 244

REVISIONS				
	NO.	DATE	DESCRIPTION	APPROVED
PAVEMENT MANAGEMENT SECTION				
DRAWN BY: G.U.J. / E.S.M.				
DESIGNED BY: G.U.J. / E.S.M.				
CHECKED BY: D.L.A.				
DATE: JULY 23, 1998				
JOB NO. 99.1730.08				
1-31-98				
Department of Public Works				
UPLAND BOULEVARD				
TRAFFIC STRIPING				
STA. 59+00 TO STA. 66+50				
DRAWING No. 31				
107-V2750				