





MATCH LINE BOX "A" STA.163+00

~~5 STA. 162+37.50 (RCB A) CL
MODIFIED TYPE "C" D.I. #14
SEE SHEET SD6~~

CONSTRUCTION NOTES

- (1) CONSTRUCT 12'x8' RCB
 - (2) CONSTRUCT RCB MANHOLE PER DETAIL B, SHEET SD-1
 - (3) CONSTRUCT TRENCH SHORING SEE SHT UN FOR SHORING NOTES.
 - (5) SAWCUT AC..ACTUAL LOCATION TO BE DETERMINED BY THE ENGINEER AT TIME OF CONSTRUCTION
 - (11) REMOVE AND REPLACE EXISTING MEDIAN AND ISLAND PER DRAWING NO. 220
 - (12) REMOVE & REPLACE EXISTING CURB & GUTTER PER DRAWING NO. 216
 - (13) REMOVE AND REPLACE EXISTING MEDIAN ISLAND CURB PER DWG. NO. 219 SEE PD SHEETS FOR DETAILS
 - (20) RELOCATE EXISTING WATER MAIN SEE WATER RELOCATION PPW SHEETS
 - (21) RELOCATE EXISTING GAS MAIN (BY SW GAS).
 - (26) CONTRACTOR COORDINATION WITH SWG, SEE SWG NOTES ON SHEET UN

GRAPHIC SCALE

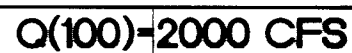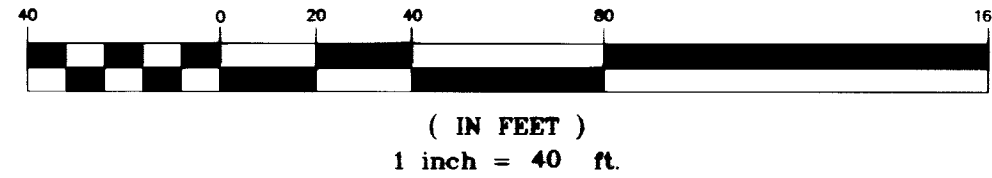

CE **Carter Burgess**
Consultants in Engineering,
Planning and the Environment
2955 East Sunset Road, Suite 105
Las Vegas, NV 89120
(702) 798-1007 Fax (702) 798-7056

DESIGNED:	ET/GKC	REVISONS			
DRAWN:	RP/JL/JS	N _o .	Date	CHKD	APPD
CHECKED:	GRB	<u>A</u>	7/28/99	MOD. TYPE "C" TO NDOT TYPE 11 D.I.	G.R.B. S.F.
JOB No:	681-95	<u>A</u>	7/28/99	DELETED DROP INLET	G.R.B. S.F.
HORIZ:	1"=40'	<u>A</u>	12/01/99	CHANGED D.I. FROM NDOT TYPE 11 TO G.R.B.	S.F.
VERT:	1"=4'			NEENAH HOOD TYPE D.I.	
DATE:	12/01/99				

Avoid cutting underground
 utility lines. It's costly.

**Call
 before you
 Dig.**

1-800-227-2600
OVERHEAD SERVICE ALERT LINE

SAFETY ALERT

**Call
 before you
 Overhead**

593-6111
OVERHEAD SERVICE ALERT