



- (1) CONSTRUCT 12'x8' RCB
- (2) CONSTRUCT RCB MANHOLE PER DETAIL B, SHEET SD-3
- (5) SAWCUT AC, ACTUAL LOCATION TO BE DETERMINED BY THE ENGINEER AT THE TIME OF CONSTRUCTION
- (12) REMOVE AND REPLACE EXISTING CURB & GUTTER
- (19) REMOVE EXISTING CONCRETE HEADWALL AND CONSTRUCT 8 FOOT CIP CONNECTION, SEE DETAIL C SHEET SD2 FOR DETAILS
- (23) REMOVE EXISTING FENCE
- (27) REMOVE ABANDONED SEWER MAIN AND MANHOLES

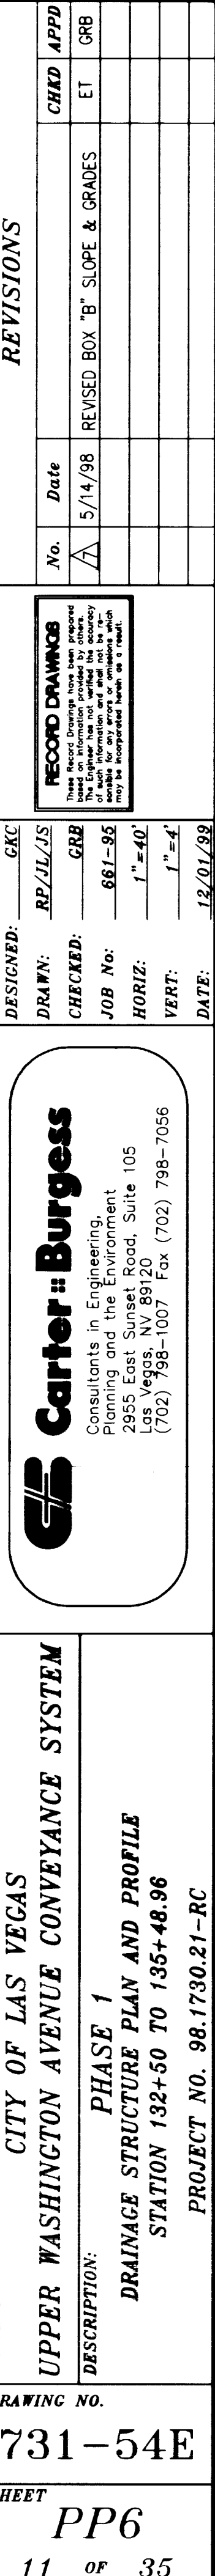


CONSTRUCTION NOTES

2. THE DRIVE IS TO BE CONSTRUCTED BY THE OWNER.

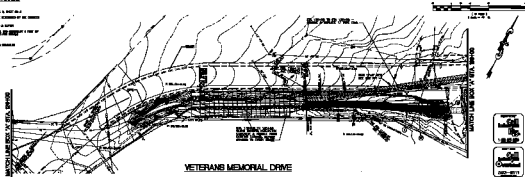

VETERANS MEMORIAL DRIVE

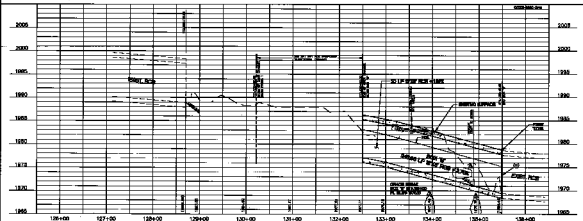

