
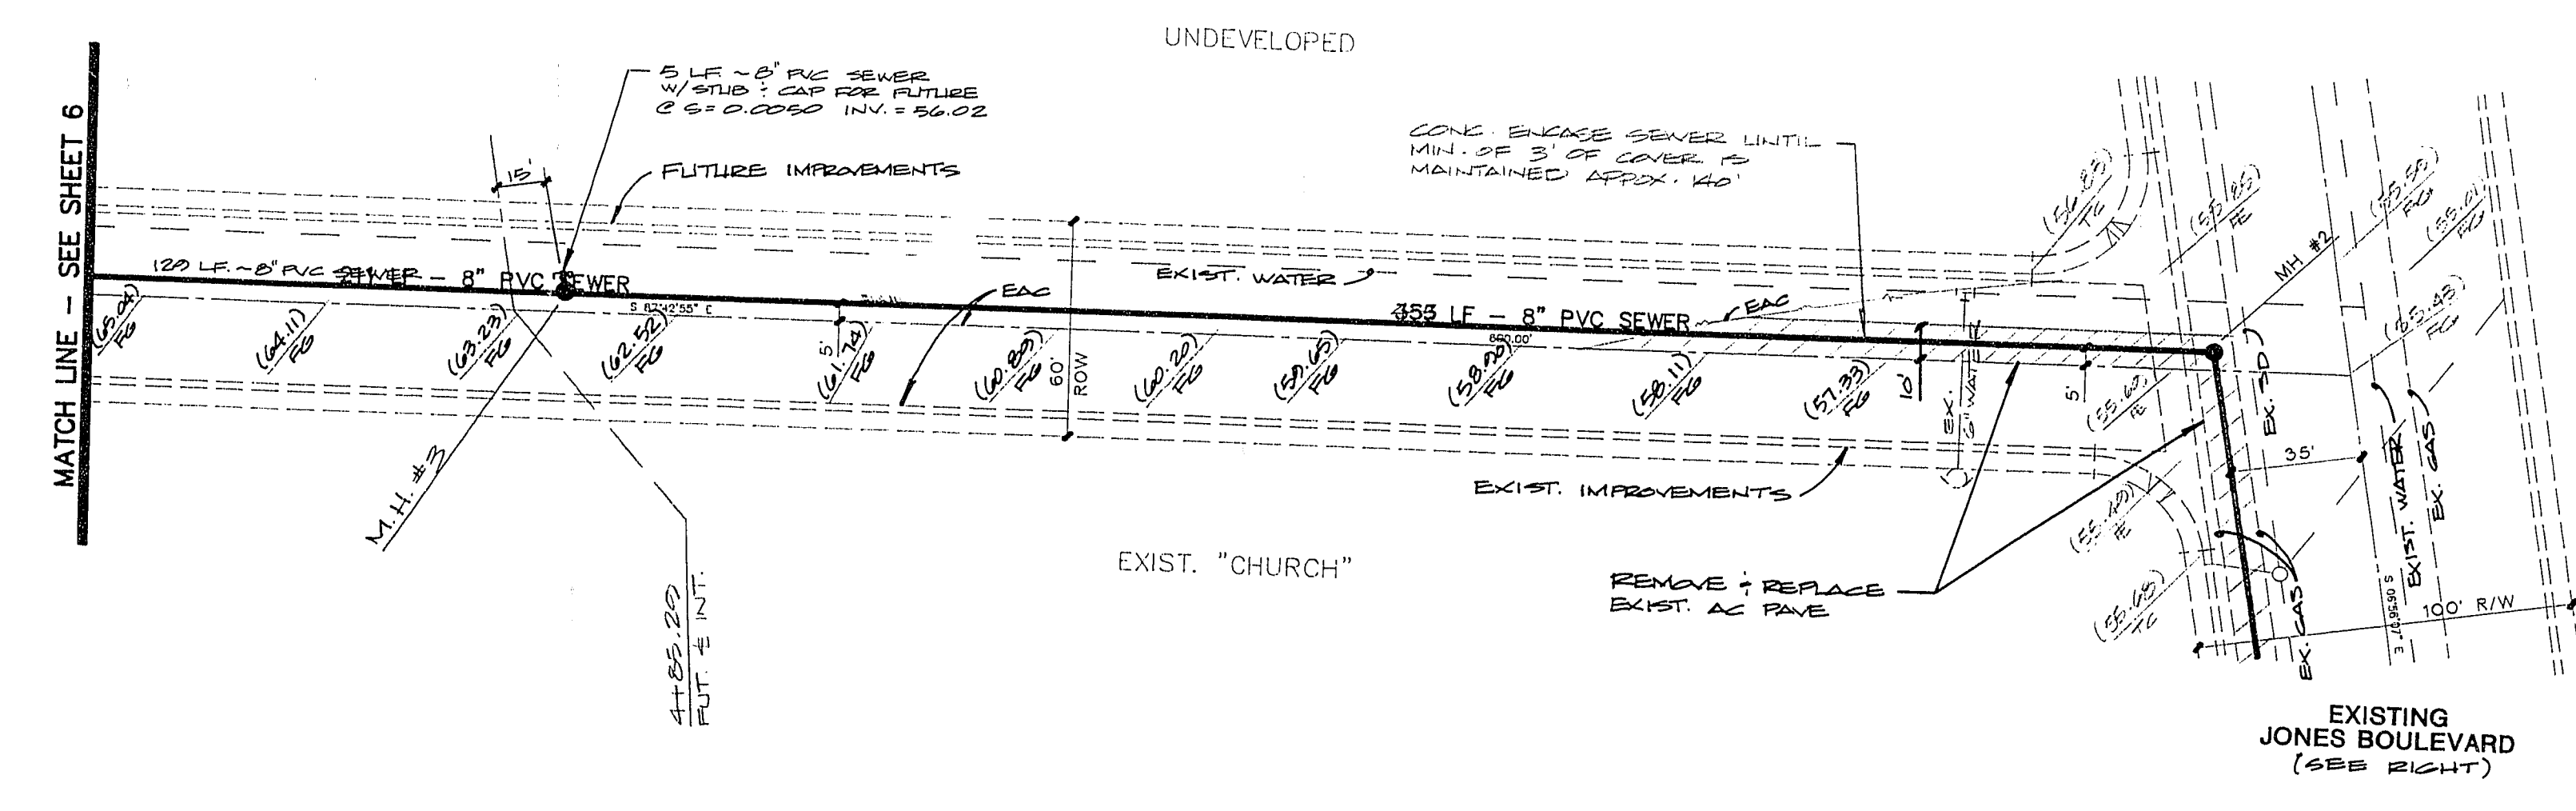


APPROVAL	REV	DATE	BY	REVISION
	1	4-27-92	TAK	ADDED SEWER ENGAGEMENT NOTE
	2	5-12-92	PE	DELEGATE M.H.#3
	3	5-12-92	PE	ADDED ENGAGEMENT FOR SEE, SEE



---	--

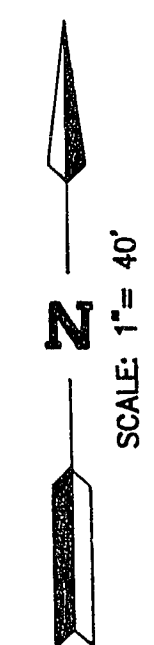

CARTIER AVENUE

BENCHMARK
 CLV DATUM
 # 7C00 ELEVATION = 2287.541
 14S4
 RIVET AND PLATE IN THE TOP OF CURB, NE RETURN OF TORREY PINES AND SMOKE RANCH ROAD.

Call before you Dig.
 1-800-227-2600
 UNDERGROUND SERVICE (USA)

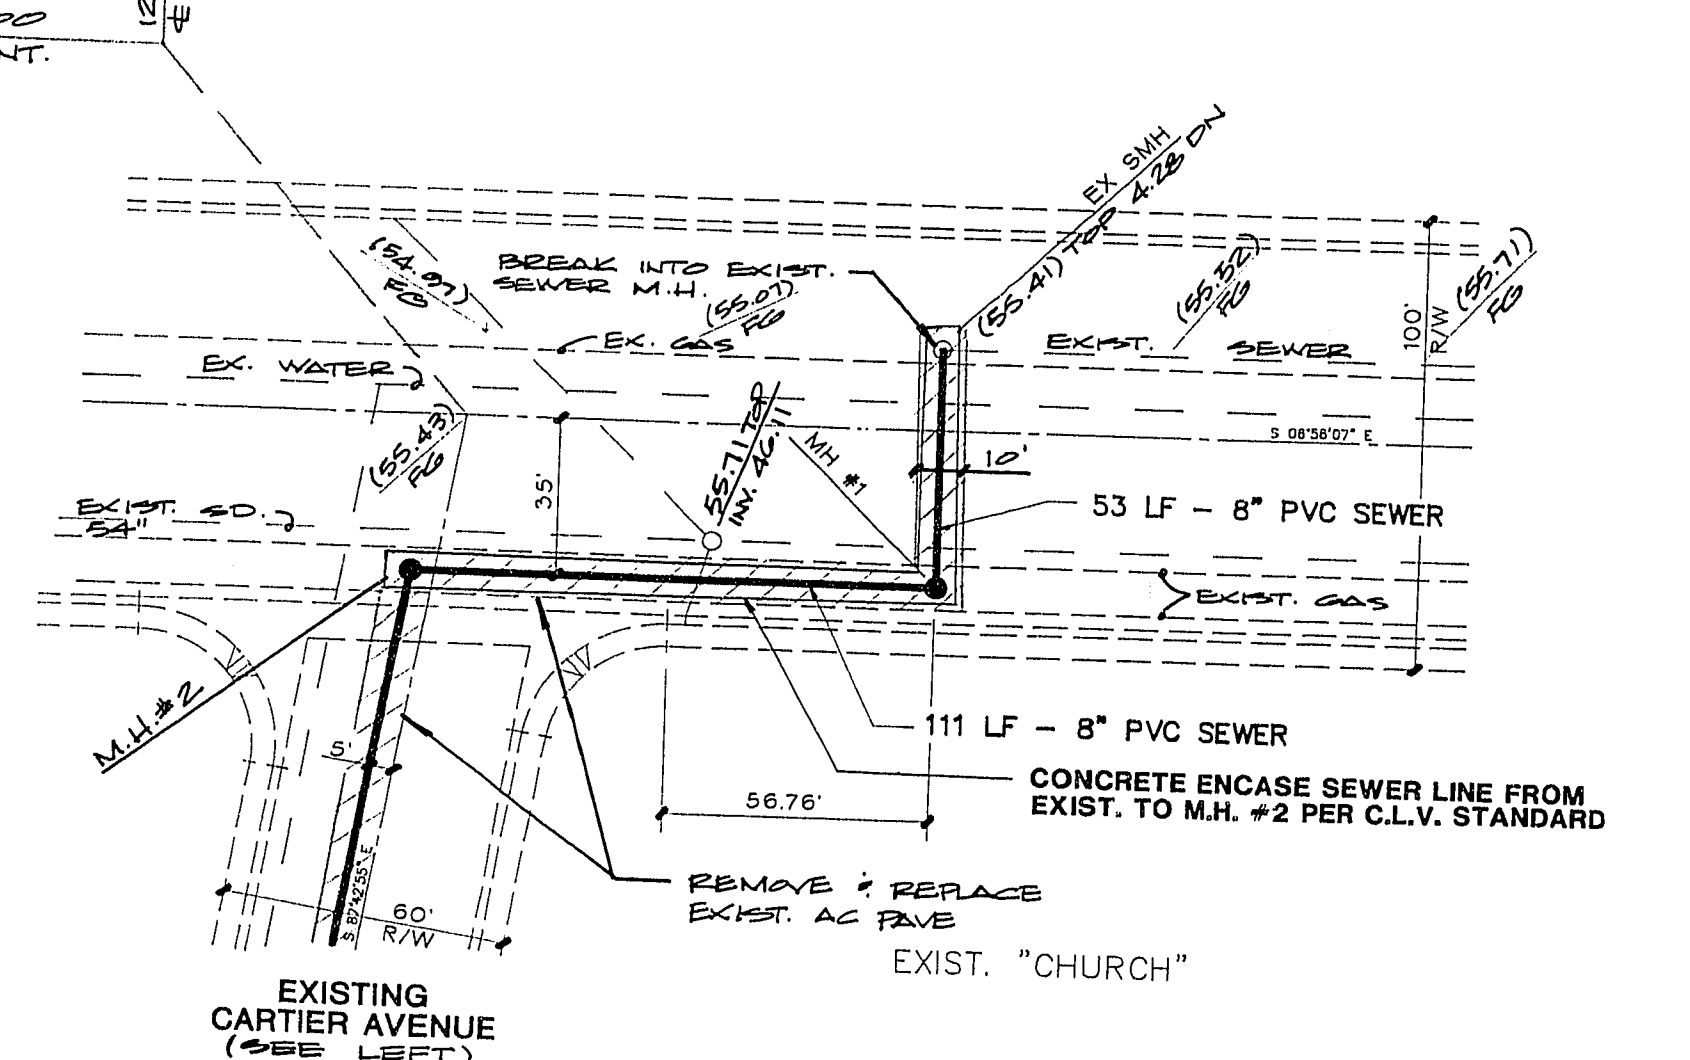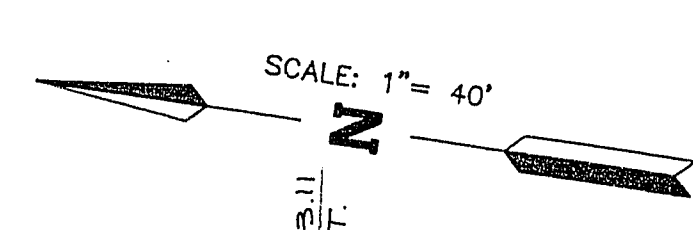

JONES BOULEVARD

OFFSITE SEWER PLAN & PROFILE
 (CARTIER AVENUE & JONES BOULEVARD)

UPTOWN ESTATES III

W.O. #: 000-5050
 BY: CHAO
 DATE: MAR. 1992
 SCALE: HORIZ. 1"=40'
 VERT. 1"=4'

SHEET
7
 OF 10 SHEETS

20-60-14
 307Y-4202-3