


MATCHLINE 816+00 SEE SHEET C-10

MATCHLINE 822+00 SEE SHEET C-12



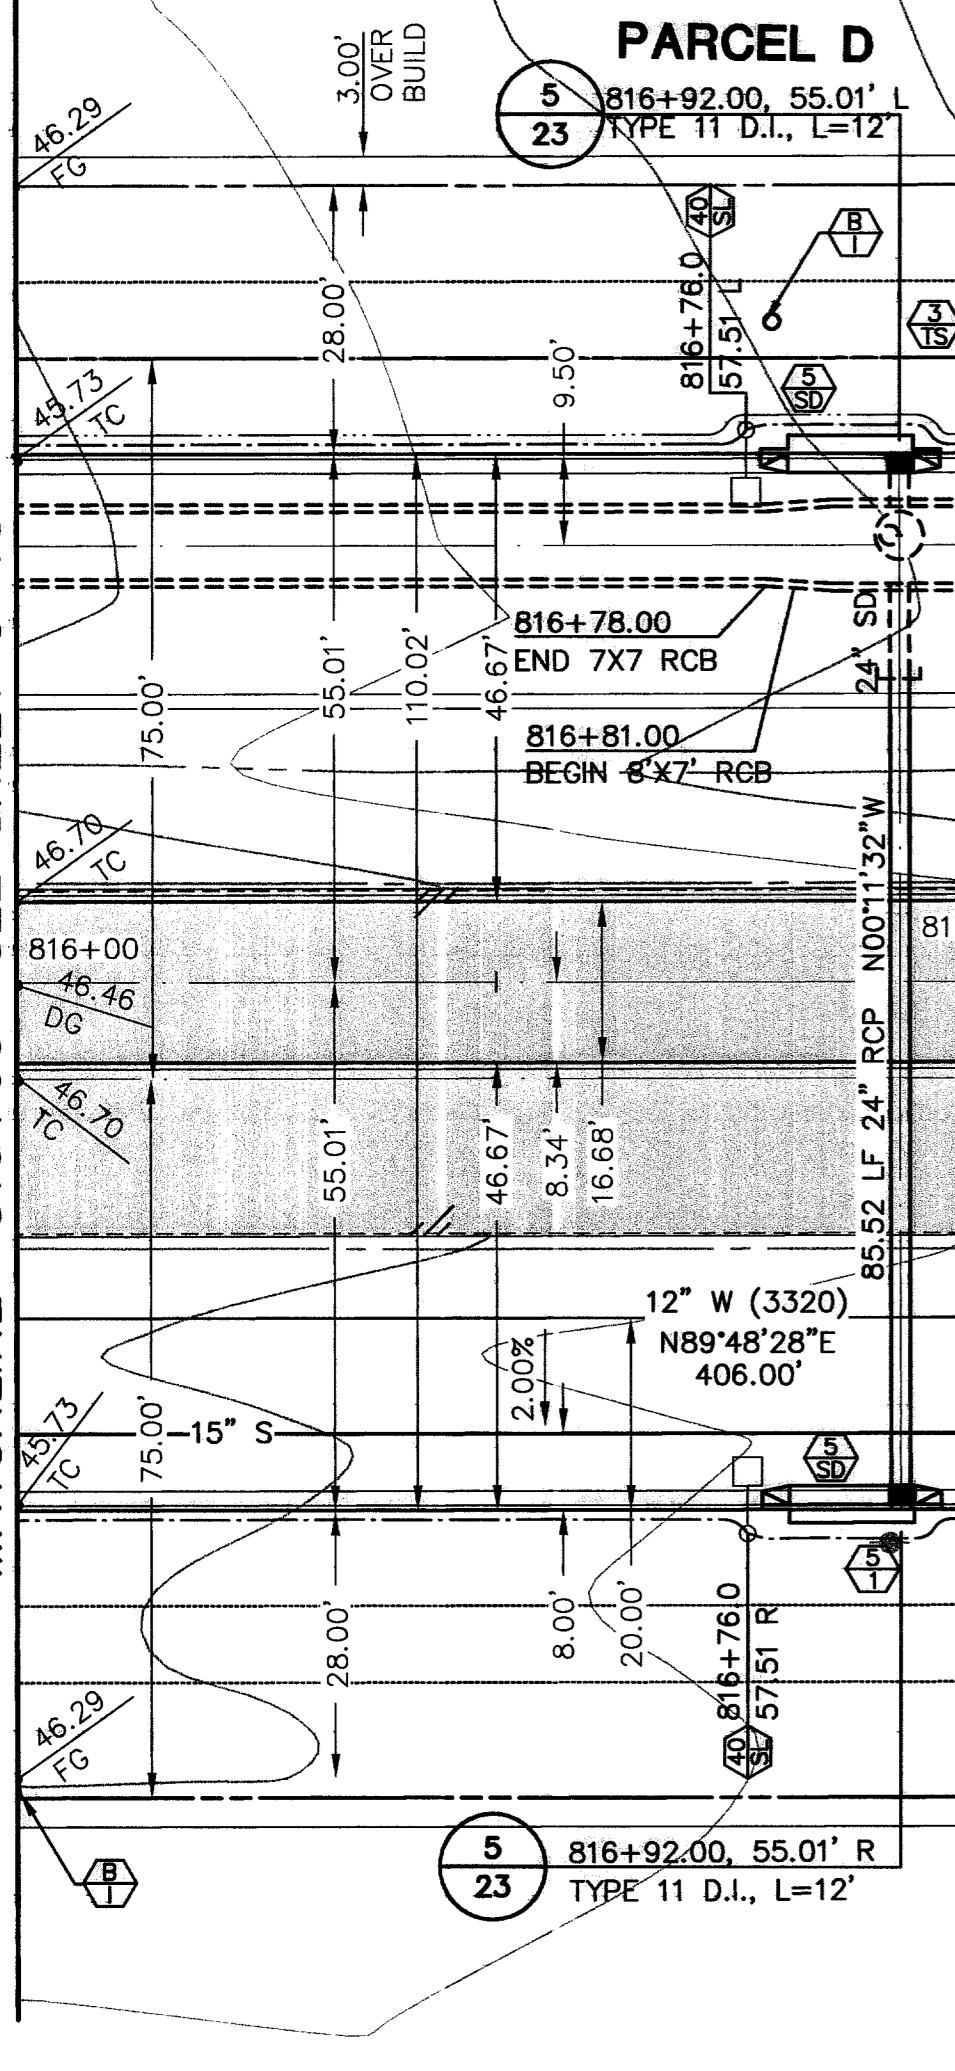


BENCHMARK
NDOT BRASS REFERENCE CAP, 50.00 FEET RIGHT OF STATION 787+19.42 OF CHARLESTON BLVD. (NO. OL709-34SSE6)
*3209.81 NAVD 1988 DATUM (978.351 M)
*3207.61 SUMMERLIN DATUM
* THIS PROJECT BASED ON NAVD 1988 DATUM

BASIS OF BEARING
NORTH 89°45'05" EAST BEING THE SOUTH LINE OF THE SOUTHWEST QUARTER (SW 1/4) OF SECTION 35, TOWNSHIP 20, RANGE 59 EAST, M.D.M., AS SHOWN BY MAP ON FILE IN FILE 91, PAGE 28 OF PARCEL MAPS IN THE CLARK COUNTY RECORDER'S OFFICE, CLARK COUNTY, NEVADA.

NOTES:
1. THIS SET OF DRAWINGS IS BASED ON NAVD 88 DATUM. PREVIOUS DRAWINGS MAY BE BASED ON SUMMERLIN DATUM. CARE SHOULD BE OBSERVED WHEN UTILIZING THIS SET OF DRAWINGS.
2. CONTRACTOR TO PROTECT IN PLACE ALL EXISTING UTILITIES AND VERIFY LOCATION PRIOR TO ANY CONSTRUCTION

CHARLESTON BLVD.
SCALE: HORIZ. 1" = 20'
VERT. 1" = 5'
SEE SHEET 4 FOR CONSTRUCTION NOTES

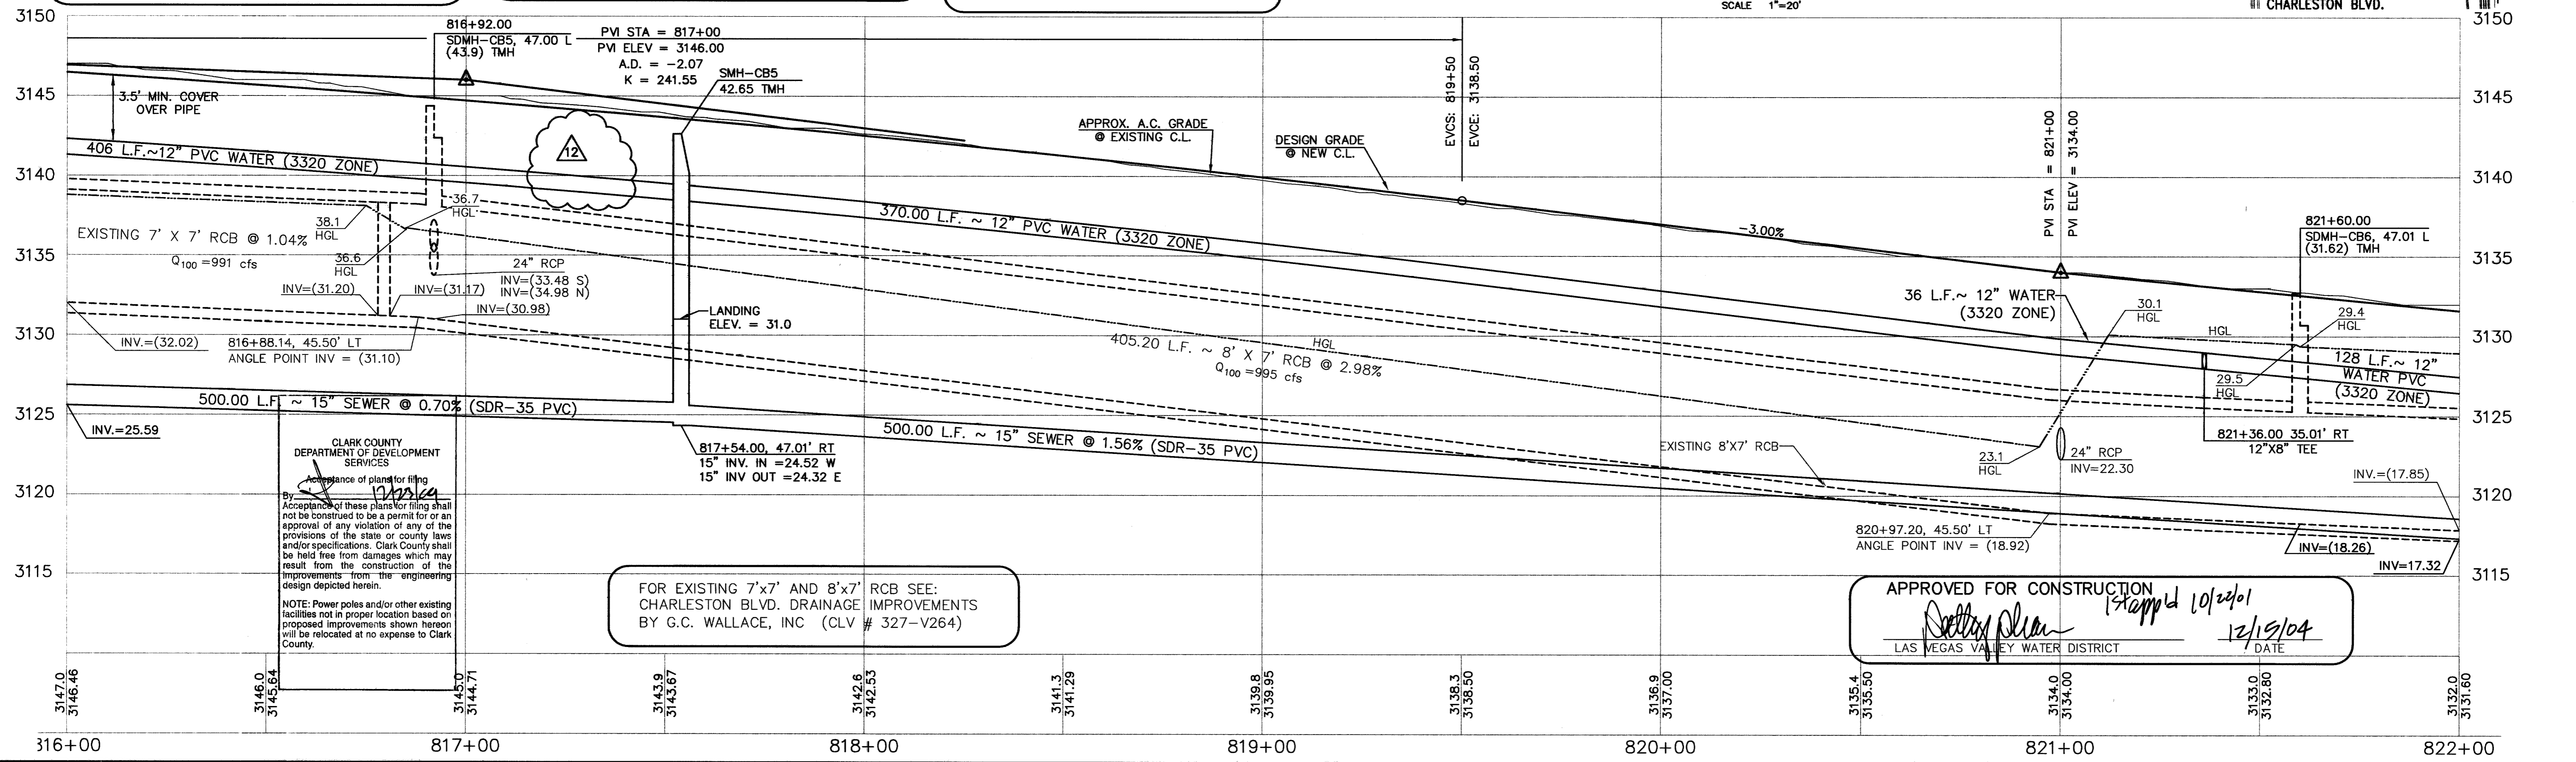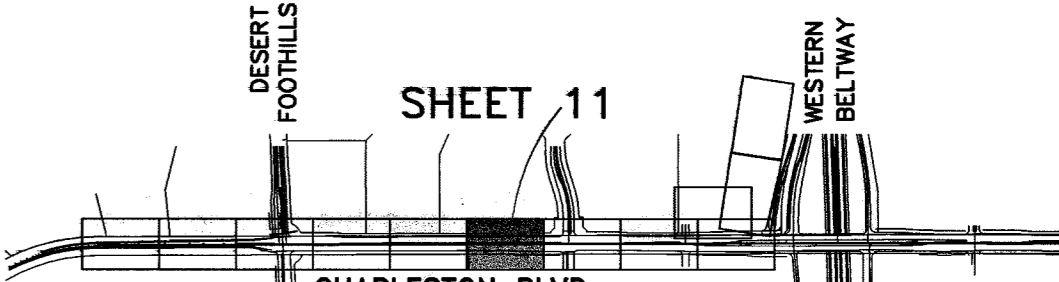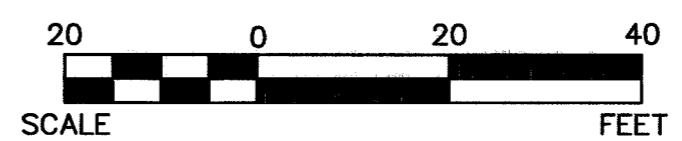

CLARK COUNTY DEPARTMENT OF DEVELOPMENT SERVICES
Acceptance of plans for filing
By: [Signature] 12/15/04
Acceptance of these plans for filing shall not be construed to be a permit for or an approval of any violation of any of the provisions of the state or county laws and/or specifications. Clark County shall be held free from damages which may result from the construction of the improvements from the engineering design depicted herein.
NOTE: Power poles and/or other existing facilities not in proper location based on proposed improvements shown herein will be relocated at no expense to Clark County.

FOR EXISTING 7'x7' AND 8'x7' RCB SEE: CHARLESTON BLVD. DRAINAGE IMPROVEMENTS BY G.C. WALLACE, INC (CLV # 327-V264)

APPROVED FOR CONSTRUCTION
[Signature] 12/15/04
LAS VEGAS VALLEY WATER DISTRICT
DATE

DESIGN: [Signature] CHECK: [Signature] ISSUE DATE: [Signature] PLOT DATE: 12-10-04 PLOT TIME: 14:32:15
DATE: 12/14/04
JOB NO. 62020.224
SHEET C-11 11 OF 30 SHTS
SUMMERLIN
V 19/20 CHARLESTON BOULEVARD IMPROVEMENTS
STATION 787+31 TO STATION 841+02
PLAN & PROFILE
STA. 816+00 TO 822+00