



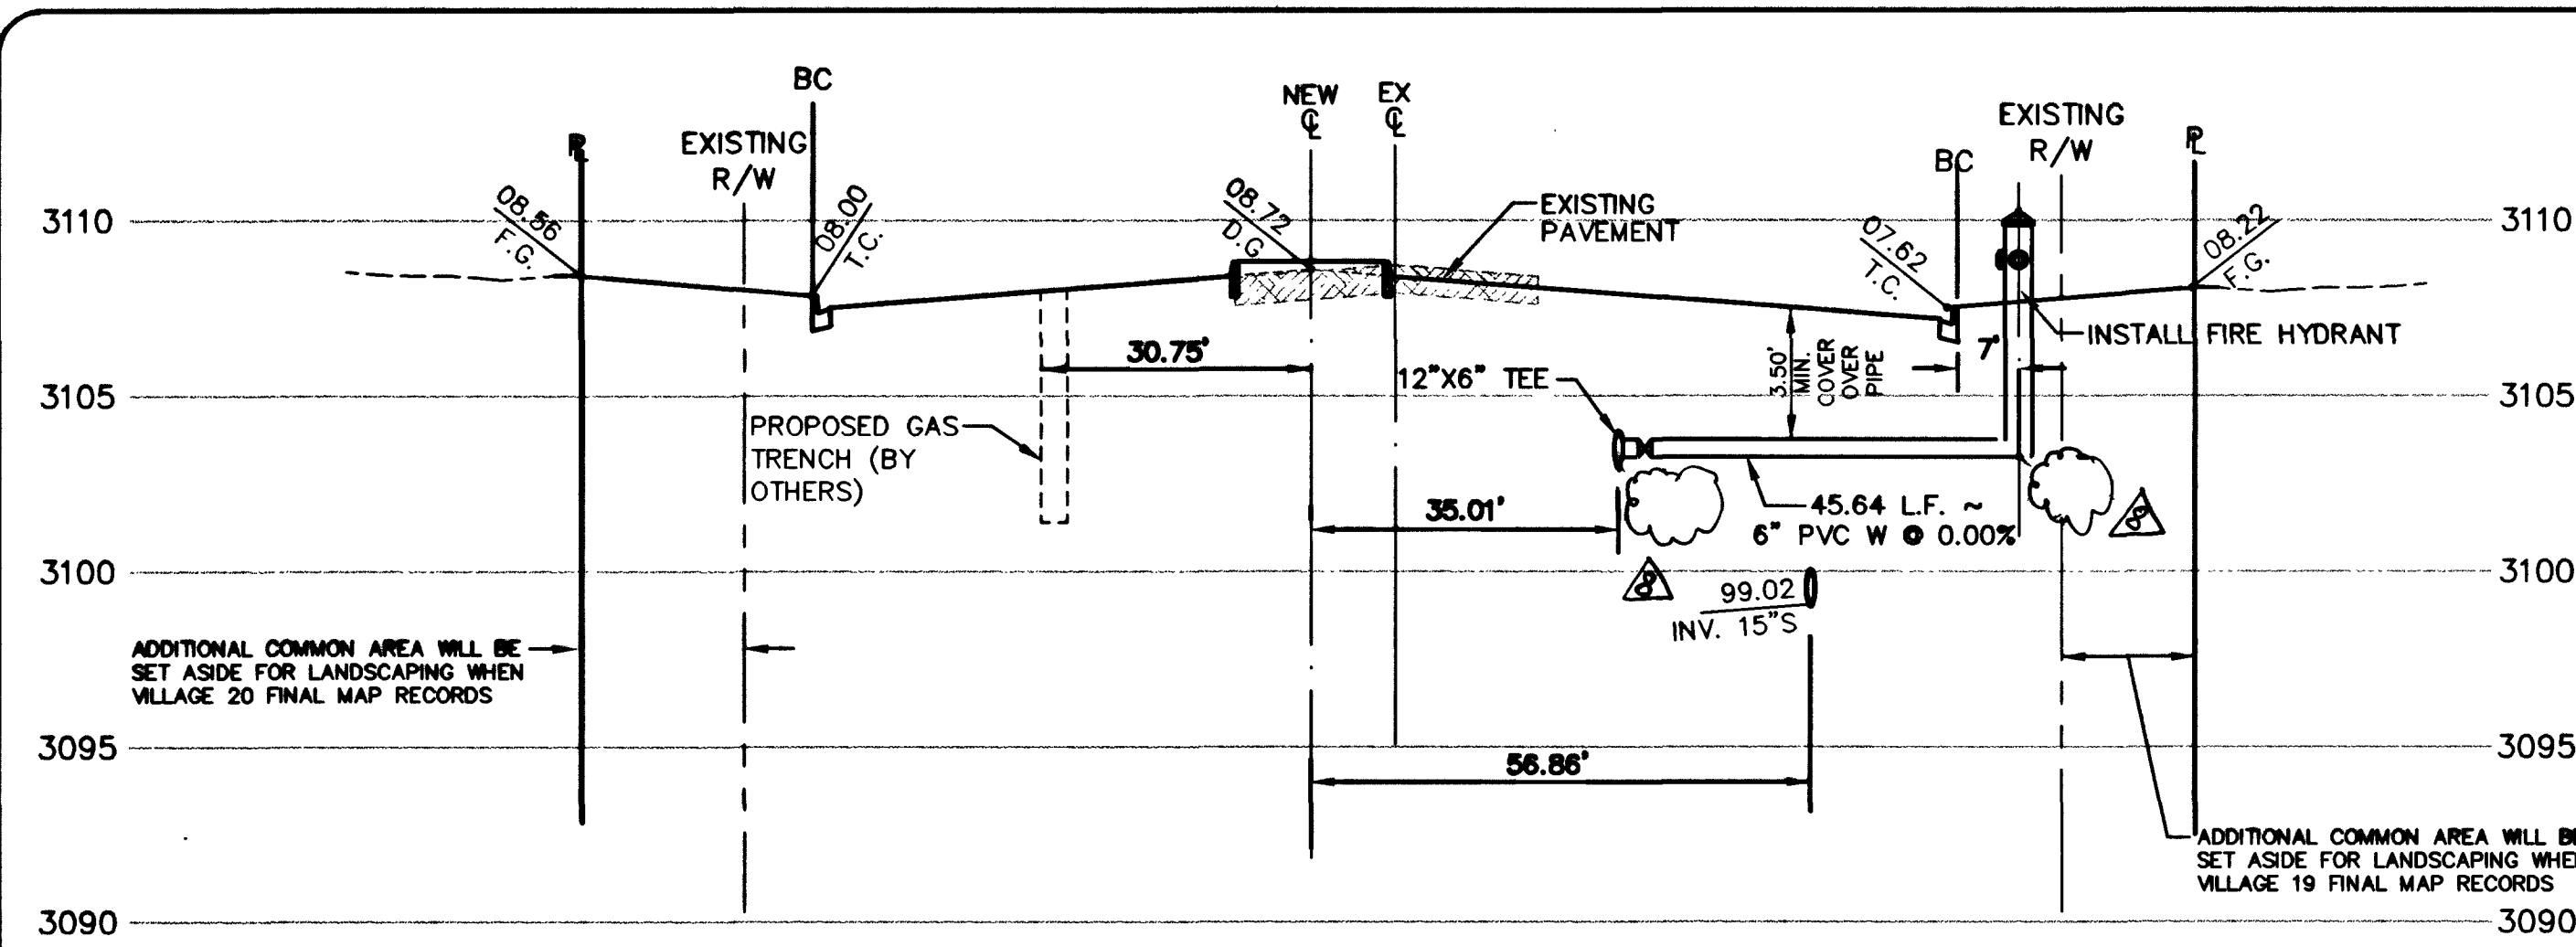


WATER LATERAL PROFILE • 832+64.00

SCALE: HORIZ. 1" = 20'
VERT. 1" = 5'

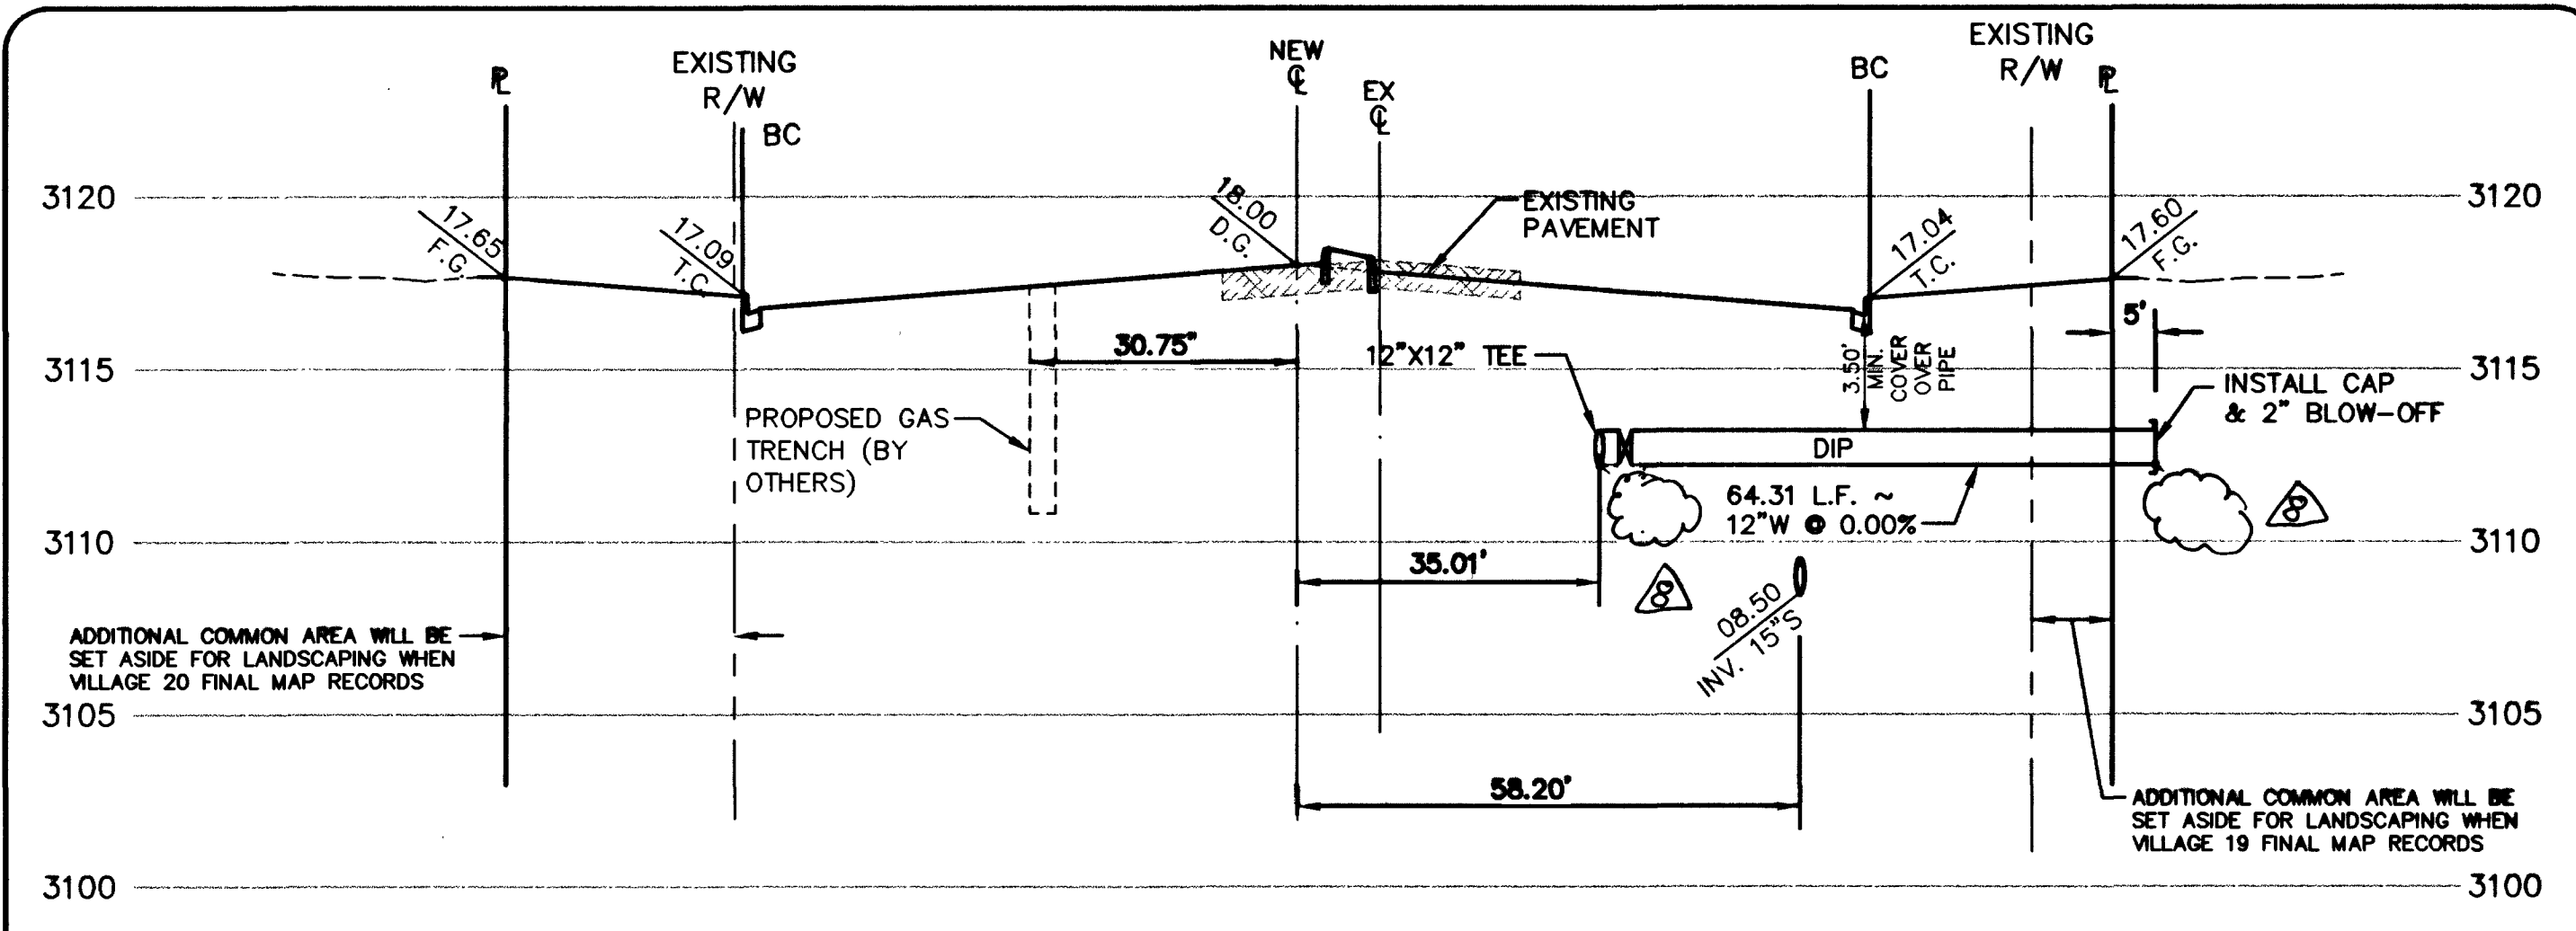


WATER LATERAL PROFILE • 828+00.00

SCALE: HORIZ. 1" = 20'
VERT. 1" = 5'

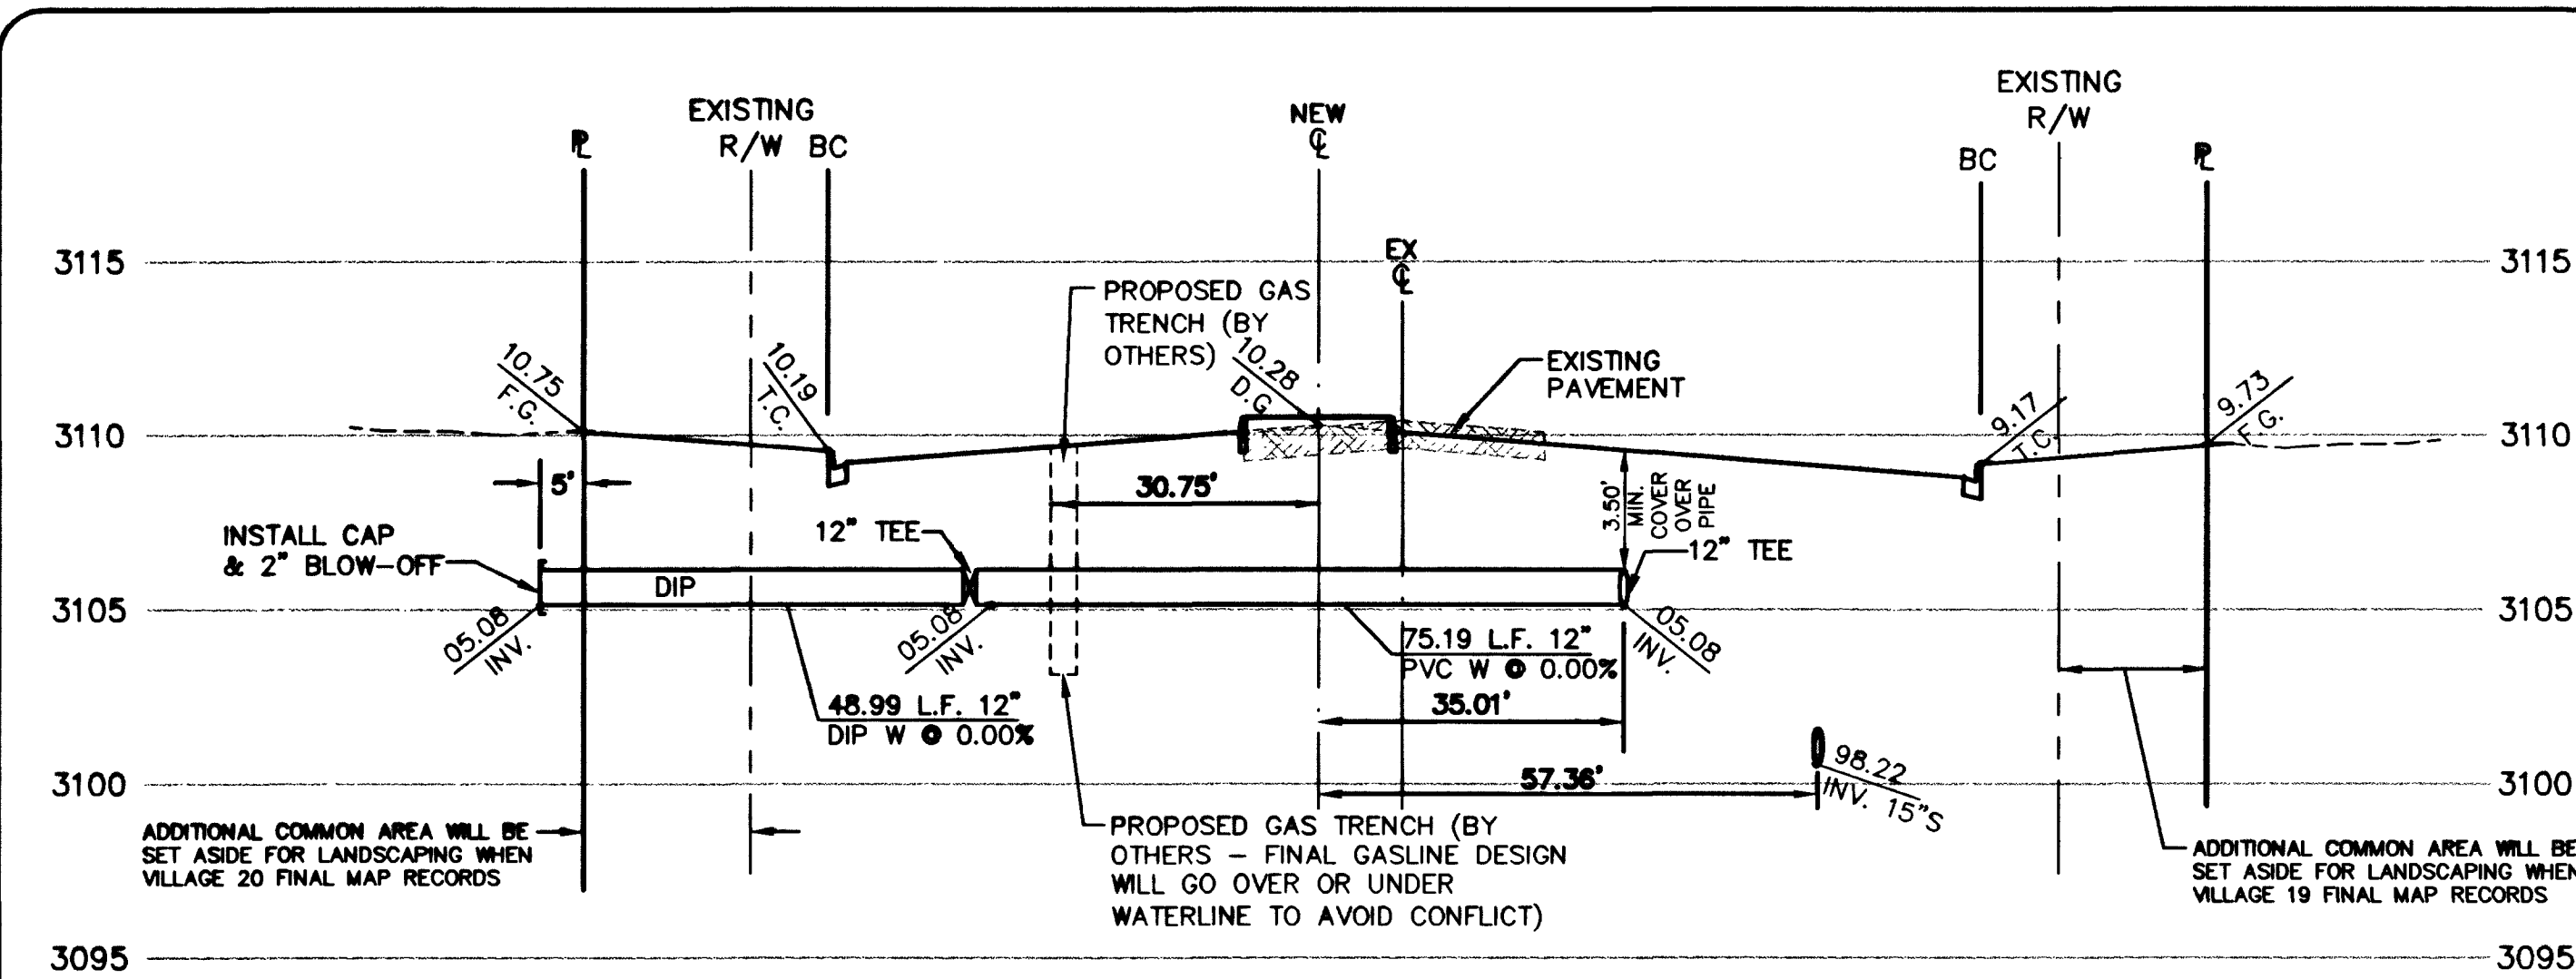


WATER LATERAL DETAIL • 83H+85.31

SCALE: HORIZ. 1" = 20'
VERT. 1" = 5'

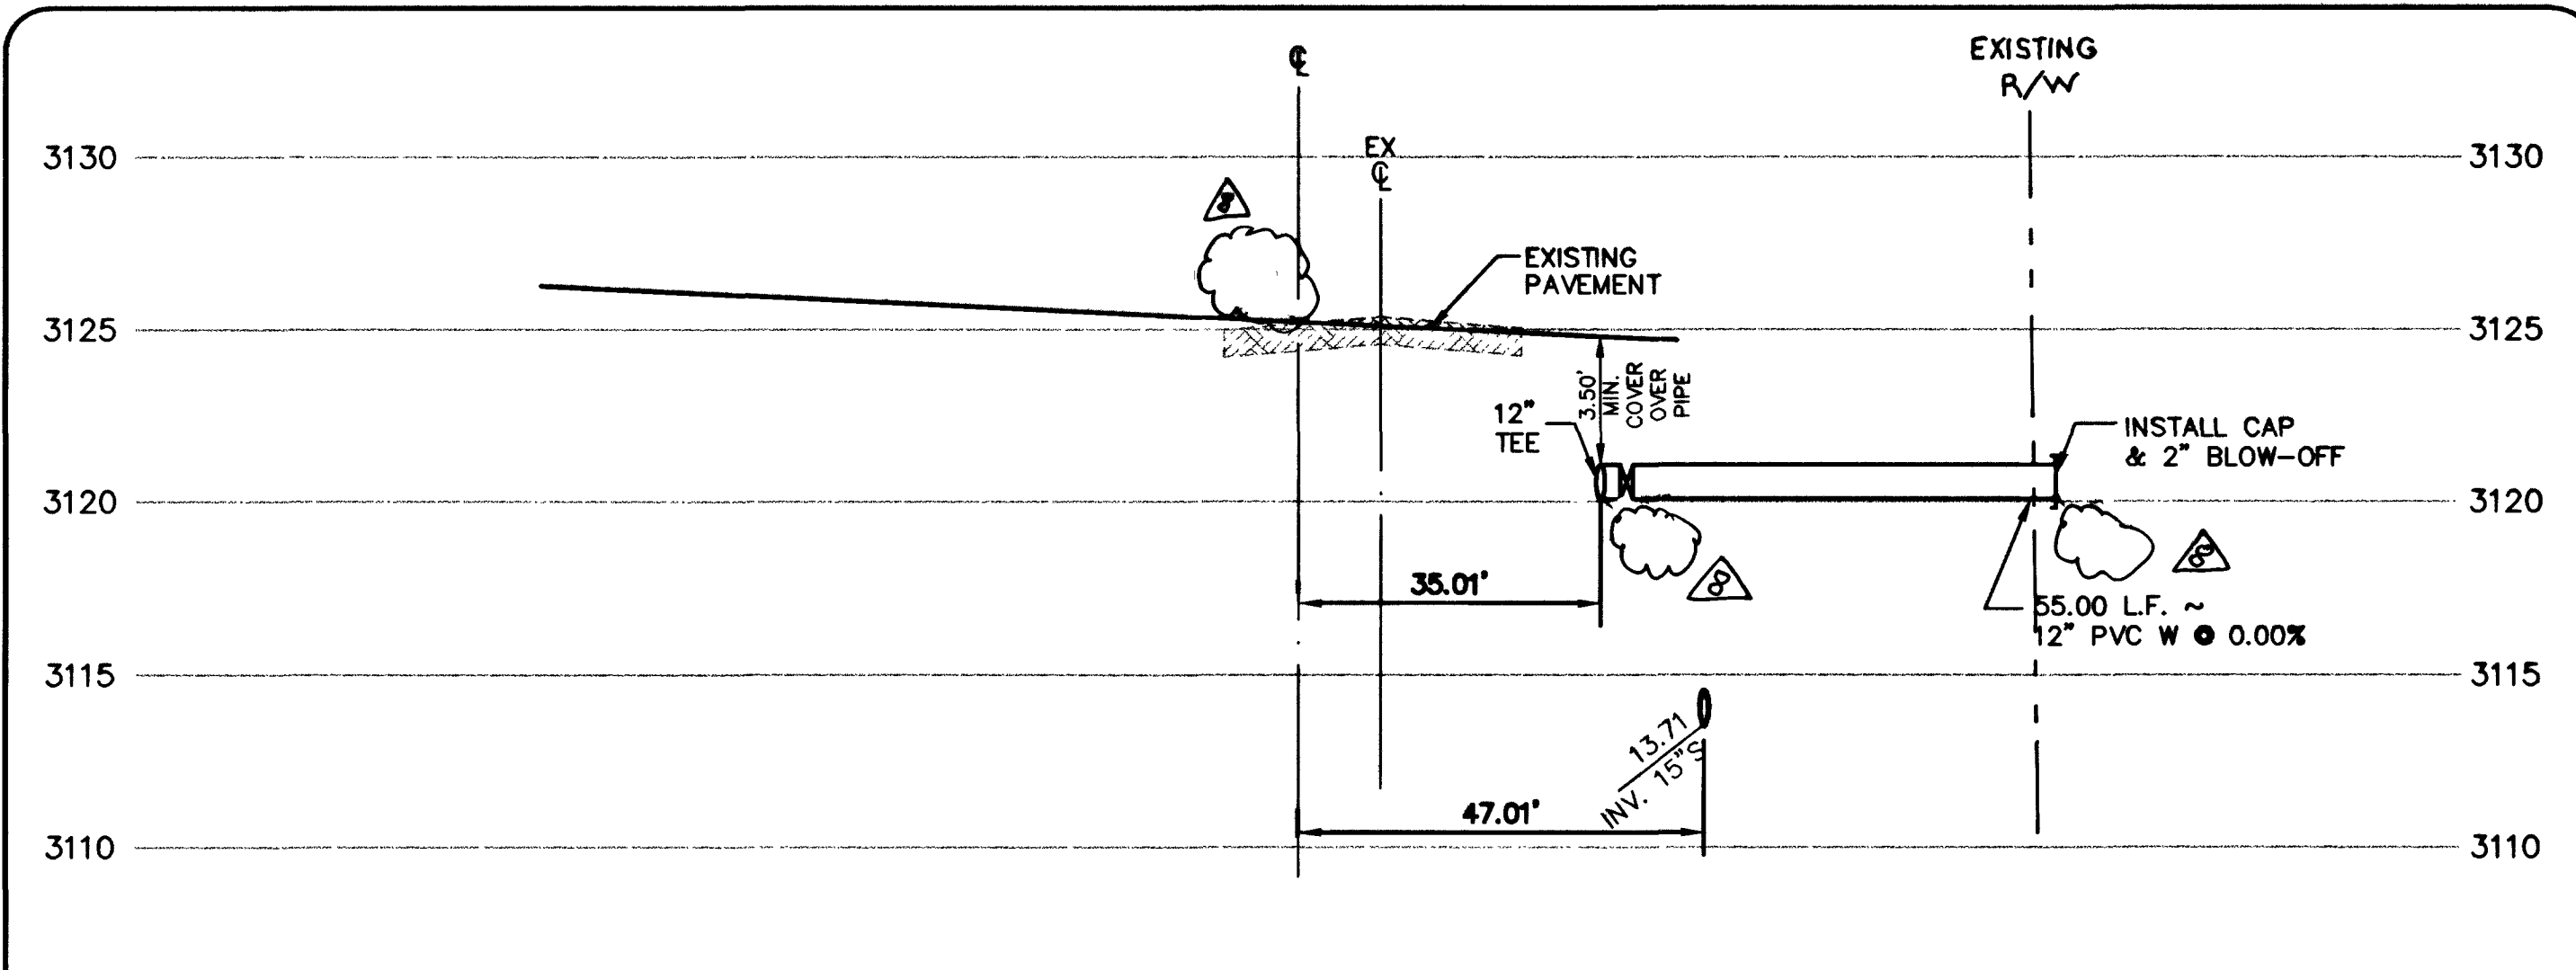


WATER LATERAL PROFILE • 824+50.3

SCALE: HORIZ. 1" = 20'
VERT. 1" = 5'

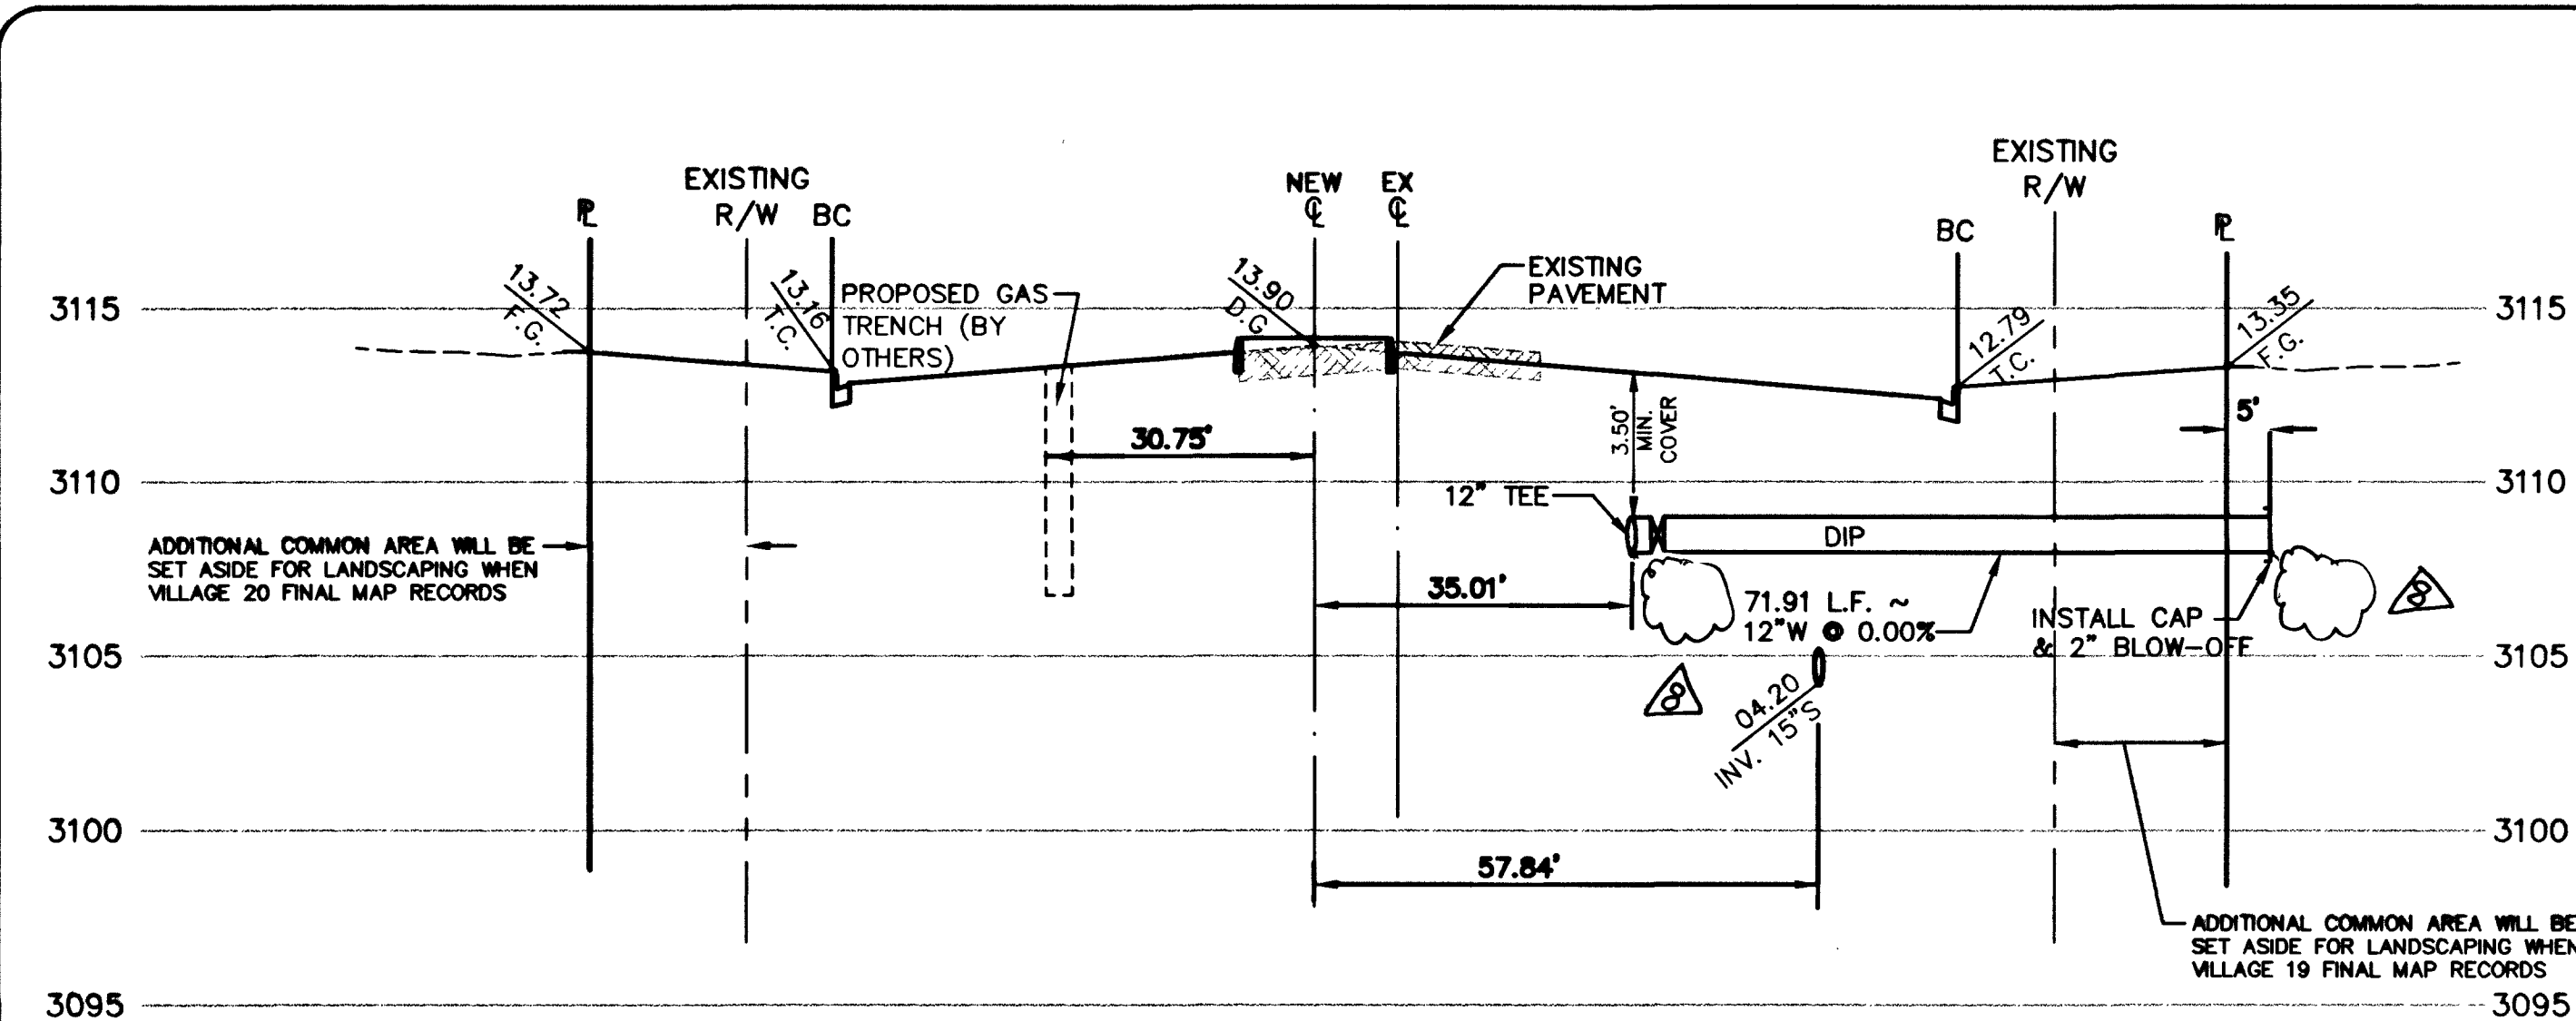

WATER LATERAL PROFILE • 830+05.00

SCALE: HORIZ. 1" = 20'
VERT. 1" = 5'

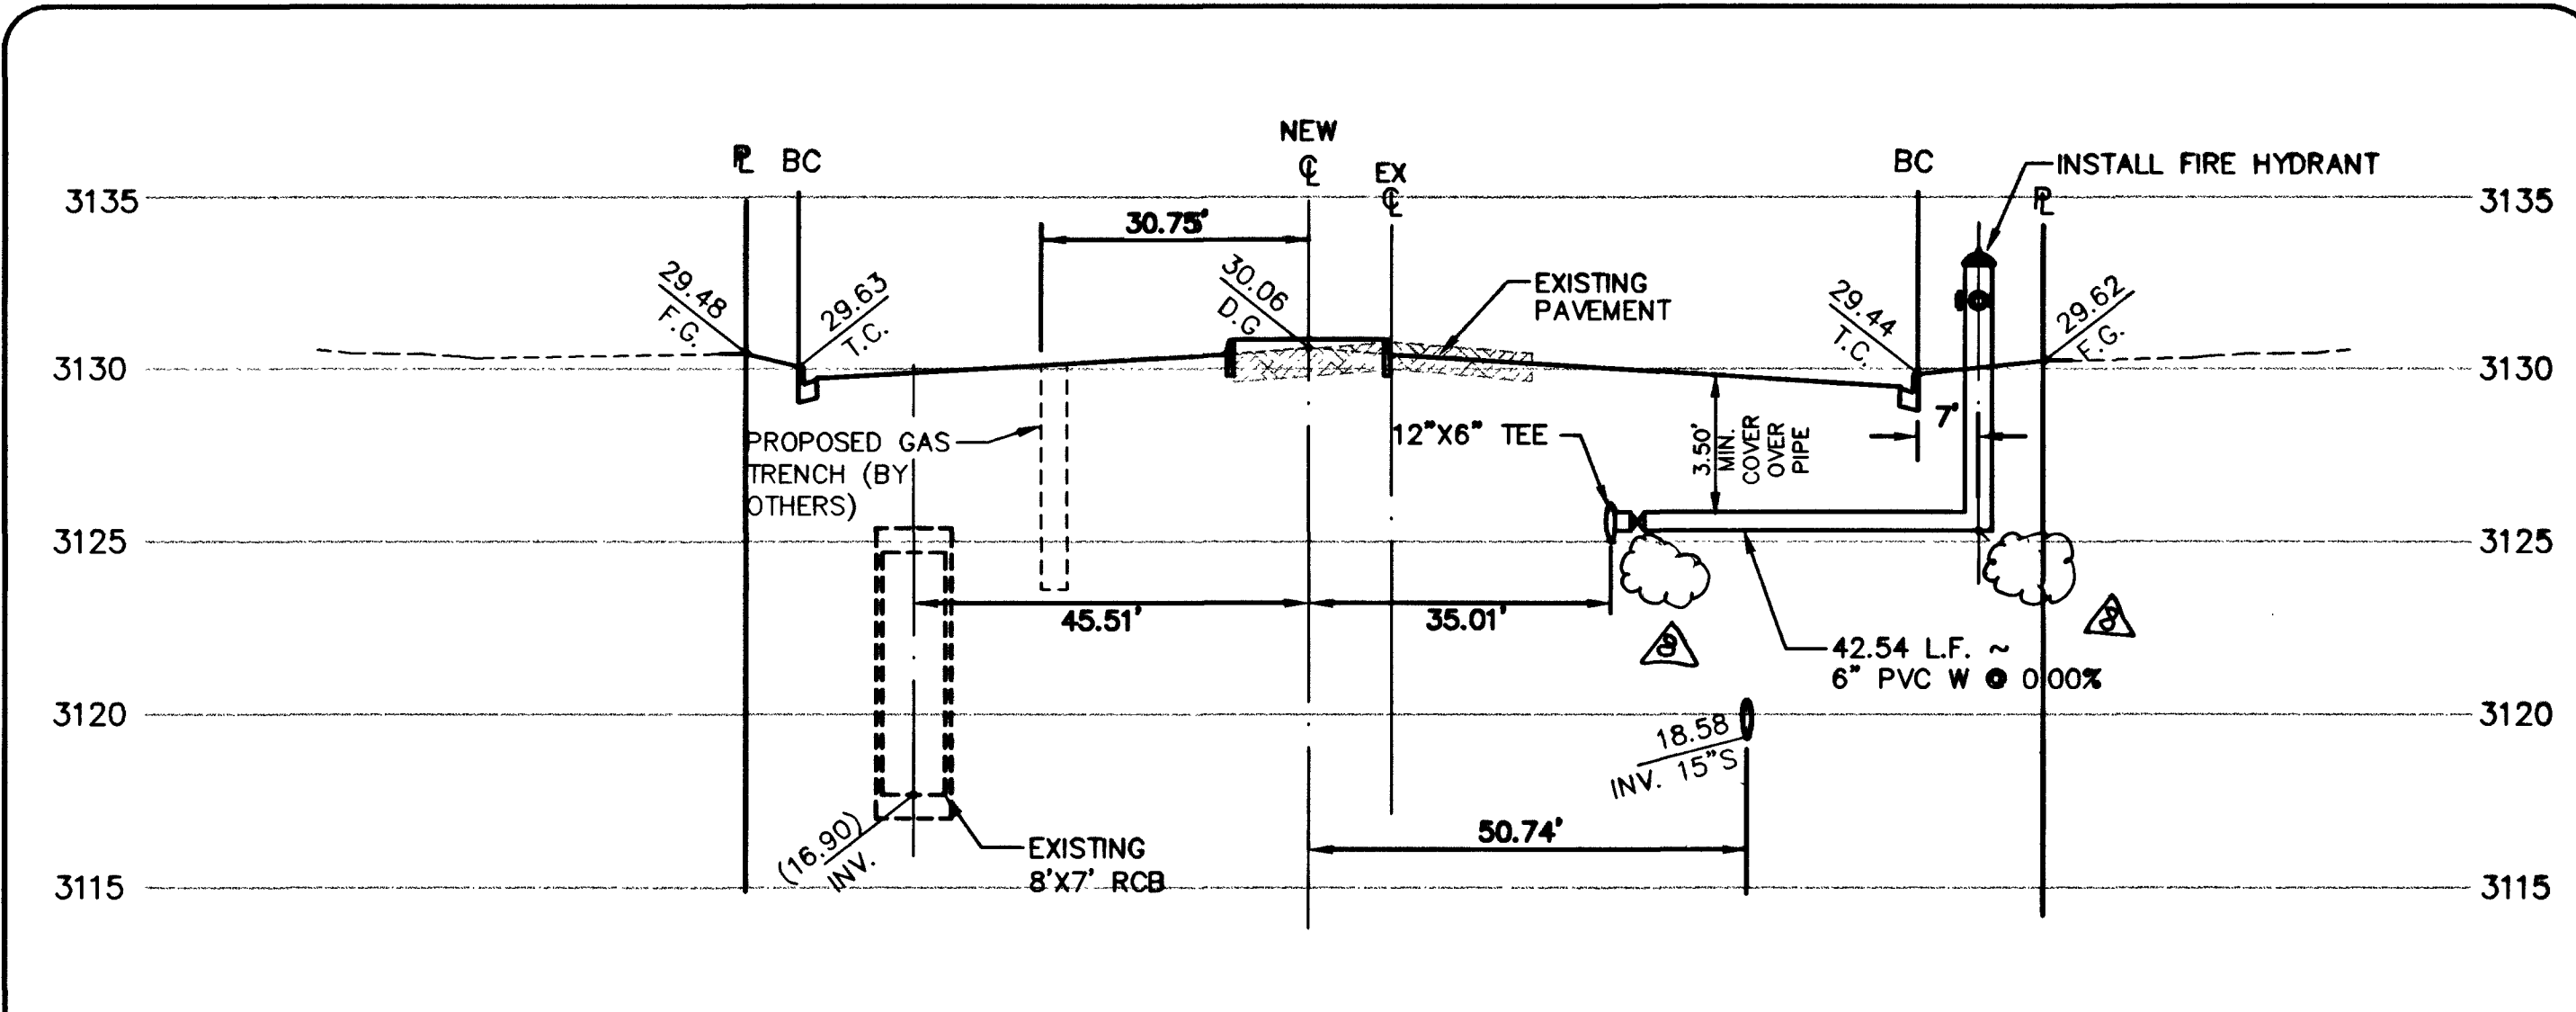

WATER LATERAL PROFILE • 822+64.00

SCALE: HORIZ. 1" = 20'
VERT. 1" = 5'

APPROVED FOR CONSTRUCTION:

LAS VEGAS VALLEY WATER DISTRICT