

BENCHMARK

NDOT BRASS REFERENCE CAP, 50.00 FEET RIGHT OF STATION
787+19.42 OF CHARLESTON BLVD. (NO. OLVO9-34SE6)
*3209.81 NAVD 1988 DATUM (978.351 M)
3207.61 SUMMERLIN DATUM
* THIS PROJECT BASED ON NAVD 1988 DATUM

BASIS OF BEARING

NORTH 89°45'05" EAST BEING THE SOUTH LINE OF THE
SOUTHWEST QUARTER (SW 1/4) OF SECTION 35, TOWNSHIP 20,
RANGE 59 EAST, M.D.M., AS SHOWN BY MAP ON FILE IN FILE 91,
PAGE 28 OF PARCEL MAPS IN THE CLARK COUNTY RECORDER'S
OFFICE, CLARK COUNTY, NEVADA.

MATCHLINE 798+00 SEE SHEET C-7

MATCHLINE 804+00 SEE SHEET C-9

CHARLESTON BLVD.


SCALE: HORIZ. 1" = 20'
VERT. 1" = 5'

SEE SHEET 4 FOR CONSTRUCTION NOTES


NOTES:

- THIS SET OF DRAWINGS IS BASED ON NAVD 88 DATUM.
PREVIOUS DRAWINGS MAY BE BASED ON SUMMERLIN DATUM.
CARE SHOULD BE OBSERVED WHEN UTILIZING THIS SET OF
DRAWINGS.
- CONTRACTOR TO PROTECT IN PLACE ALL EXISTING UTILITIES
AND VERIFY LOCATION PRIOR TO ANY CONSTRUCTION

FOR EX 7'x7' RCB SEE:
CHARLESTON BLVD. DRAINAGE IMPROVEMENTS
BY G.C. WALLACE, INC (CLV # 327-V264)

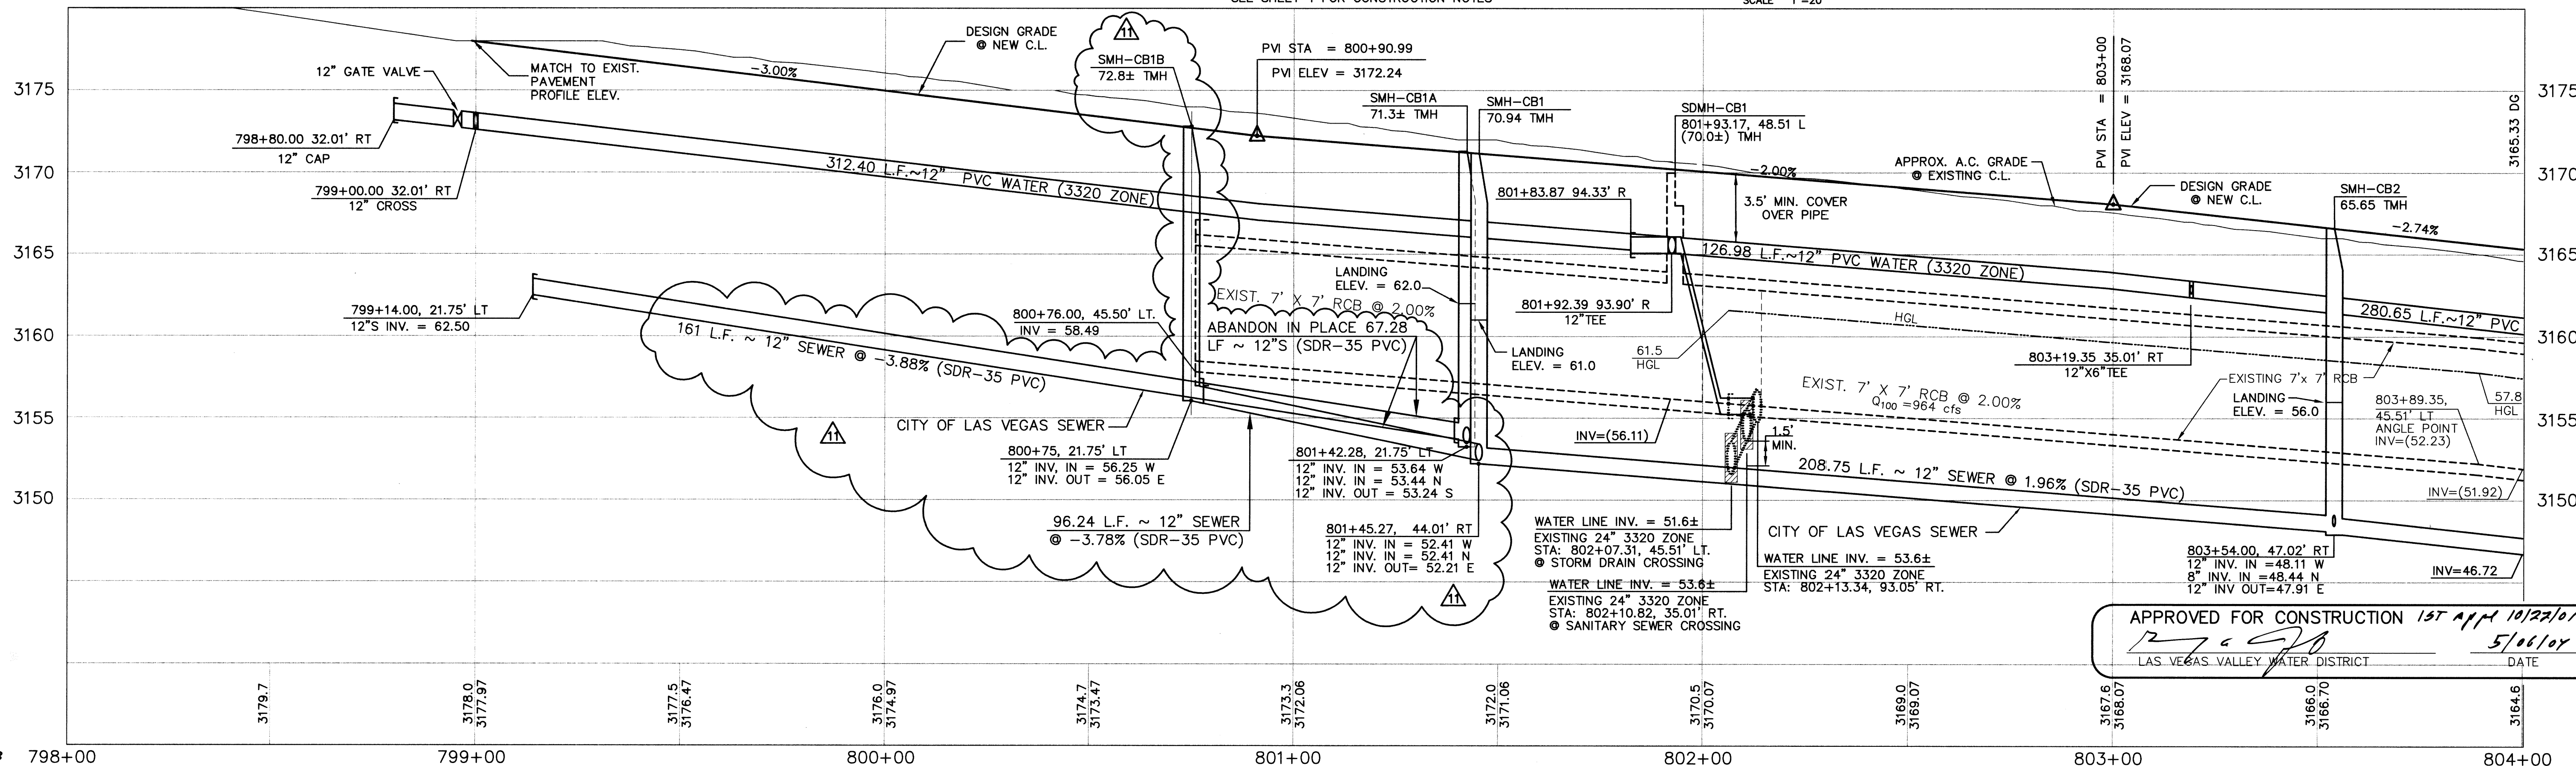

APPROVED FOR CONSTRUCTION 1ST APR 10/22/01
LAS VEGAS VALLEY WATER DISTRICT

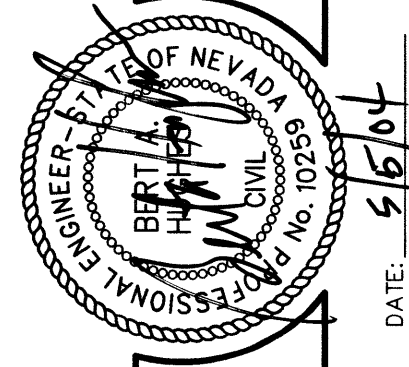

PLOT DATE:	05-04-04	
PLOT TIME:	13:53:30	
REV	DATE	DESCRIPTION
1	2/19/04	REMOVED FUTURE PARCEL ENTRY, RIGHT TURN LANE, RELOCATED CURB
REV	DATE	DESCRIPTION
1	05-04-04	12/12/04 ADD CURB RETURNS FOR SOUTH LEG OF INTERSECTION, RELOCATE

G.C. WALLACE, INC.
Engineering/Architecture
1555 SOUTH RAINBOW BLVD., LAS VEGAS, NEVADA 89146
TELEPHONE: (702) 804-2000 • FAX: (702) 804-2299
F:\62020\914\DWG\NPS\VF-P008.dwg

SUMMERLIN
V 19/20 CHARLESTON BOULEVARD IMPROVEMENTS
STATION 787+31 TO STATION 841+02
PLAN & PROFILE
STA. 798+00 TO 804+00

SHEET
C-8
8 OF 30 SHEETS

JOB NO. 62020.224