

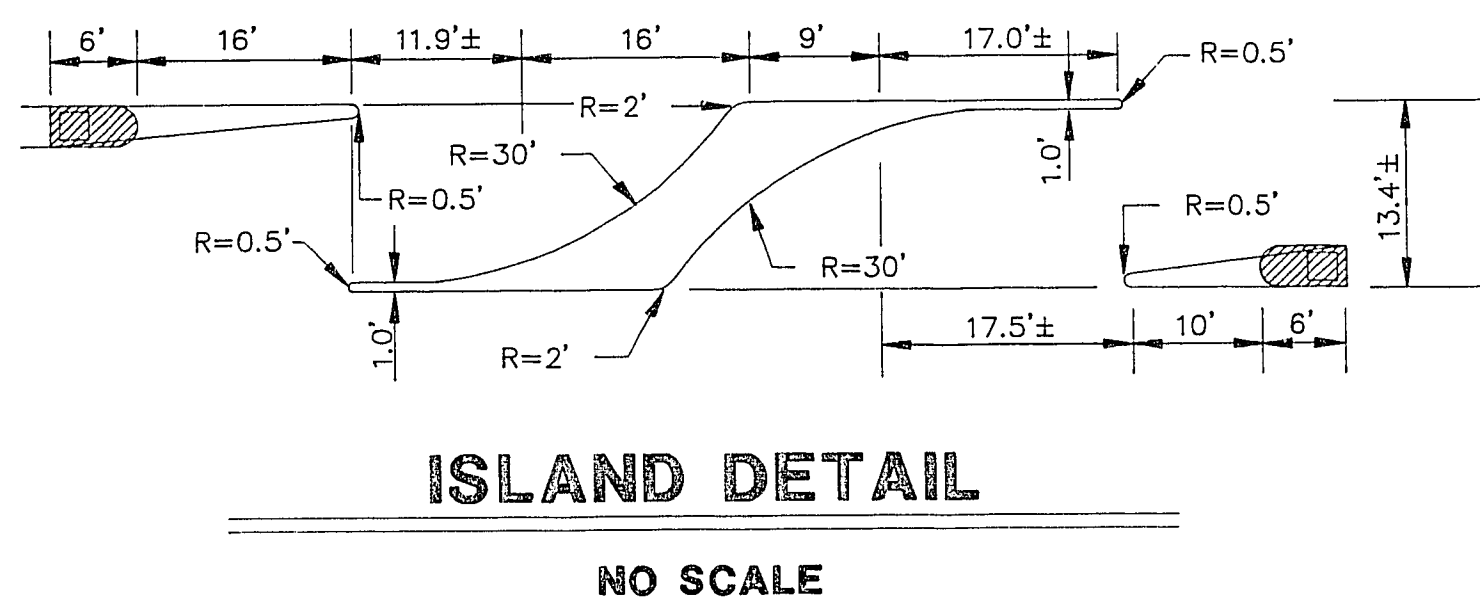
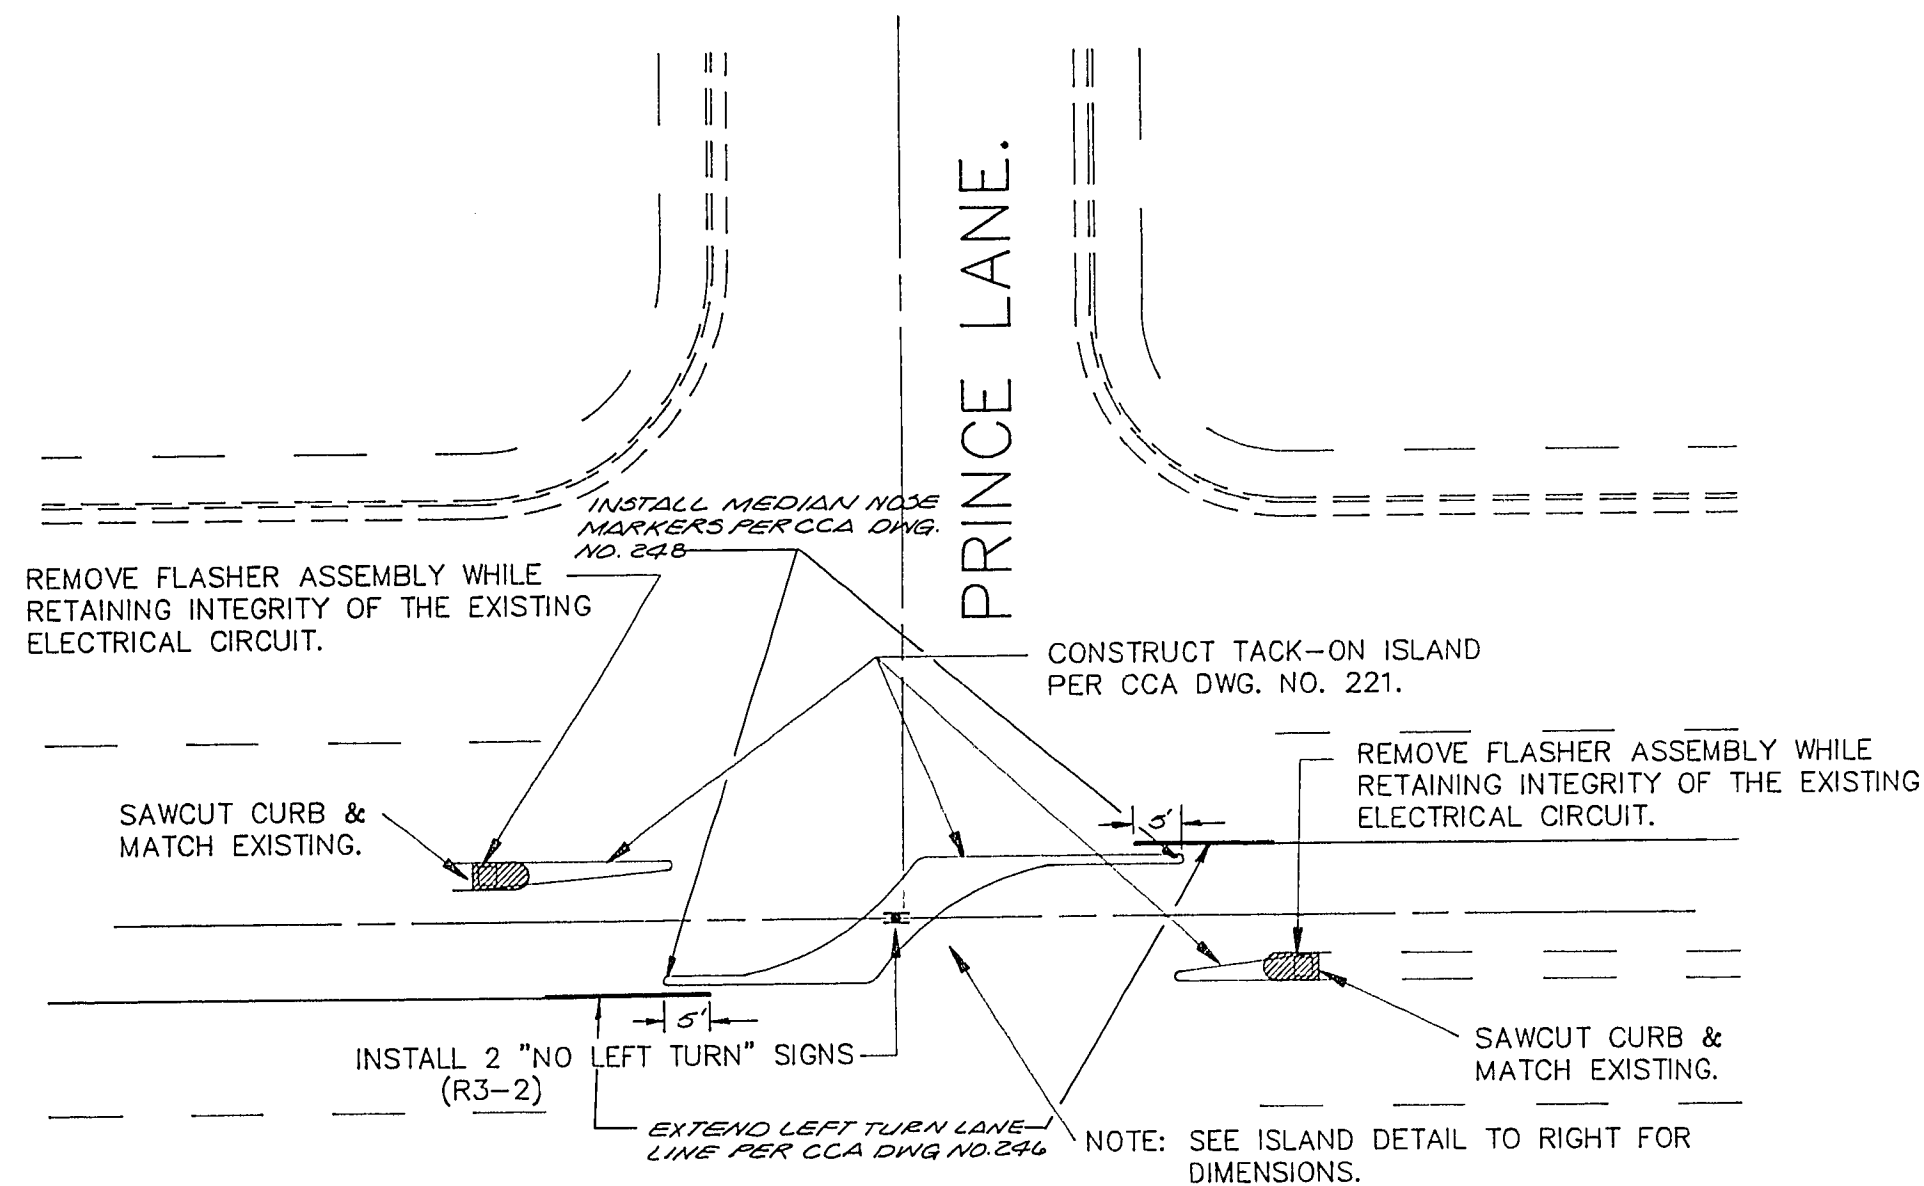


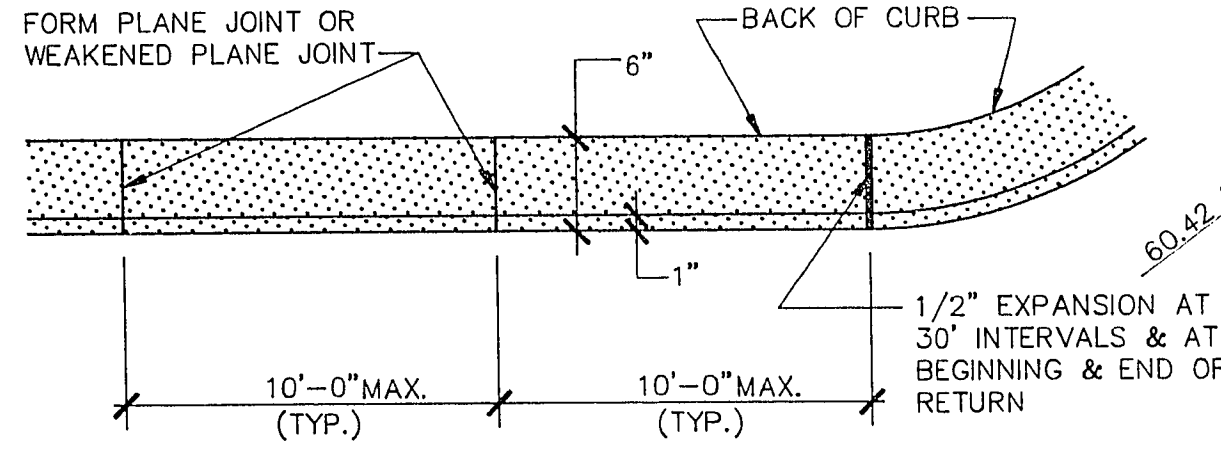


ISLAND DETAIL
NO SCALE


EAST CHARLESTON BLVD.

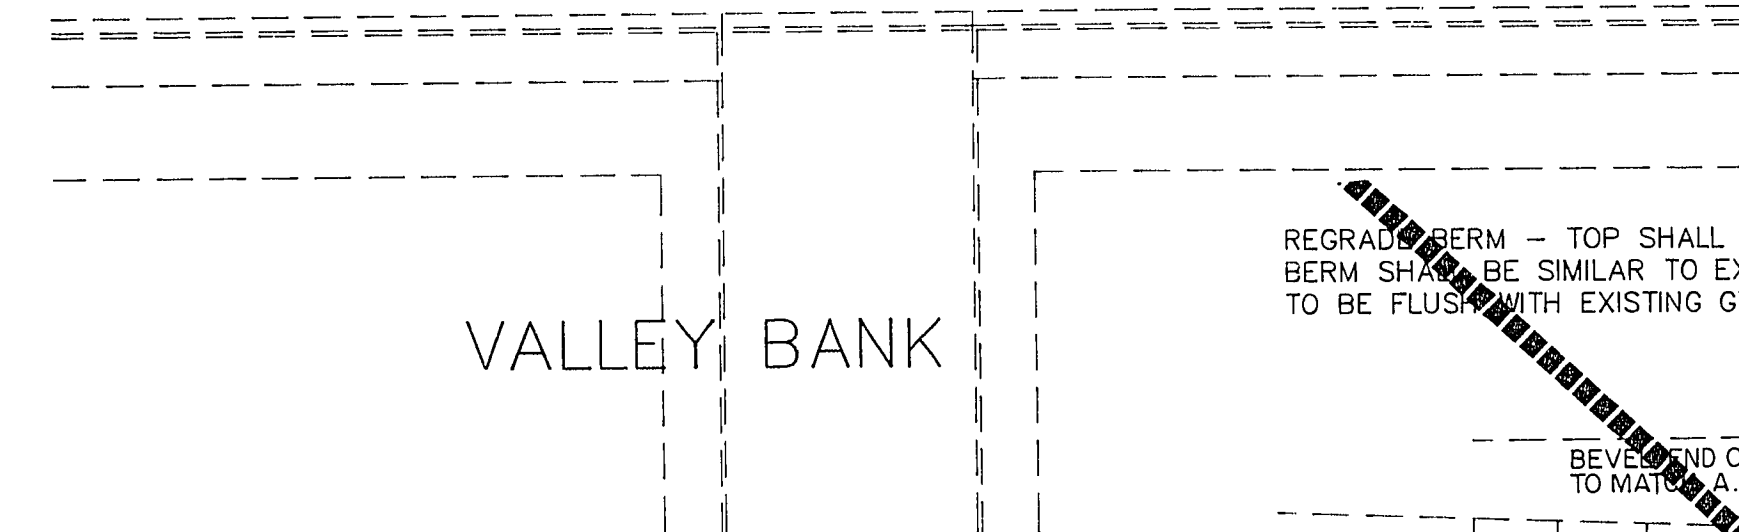

PLAN

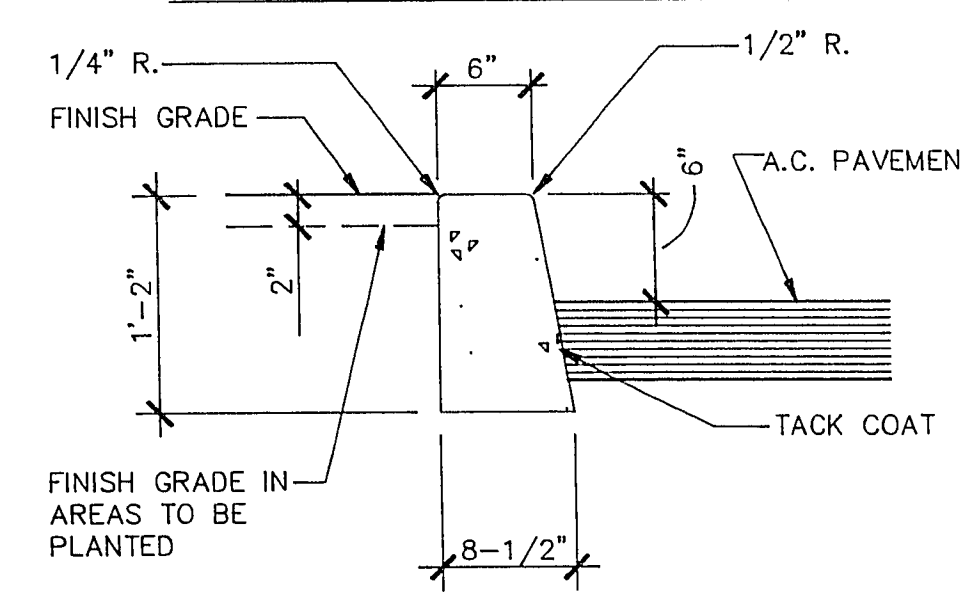


TYPICAL SECTION

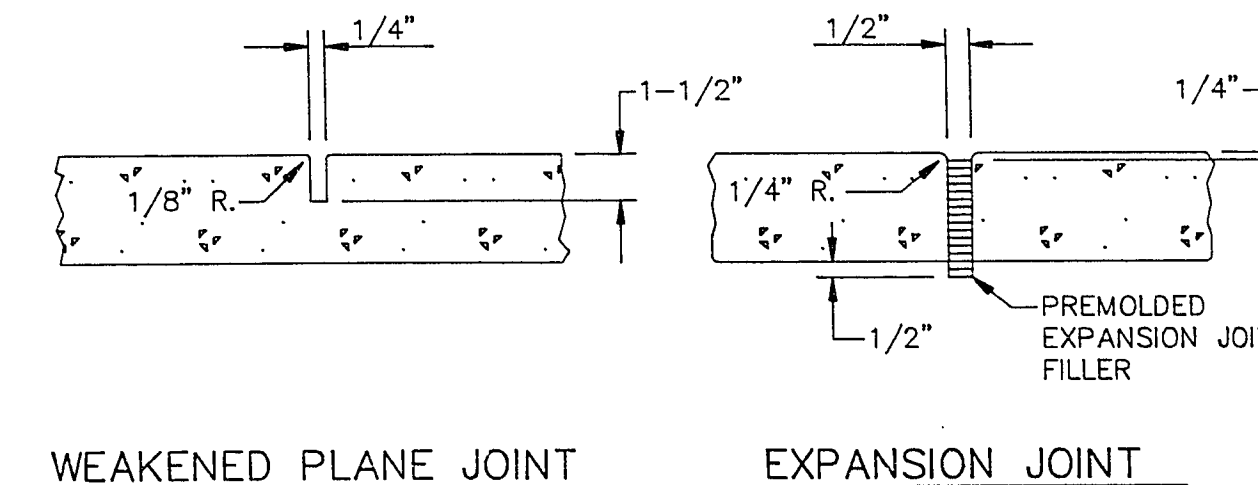

ON-SITE 'A' CURB


NO SCALE

(C)

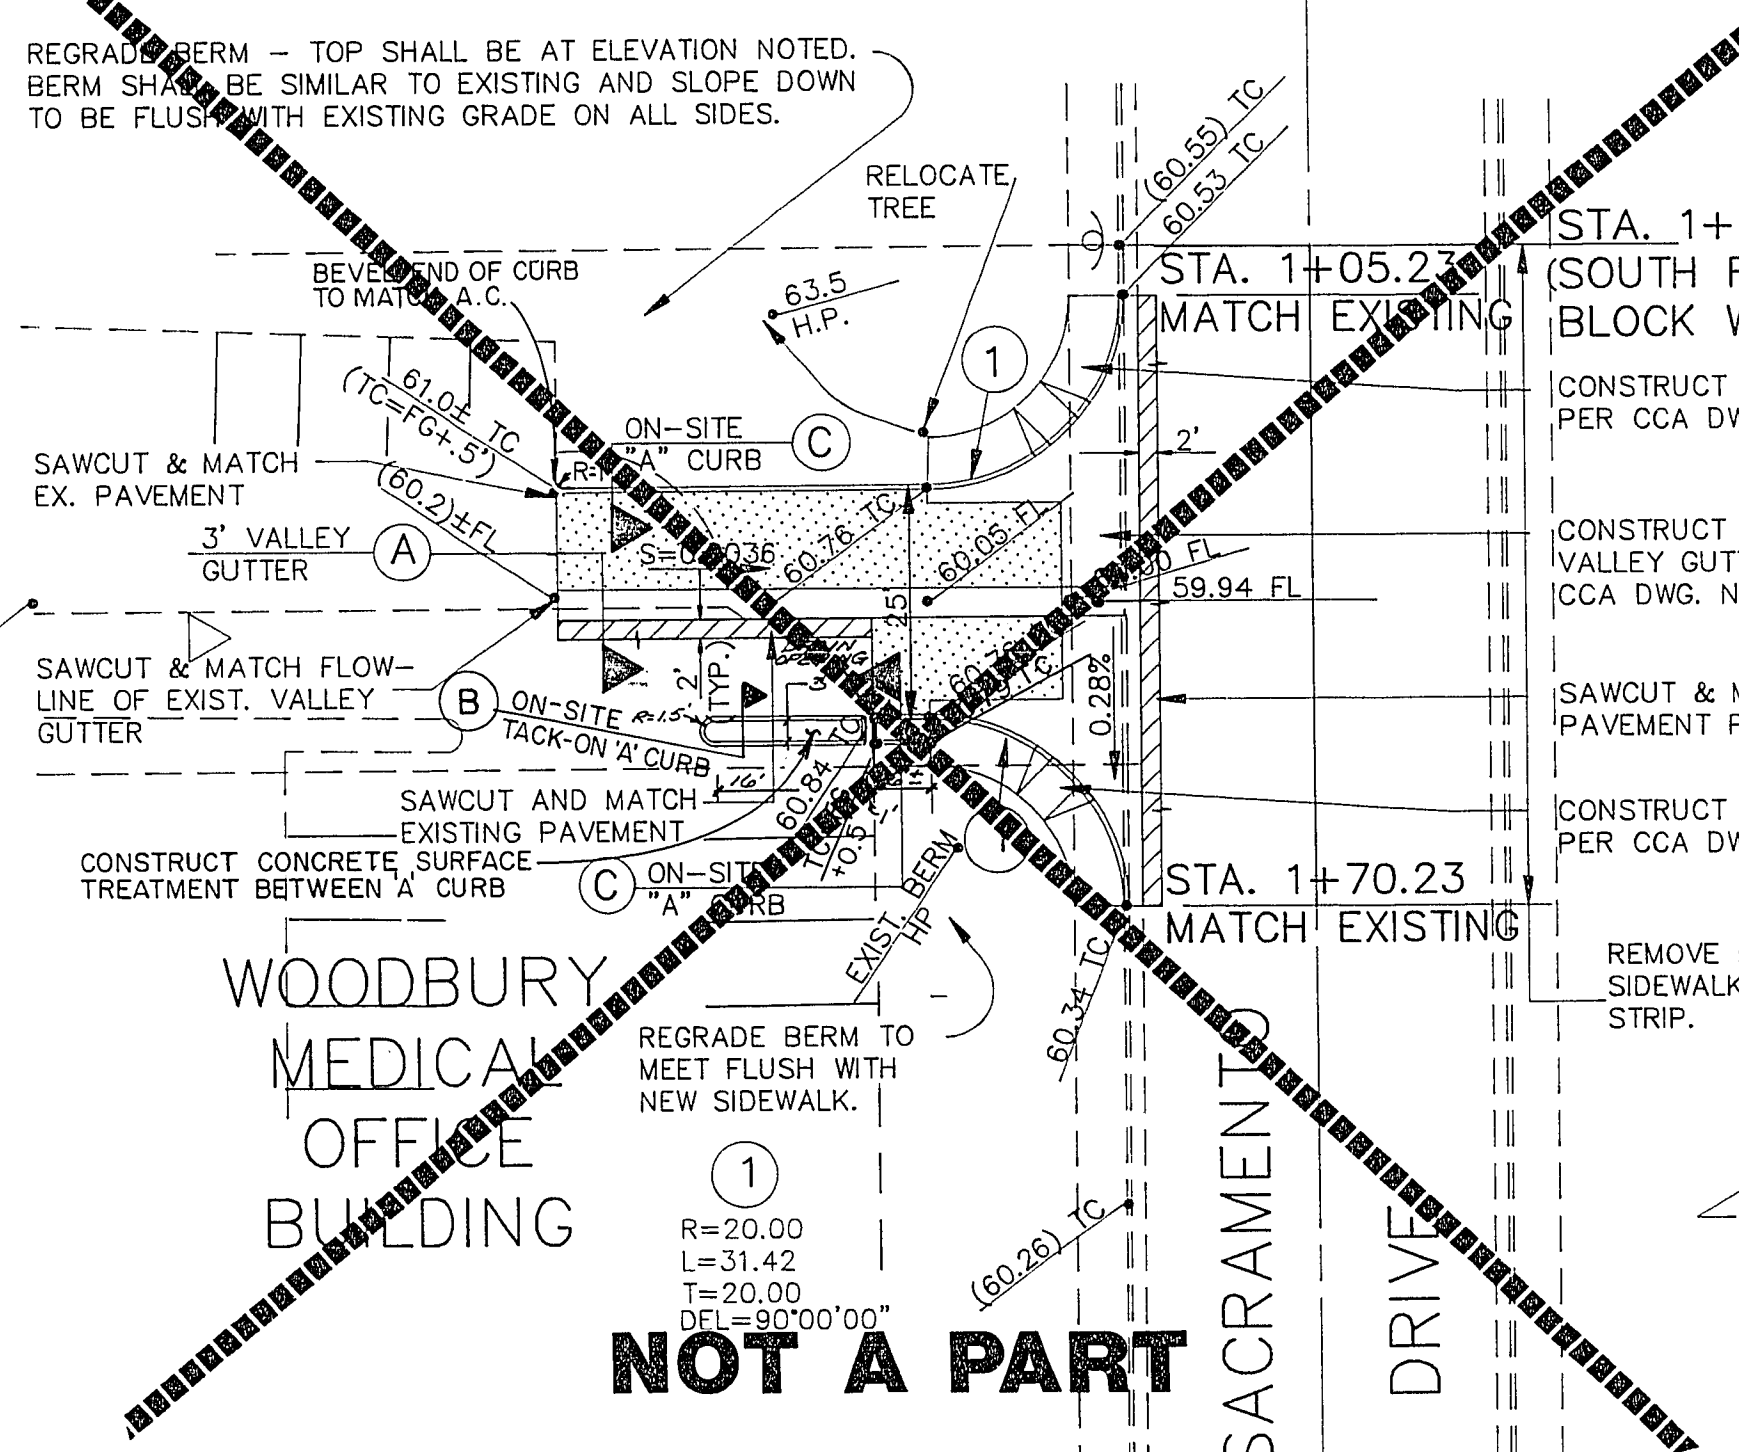


ON-SITE PAVEMENT SECTION

NO SCALE

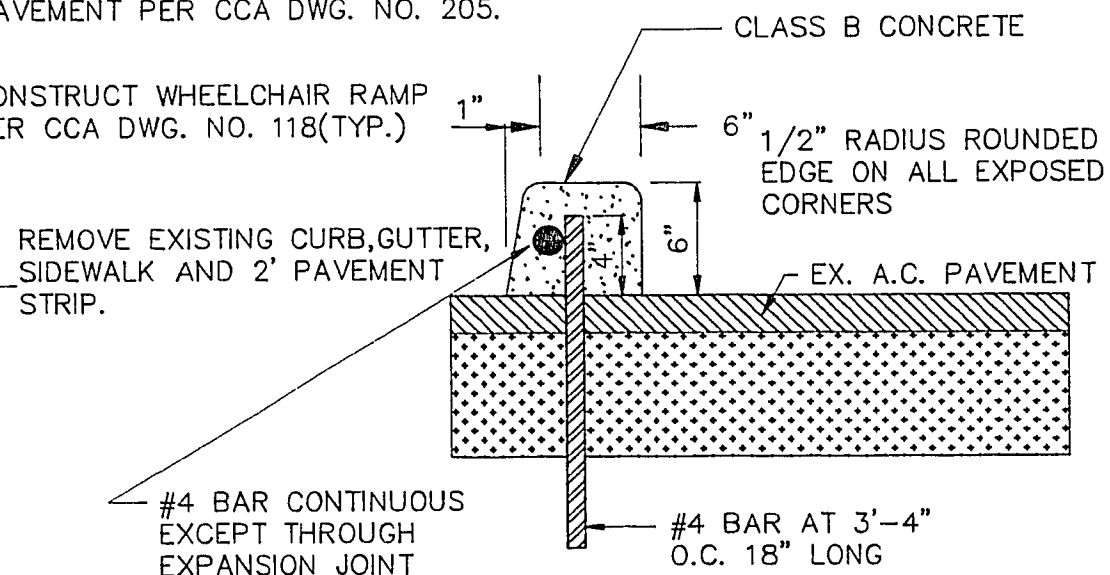

SECTION

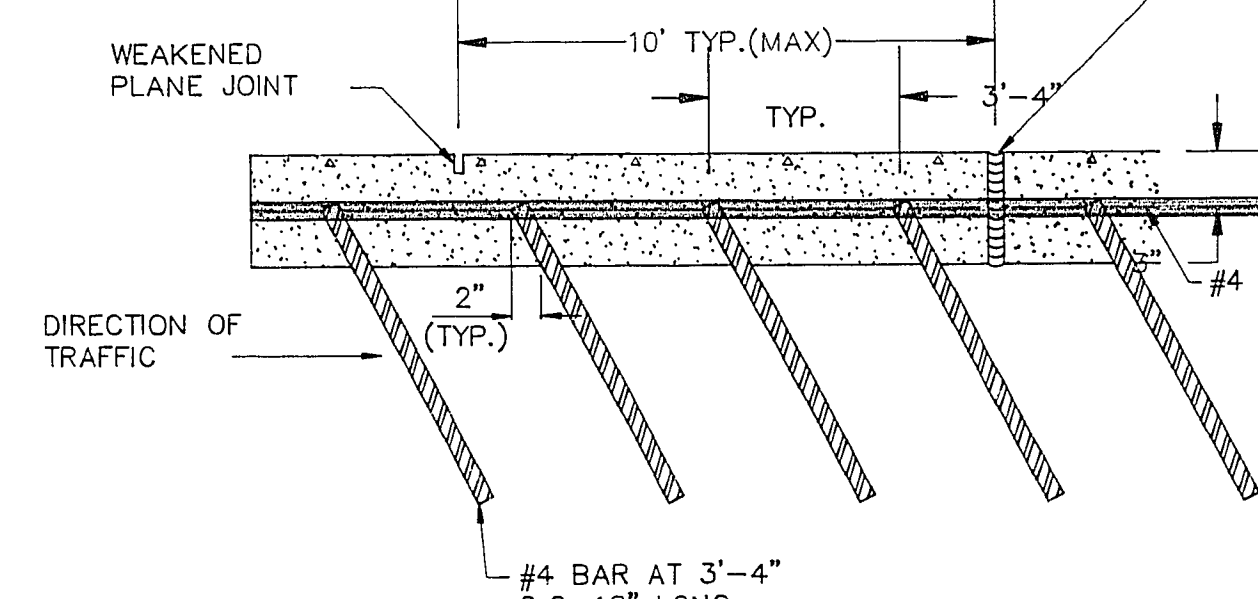

SIDE VIEW

ON-SITE TACK ON CURB

NO SCALE


(B)

- NOTES:
1. FOR EXPANSION JOINT AND WEAKENED PLANE JOINT DETAIL, SEE DETAIL THIS SHEET. (LEFT)
 2. WEAKENED PLANE JOINTS EVERY 10' STAGGER WITH #4 BARS.
 3. ALL REINFORCED STEEL SHALL HAVE 2" CLEAR COVER UNLESS OTHERWISE SHOWN.

NOTE


EXISTING UTILITY LOCATIONS SHOWN HEREON ARE APPROXIMATE ONLY. IT SHALL BE THE CONTRACTOR'S RESPONSIBILITY TO DETERMINE THE EXACT VERTICAL AND HORIZONTAL LOCATION OF ALL EXISTING UNDERGROUND UTILITIES PRIOR TO COMMENCING CONSTRUCTION. NO REPRESENTATION IS MADE THAT ALL EXISTING UTILITIES ARE SHOWN HEREON. THE ENGINEER ASSUMES NO RESPONSIBILITY FOR UTILITIES NOT SHOWN OR UTILITIES NOT SHOWN IN THEIR PROPER LOCATION. CALL BEFORE YOU DIG: 1-800-227-2600.

NOTE: ALL DIMENSIONS ARE TO BACK OF CURB.

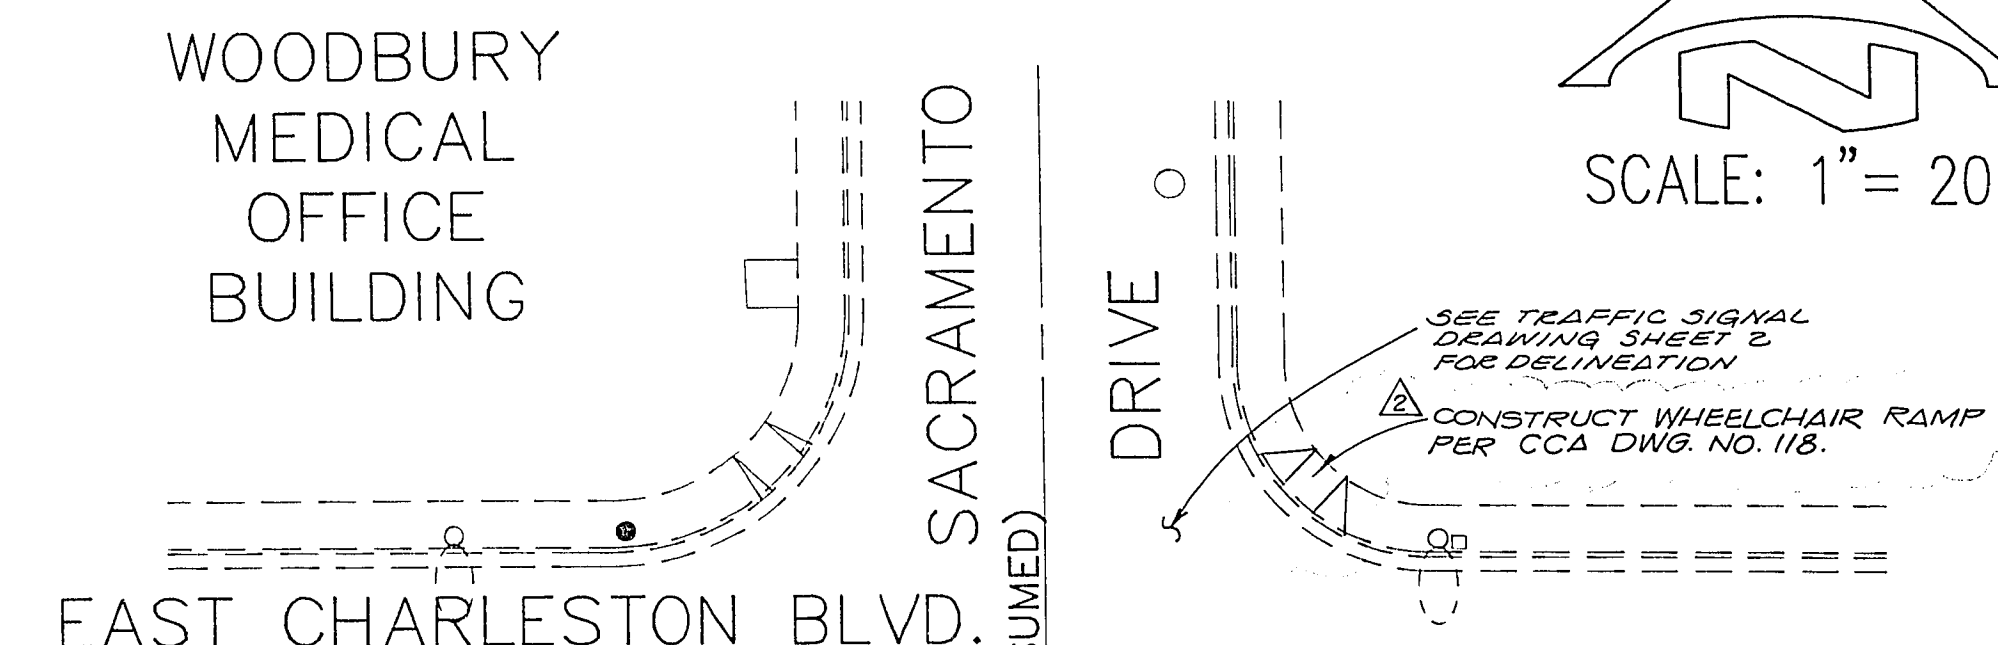

EL POLLO LOCO

VALLEY BANK

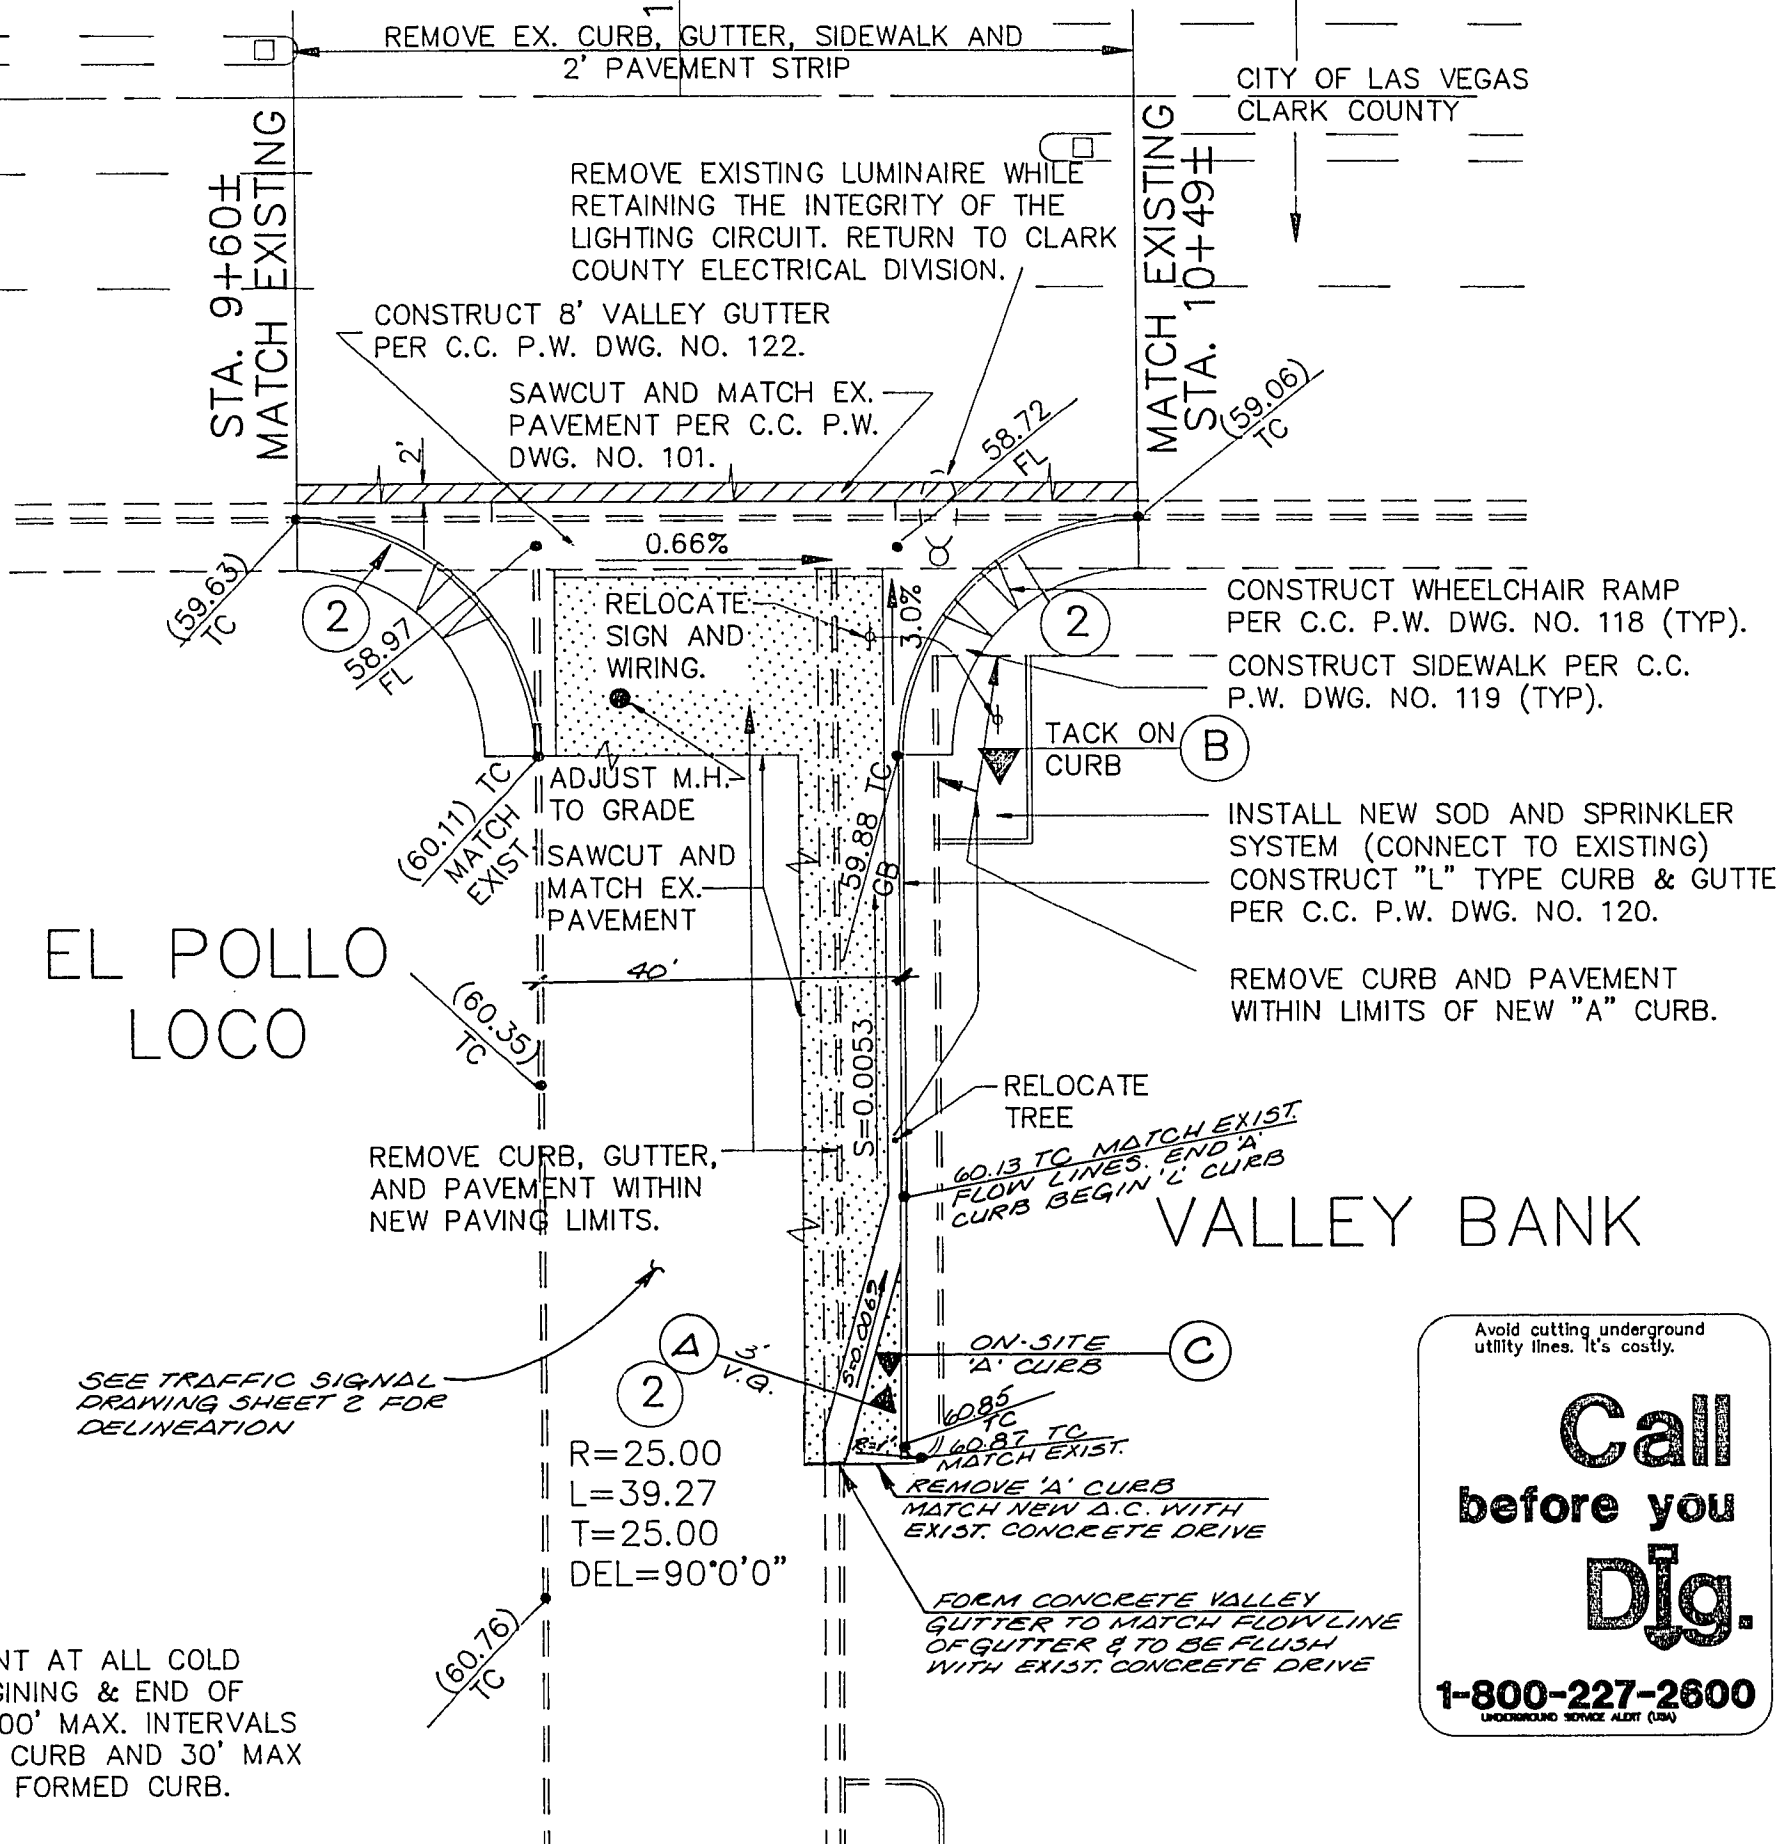

CONCRETE VALLEY GUTTER DETAIL

NO SCALE

(A)

REVISIONS	
NO.	DESCRIPTION/DATE
1	CITY COM 2-5-91 KH
2	REVISIONS TO 2-5-91 KH
3	ADD WHEELCHAIR RAMP 3-5-91 KH
RENO/SPARKS, NEVADA LAS VEGAS, NEVADA PHOENIX, ARIZONA	
Incorporated CONSULTING ENGINEERS	
VALLEY BANK OF NEVADA GRADING PLAN & DETAILS	
NEVADA CLARK COUNTY LAS VEGAS	
JOB NO. 2-418-011 DESIGNED K.H. DRAWN L.L. COMP. CHECKED DATE JANUARY, 1991	
2 OF 2 SHEETS	