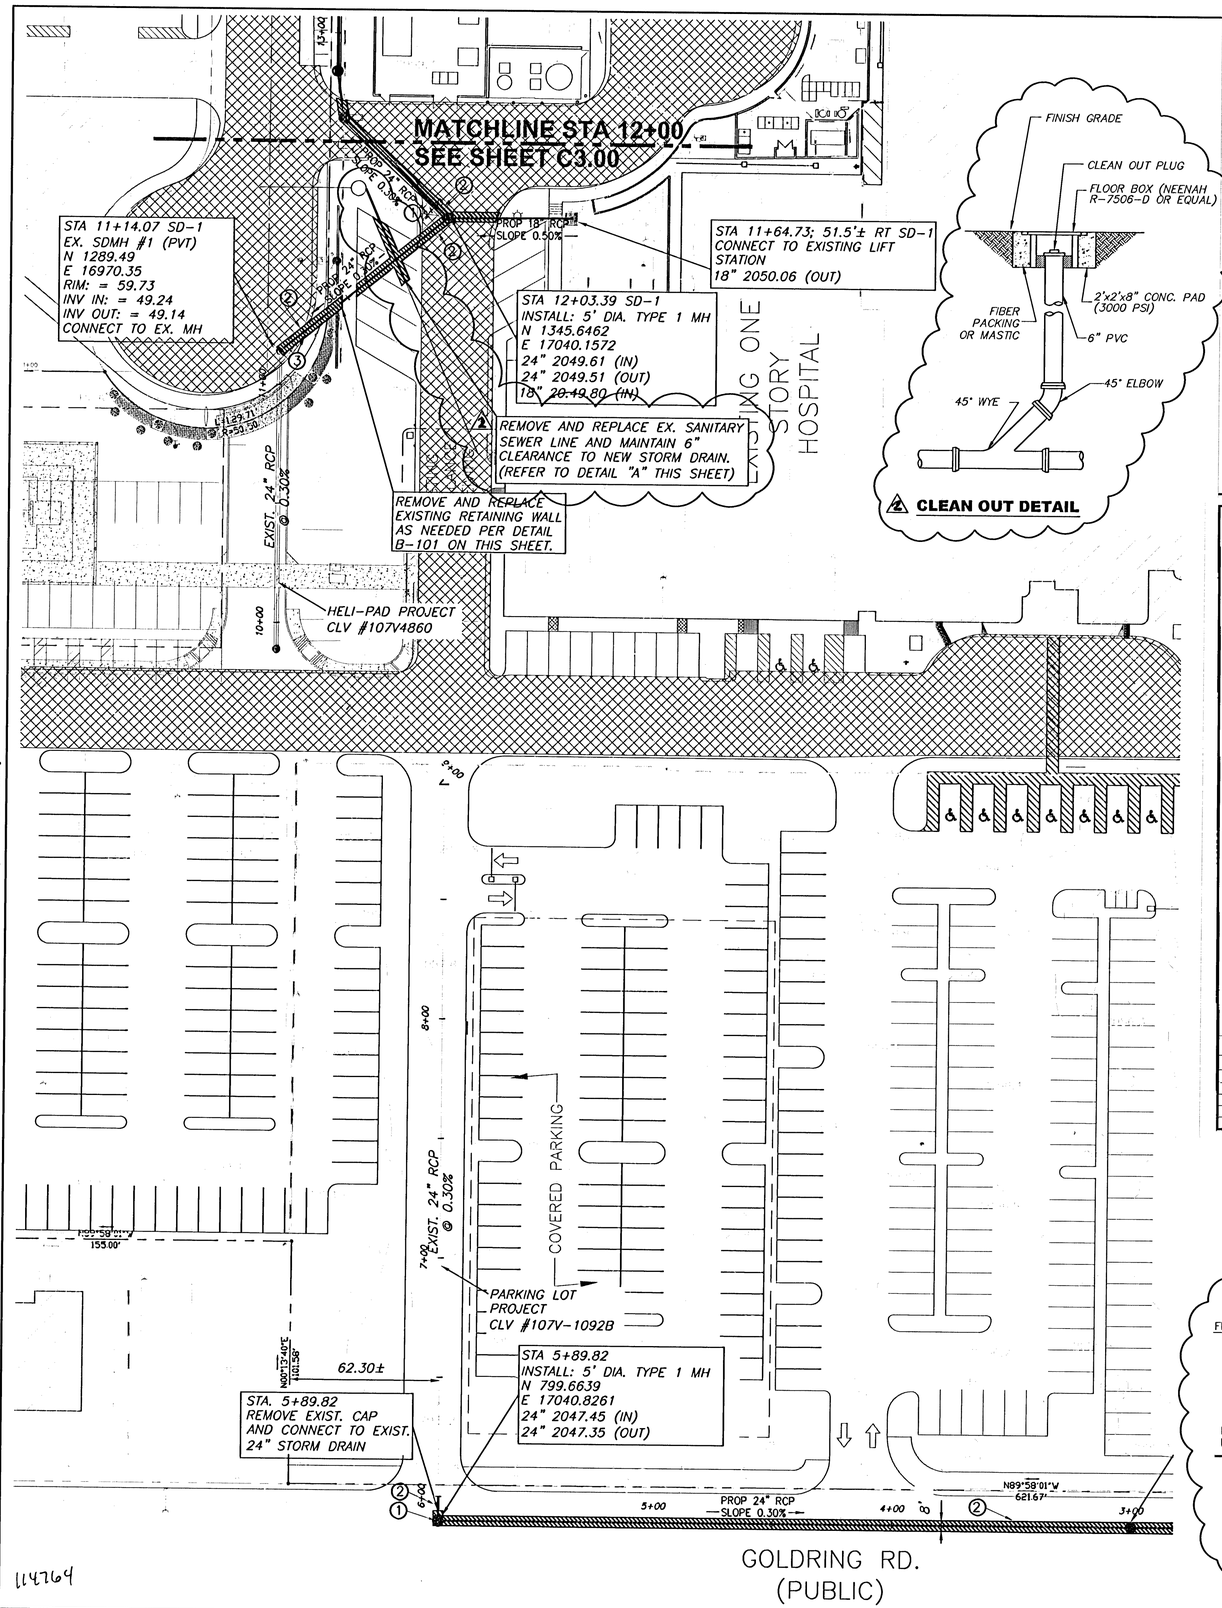





**CLEAN OUT DETAIL**

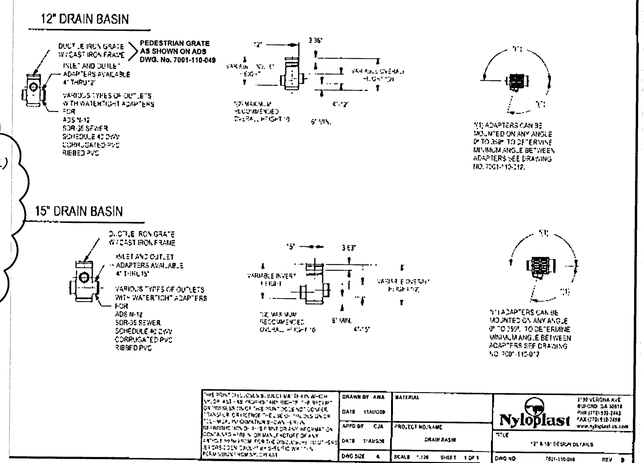


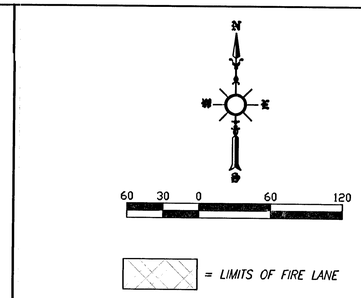


## STORM DRAIN CONSTRUCTION NOTES

1. 4' STD MH PER USDCCA DWG. No. 403 ON SHEET C3.4
2. TRENCH BACKFILL PER USDCCA DWG. No. 504 ON SHEET C3.4
3. REMOVE AND REPLACE PAVEMENT TO MATCH EXISTING PAVEMENT

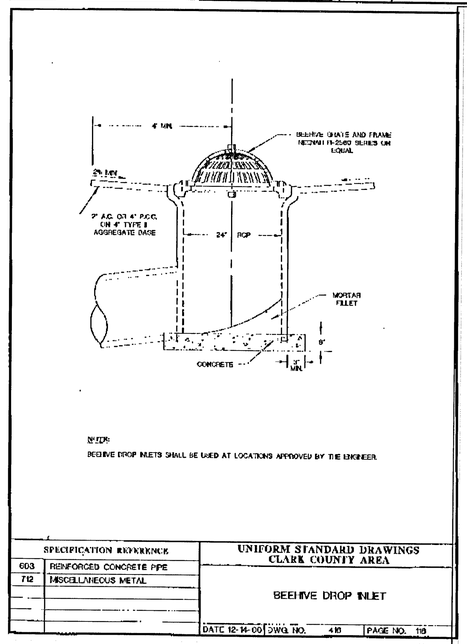


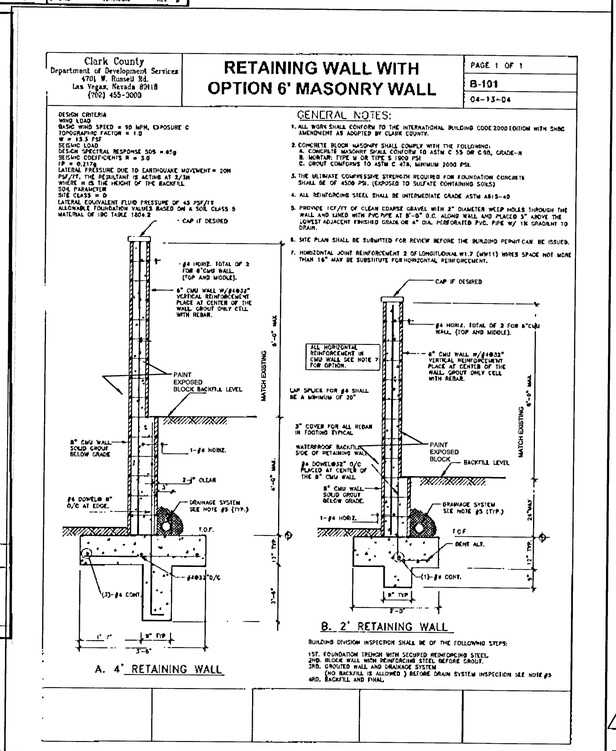


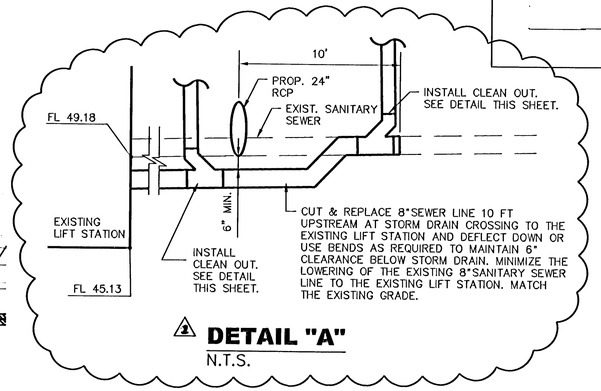


**DETAIL "A"**
N.T.S.

## BASIS OF BEARINGS:

NORTH 89°54'49" WEST, BEING THE BEARING OF THE CENTERLINE OF PINTO LANE, AS SHOWN ON THAT CERTAIN MAP ON FILE IN THE CLARK COUNTY RECORDER'S OFFICE IN BOOK 123, PAGE 37 OF PLATS, SITUATE IN THE SOUTHWEST QUARTER (SW 1/4) OF SECTION 33, TOWNSHIP 20 SOUTH, RANGE 61 EAST, M.D.M., CITY OF LAS VEGAS, CLARK COUNTY, NEVADA.

## BENCHMARK:

CITY OF LAS VEGAS BENCHMARK 1LV01 33SW6
RIVET AND PLATE IN TOP OF CURB AT THE SOUTHEAST CORNER OR SHADOW LANE AND PALOMINO

ELEVATION = 626.313 METERS, 2054.83 FEET (NAVD 88)

| REV: | DESCRIPTION: | DATE: | BY: |
|---|---|---|---|
| 2 | LVVWD COMMENTS & SAN. SEWER & SD CONFLICTS | 5/20/08 | RC |

UHS

**CLIENT**
UHS OF DELAWARE, INC
367 SOUTH GULPH ROAD
KING OF PRUSSIA, PA 19406

**ARCHITECT**
HKS ARCHITECTS, INC.
1919 McKINNEY AVENUE
DALLAS, TX 75201

**STRUCTURAL ENGINEER**
HKS ARCHITECTS, INC.
1919 McKINNEY AVE.
DALLAS, TX 75201-1753

**MEP ENGINEER**
CCRD PARTNERS
3625 N. HALL ST., SUITE 1300 LB 139
DALLAS, TX 75219

**DESIGN CONSULTANT**
DESIGN STUDIO, INC.
161 LEVERINGTON AVENUE
PHILADELPHIA, PA 19127

**CIVIL ENGINEER**
LOPEZGARCIA GROUP
1825 MARKET CENTER, SUITE 500
DALLAS, TX 75207

**LANDSCAPE ARCHITECT**
JW ZUNINO AND ASSOCIATES
3191 S JONES BLVD
LAS VEGAS, NV 89146

HKS

Valley Hospital Medical Center

**VALLEY HOSPITAL MEDICAL CENTER**
**LAS VEGAS, NEVADA**

# SURGERY EXPANSION

RICHARD CARSON, JR. — STATE OF NEVADA — PROFESSIONAL ENGINEER — EXP: 12-31-08 — CIVIL — No. 14870

DATE: NOVEMBER 17, 2008

KEY PLAN

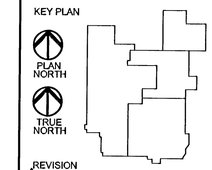


REVISION
1 PC-005 MAY 21, 2008

HKS PROJECT NUMBER
**07141.005**

DATE
**6 DECEMBER 2007**

ISSUE
**CONSTRUCTION DOCUMENTS**

SHEET TITLE
**UTILITY PLAN**

# C3.01

SHEET NO. 12 OF 21

107V1092-EX

© 2008 HKS ARCHITECTS INC.

Drawing: P:\DM\2061104.00_Valley_OR\Drawings\C3_01-02_OFF-SITE.dwg at Nov 17, 2008-1:35pm by tori.pulisce
Layout: Layout1 Xrefs: 061004.00-Ts.dwg - 01KFP.dwg - 00ASP.dwg - civilbase.dwg - TB2442Ts.dwg - utility base.dwg - VHMC-01-srvy.DWG - WWP1.dwg - x-05419-tp-add.dwg - x-06572-bm-bld.dwg