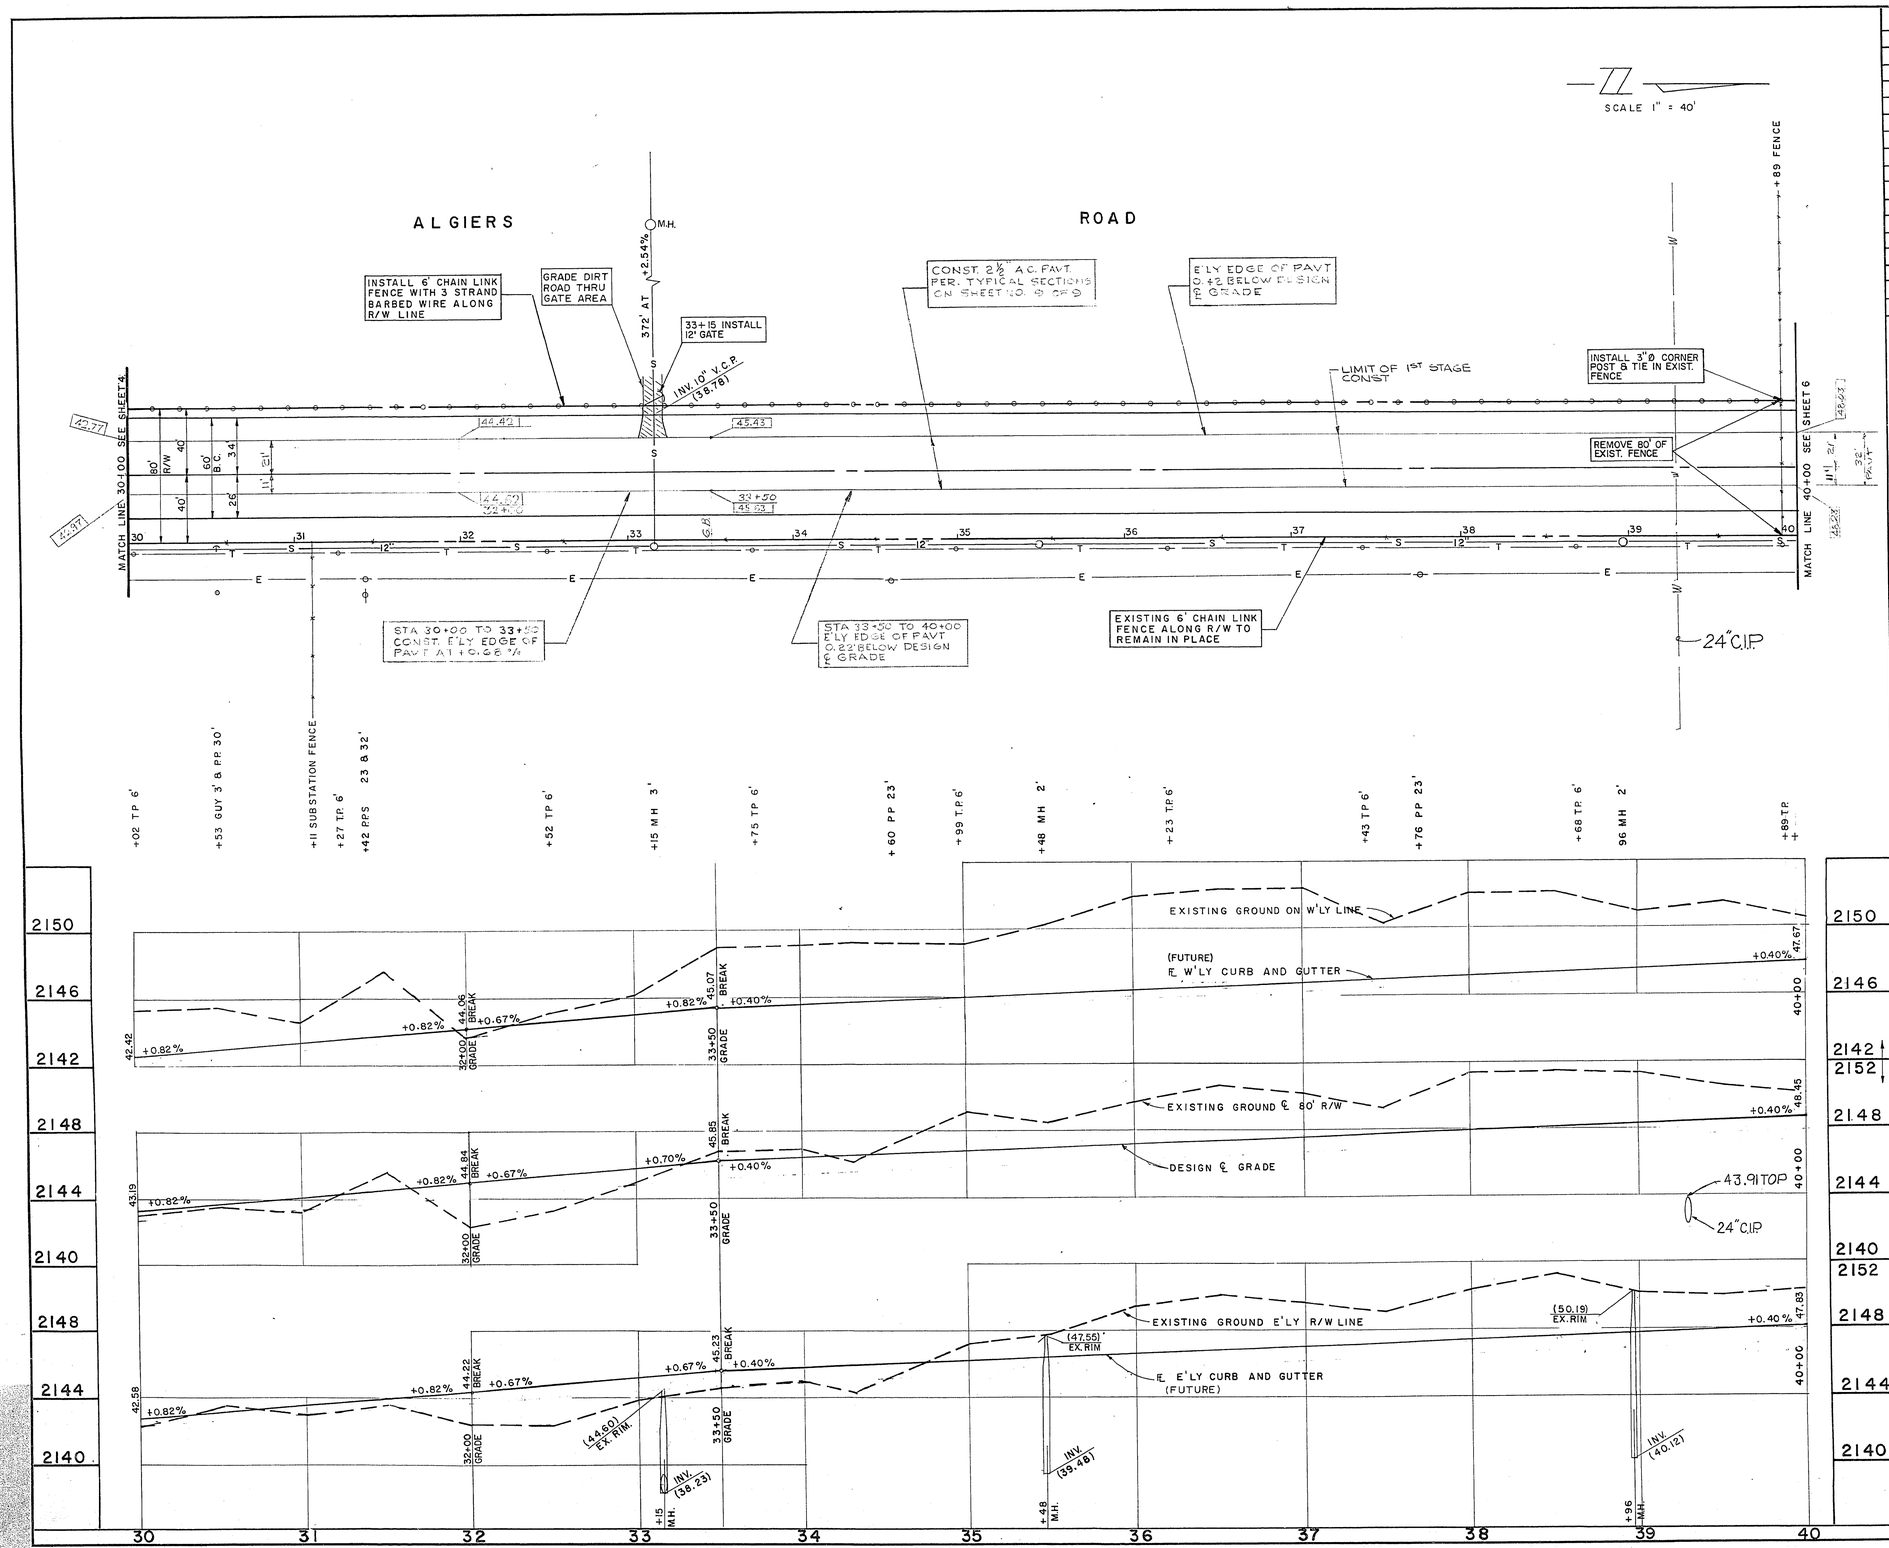

APPROXIMATE QUANTITIES – THIS SHEET

ITEM	DESCRIPTION	UNIT	QUANTITY
201.1	ROADWAY EXCAVATION	C.Y.	
302.1A	TYPE I GRAVEL EMBANKMENT	C.Y.	74
302.1B	TYPE I GRAVEL BASE	C.Y.	889
302.2	TYPE II GRAVEL BASE	C.Y.	395
334.5	2 1/2" ASPHALT CONC PAVT	S.Y.	3556
333.1	BITUMINOUS FOG SEAL COAT	S.Y.	3556
410.1	INSTALL 6' CHAIN LINK FENCE	L.F.	977
410.312	INSTALL 12' CHAIN LINK GATE	E.A.	1
410.1	REMOVE FENCE	L.F.	80

APPROVED DATE

8			
7		RL	2-20-69
1		KSH	12/12/68
5		JDD	2-18-69
4			
6		RW	7/1/68
2			12-1-69
3			

REVISION NO.	DESCRIPTION	BY	DATE	APPROVAL
1	BASE THICKNESS CHANGED	EJL		7/21/69

REVISIONS

CITY OF LAS VEGAS NEVADA
DEPARTMENT OF PUBLIC WORKS
SERVICES DIVISION

ALGIERS ROAD
CHARLESTON BLVD.-WEST FREMONT ST.

W.O. NO. 7070	F. BK. NO. 59-3X, 66-7X	DATE	DRAWING NO.
SC. (H) 1" = 40'	SC. (V) 1" = 4'	4-10-68	107V-604B
DES. LOUVIERE		4-10-68	FILE NO.
DR. LANGE JMC.			
APPROVED BY DIRECTOR OF PUBLIC WORKS			SHEET 5 OF 9

6-4-68

BRUNING 44 560