
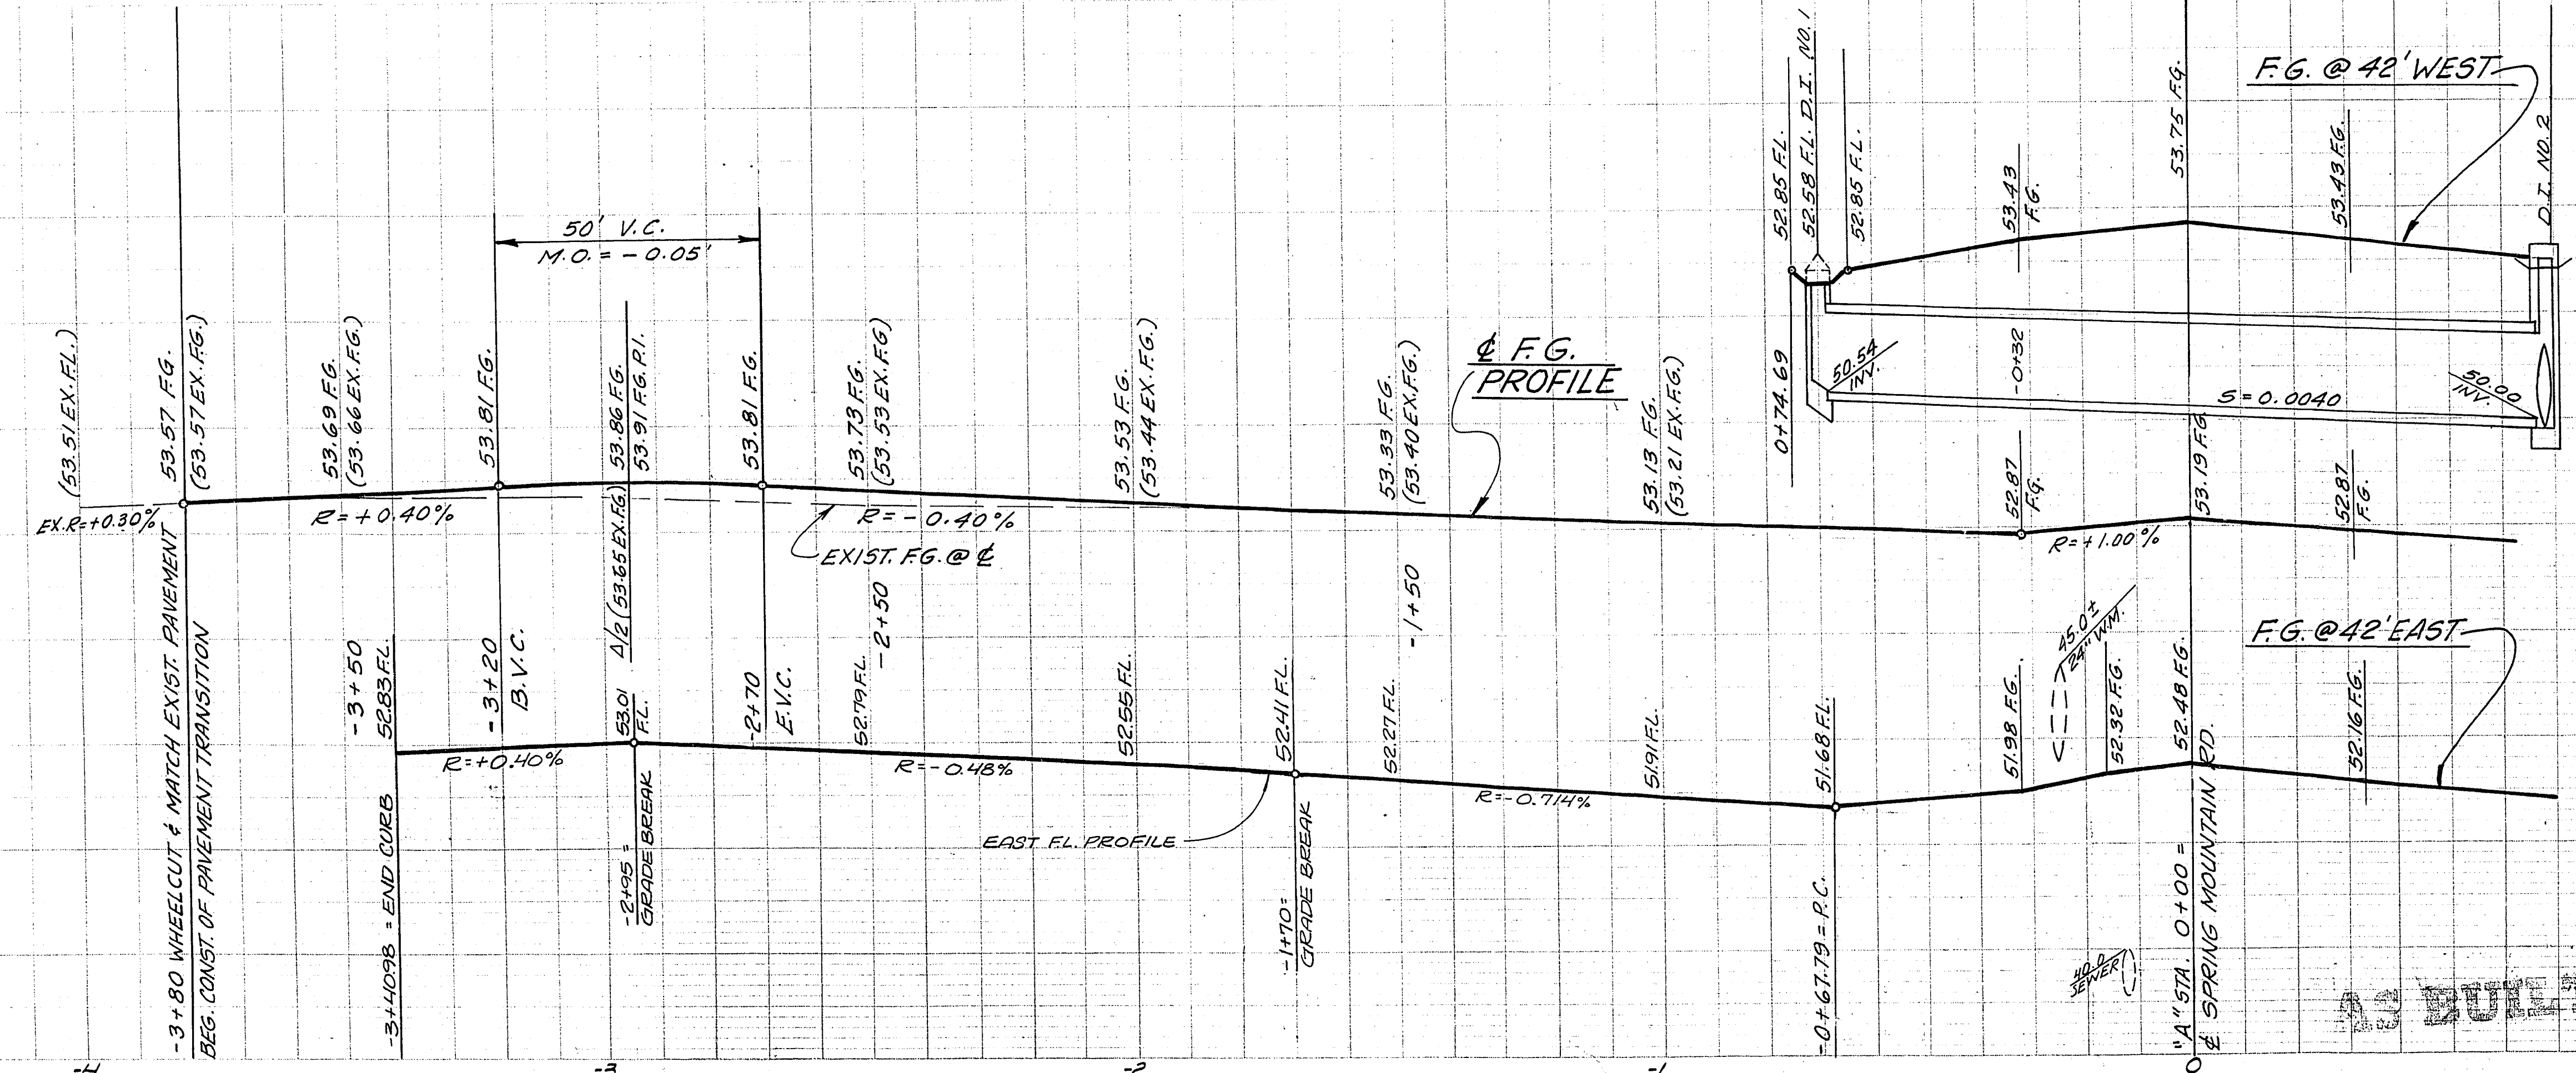
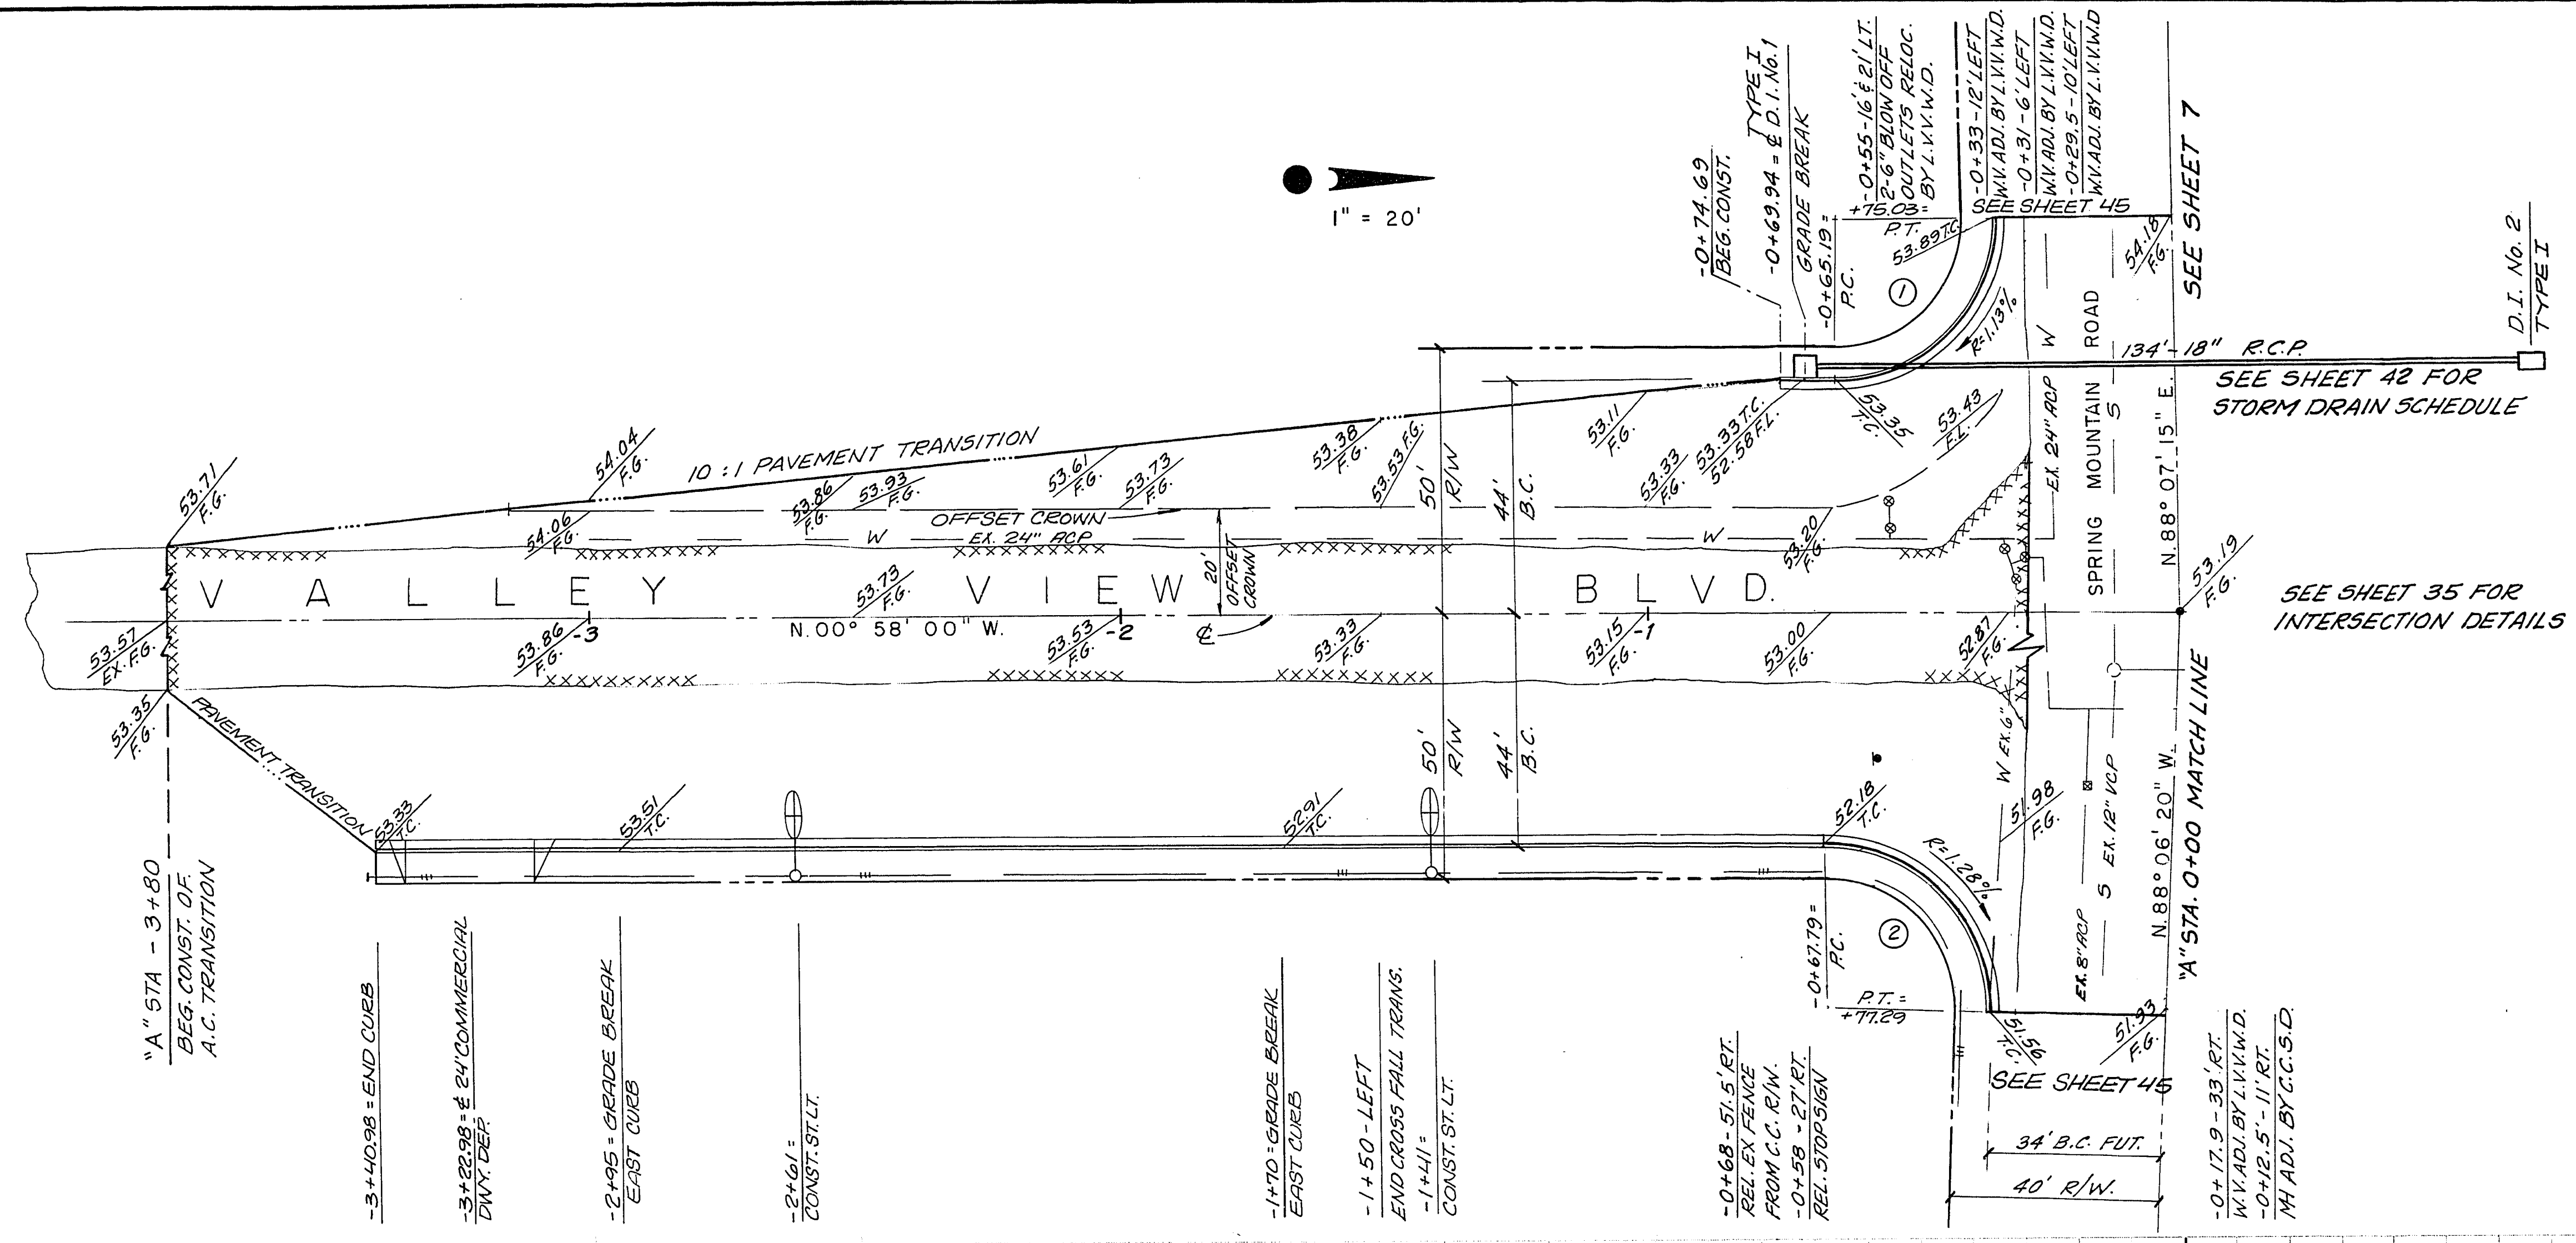


PLAN
 VALLEY VIEW BLVD.
 SPRING MOUNTAIN RD. TO CHARLESTON BLVD.
 "A" STA. -4+00 TO 0+50

PROFILE
 VALLEY VIEW BLVD.
 SPRING MOUNTAIN RD. TO CHARLESTON BLVD.
 "A" STA. -4+00 TO 0+50

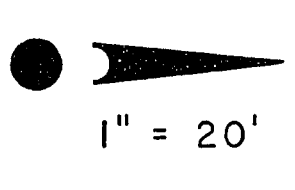

ITEM	DESCRIPTION	APPROXIMATE QUANTITY	ESTIMATE
201.000	ROADWAY EXCAVATION	700	C.Y.
302.000	TYPE I GRAVEL BASE	201	C.Y.
303.200	TYPE II GRAVEL BASE	295	C.Y.
334.000	ASPHALT CONCRETE PAVEMENT - 5"	1795	TON
334.500	1/2" PRIMAIR BITUMINOUS OPEN-GRADED SURFACE	3290	S.Y.
340.000	CONC. 1" TYPE CURB & GUTTER (24" WIDE)	823	L.F.
351.000	1/4" C. OVERLAY	1/2	TON
400.000	ADJUST SANITARY SENER MANHOLE	1	EA.
400.000	STREET LIGHT	2	EA.
340.100	CONCRETE SIDEWALK	1766	S.F.
340.200	COMMERCIAL DEPRESSED CURB	24	L.F.
340.200	COMMERCIAL DEWEWAY	144	S.F.

CONTRACT
 DRAWING
 MAY 1 1974

NO.	Δ	BCR	L	T	PLR	
51	2	92° 51' 40"	30.00'	48.62'	31.54'	24.00'
50	1	90° 54' 45"	30.00'	47.60'	30.45'	24.00'

NO.	ELEV.	DESCRIPTION
1	53.15	BRASS CAP AT CENTERLINE'S

REV.	DATE	DESCRIPTION	APP'D.

DELTA ENGINEERING INC.
 4239 W. SAHARA AVE.
 LAS VEGAS, NEV. 89102
 PHONE: (702) 876-0330

VALLEY VIEW BLVD.
 SPRING MOUNTAIN RD. TO CHARLESTON BLVD.
 "A" STA. -4+00 TO 0+50

H. SCALE: 1" = 20'	V. SCALE: 1" = 2'	DES. D.P.	DWG NO. 107-V926
WO NO. 71102	CHK'D.	DWN. E.C.	FILE NO.
APPROVED	DATE	DATE	SHEET 6 OF 45

30410