


PLAN
 DATE: 05/14/74
 DRAWN BY: J. M. MUMFORD
 CHECKED BY: J. M. MUMFORD
 APPROVED BY: J. M. MUMFORD

PROFILE
 DATE: 05/14/74
 DRAWN BY: J. M. MUMFORD
 CHECKED BY: J. M. MUMFORD
 APPROVED BY: J. M. MUMFORD

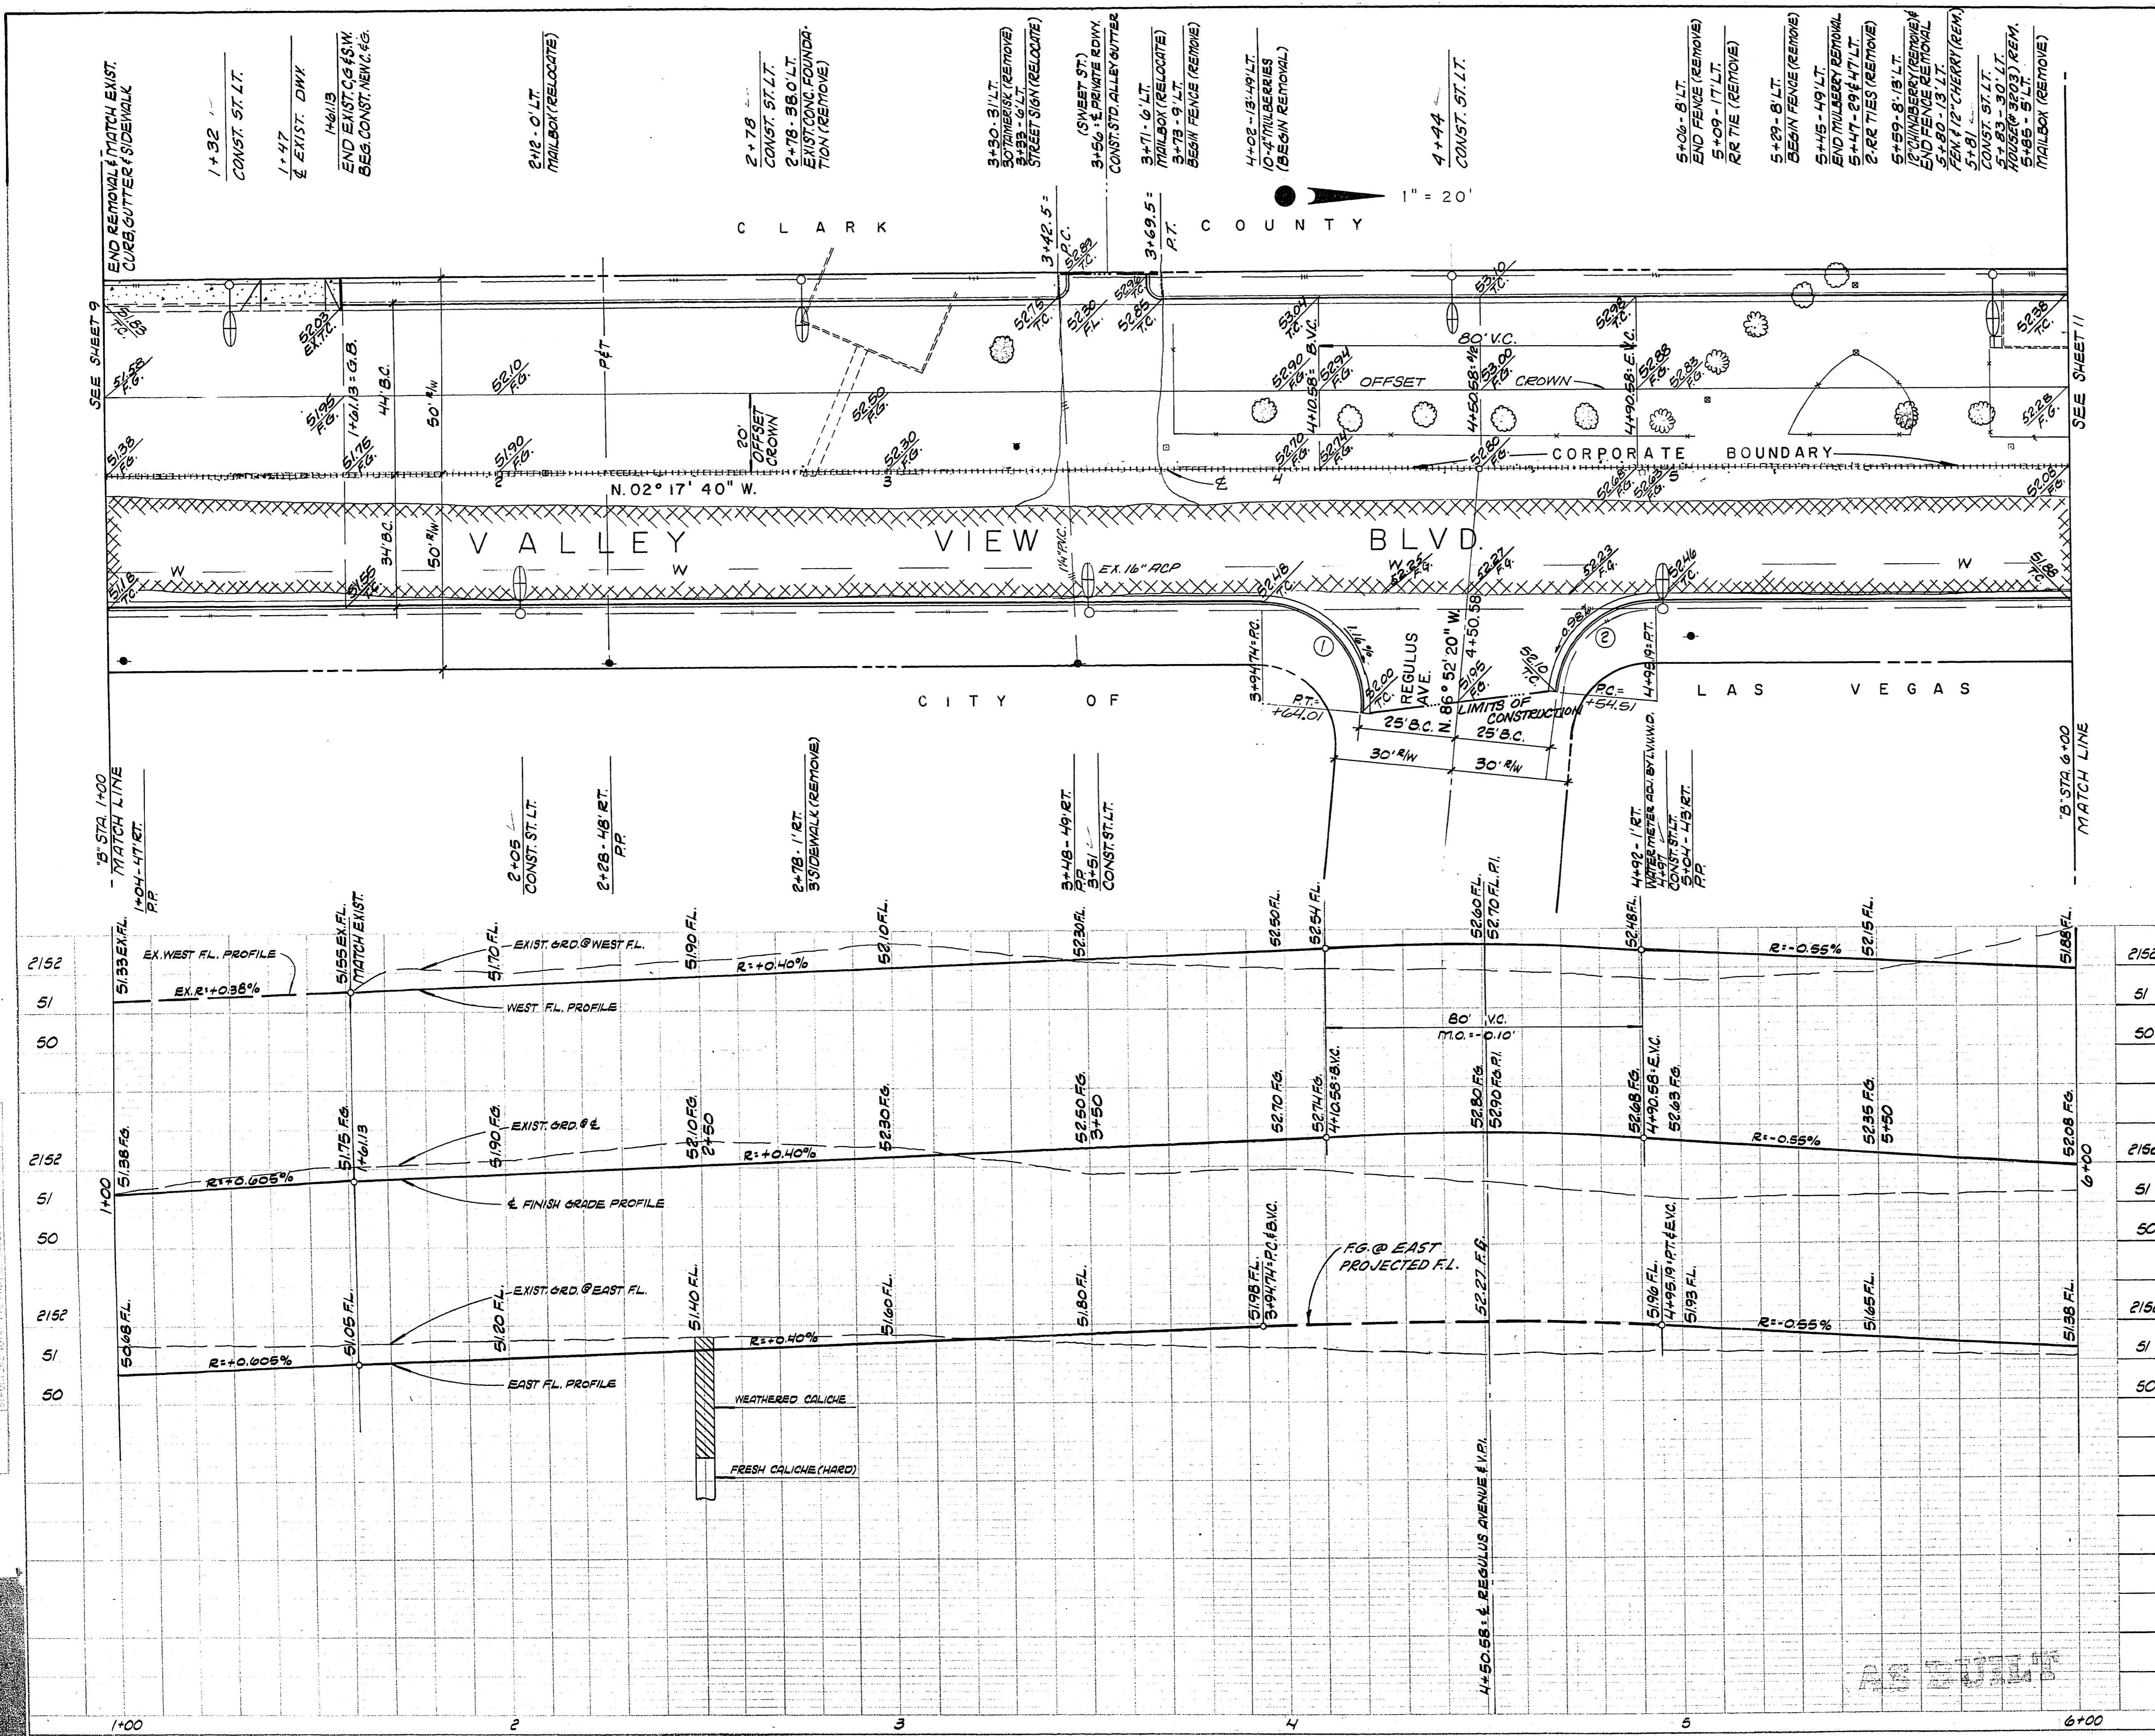

ITEM	DESCRIPTION	APPROXIMATE QUANTITY	ESTIMATE	CC	CC-SID	CLV	CLV-SID	TOTAL	UNIT
201100	ROADWAY EXCAVATION	1256	RSH					1256	C.Y.
302100	TYPE I GRAVEL BASE	493						493	C.Y.
302200	TYPE II GRAVEL BASE	418						418	C.Y.
334000	ASPHALT CONCRETE PAVEMENT - 5"	1059						1059	TON
334500	PLANT MIX BITUMINOUS OPEN-GRADED SURFACE	3764						3764	S.Y.
334800	PLANT MIX BITUMINOUS PRIME COAT	941						941	S.Y.
200100	CONCRETE REMOVAL	105						105	SQ.FT.
200200	REMOVE TREE (4"-10")	10						10	EA.
200400	REMOVE (OVER 10")	3						3	EA.
340014	BUILDING REMOVAL	1/2						1/2	EA.
340014	CONCRETE 1" TYPE CURB & GUTTER (W/2)	478						478	L.F.
340326	ALLEY GUTTER	174						174	S.F.
400222	STREET LIGHT INSTALLATION	3						3	EA.

NO.	Δ	BCR	L	T	PLR
2	84°34'40"	25.00	3690	22.74	20.00
1	95°25'20"	25.00	4164	27.49	20.00

REV.	DATE	DESCRIPTION	APP'D.

DELTA ENGINEERING INC.
 4239 W. SAHARA AVE.
 LAS VEGAS, NEV. 89102
 PHONE: (702) 876-0330

VALLEY VIEW BLVD.
 SPRING MOUNTAIN RD. TO CHARLESTON BLVD.
 "B" STA. 1+00 TO 6+00

H. SCALE: 1"=20' V. SCALE: 1"=2'
 W.O. NO. 71102 CHK'D. DWN. MM. DWG. NO. 107-V926
 APPROVED: [Signature] DATE: SHEET 10 OF 45

314-14