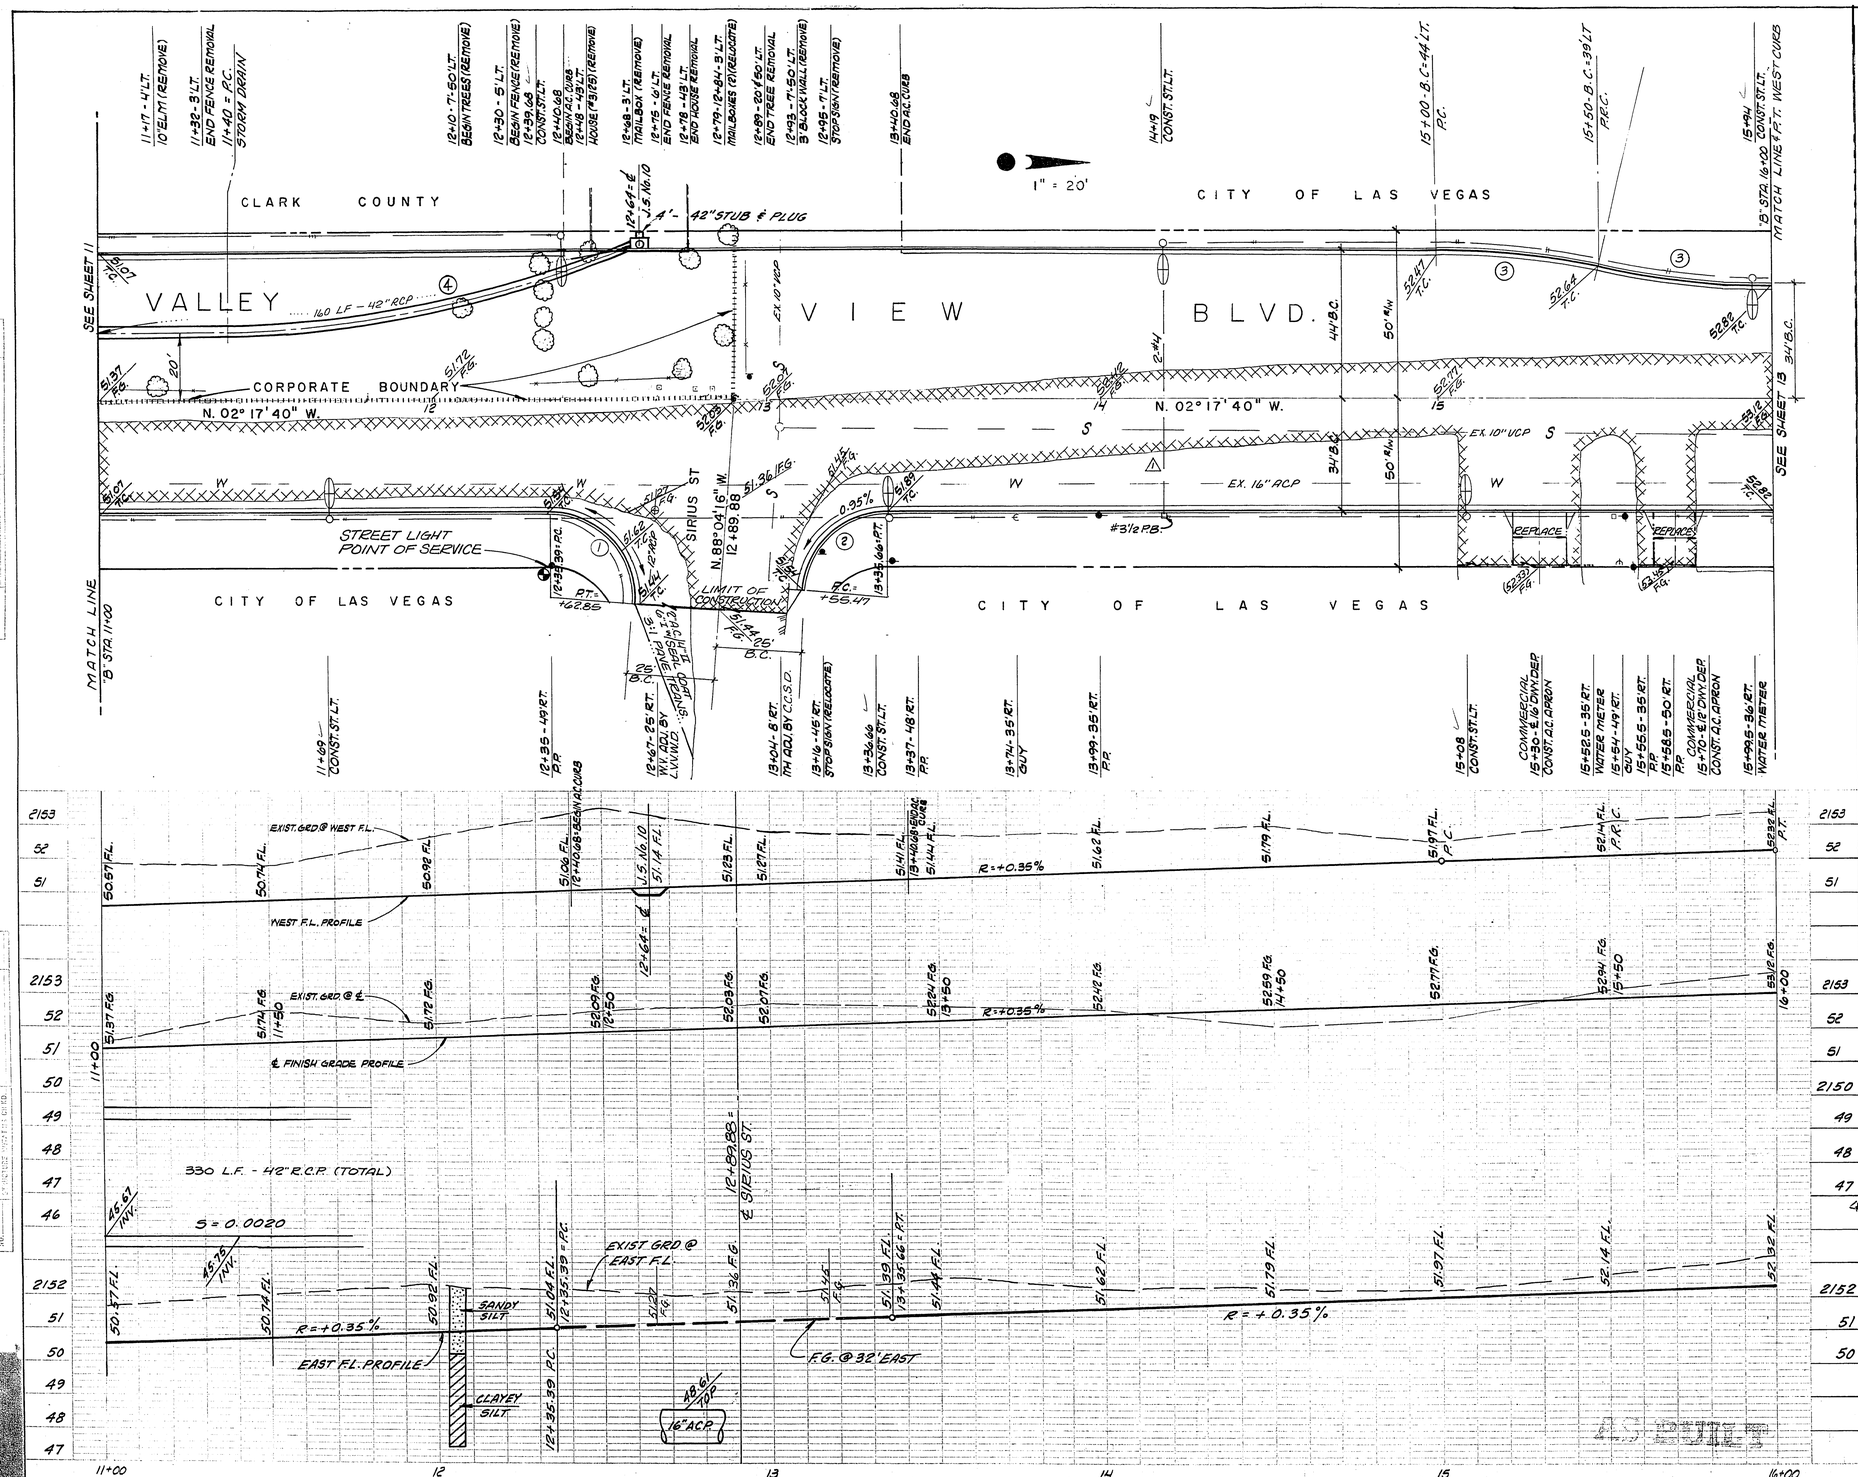

APPROXIMATE QUANTITY ESTIMATE

ITEM	DESCRIPTION	R S H	C C	CC-SID	CLV	CLV-SID	TOTAL	UNIT
201.100	ROADWAY EXCAVATION	2770					2770	C.Y.
302.100	TYPE I GRAVEL BASE	558		46		65	669	C.Y.
302.200	TYPE II GRAVEL BASE	395		26		53	474	C.Y.
331.010	ASPHALT CONCRETE PAVEMENT - 5"	996		58		80	1134	TON
333.500	1/2" PG. ANTIMIX BITUMINOUS OPEN-GRADED SURFACE	3541		205		285	4031	S.Y.
339.800	BITUMINOUS PRIME COAT	885		51		71	1007	GAL.
340.014	CONCRETE "L" TYPE CURB & GUTTER (24")			141		694	835	L.F.
339.912	A.C. CURB	450		50		50	100	LIN. FT.
333.907	A.C. DRIVEWAY (2½")						450	SQ. FT.
200.300	REMOVE TREE (4"-10")	7					7	EA.
200.400	REMOVE TREE (OVER 10")	5					5	EA.
340.236	COMMERCIAL DEPRESSED CURB					44	44	L.F.
512.500	ADJUST SANITARY SEWER MANHOLE	1					1	EA.
400.222	STREET LIGHT INSTALLATION			1		5	6	EA.
200.201	HOUSE REMOVAL	1					1	EA.
	SEE SHEET 42 FOR STORM DRAIN							

CONTRACT DRAWING
MAY 3 1974

* STORM DRAIN CENTERLINE

CURVE DATA

NO.	Δ	BCR	L	T	PLR
4	20°13'19"	340.00'*	120.00'	60.63'	—
3	11°25'16"	252.50'	50.33'	25.25'	
2	85°46'36"	25.00'	37.43'	23.22'	20.00'
1	94°13'24"	25.00'	41.11'	26.91'	20.00'

BENCH MARK

NO.	ELEV.	DESCRIPTION
4	52.87	CONCRETE MONUMENT – CENTERLINE'S

REVISIONS

48	5-14-74	ADDED ST. LT. X-ING @ STA. 14+19 & P.B.

DELTA ENGINEERING INC.
4239 W. SAHARA AVE.
LAS VEGAS, NEV. 89102
PHONE (702) 876-0330

VALLEY VIEW BLVD.

SPRING MOUNTAIN RD. TO CHARLESTON BLVD.

"B" STA. 11+00 TO 16+00

H. SCALE: 1" = 20'	V. SCALE: 1" = 2'	DES: D.P.	DWG. NO. 107-V926
W.O. NO. 711102	CHK'D.	DWN: MM.	FILE NO.
APPROVED		DATE: 5-3-74	SHEET 12 OF 45

21-4-16