
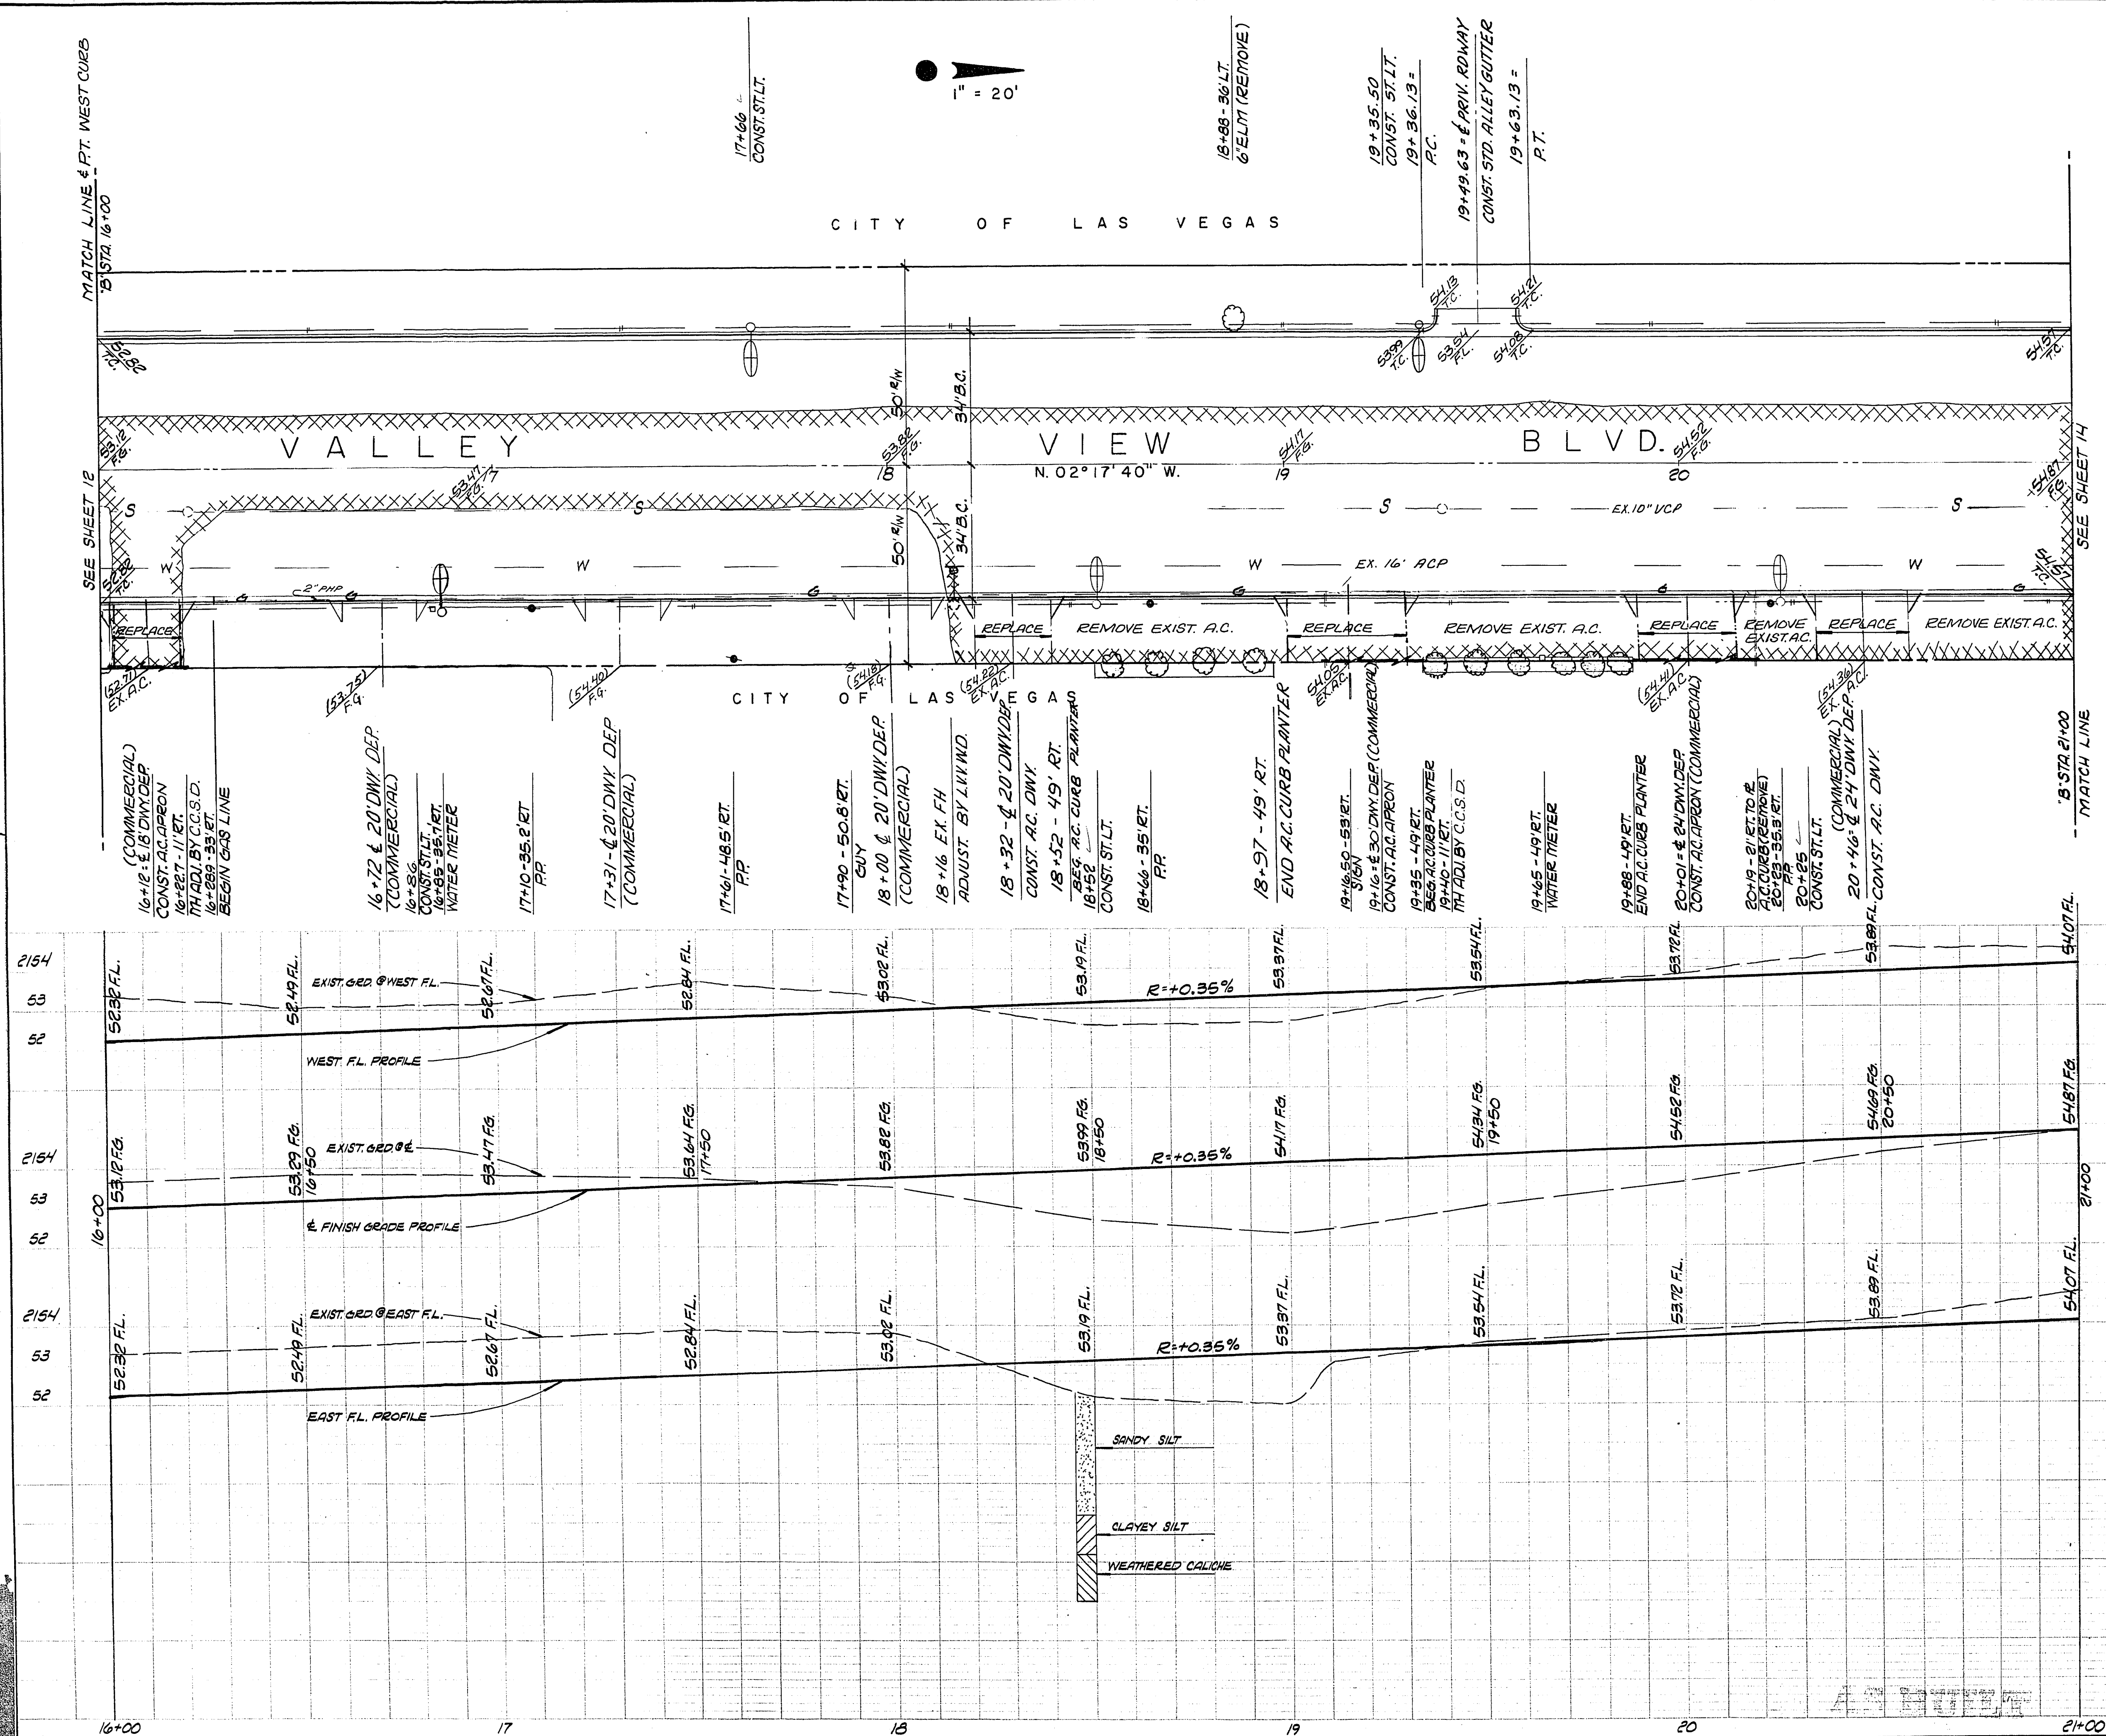
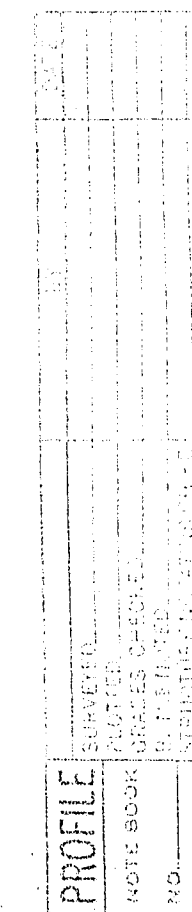


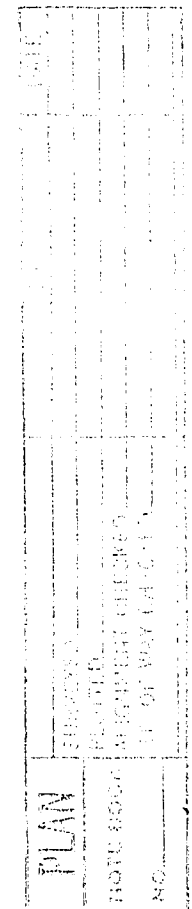

ITEM		DESCRIPTION		APPROXIMATE QUANTITY		ESTIMATE		TOTAL		UNIT	
20100	RD	ROADWAY EXCAVATION		1479		1479		1479		C.Y.	
302100	RD	TYPE I GRAVEL BASE		319		319		319		C.Y.	
302200	RD	TYPE II GRAVEL BASE		225		225		225		C.Y.	
331010	RD	ASPHALT CONCRETE PAVEMENT - 5"		256		256		256		TON	
333500	RD	12" PLANT MIX BITUMINOUS OPEN-GRADED SURFACE		2667		2667		2667		S.Y.	
334800	RD	BITUMINOUS PRIME COAT		667		667		667		S.Y.	
340230	RD	COMMERCIAL DEPRESSIONED CURB		1760		1760		1760		SQ.FT.	
334907	RD	A.C. DRIVEWAY (2'x6")		1		1		1		EA.	
200300	RD	REMOVE TREE (4"-10")		1		1		1		EA.	
34004	RD	CONCRETE 2" TYPE CURB & GUTTER (24" WIDE)		733		733		733		L.F.	
340326	RD	ALLEY GUTTER		174		174		174		SQ.FT.	
400222	RD	STREET LIGHT INSTALLATION		5		5		5		EA.	
52500	RD	ADJUST SANITARY SEWER MANHOLES		2		2		2		EA.	

CONTRACT
DRAWING
MAY 3 1974

NO.	A	BCR	L	T	PLR
2154					
53					
52					

CURVE DATA
BENCH MARK
STATIONS 16+00 TO 19+00 - SEE SHEET - 12
STATIONS 19+00 TO 21+00 - SEE SHEET - 14

REV.	DATE	DESCRIPTION	APPD.

DELTA
ENGINEERING INC.

4239 W. SAHARA AVE.
LAS VEGAS, NEV. 89102
PHONE: (702) 876-0330

VALLEY VIEW BLVD.
SPRING MOUNTAIN RD. TO CHARLESTON BLVD.
"B" STA. 16+00 TO 21+00

H. SCALE: 1"=20'	V. SCALE: 1"=2'	DES. D.P.	DWG. NO. 107-V926
W.O. NO. 71102	CHK'D.	DWN. M.M.	FILE NO.
APPROVED	DATE: 5-3-74	SHEET 13	OF 45