


PLAN
 HORIZONTAL CONTROL
 POINTS
 1. 2. 

PROFILE
 VERTICAL CONTROL
 POINTS
 1. 2. 

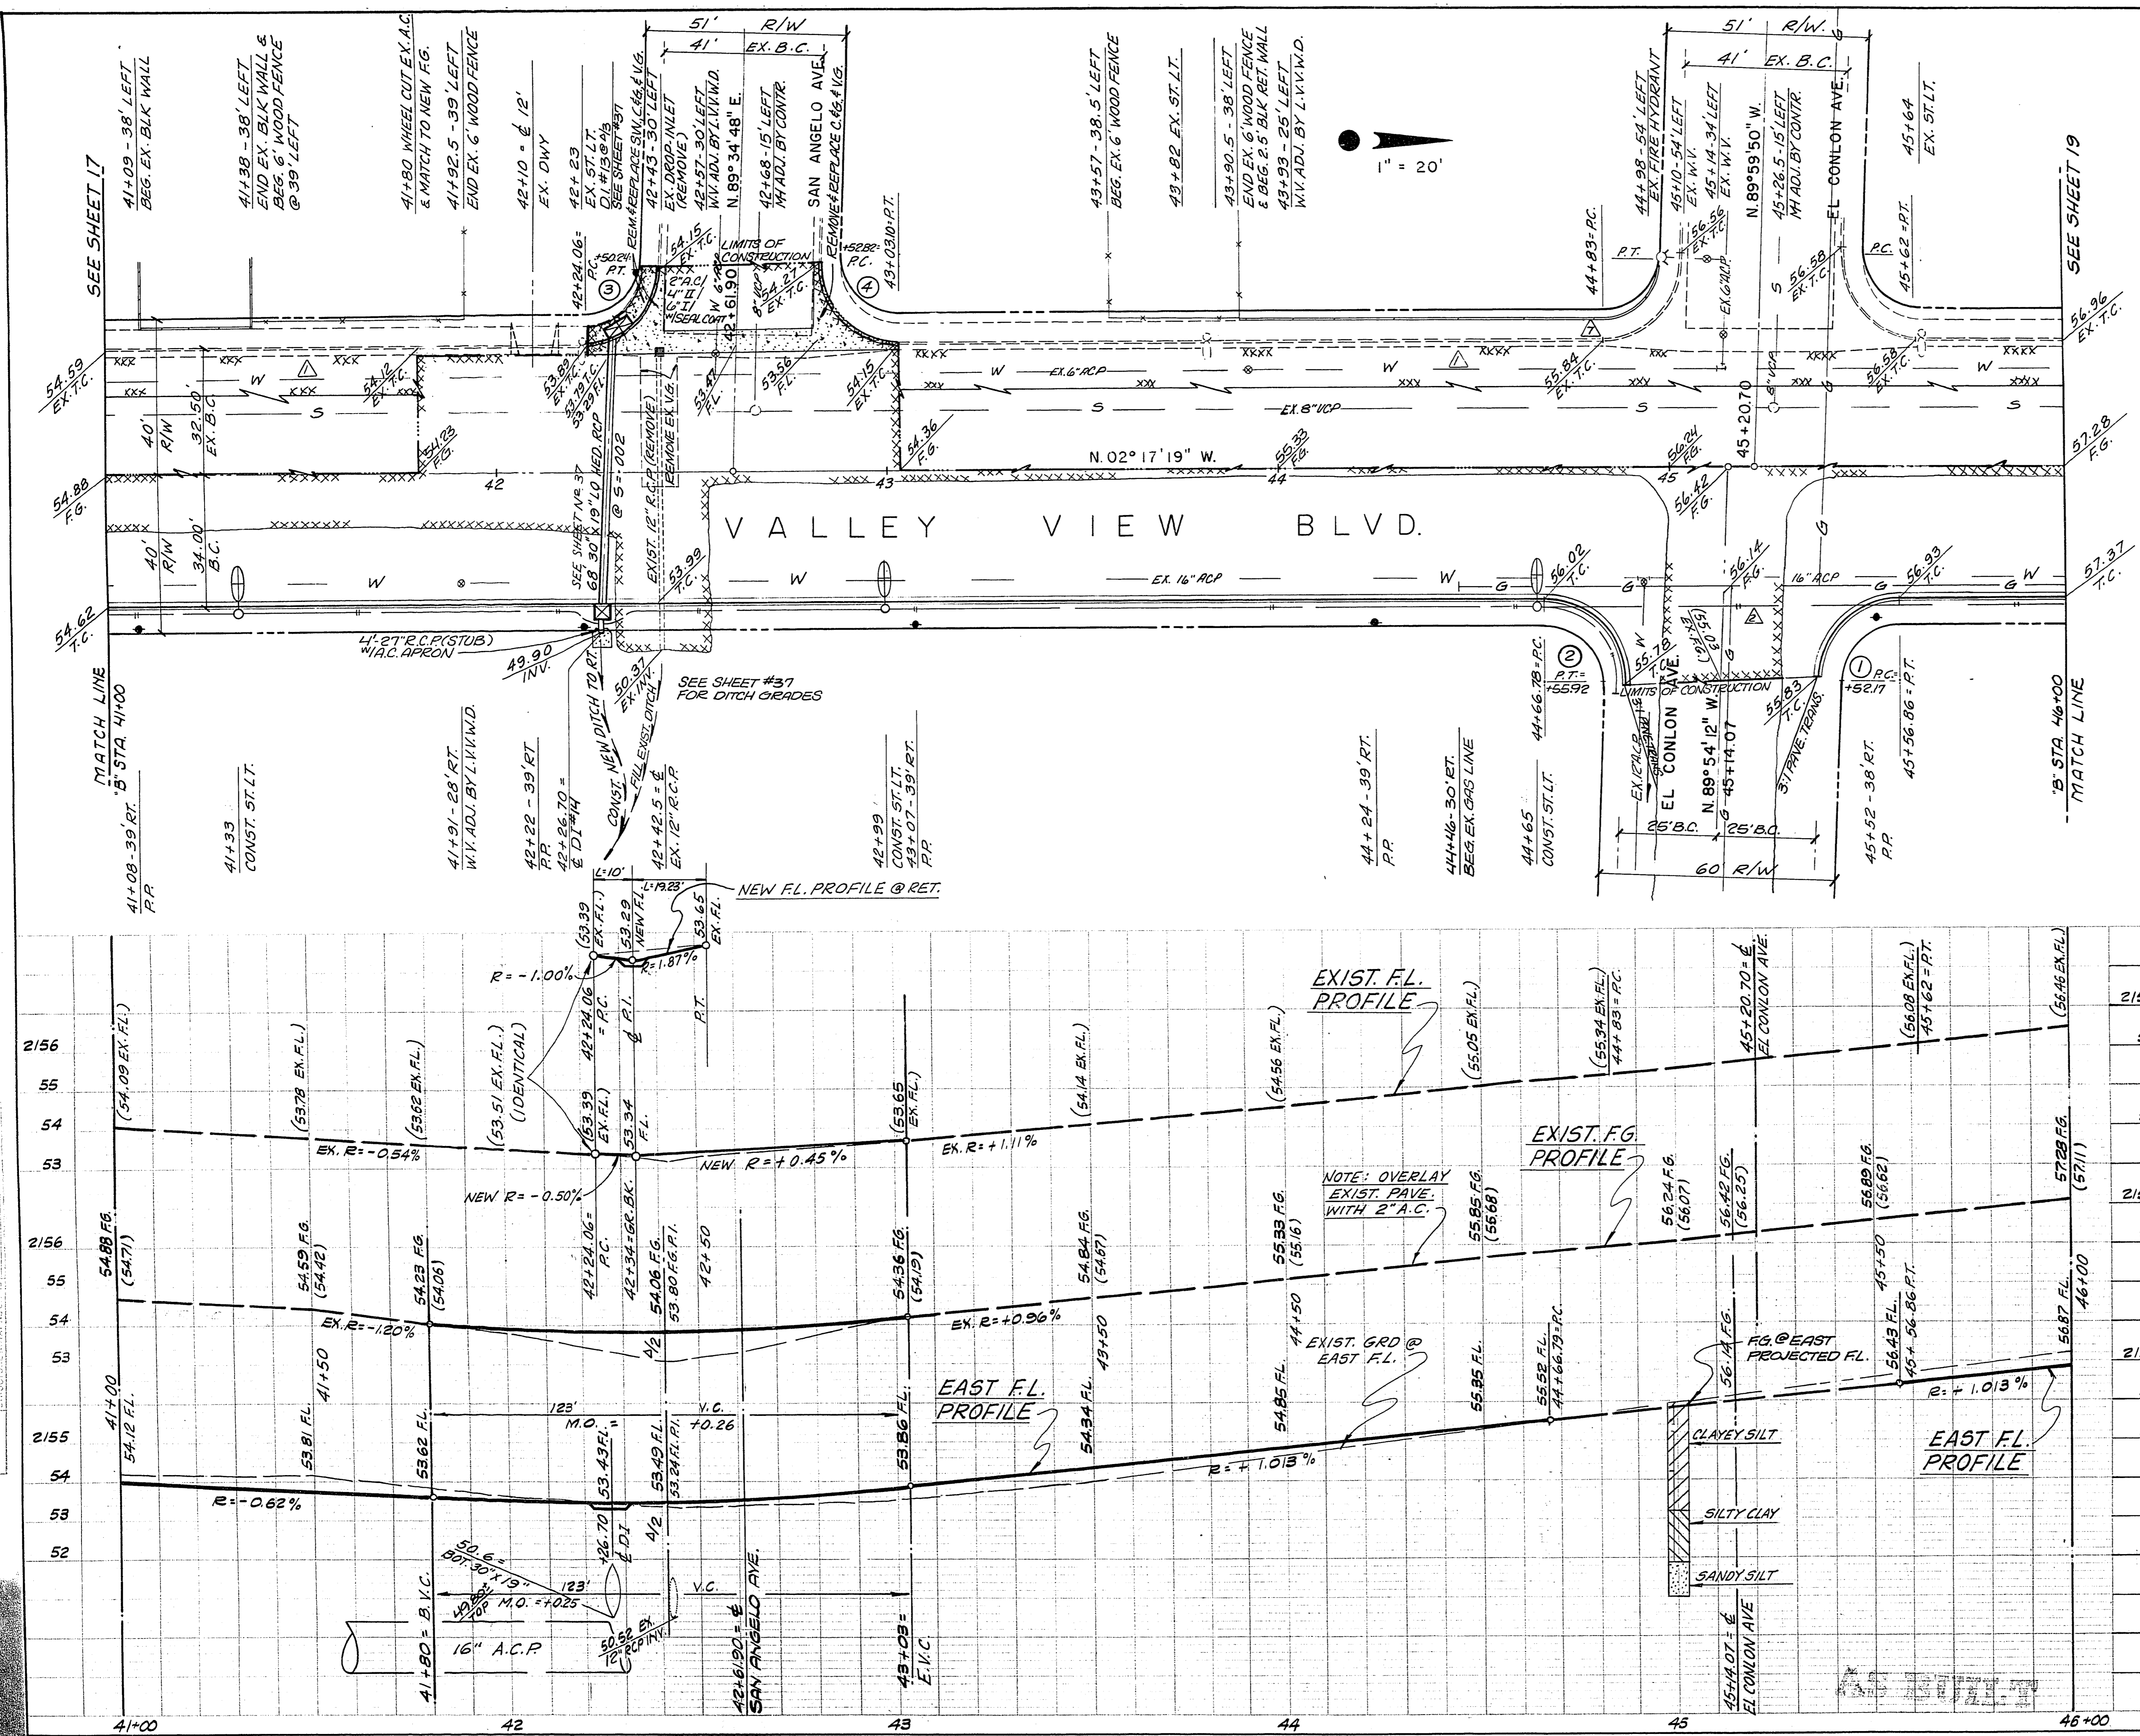

| ITEM | DESCRIPTION | APPROXIMATE QUANTITY ESTIMATE | UNIT |
|---------|---|-------------------------------|--------|
| 201.100 | ROADWAY EXCAVATION | 679 | C.Y. |
| 302.000 | TYPE I GRAVEL BASE | 143 | C.Y. |
| 302.200 | TYPE II GRAVEL BASE | 86 | C.Y. |
| 331.000 | ASPHALT CONCRETE PAVEMENT OVERLAY | 172 | TON |
| 334.000 | ASPHALT CONCRETE PAVEMENT - 5" | 574 | TON |
| 338.500 | 1/2" PLANT MIX BITUMINOUS OPEN-GRADED SURFACE | 473 | TON |
| 340.010 | CONCRETE "I" TYPE CURB & GUTTER (24" WIDE) | 125 | SR.FT. |
| 340.010 | VALLEY GUTTER | 125 | SR.FT. |
| 200.110 | CONCRETE REMOVAL | 125 | SR.FT. |
| 334.004 | ASPHALT CONCRETE PAVEMENT - 2" | 8 | TON |
| 334.800 | BITUMINOUS PRIME COAT | 105 | TON |
| 512.500 | ADJUST SANITARY SEWER MANHOLE | 2 | EA. |
| 400.222 | STREET LIGHT | 3 | EA. |

CONTACT DRAWING MAY 3 1974

| NO. | ELEV. | DESCRIPTION |
|-----|-------|---|
| 7 | 55.85 | C.L.V. BM. #167A13 - SW COR. EL CONLON INT. |

REVISIONS

| REV. | DATE | DESCRIPTION | APP'D. |
|------|---------|-----------------------------------|--------|
| 55 | 5-16-74 | OMIT HEATER REMIX - ADD PAVE. GR. | CP |
| 54 | 5-16-74 | ADDED ST. LT. CONDUIT | CP |

DELTA ENGINEERING INC.
 4239 W. SAHARA AVE.
 LAS VEGAS, NEV. 89102
 PHONE: (702) 876-0330

VALLEY VIEW BLVD.
 SPRING MOUNTAIN RD. TO CHARLESTON BLVD.
 "B" STA. 41+00 TO 46+00

H. SCALE: 1"=20' V. SCALE: 1"=2'
 W.O. NO. 71102 CHKD. DWN. E.C. FILE NO. 107-V926
 DATE: 5-3-74 SHEET 18 OF 45