


PLAN
 COURTESY
 NOTE BOOK
 DATE
 DRAWN BY
 CHECKED BY
 DATE

PROFILE
 DATE
 DRAWN BY
 CHECKED BY
 DATE

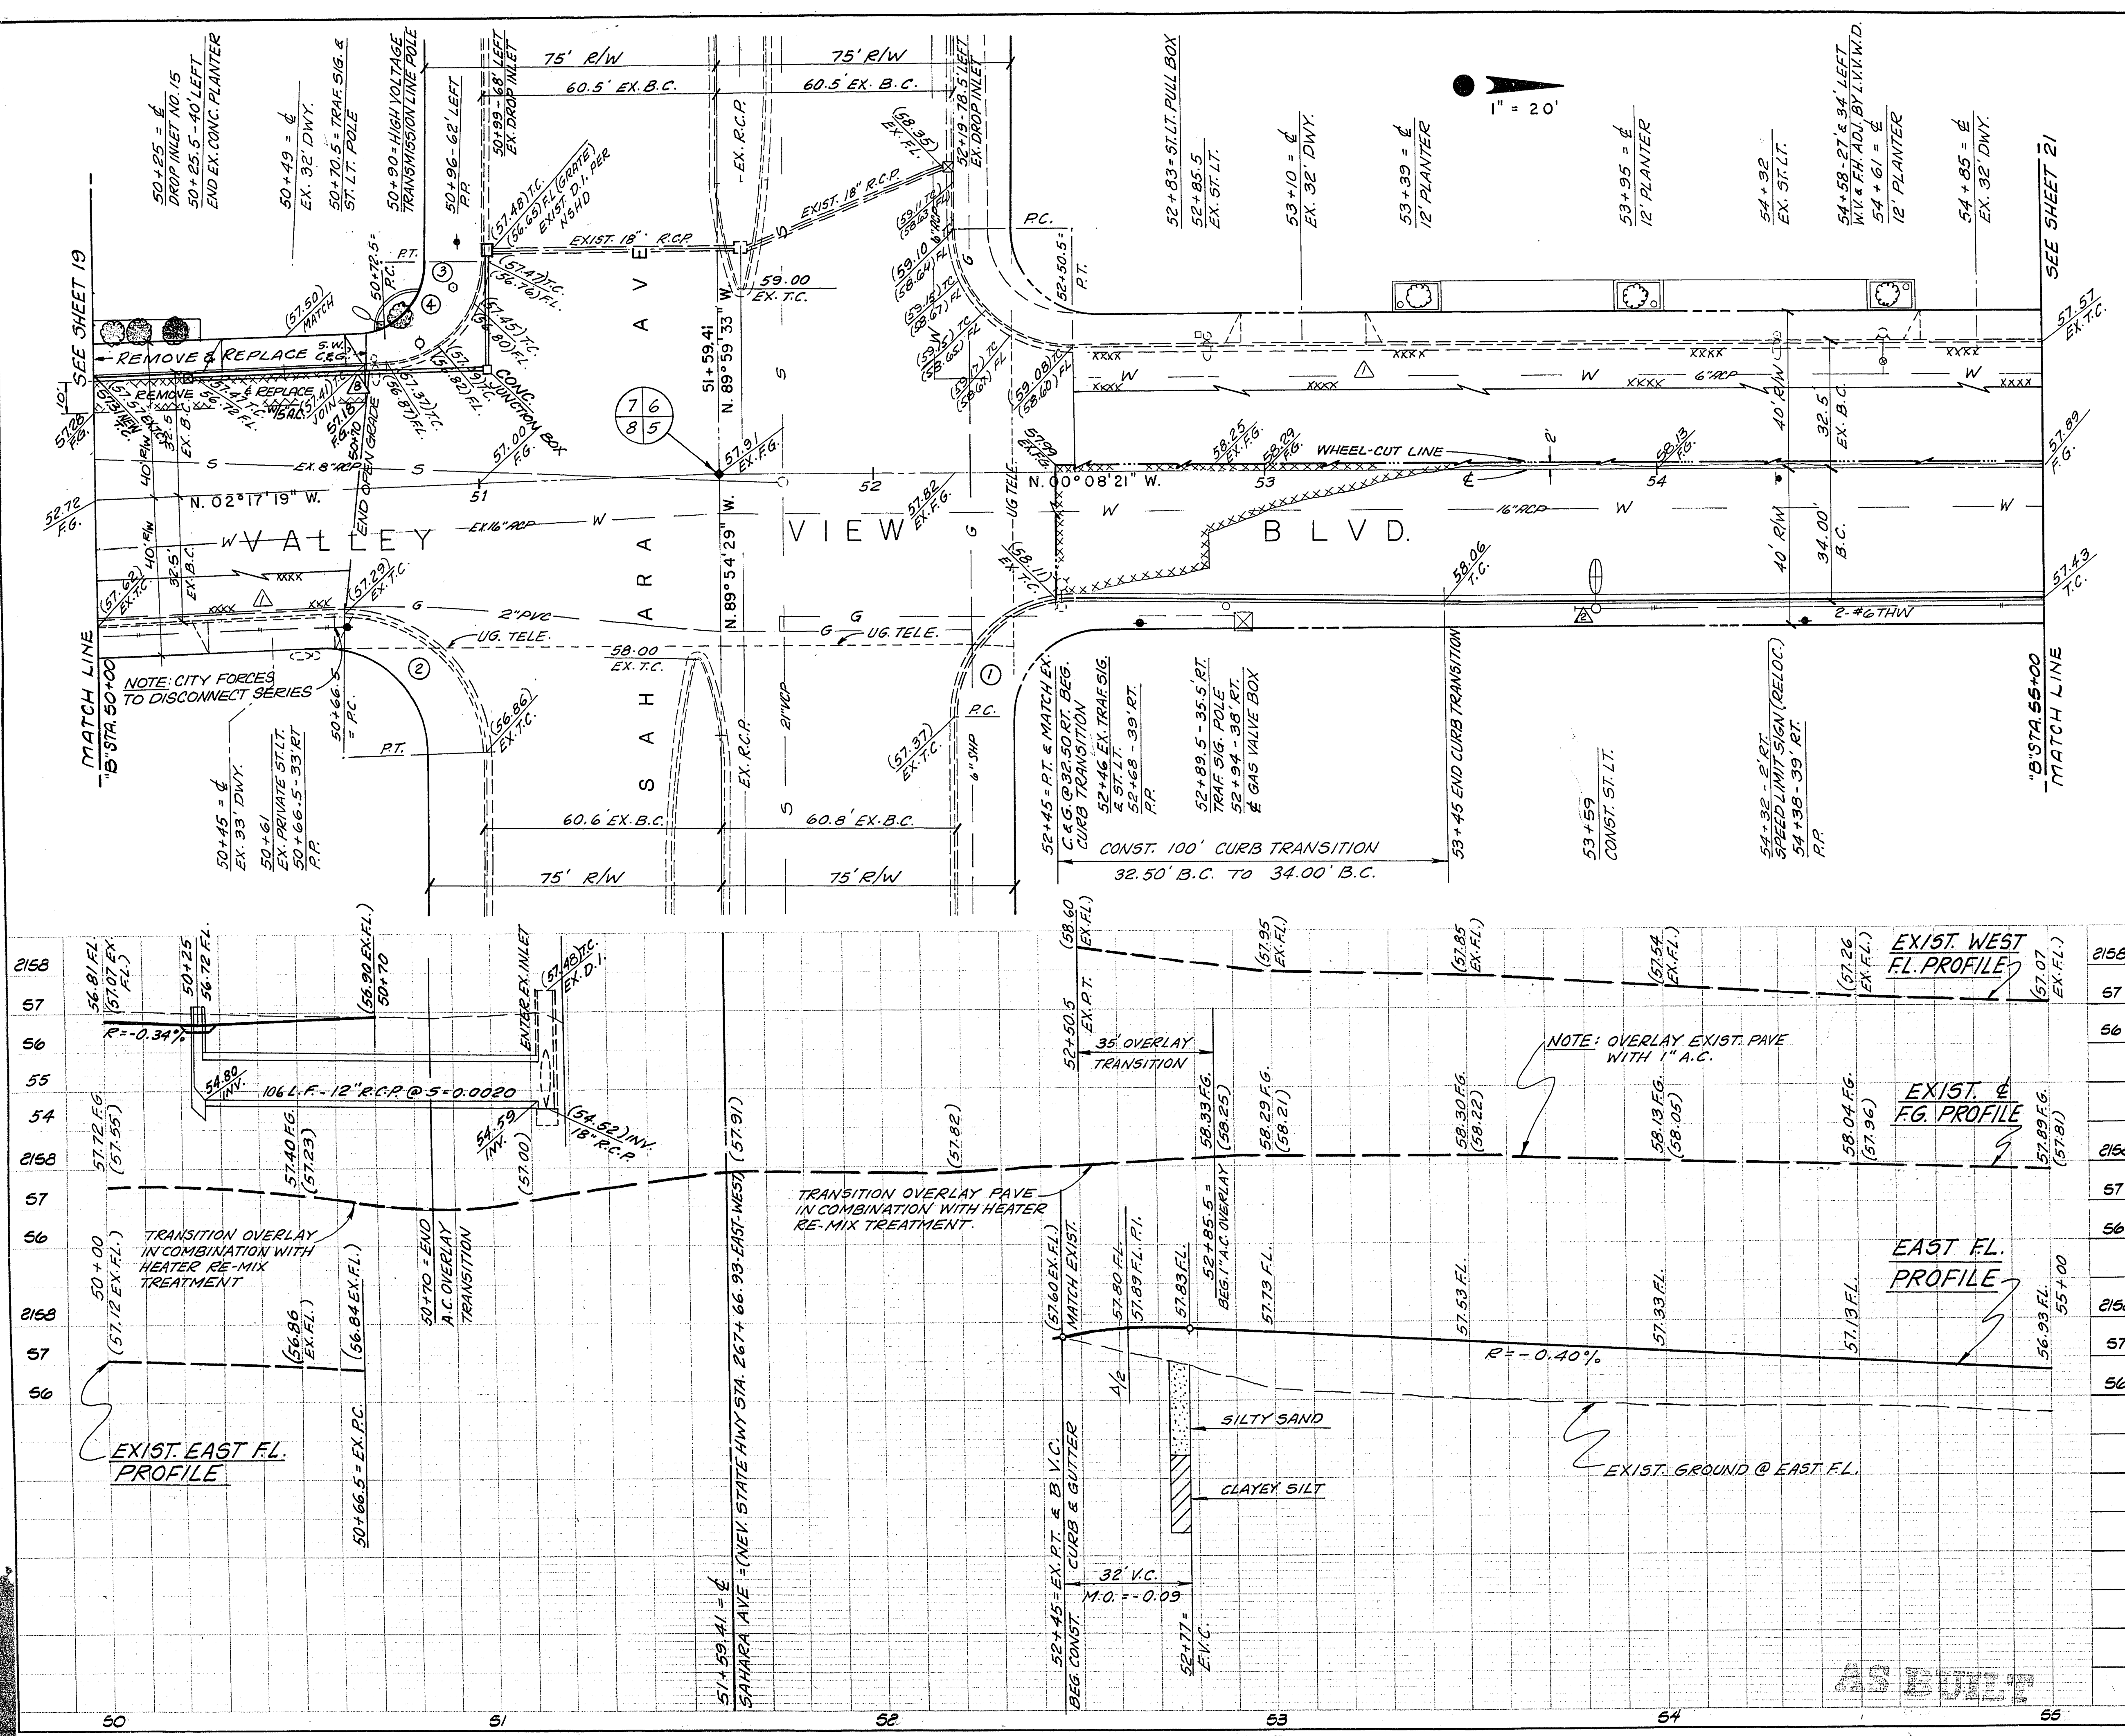

ITEM	DESCRIPTION	APPROXIMATE QUANTITY	ESTIMATE	CLV	RSH	CLV	CLV-SID	TOTAL	UNIT
201100	ROADWAY EXCAVATION	80						80	C.Y.
302200	TYPE II GRAVEL BASE	114					47	161	C.Y.
331002	ASPHALT CONCRETE PAVEMENT 1" OVERLAY	53					51	59	TON
331004	ASPHALT CONCRETE PAVEMENT 2" OVERLAY	230					227	281	TON
334008	ASPHALT CONCRETE PAVEMENT 4"	1970					57	2197	S.Y.
331000	1/2" OPENGRADE PLANT MIX	274					255	331	QAL.
330004	CONCRETE 12" TYPE CURB & GUTTER (24" WIDE)	20					200	270	S.F.
330004	CONCRETE SIDEWALK	270					602	602	S.F.
340226	COMMERCIAL DRIVEWAY	602					1	1	E.A.
400222	STREET LIGHT	40					40	40	TON
330100	ASPHALT CONCRETE PAVEMENT-5"	40					40	40	L.F.
340236	COMMERCIAL DEPRESSED CURB								

CONTRACT DRAWING
 MAY 3 1974

* 12" R.C.P. STORM DRAIN

NO.	Δ	BCR	L	T	PLR
2158	4	60°00'00"	50.00'	52.36'	28.87'
57	2	92°22'50"	36.00'	58.04'	
56	1	80°00'00"	30.00'	41.83'	

CURVE DATA
 BENCH MARK

NO.	ELEV.	DESCRIPTION
2158	8 57.41	CLV. BM. # 1617A1 - SW COR. SAHARA INT.

REVISIONS

REV.	DATE	DESCRIPTION	APP'D.
Δ	5-16-74	OMIT HEATER REMIX - ADD PAVE. CRIB AT STA. 51+74	CRIB
Δ	5-16-74	ST. LT. LOCATION	CRIB

DELTA ENGINEERING INC.
 4239 W. SAHARA AVE.
 LAS VEGAS, NEV. 89102
 PHONE: (702) 876-0330

VALLEY VIEW BLVD.
 SPRING MOUNTAIN RD. TO CHARLESTON BLVD.
 "B" STA. 50+00 TO 55+00

H. SCALE: 1"=20' V. SCALE: 1"=2'
 DES. DR. DWG. NO. 107-V926
 W.O. NO. 711102 CHKD. OWN. E.C. FILE NO.
 APPROVED DATE: 5-3-74 SHEET 20 OF 45

21-4254