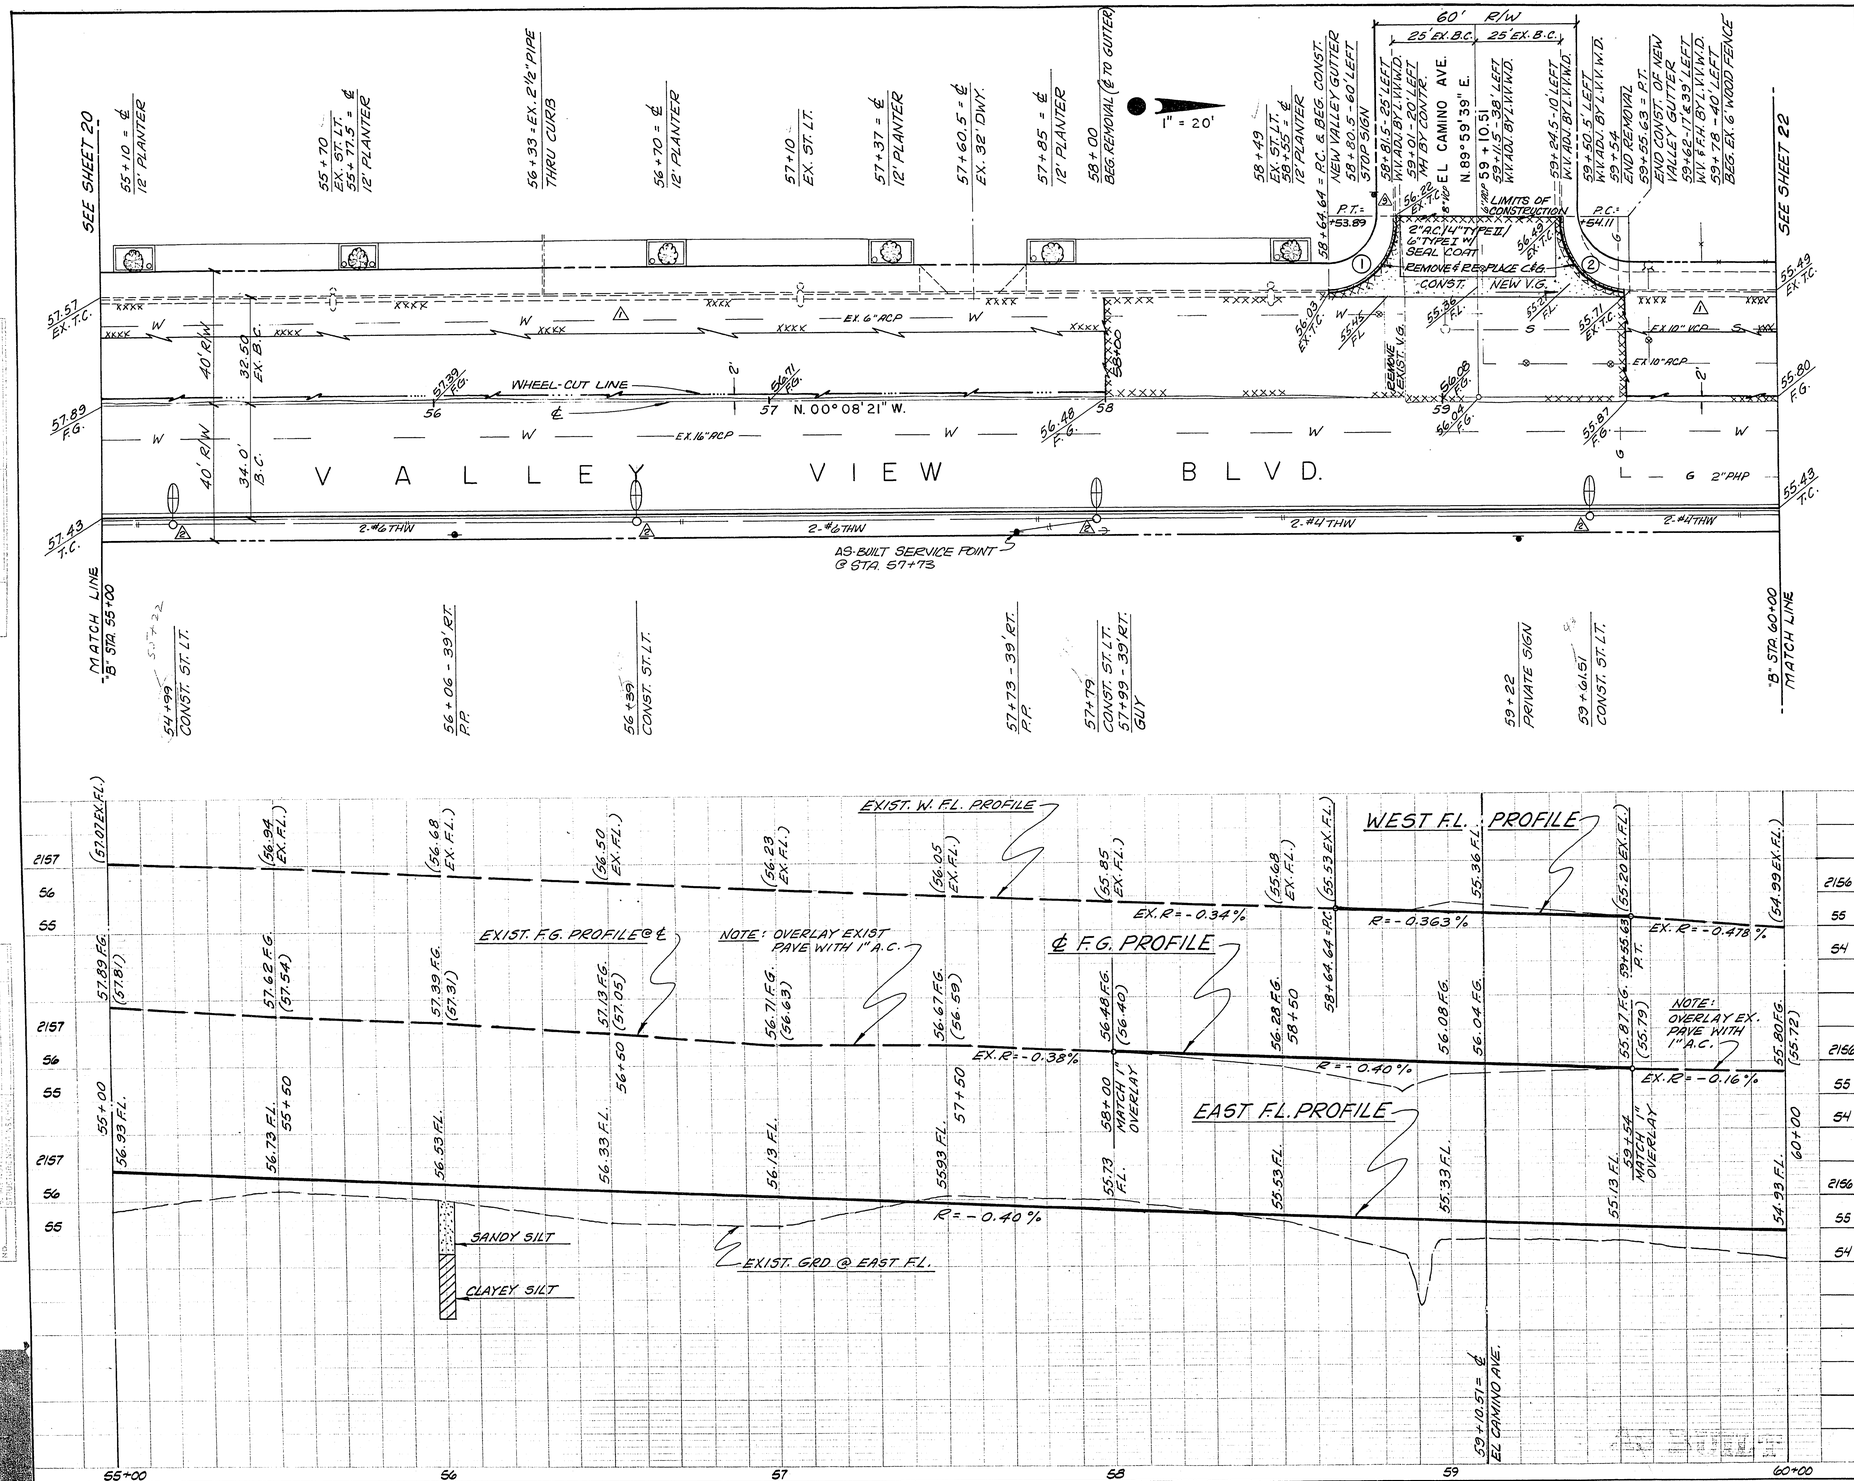

APPROXIMATE QUANTITY ESTIMATE

ITEM	DESCRIPTION	R.S.H.	CLV	CLV-SID	TOTAL	UNIT
201.100	ROADWAY EXCAVATION	85			85	C.Y.
302.100	TYPE I GRAVEL BASE	34			34	C.Y.
302.200	TYPE II GRAVEL BASE	316		96	412	C.Y.
331.002	ASPHALT CONCRETE PAVEMENT - OVERLAY	62			62	TON
331.008	ASPHALT CONCRETE PAVEMENT - 4"	535		105	640	TON
333.500	1/2" PLANTMIX BITUMINOUS OPEN-GRADED SURFACE	3108		457	3565	S.Y.
340.014	CONCRETE "L" TYPE CURB & GUTTER (24" WIDE)	64		500	564	LIN.FT.
341.319	VALLEY GUTTER	600			600	SQ.FT.
341.600	BITUMINOUS PRIME COAT	594		117	711	GAL.
200.110	CONCRETE REMOVAL	488			488	SQ.FT.
512.500	ADJUST SANITARY SEWER MANHOLE		1		1	EA.
331.004	ASPHALT CONCRETE PAVEMENT - 2"	10			10	TON
400.222	STREET LIGHT			4	4	EA.

CONTRACT DRAWING
MAY 3 1974

CURVE DATA

NO.	Δ	BCR	L	T	PLR
2.	90° 08' 00"	20.00'	31.46'	20.05'	15.00'
1.	89° 52' 00"	21.00'	32.94'	20.95'	15.00'

BENCH MARK

NO.	ELEV.	DESCRIPTION
9	56.22	C.L.V. BM. #1616D15 - SW COR. EL CAMINO INT.

REVISIONS

REV.	DATE	DESCRIPTION	APP'D
1	5-16-74	OMIT HEATER REMIX - ADD PAVE CONT.	5/17/74
2	5-16-74	ST. LT. LOCATION	

DELTA ENGINEERING INC.
4239 W. SAHARA AVE.
LAS VEGAS, NEV. 89102
PHONE: (702) 876-0330

VALLEY VIEW BLVD.

SPRING MOUNTAIN RD. TO CHARLESTON BLVD.

"B" STA. 55+00 TO 60+00

H. SCALE: 1"=20'	V. SCALE: 1"=2'	DES. D.P.	DWG. NO. 107-V926
W.O. NO. 71102	CHK'D.	DWN. E.C.	FILE NO.
APPROVED		DATE 5-3-74	SHEET 21 OF 45

PLATE 1, PLAN-PROFILE
KEUFFEL & ESSER CO.
46 7010 ARKWRIGHT TRACING CLOTH
MADE IN U.S.A.

21-4-75