


PLAN  
 CONTRACT NO. 107-V926  
 SHEET NO. 22 OF 45  
 DATE 5-3-74

PROFILE  
 CONTRACT NO. 107-V926  
 SHEET NO. 22 OF 45  
 DATE 5-3-74

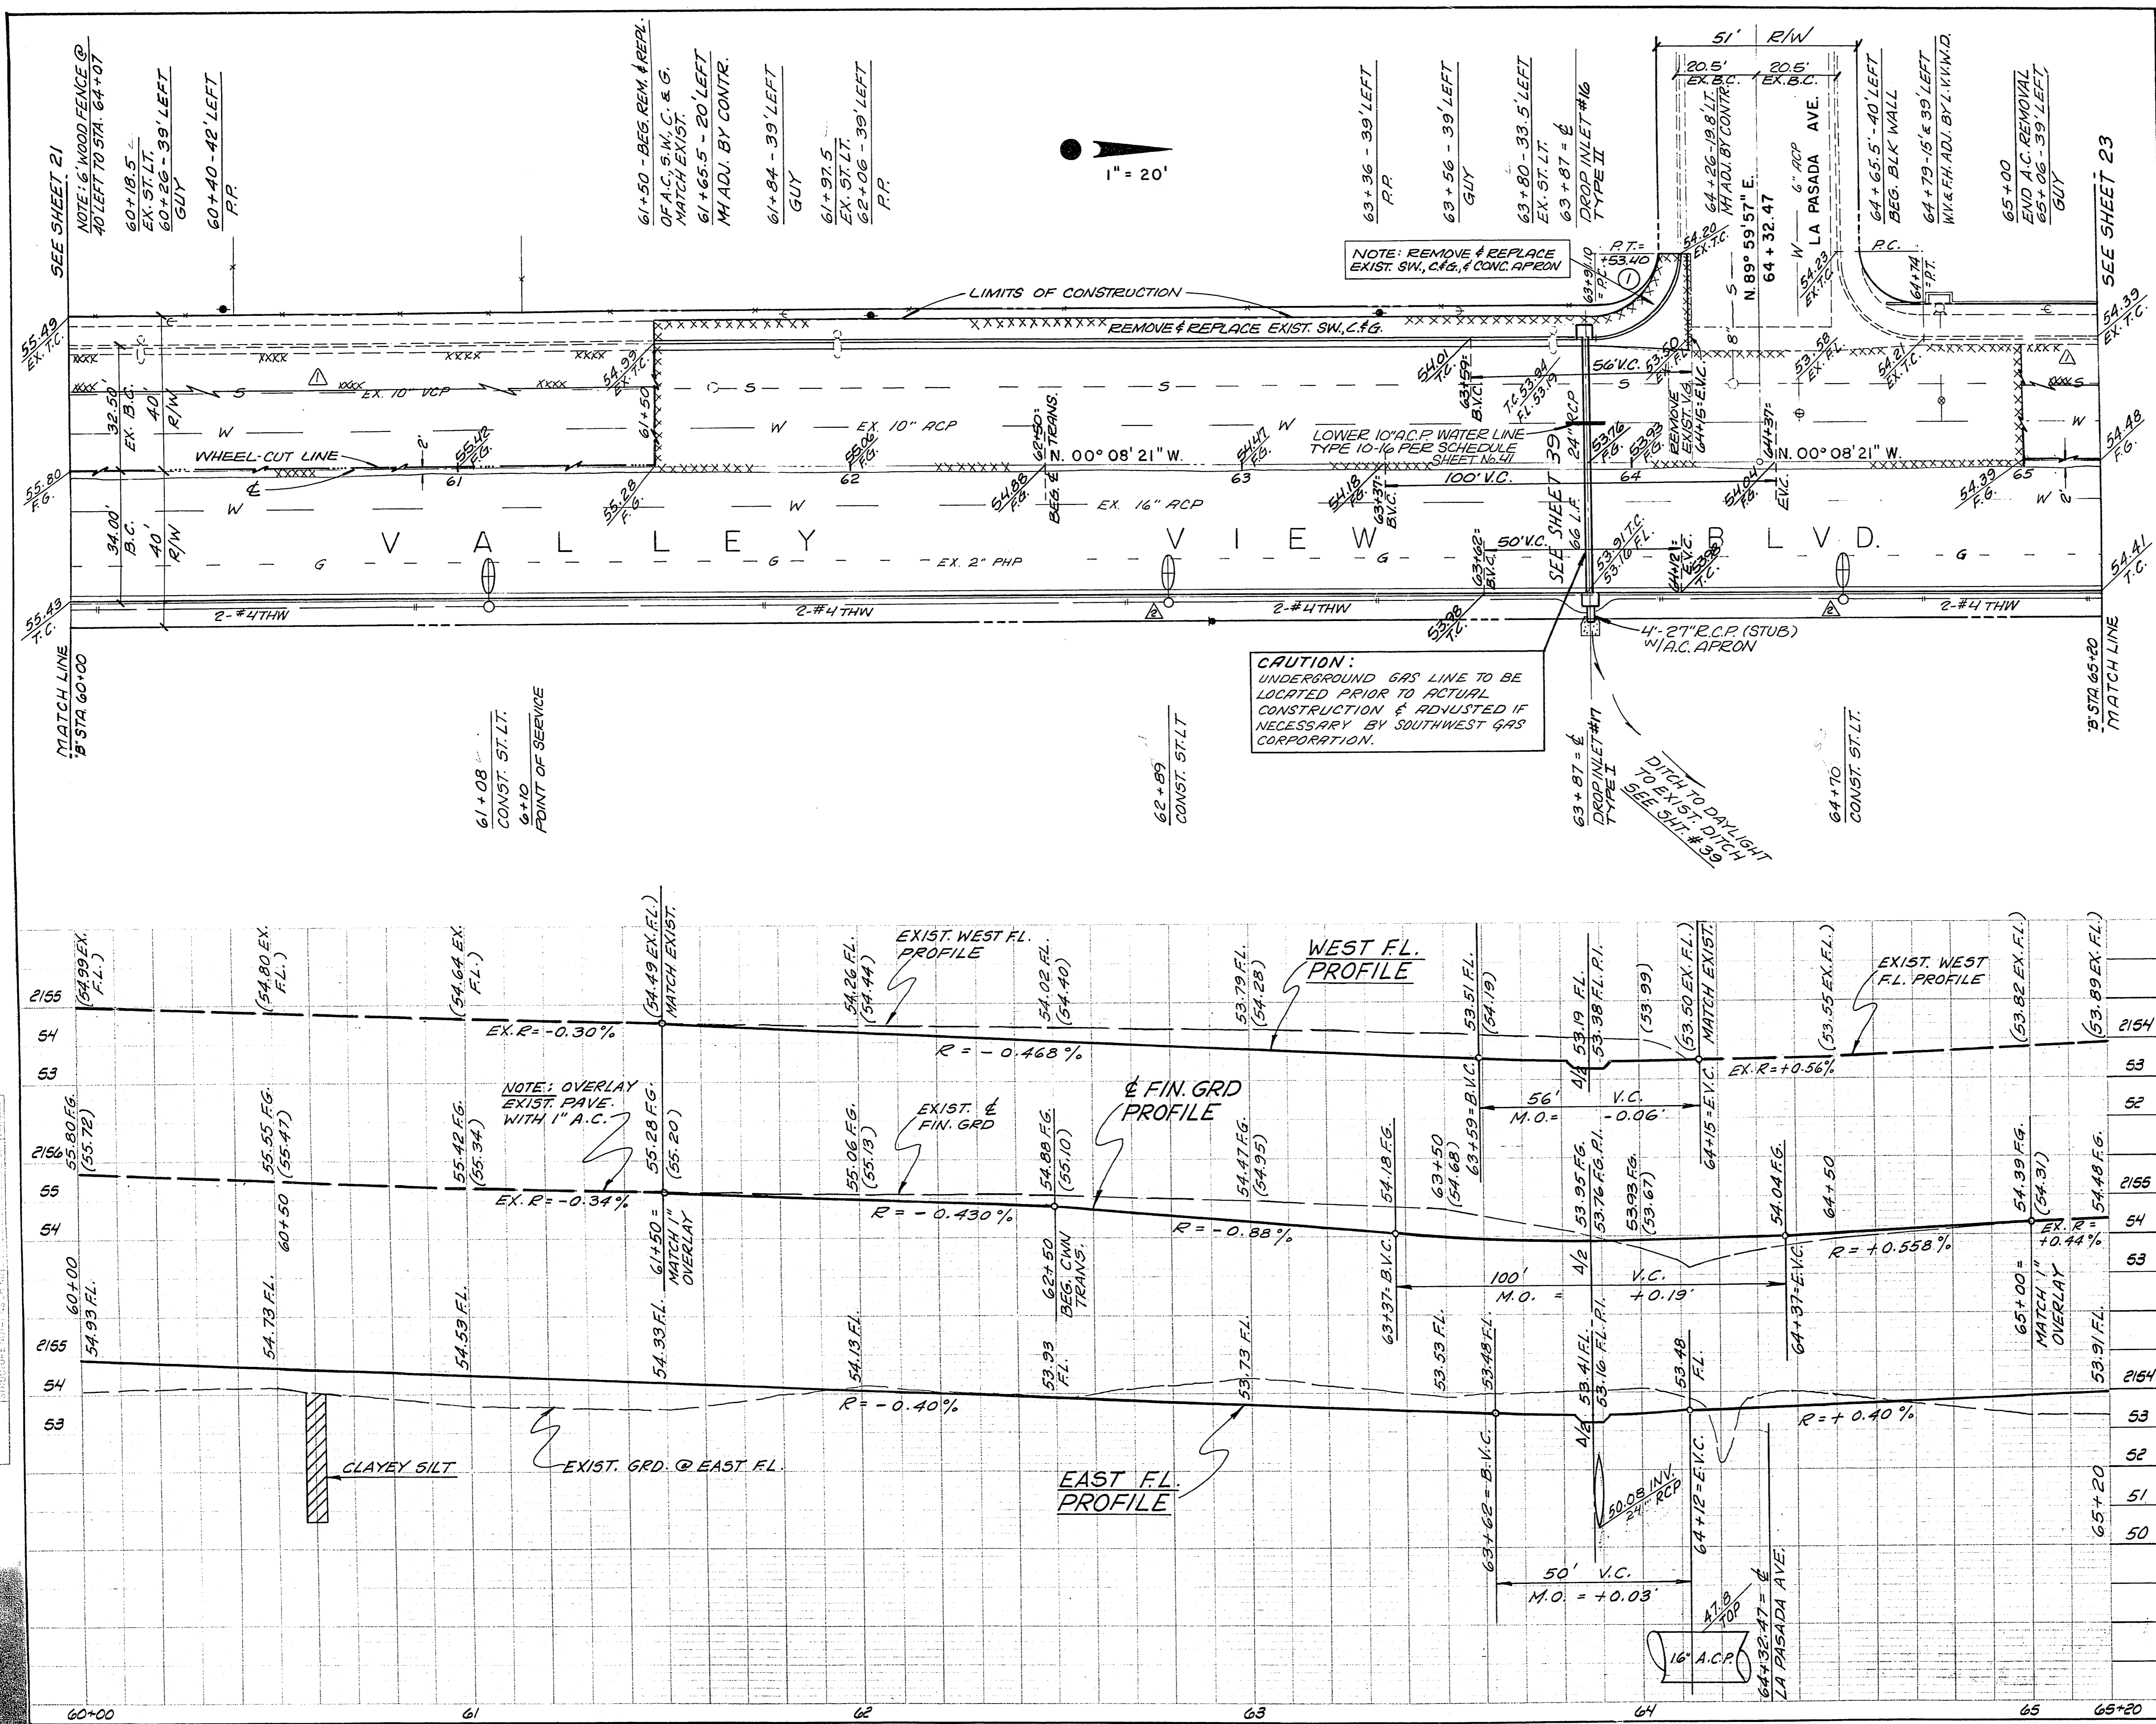

**CAUTION:**  
 UNDERGROUND GAS LINE TO BE  
 LOCATED PRIOR TO ACTUAL  
 CONSTRUCTION & ADJUSTED IF  
 NECESSARY BY SOUTHWEST GAS  
 CORPORATION.

NOTE: REMOVE & REPLACE  
 EXIST. SW, C.F.G. & CONC. APRON

ITEM	DESCRIPTION	QUANTITY	ESTIMATE
201.00	ROADWAY EXCAVATION	746	R.S.H.
302.00	TYPE I GRAVEL BASE	146	C.Y.
302.20	TYPE II GRAVEL BASE	101	C.Y.
331.00	ASPHALT CONCRETE PAVEMENT 1" OVERLAY	552	TON
333.00	ASPHALT CONCRETE PAVEMENT 4"	104	TON
342.00	1/2" PLANT MIX BITUMINOUS OPEN-GRADED SURFACE	462	SQ. FT.
342.00	CONCRETE 1" TYPE CURB & GUTTER (24" WIDE)	520	SQ. FT.
342.00	CONCRETE SIDEWALK	1330	SQ. FT.
342.00	VALLEY GUTTER	200	SQ. FT.
342.00	BITUMINOUS PRIME COAT	806	SQ. FT.
200.10	CONCRETE REMOVAL	2078	SQ. FT.
500.00	LOWER 10" RCP WATER LINE TYPE 10-16	1	EA.
512.500	ADJUST SANITARY SEWER MANHOLE	2	EA.
400.222	STREET LIGHT	3	EA.

REV.	DATE	DESCRIPTION	APP'D.
53	5-16-74	OMIT HEATER REMIX - ADD PAVE COAT	CE
52	5-16-74	ST. LT. LOCATION	CE

NO.	Δ	BCR	L	T	PLR
1	89° 51' 42"	21.00'	32.94'	20.95'	15.00'

REV.	DATE	DESCRIPTION	APP'D.
53	5-16-74	OMIT HEATER REMIX - ADD PAVE COAT	CE
52	5-16-74	ST. LT. LOCATION	CE

<b>DELTA</b>		4239 W. SAHARA AVE. LAS VEGAS, NEV. 89102 PHONE: (702) 876-0330	
<b>VALLEY VIEW BLVD.</b>			
SPRING MOUNTAIN RD. TO CHARLESTON BLVD.			
"B" STA. 60+00 TO 65+20			
H. SCALE: 1"=20'	V. SCALE: 1"=2'	DES. D.P.	DWG. NO. 107-V926
W.O. NO. 711102	CHK'D.	DWN. E.C.	FILE NO.
APPROVED	DATE 5-3-74	DATE	SHEET 22 OF 45

214.26