


PLAN

PROFILE

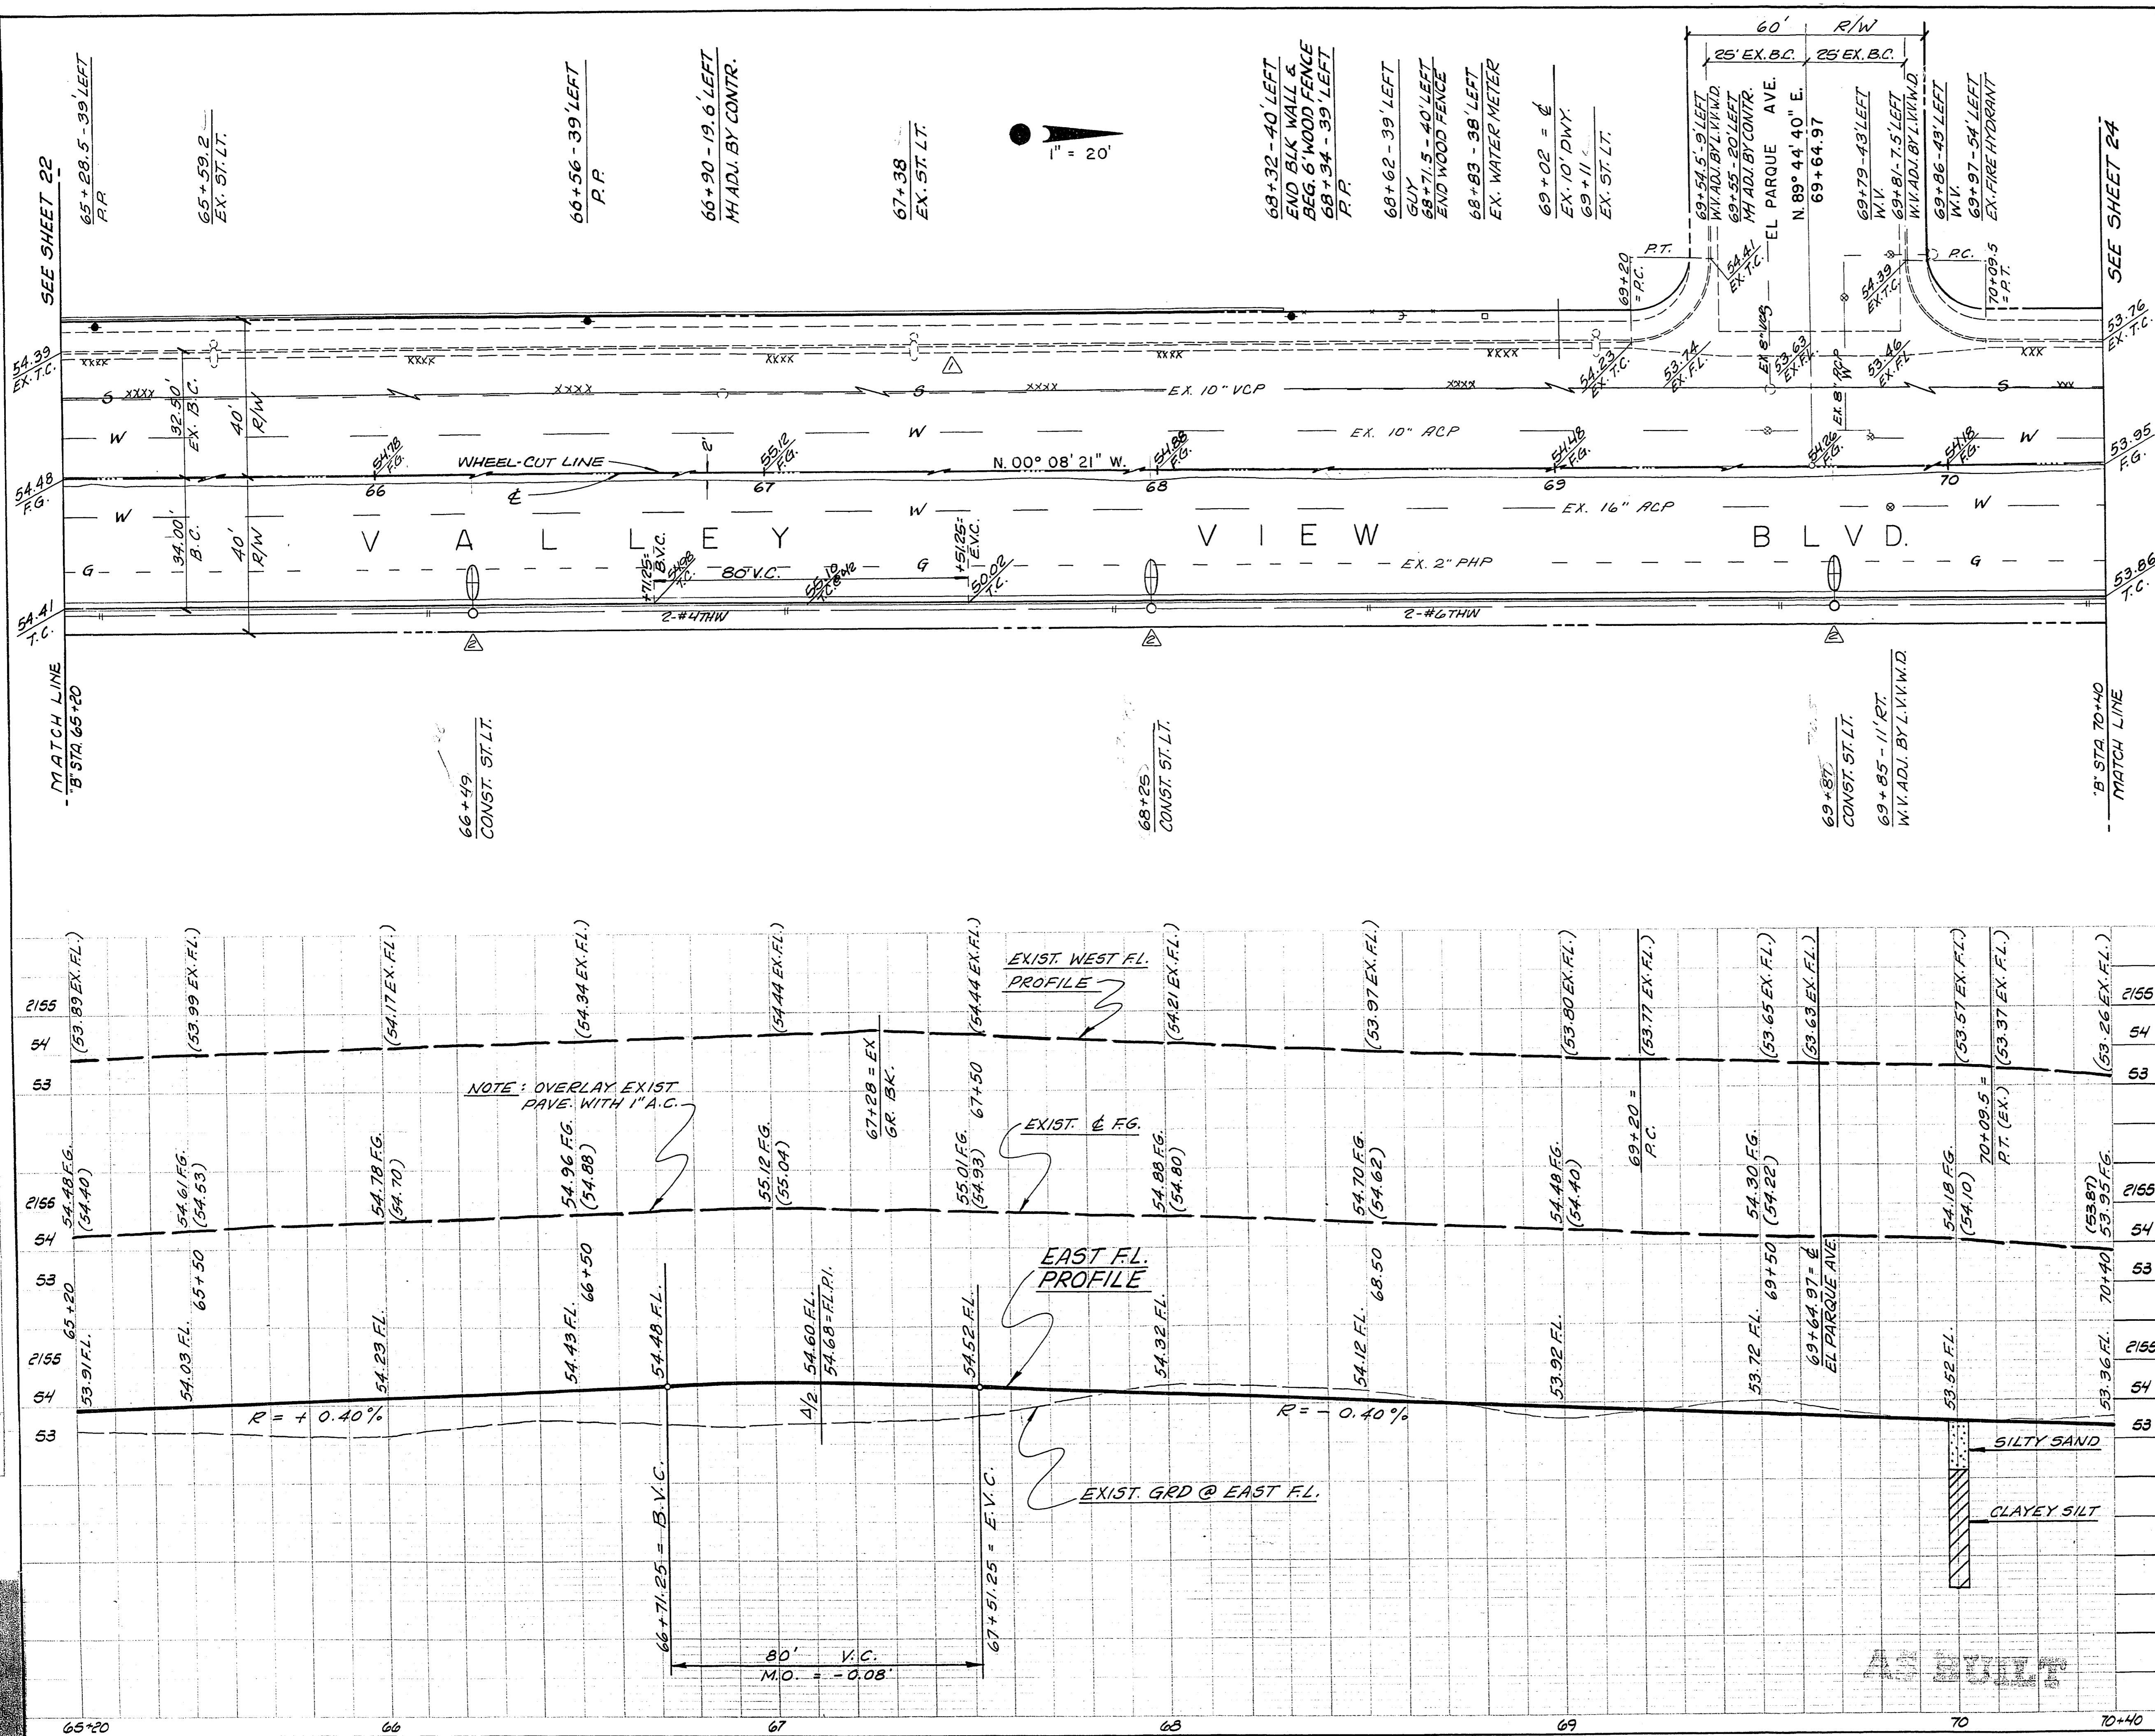

APPROXIMATE QUANTITY ESTIMATE		DESCRIPTION	R	S	H	CLV	CLV-SID	TOTAL	UNIT
201	100	ROADWAY EXCAVATION	120				96	120	C.Y.
302	200	TYPE II GRAVEL BASE	229				99	325	TON
331	000	ASPHALT CONCRETE PAVEMENT 1" OVERLAY	442				104	546	TON
333	000	ASPHALT CONCRETE PAVEMENT - 4"	3149				462	3611	S.Y.
340	004	12" PLANT MIX BITUMINOUS OPEN-GRADED SURFACE					520	520	LN.FT.
512	500	CONCRETE "L" TYPE CURB & GUTTER (24" WIDE)					116	607	EA.
514	500	ADJUST SANITARY SEWER MANHOLE					3	3	EA.
514	500	ADJUST SANITARY SEWER MANHOLE					3	3	EA.
400	222	BITUMINOUS PRIME COAT							
		STREET LIGHT							

CURVE DATA		BENCH MARK	
N.O.	ELEV.	DESCRIPTION	
10	53.86	CLV. BM. #1616D24 - NW COR. EL. PARQUE INT.	

REVISIONS		DATE	DESCRIPTION	APP'D.
5-16-74	OMIT HEATER REMIX - ADD PAVE.			
5-16-74	ST. LT. LOCATION			

DELTA ENGINEERING INC.
 4239 W. SAHARA AVE.
 LAS VEGAS, NEV. 89102
 PHONE: (702) 876-0330

VALLEY VIEW BLVD.
 SPRING MOUNTAIN RD. TO CHARLESTON BLVD.
 "B" STA. 65+20 TO 70+40

H. SCALE: 1"=20' V. SCALE: 1"=2'
 W.O. NO. 71102 CHK'D. DWN. E.C. FILE NO.
 DATE: 5-3-74 SHEET 23 OF 45

214-27