


NO.	DATE	BY	DESCRIPTION
1			AS SHOWN

NO.	DATE	BY	DESCRIPTION
1			AS SHOWN

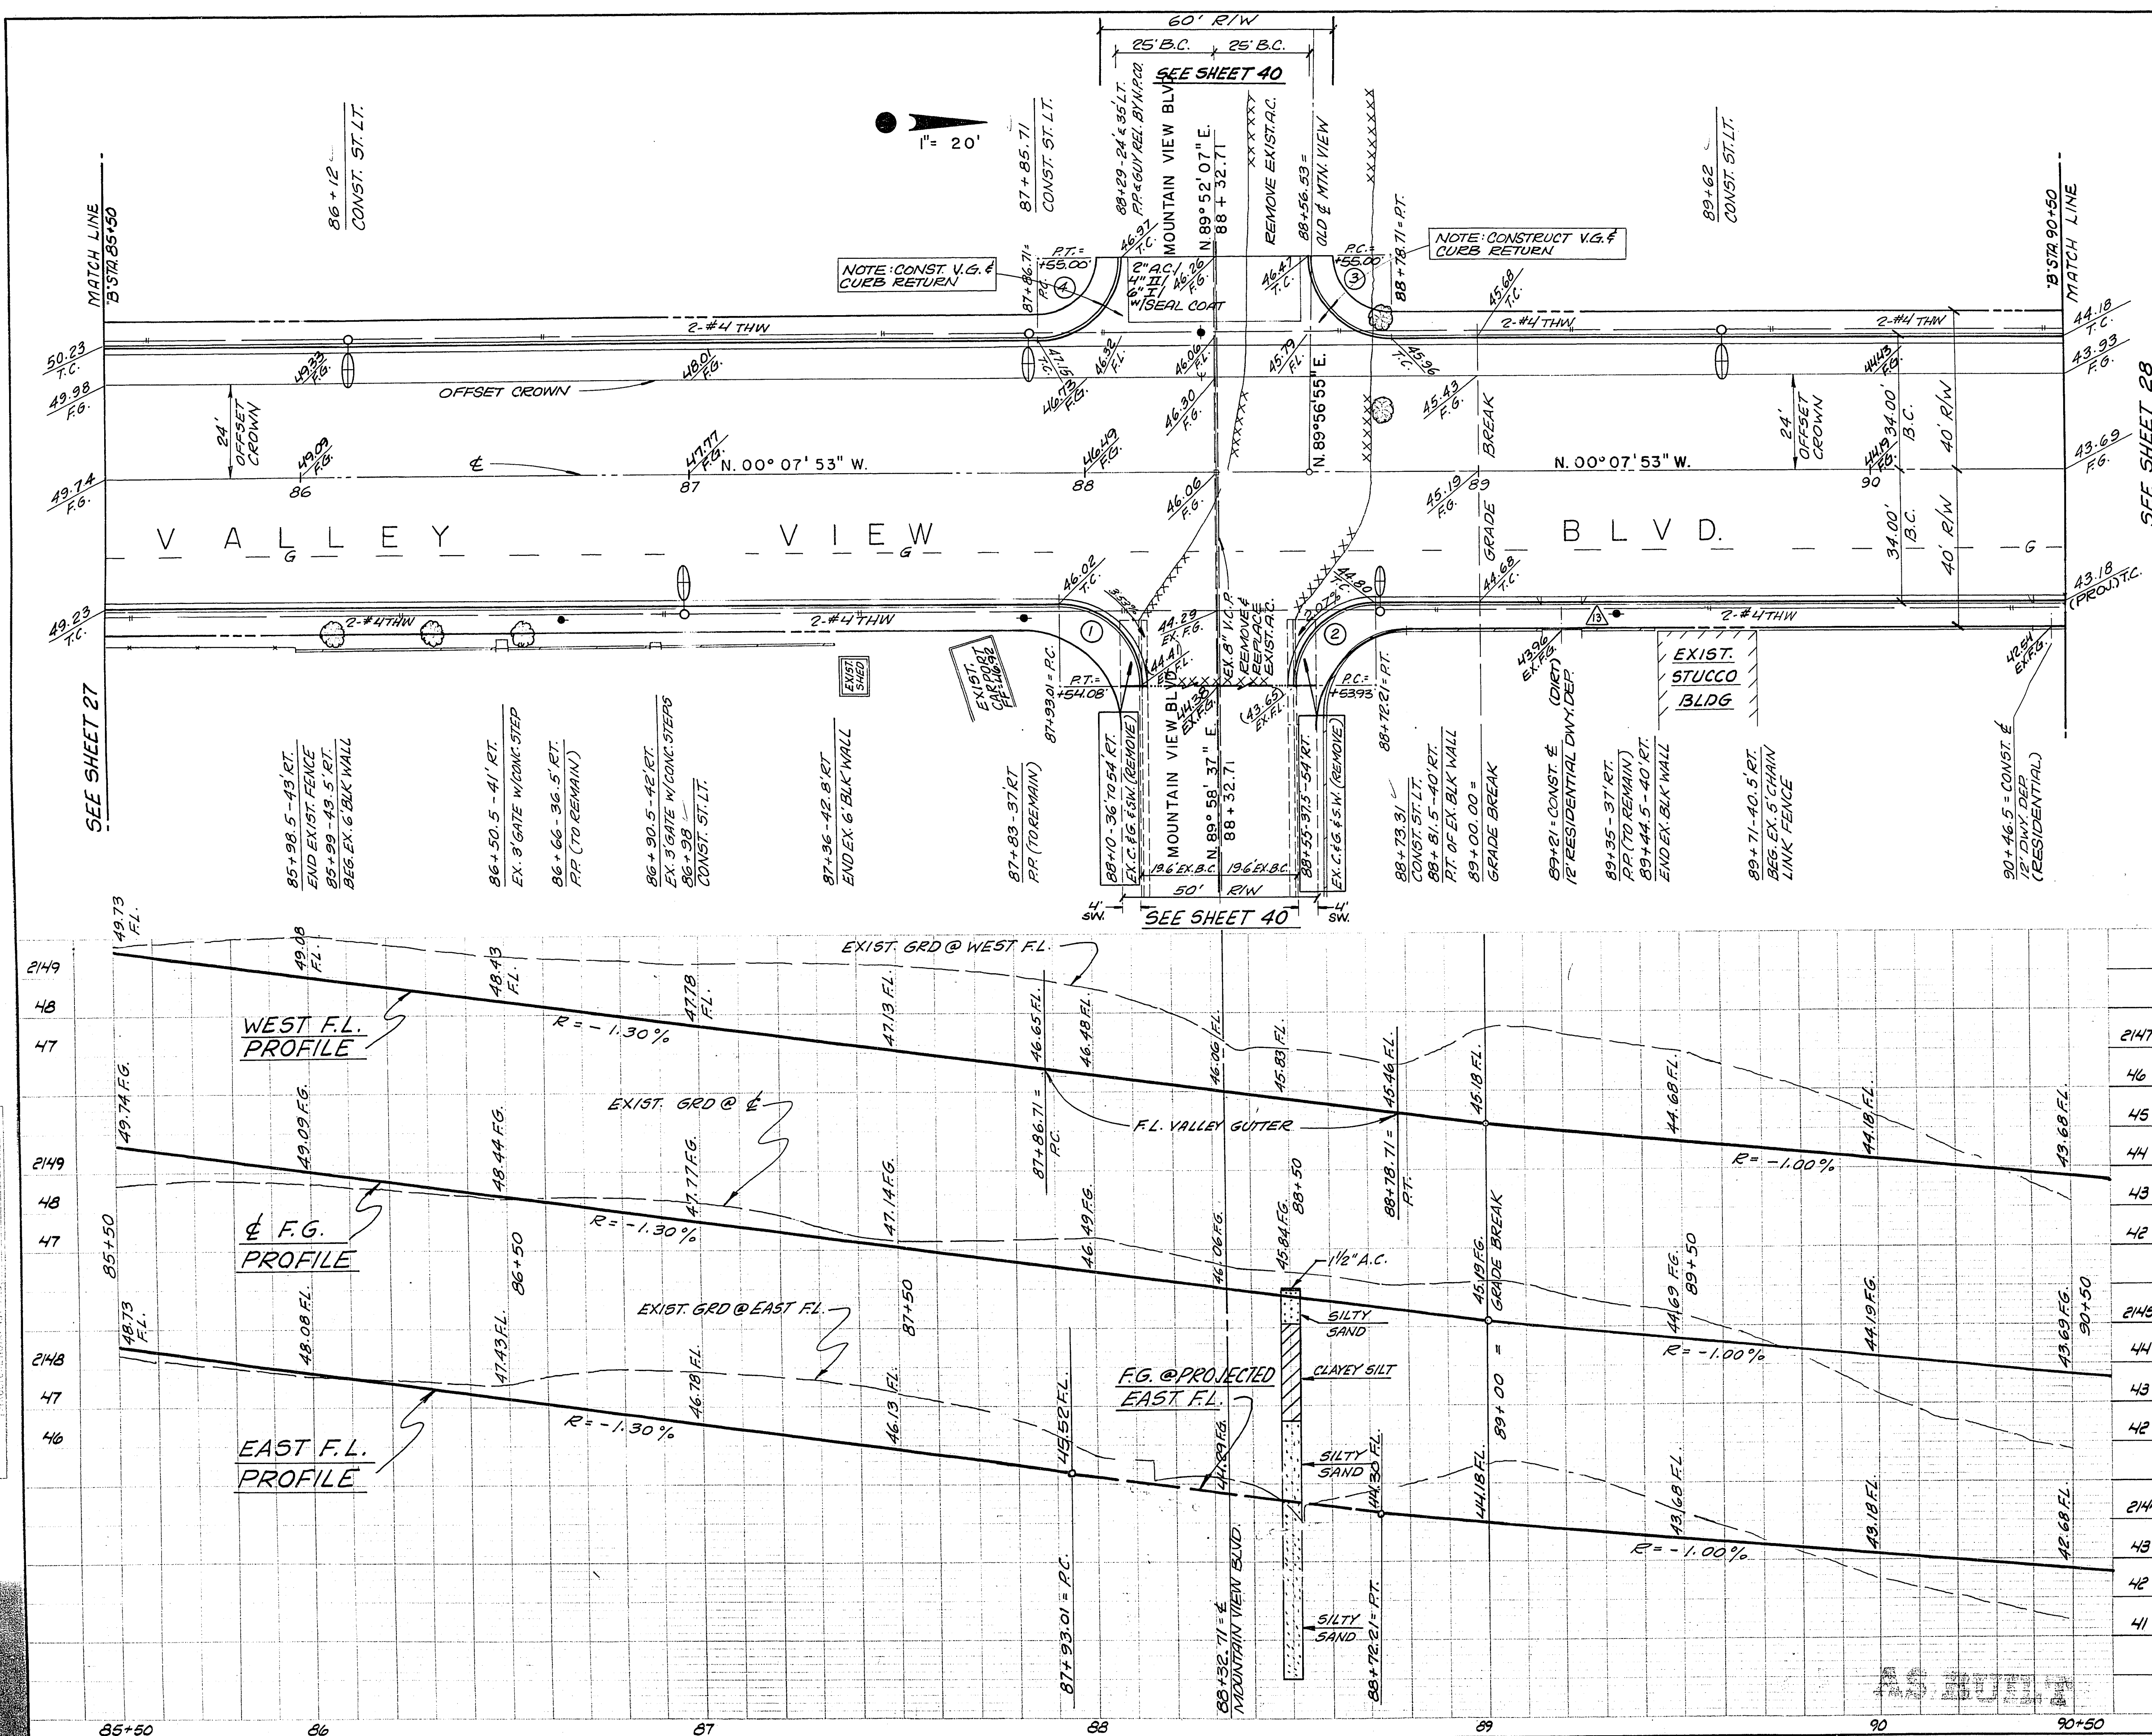

ITEM	DESCRIPTION	APPROXIMATE QUANTITY	ESTIMATE	CLV	CLV-SID	TOTAL	UNIT
20100	ROADWAY EXCAVATION	2533				2533	C.Y.
302100	TYPE I GRAVEL BASE	578			98	676	C.Y.
302200	TYPE II GRAVEL BASE	372			63	435	C.Y.
334000	ASPHALT CONCRETE PAVEMENT - 4"	723			104	827	TON
333500	1/2" PLANT MIX BITUMINOUS OPEN-GRADED SURFACE	3216			460	3676	S.Y.
340014	CONCRETE 2" TYPE CURB & GUTTER (24" WIDE)	473			473	946	L.M.F.T.
340019	VALLEY GUTTER	600			600	600	S.F.
334800	RESIDENTIAL DEPRESSED CURB	20			20	20	L.F.
334800	RESIDENTIAL PRIME COAT	803			116	919	G.P.L.
200110	CONCRETE REMOVAL	245			3	248	S.F.
400220	STREET LIGHT	2			3	5	EA.
334004	ASPHALT CONCRETE PAVEMENT-2"	10			10	10	TON

CONTACT DRAWING
MAY 1 1974

NO.	Δ	BCR	L	T	PLR	
4		90° 00' 00"	21.00'	32.99'	21.00'	15.00'
3		90° 00' 00"	21.00'	32.99'	21.00'	15.00'
2		89° 53' 30"	20.00'	31.38'	19.95'	25.00'
1		90° 06' 30"	20.00'	31.45'	20.04'	25.00'

CURVE DATA	
N.O.	ELEV.
13	46.32

BENCH MARK DESCRIPTION
NAIL IN PP #R1266 - STA. 89+35 (36.0 RT)

REV.	DATE	DESCRIPTION	APP'D.

DELTA ENGINEERING INC.
4239 W. SAHARA AVE.
LAS VEGAS, NEV. 89102
PHONE: (702) 876-0330

VALLEY VIEW BLVD.
SPRING MOUNTAIN RD. TO CHARLESTON BLVD.
"B" STA. 85+50 TO 90+50

H.SCALE: 1"=20' V.SCALE: 1"=2'
W.O. NO. 711102 CHK'D. DATE: 5-3-74
DWN. E.C. FILE NO. SHEET 27 OF 45

21-4-31