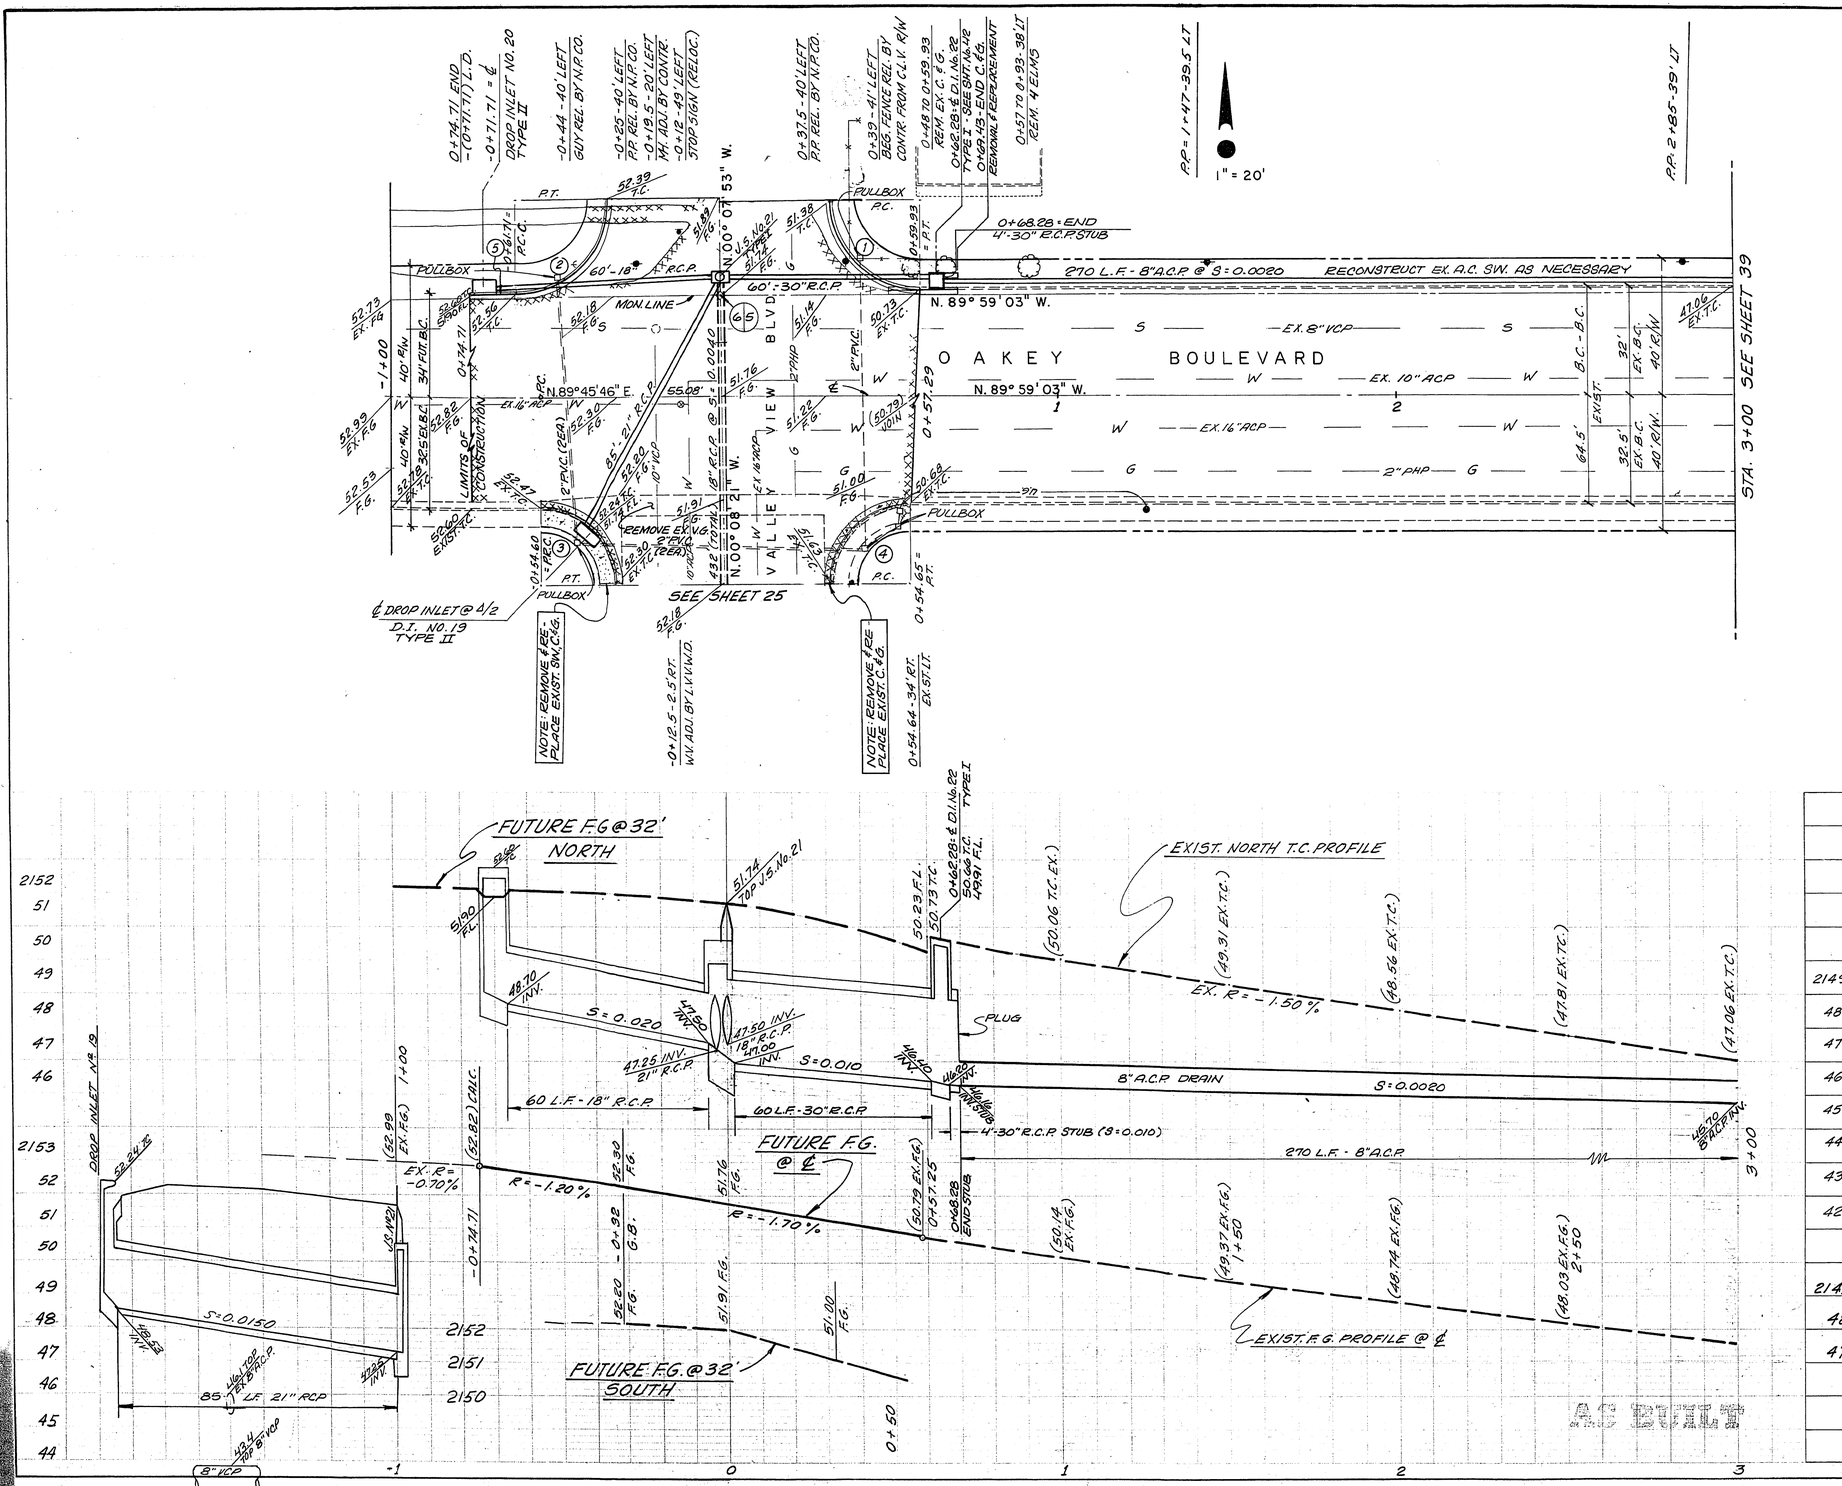

APPROXIMATE QUANTITY ESTIMATE

ITEM	DESCRIPTION	RSH	CLV	CLV-SID	TOTAL	UNIT
337.905	A.C. SIDEWALK (RECONSTRUCTION)	1000			1000	SQ. FT.
200.300	REMOVE TREE (4"-10")	4			4	EA.
	SEE SHEET 42 FOR STORM DRAIN					
890.103	FUTURE TRAFFIC SIGNAL INSTALLATION	1			1	L.S.

CONTRACT DRAWING
MAY 3 1974

NO.	Δ	BCR	L	T	PLR
5	0°38'16"	1167.70'	13.00'	6.50'	1161.70'
4	90°09'18"	22.00'	34.62'	22.06'	15.00'
3	90°06'13"	22.00'	34.60'	22.04'	15.00'
2	89°53'19"	27.50'	43.14'	27.45'	20.00'
1	89°51'10"	26.00'	40.77'	25.93'	20.00'

CURVE DATA

BENCH MARK

SEE SHEET 25

REVISIONS

REV.	DATE	DESCRIPTION	APP'D.

DELTA ENGINEERING INC.
4239 W. SAHARA AVE.
LAS VEGAS, NEV. 89102
PHONE: (702) 876-0330

VALLEY VIEW BLVD.
SPRING MOUNTAIN RD. TO CHARLESTON BLVD.
OAKEY AND VALLEY VIEW INTERSECTION

H. SCALE: 1" = 20'	V. SCALE: 1" = 2'	DES: D.P.	DWG. NO. 107-V926
WO NO 71102	CHK'D.	DWN: E.C.	FILE NO.
APPROVED		DATE 5-3-74	SHEET 38 OF 45

21-4-42