



PLAN  
 SURVEYED BY  
 DATE  
 NO.

PROFILE  
 SURVEYED BY  
 DATE  
 NO.

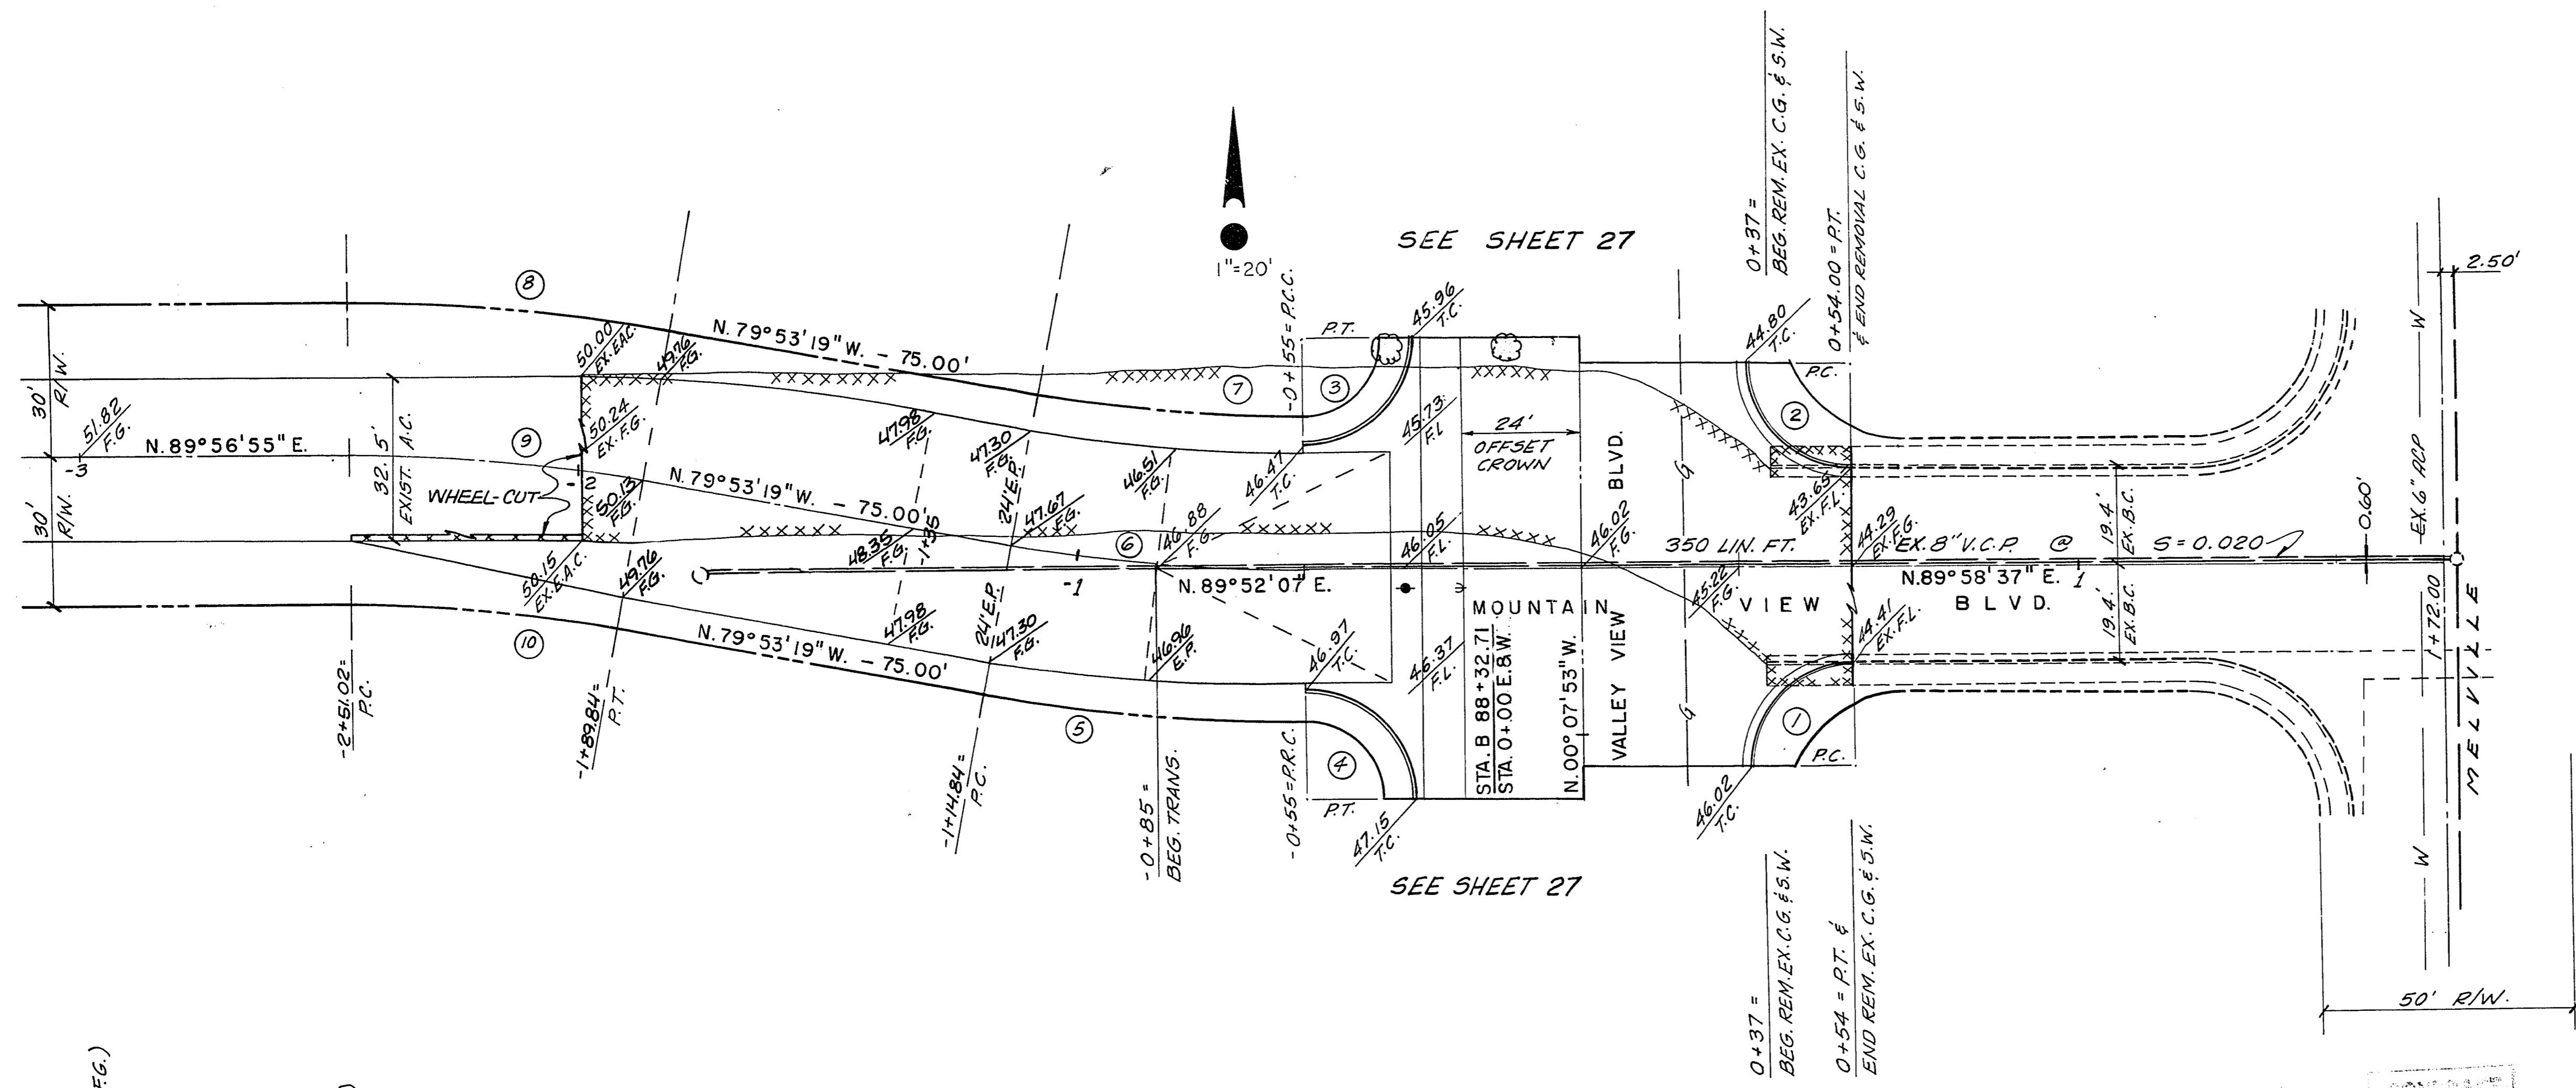

SEE SHEET 27

SEE SHEET 27

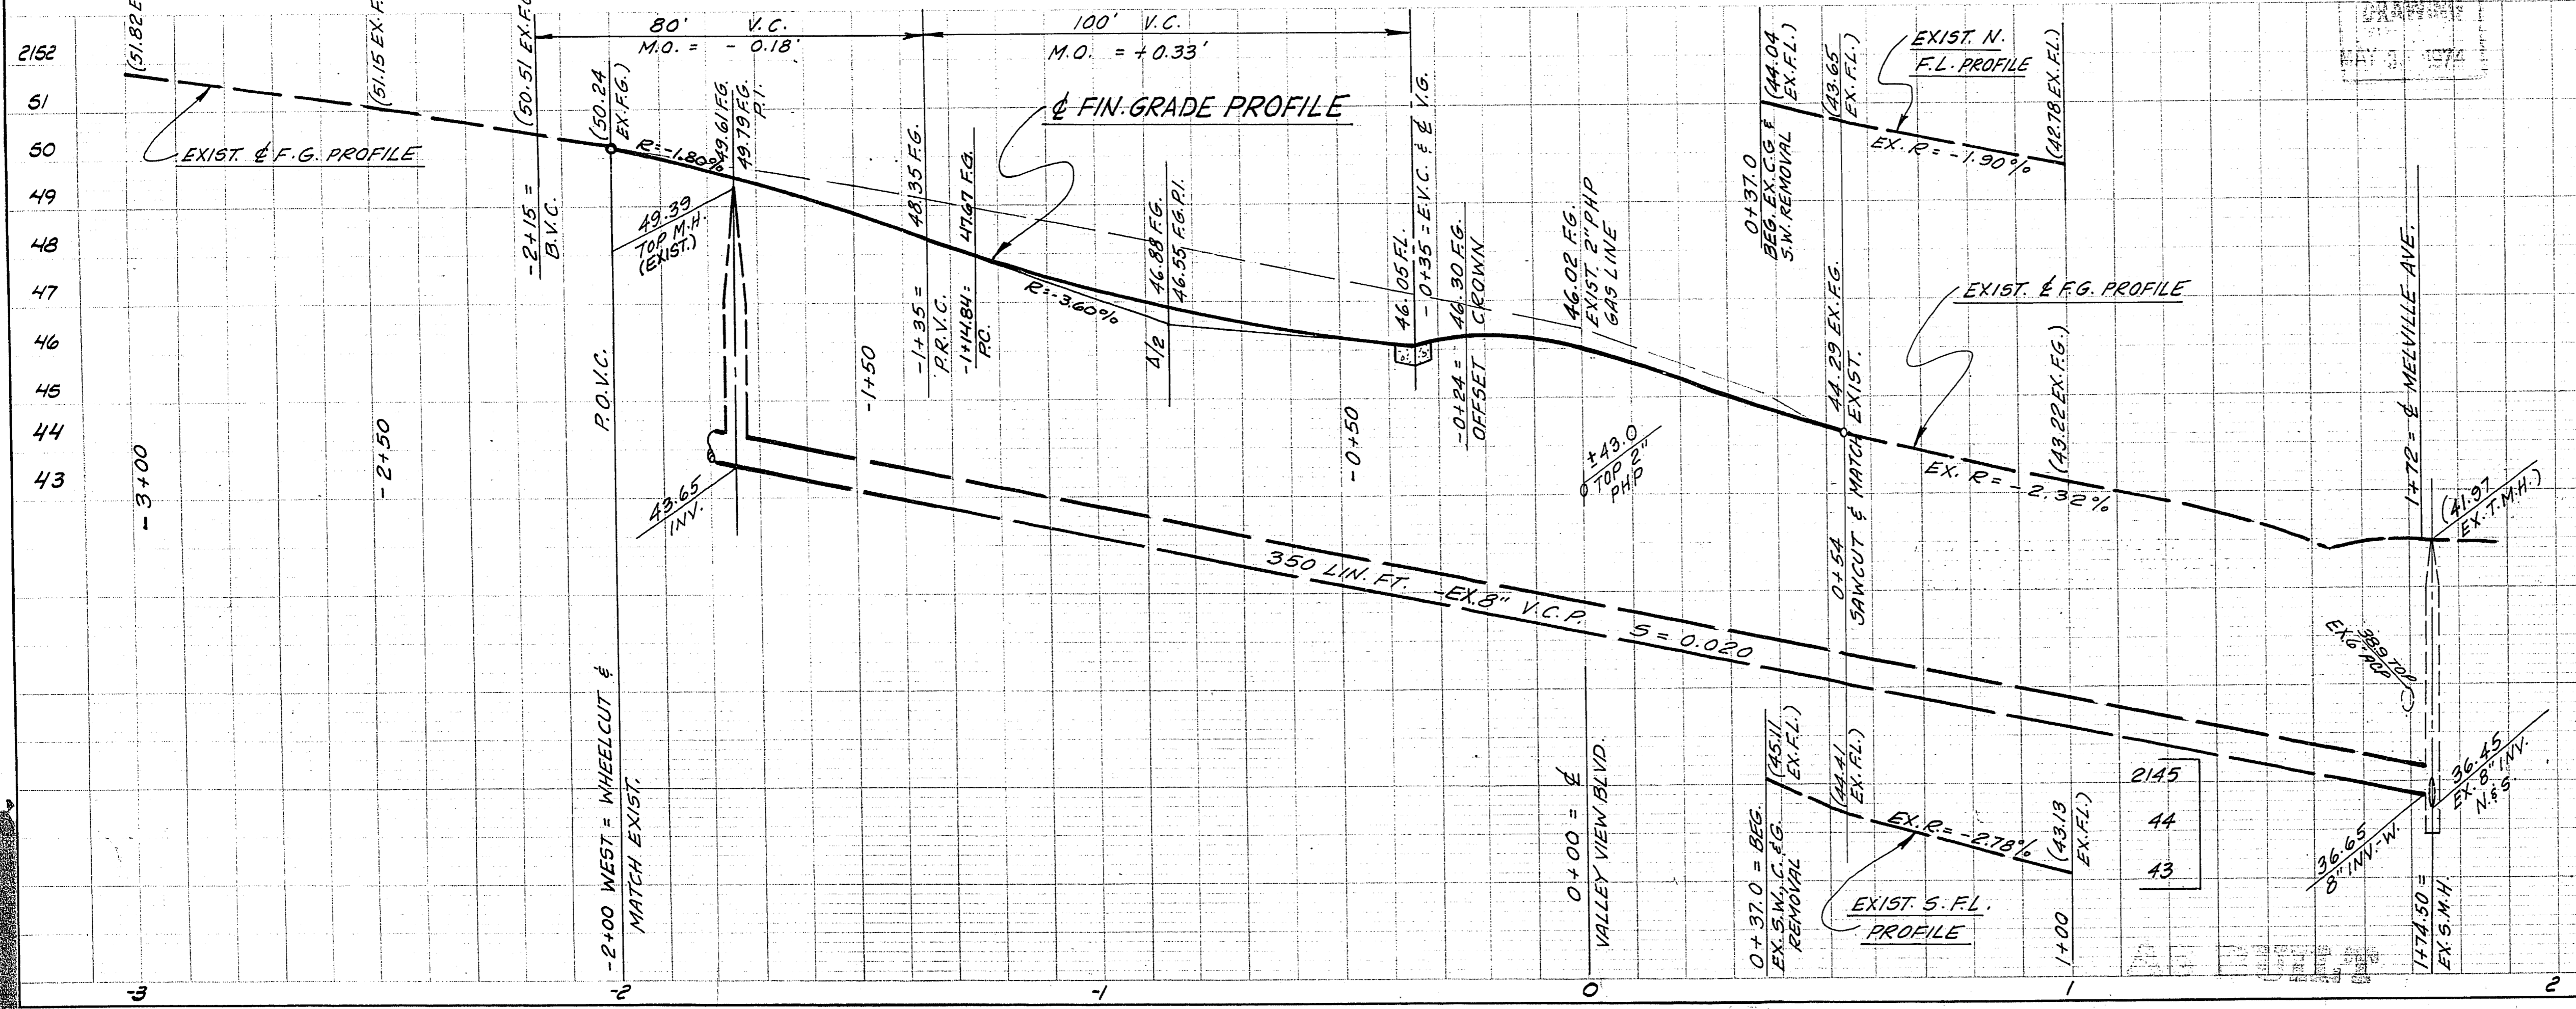

ITEM	DESCRIPTION	APPROXIMATE QUANTITY	ESTIMATE	R	S	H	CLV	CLV - SID	TOTAL	UNIT
20100	ROADWAY EXCAVATION	457							457	C.Y.
302100	TYPE I GRAVEL BASE	120							120	C.Y.
302200	TYPE II GRAVEL BASE	80							80	C.Y.
334000	ASPHALT CONCRETE PAVEMENT - 2"	81							81	TON
333100	BITUMINOUS FOG SEAL	72							72	GAL.

NO	Δ	BCR	L	T	PLR
10	10° 09' 46"	55.86'	28.00'	314.92'	
9	10° 09' 46"	61.18'	30.67'		
8	10° 09' 46"	66.50'	33.34'	374.92'	
7	10° 14' 34"	54.48'	27.31'	304.73'	
6	10° 14' 34"	59.84'	30.00'		
5	10° 14' 34"	65.20'	32.69'	364.73'	
4	90° 00' 00"	21.00'	32.99'	21.00'	15.00'
3	90° 00' 00"	21.00'	32.99'	21.00'	15.00'
2	89° 53' 30"	20.00'	31.38'	19.95'	25.00'
1	90° 06' 30"	20.00'	31.45'	20.04'	25.00'

CURVE DATA	
N.O.	ELEV.
13	46.32

REV.	DATE	DESCRIPTION	APP'D.

**DELTA ENGINEERING INC.**  
 4239 W. SAHARA AVE.  
 LAS VEGAS, NEV. 89102  
 PHONE: (702) 876-0330

**VALLEY VIEW BLVD.**  
 SPRING MOUNTAIN RD. TO CHARLESTON BLVD.  
 MTN. VIEW AND VALLEY VIEW INTERSECTION

H. SCALE: 1" = 20'    V. SCALE: 1" = 2'    DES: DR    DWG. NO: 107-V926  
 WO NO. 71102    CHK'D    DWN: EC    FILE NO.  
 APPROVED: [Signature]    DATE    SHEET 40 OF 45

21-4-44