



GILMORE AVENUE

7 6 5 4 3 2 1 0

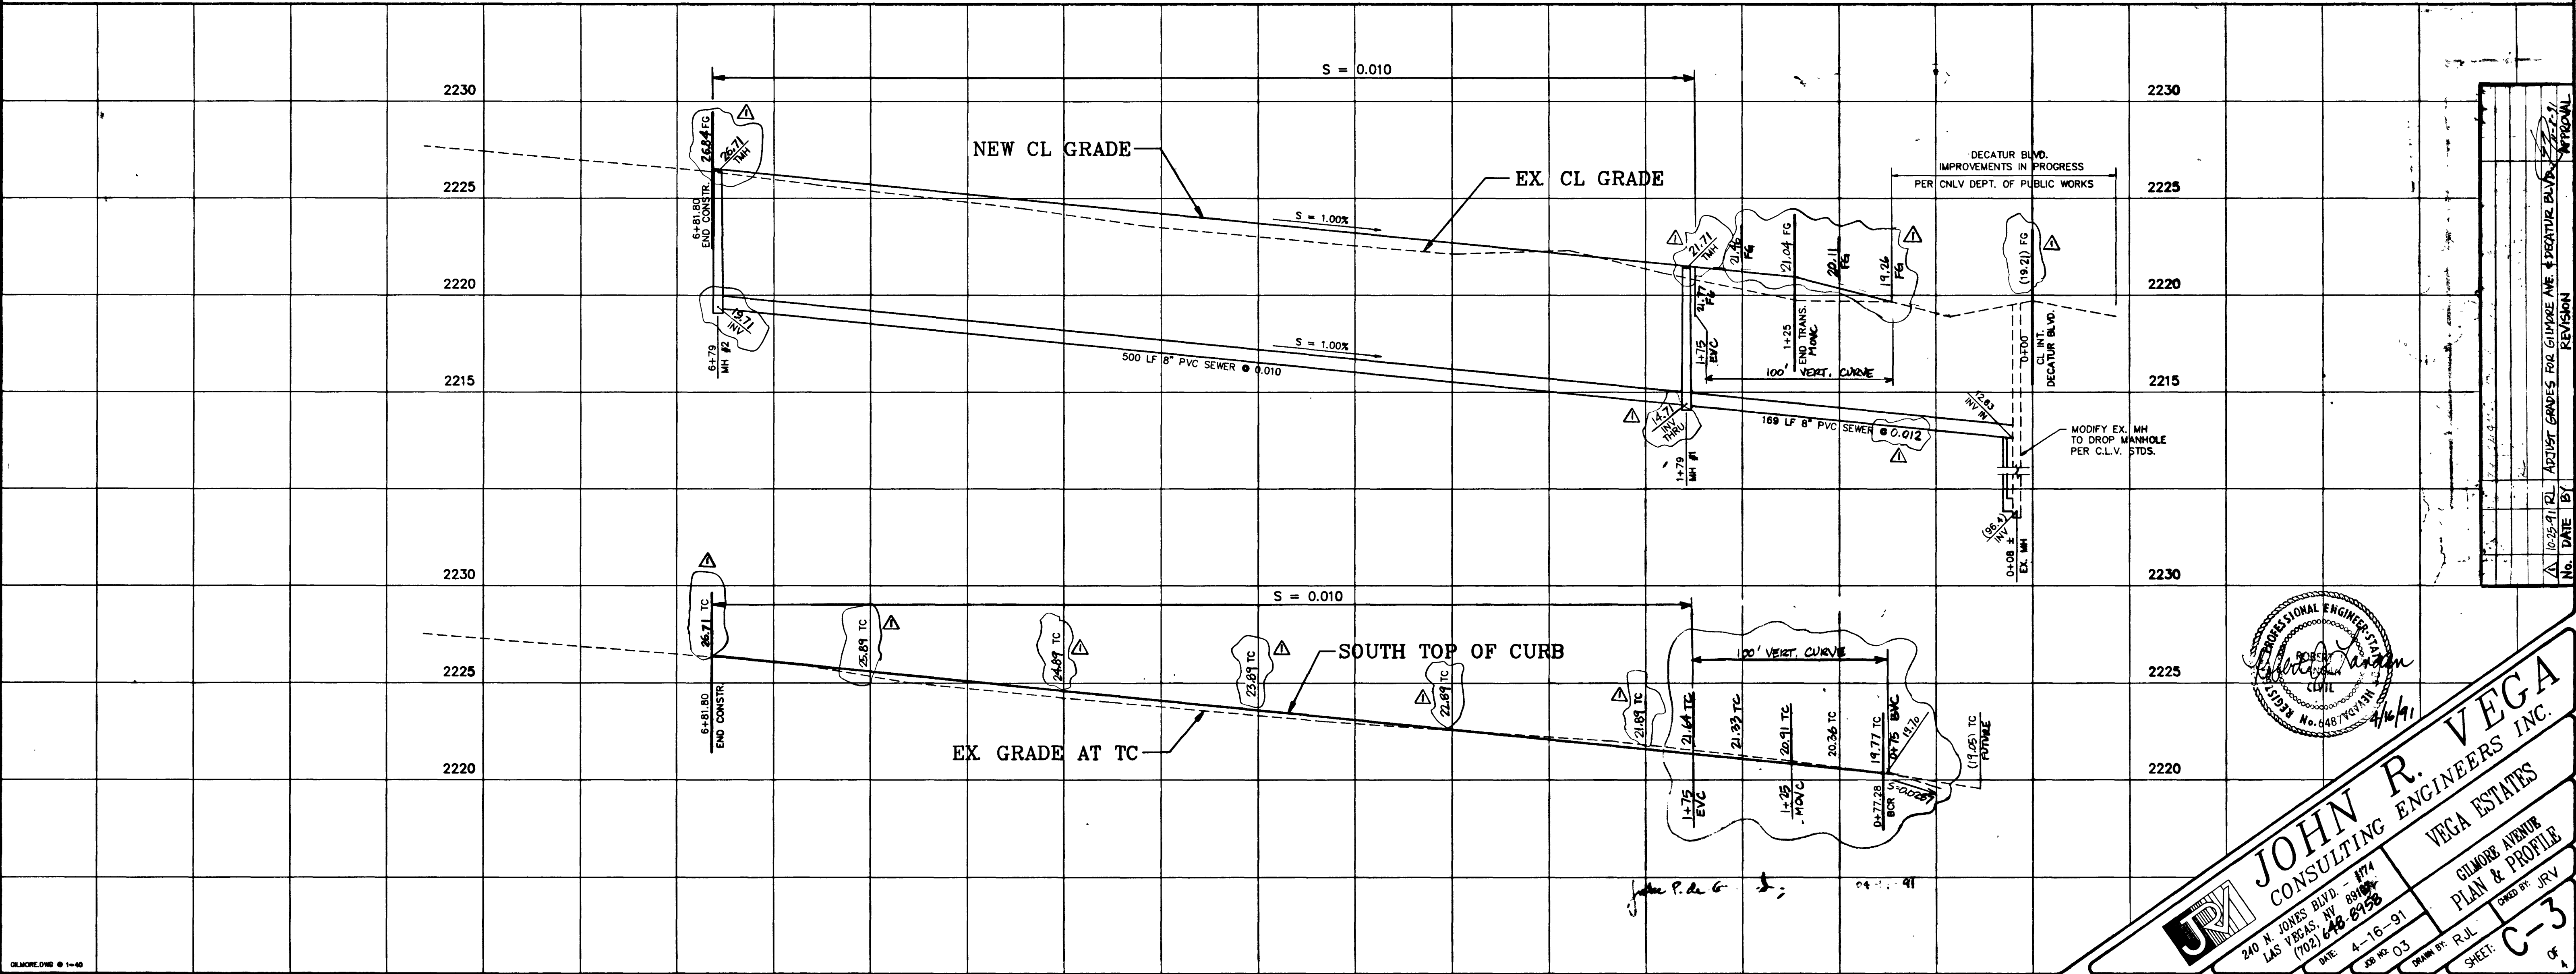


SCALE  
1" = 40' HOR  
1" = 4' VER

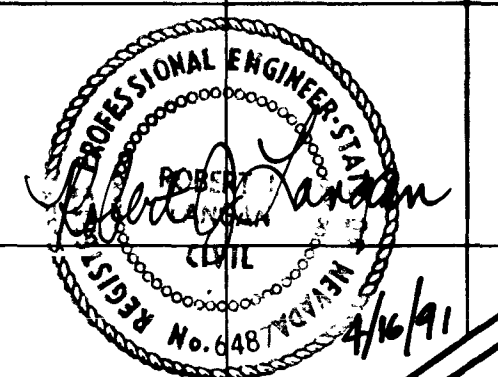


**JOHN R. VEGA**  
CONSULTING ENGINEERS INC.  
VEGA ESTATES  
GILMORE AVENUE  
PLAN & PROFILE  
DRAWN BY: RUL  
DATE: 4-16-91  
SHEET: C-3

No.	DATE	BY	REVISION
1	10-29-91	RUL	ADJUST GRADES FOR GILMORE AVE. & DECATUR BLVD. INTERSECTION

14 1079-4169

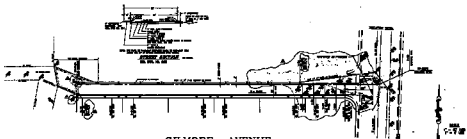

GILMORE AVENUE

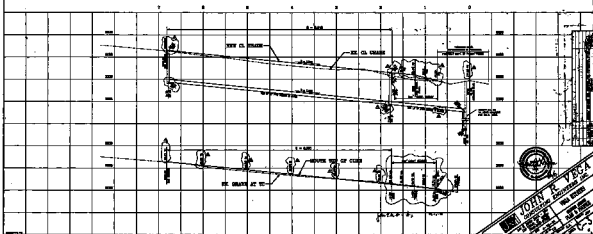

JOHN R. VECA  
 CONSULTING ENGINEER INC.  
