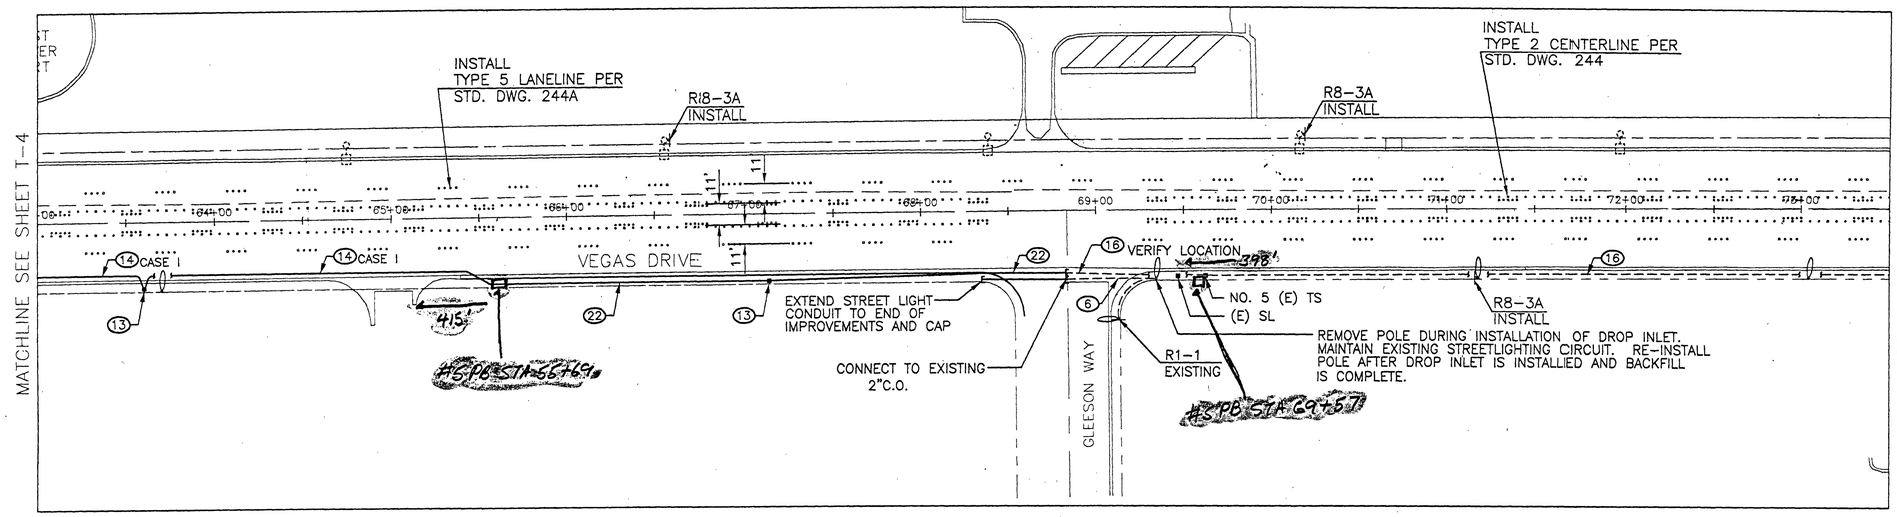

NOTES:
1. REFER TO STD. DWG. NO. 247 FOR MARKER AND REFLECTOR TYPES.
2. SEE SHEET T-1 FOR STREETLIGHTING CONSTRUCTION NOTES.

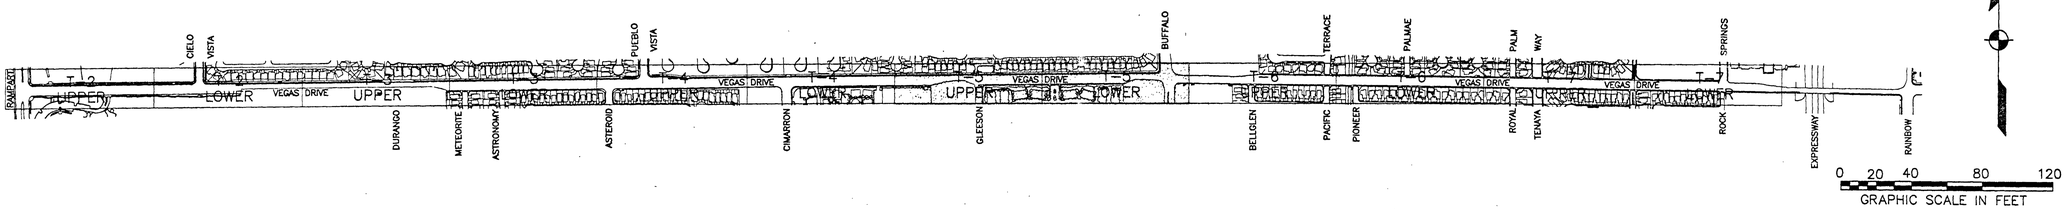

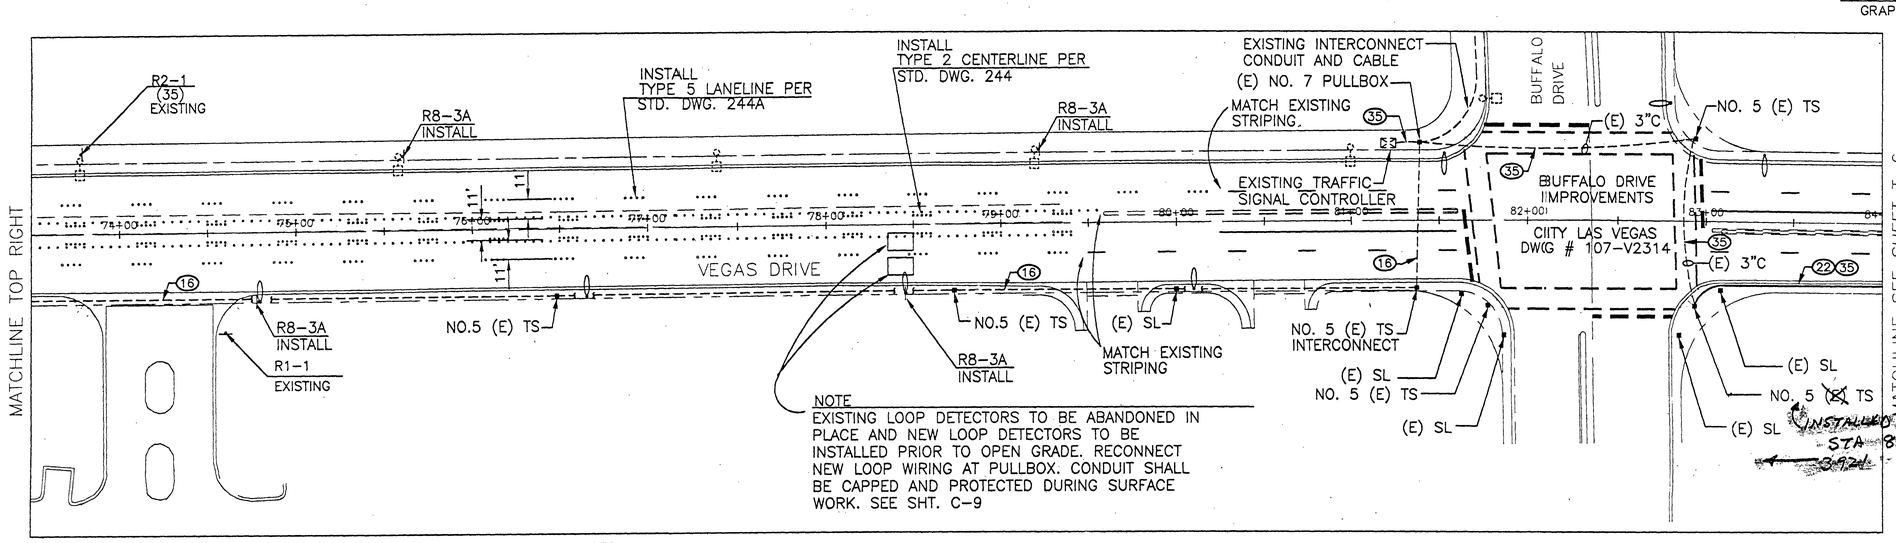

NOTES:
1. REFER TO STD. DWG. NO. 247 FOR MARKER AND REFLECTOR TYPES.
2. SEE SHEET T-1 FOR STREETLIGHTING CONSTRUCTION NOTES.
3. CONTRACTOR SHALL REMOVE EXISTING TRAFFIC SIGNAL WIRE ACROSS VEGAS DRIVE AND BUFFALO DRIVE AND RE-INSTALL WITH NEW INTERCONNECT WIRE. PROVIDE TEMPORARY TRAFFIC CONTROL DURING SIGNAL OUTAGE. COORDINATE WORK AT BUFFALO INTERSECTION WITH C.L.V.

47053

Avoid cutting underground utility lines. It's costly.
Call before you Dig.
1-800-227-2600
UNDERGROUND SERVICE ALERT (USA)

REGISTERED PROFESSIONAL ENGINEER WILLIAM J. COLEMAN CIVIL No. 4923 STATE OF NEVADA
STRIPING & SIGNAGE

REGISTERED PROFESSIONAL ENGINEER THOMAS J. KROB ELECTRICAL No. 8361 STATE OF NEVADA 9/15/97
STREET LIGHTING

USE OF DOCUMENTS
THIS DOCUMENT, INCLUDING THE INFORMATION, DATA, DESIGNS AND INSTRUMENT OF SERVICE FOR THIS PROJECT AND SHALL NOT BE USED FOR ANY OTHER PROJECT WITHOUT THE WRITTEN AUTHORIZATION OF KENNEDY/JENKS CONSULTANTS.

NO.	REVISION	DATE	BY

DESIGNED HW/DSN
DRAWN JDM/BJL
CHECKED TOM KROB

Kennedy/Jenks Consultants
1455 E. Tropicana Avenue, Suite 300
Las Vegas, NV 89119

TJ KROB CONSULTING ENGINEERS, INC.
1419 JONES BLVD. SUITE B
LAS VEGAS, NEVADA
(702) 871-3621
ELECTRICAL ENGINEERING

CITY OF LAS VEGAS NEVADA

CITY OF LAS VEGAS - STREET IMPROVEMENTS
VEGAS DRIVE - RAMPART TO ROCK SPRINGS

STRIPING/LIGHTING PLAN
FROM STA. 63+00
TO STA. 84+00

6105/SHT-T5

DWG. NO. 107-V2684
JOB NO. 967018.04
DATE 9-16-97
SHEET 42 OF 50
T-5