


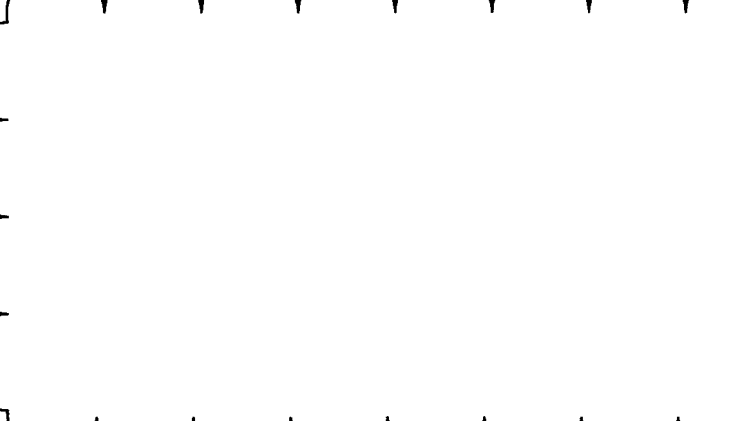

CONTRACTOR MUST SUBMIT SHOP DRAWINGS TO LVVWD BEFORE CONSTRUCTION TO SHOW HOW WATERLINES SPANNING A TRENCH WILL BE SUPPORTED DURING EXCAVATION AND BACKFILL. DRAWINGS WILL INCLUDE ALL LOCATIONS WHERE WATERLINES SPAN A TRENCH GREATER THAN 4 (FOUR) FEET WIDE AND WHERE VALVES AND THRUST BLOCKS ARE EXPOSED. DRAWINGS MUST BE SEALED BY A NEVADA LICENSED ENGINEER.

PROTECT WATERLINES IN PLACE. WHEREVER A WATERLINE IS WITHIN 18" ABOVE A STORM DRAIN LINE, OR WHERE COMPACTION UNDER A WATERLINE CAN NOT BE MET, BACKFILL TRENCH WITH CEMENT SLURRY OR FLOWABLE FILL TO THE SPRINGLINE OF THE WATERLINE. THIS REQUIREMENT IS FOR STRUCTURAL SUPPORT ONLY, ADDITIONAL HEALTH REGULATIONS MAY APPLY PER UDACS 2.19.

APPROVED FOR CONSTRUCTION

Billy Clark

12/2/02
DATE

SAFETY ALERT
 **Call** 
Before You
Overhead
 1-702-593-6111

Avoid cutting underground utility lines. It's costly.

**Call
before you
Dig**

1-800-227-2600

12/2/02
For Rev A5B

12/2/02
For Rev A & B

	SHEET: SD-26	STORM DRAIN LATERAL PROFILE	PROJECT: VEGAS DR./OWENS AVE. RANCHO DR. TO INTERSTATE 15		SCALE (H): AS NOTED FLD. BK. #		SCALE (V): AS NOTED DATE		W.A. # DESIGN BY		REVISIONS		DATE
					1/4/02	1/4/02	ZRT	Kimley-Horn and Associates, Inc. Engineering, Planning, and Environmental Consultants © 2002		1/20/02 A REVISION PER LVVWD COMMENTS	1/20/02 A ADDENDUM No. 2, ITEMS 2.17 AND 2.18.	9/19/02 A	