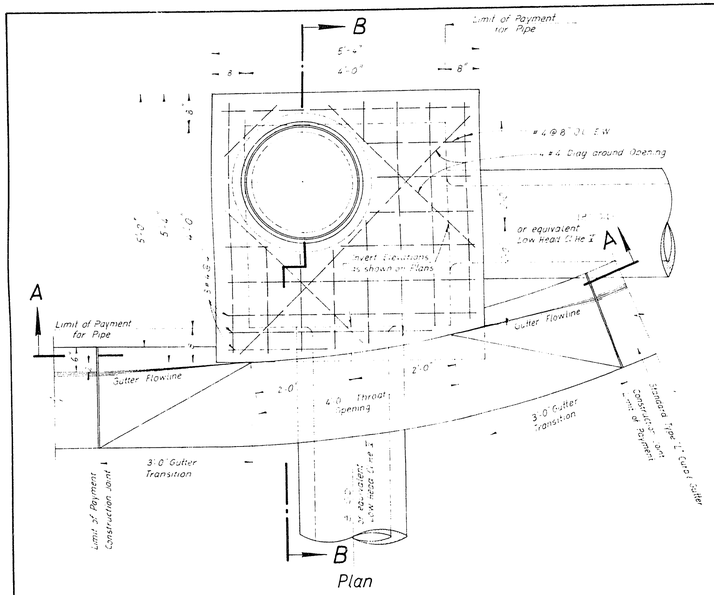

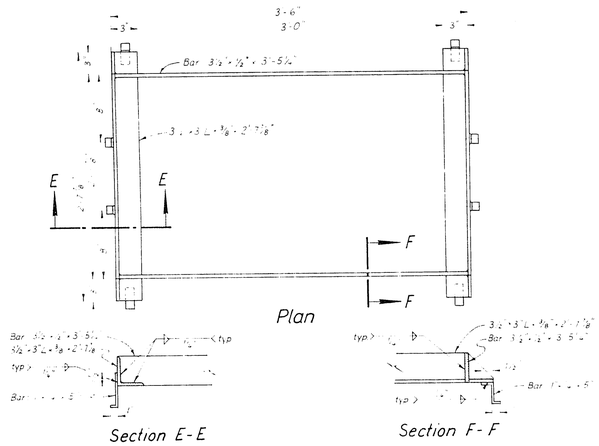

Frame

Scale: 1½" = 1'-0"

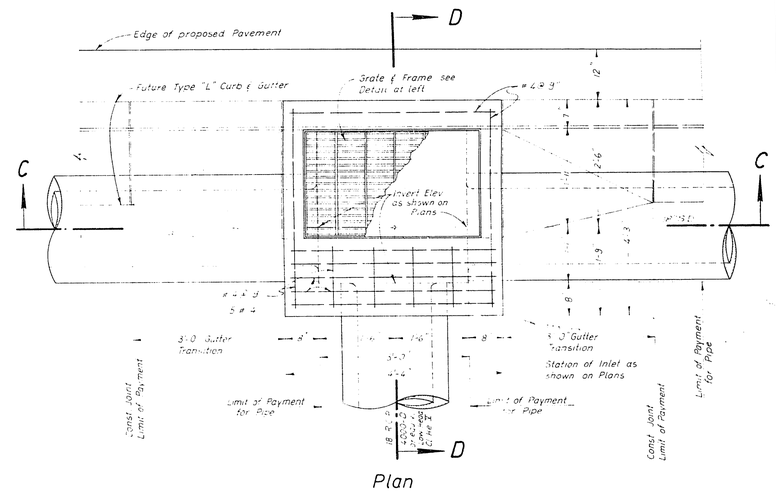

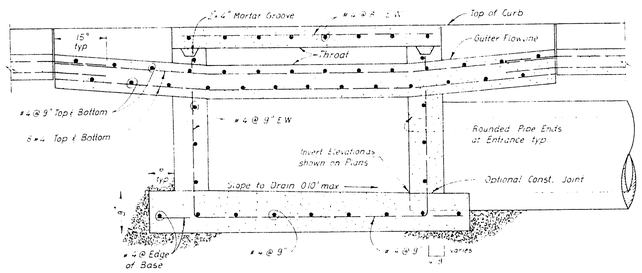

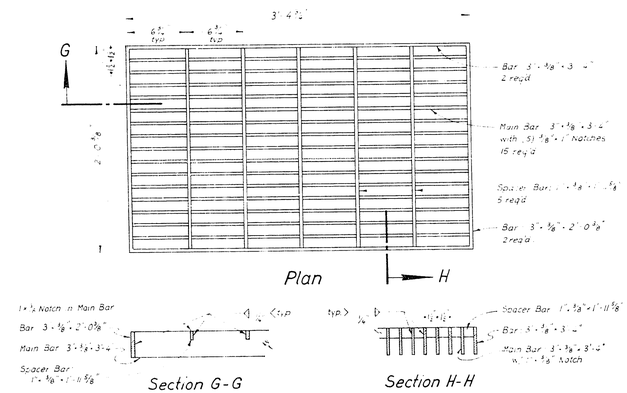

Grate

Scale: 1½" = 1'-0"

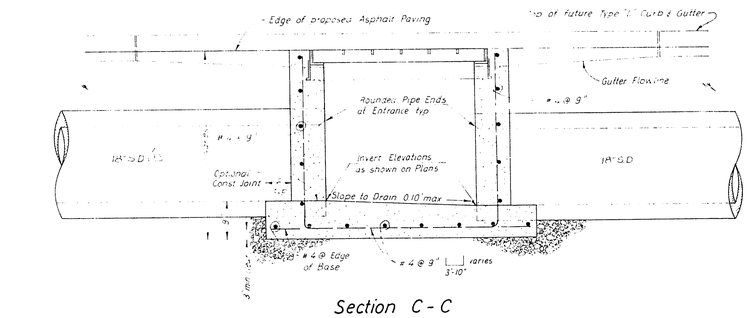

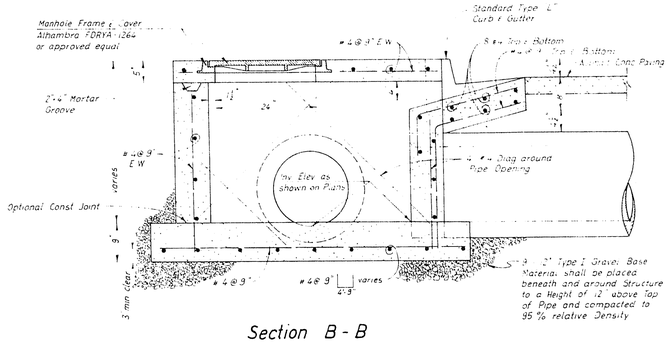

Type I Curb Inlet

Scale: ¾" = 1'-0"

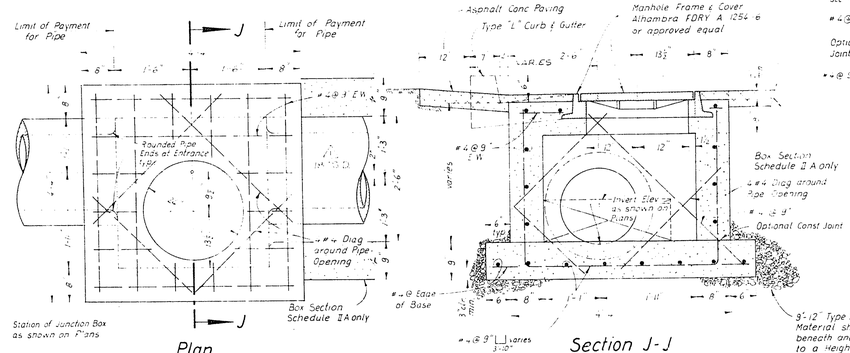

Junction Box

Scale: ¾" = 1'-0"

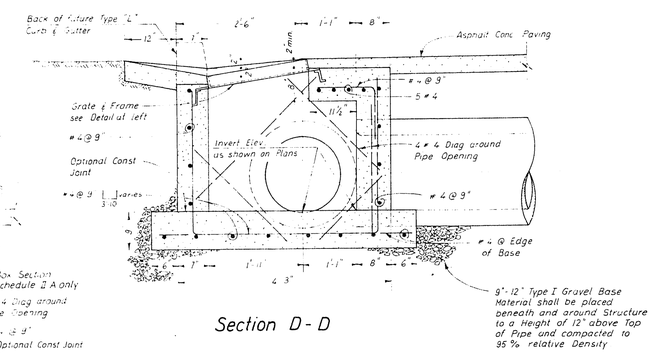

Type II Inlet

Scale: ¾" = 1'-0"

"AS CONSTRUCTED"
6-1-73

STERLING C DITSWORTH R C E 2304 DATE

1	2-21-70	CHANGED 14" RCP 4000 D TO 18" S.D. (TYP.)	S.C.D.

REGIONAL STREET & HIGHWAY COMMISSION
CLARK COUNTY, NEVADA

VEGAS DRIVE IMPROVEMENTS
PROJECT NO. 4A

NUISANCE WATER DRAIN DETAILS

DESIGNED R.L.G. | DRAWN G.M. | DATE 3-29-71 | CHECKED S.C.D.

BOYLE ENGINEERING
2000 SOUTH COMMERCE ST., LAS VEGAS, NEV.

CAN 07-0947-00-00

SHEET 13 OF 15

2-6-143 107-V912