
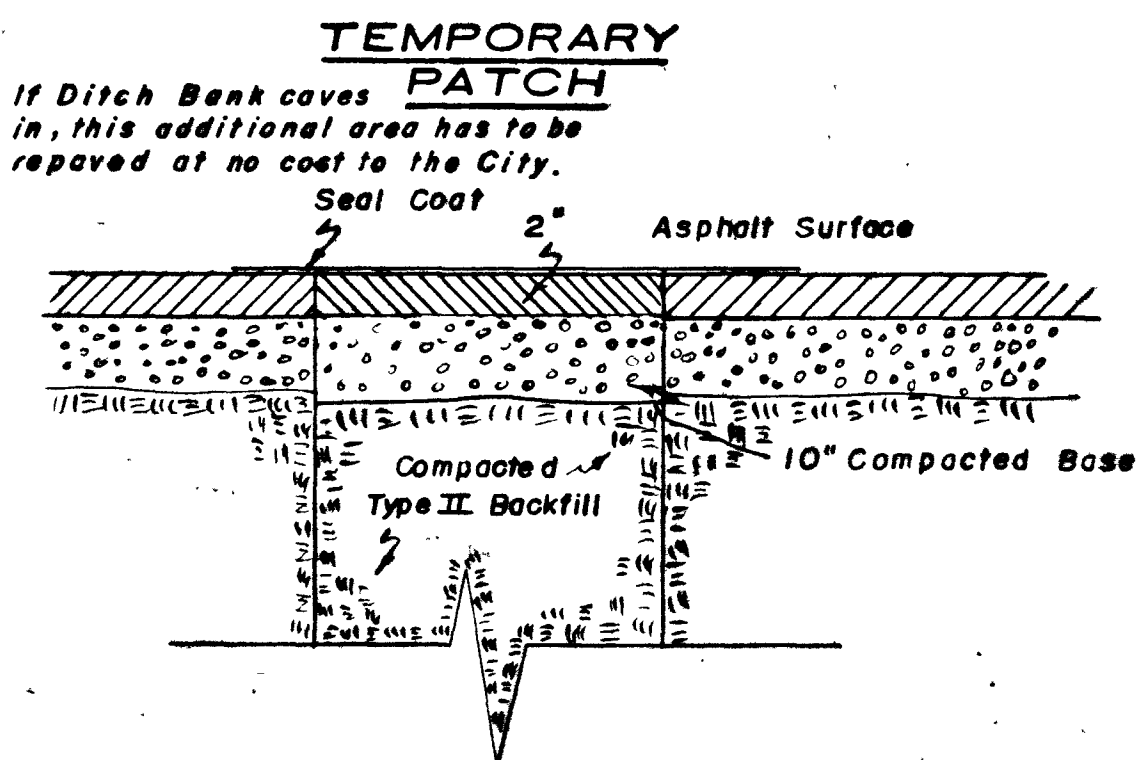


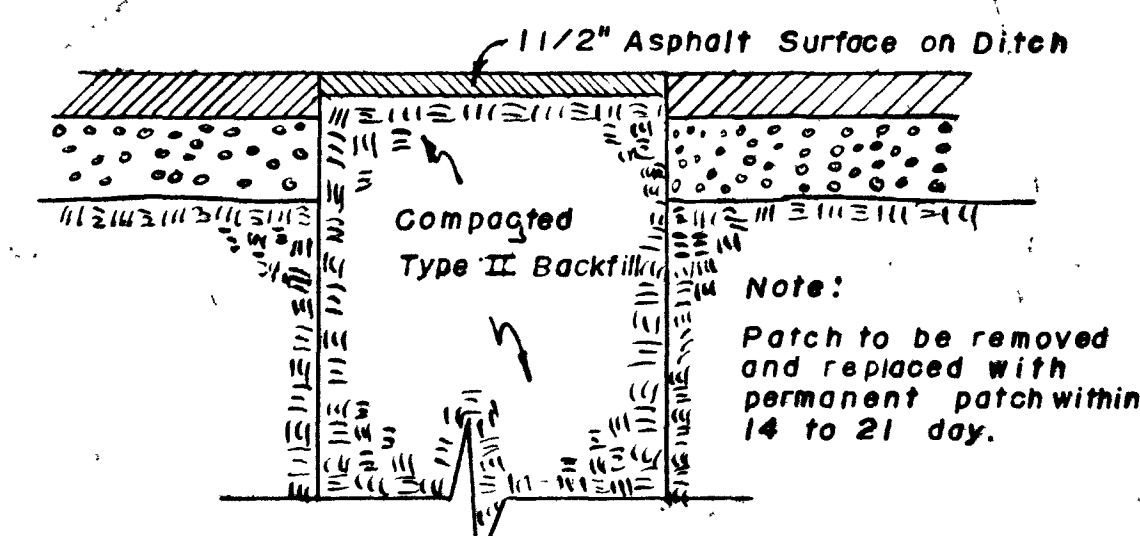


PAVEMENT REPLACEMENT CLASS "B"


PAVEMENT REPLACEMENT DETAILS
No Scale

TRENCH WIDTHS


Pipe Size, Inches	Max. Trench Width, Inches "W"	Min. Trench Width, Inches "W"
6"	26"	24"
10"	28"	26"

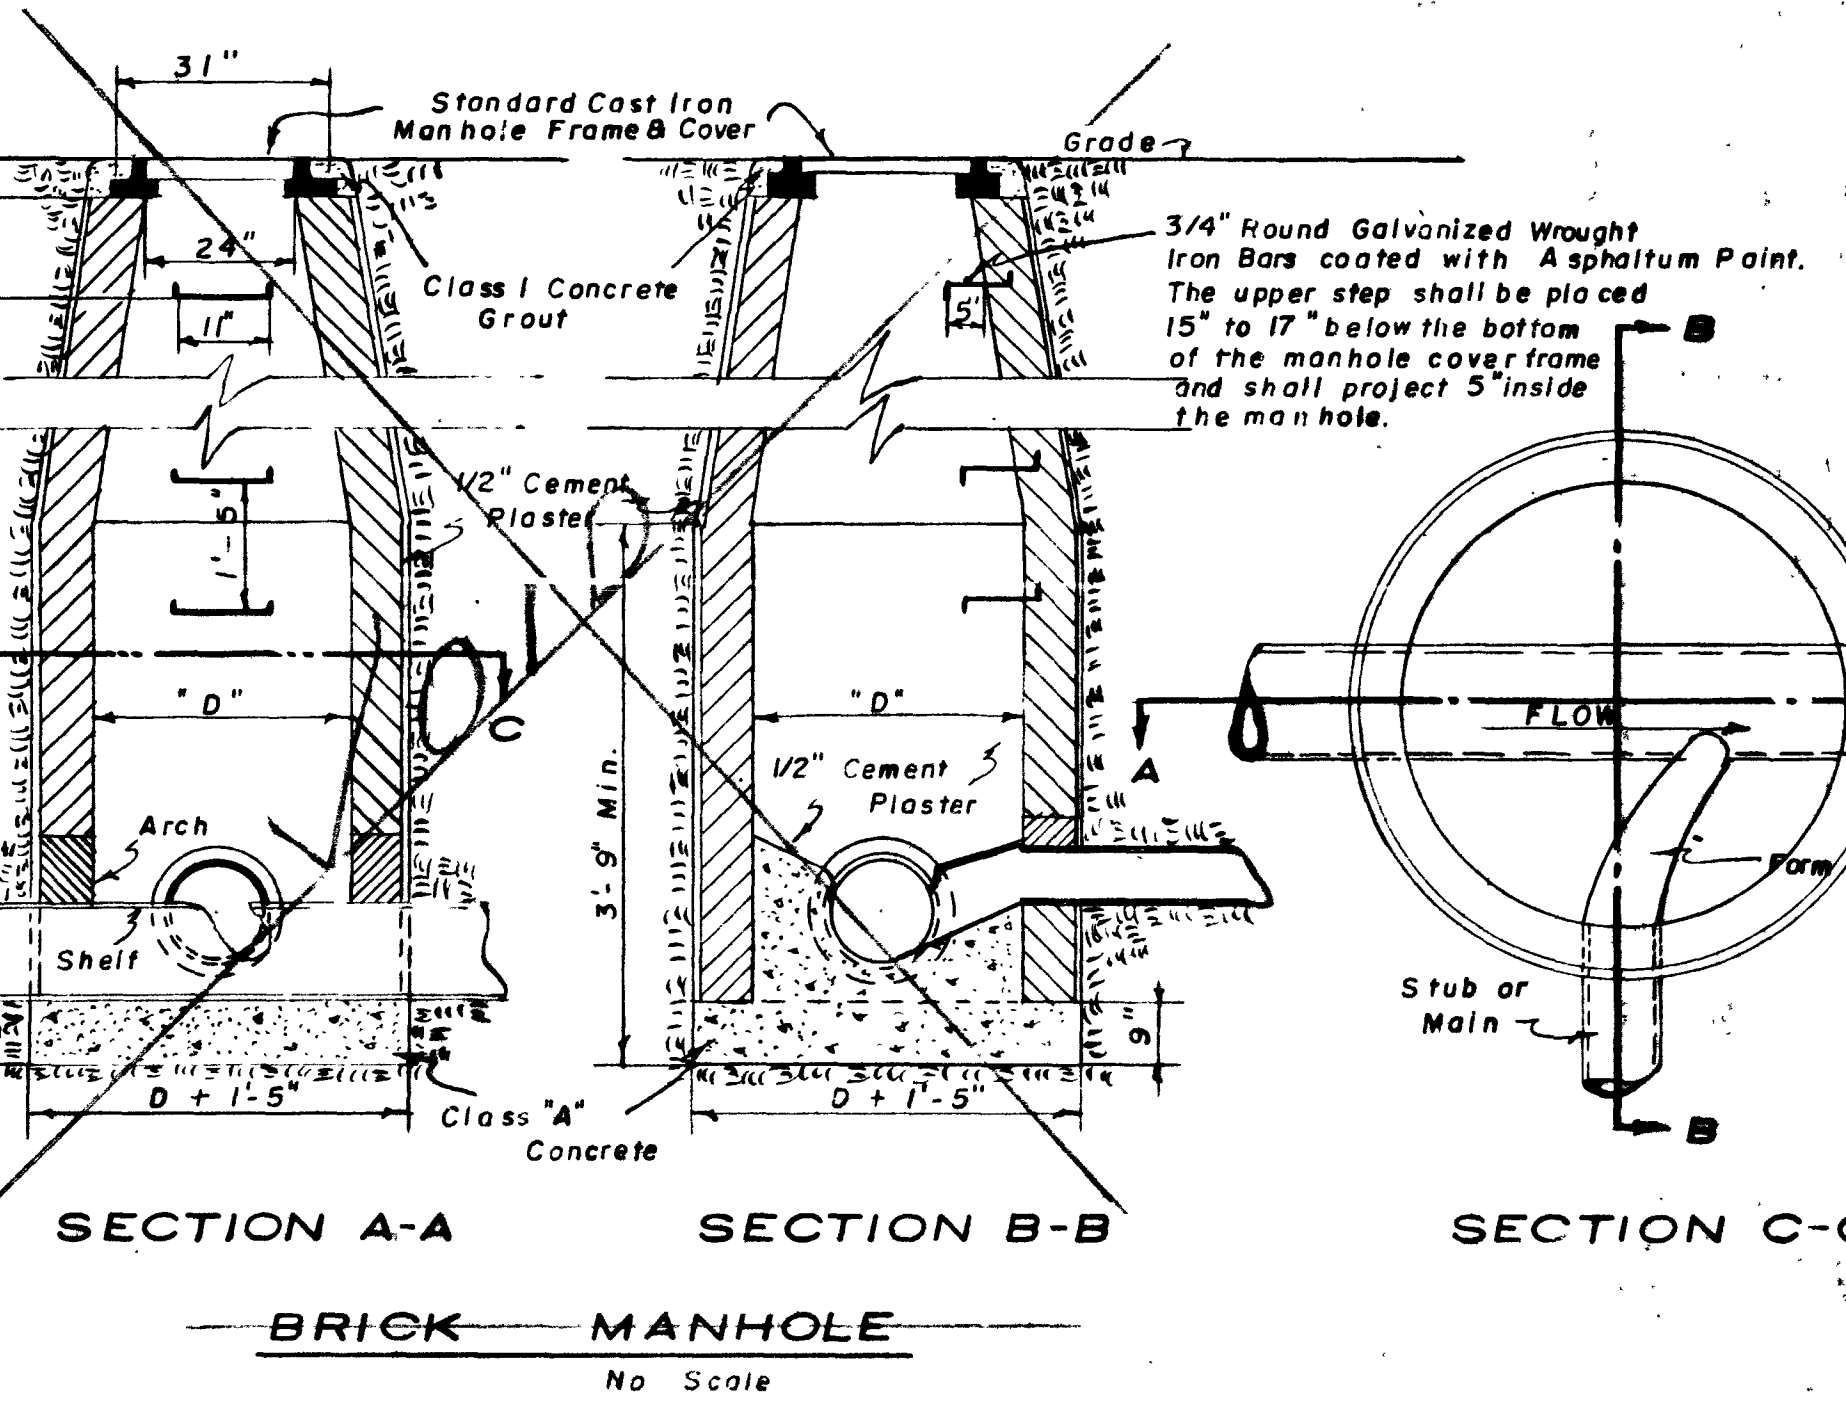


MANHOLE DETAILS
No Scale

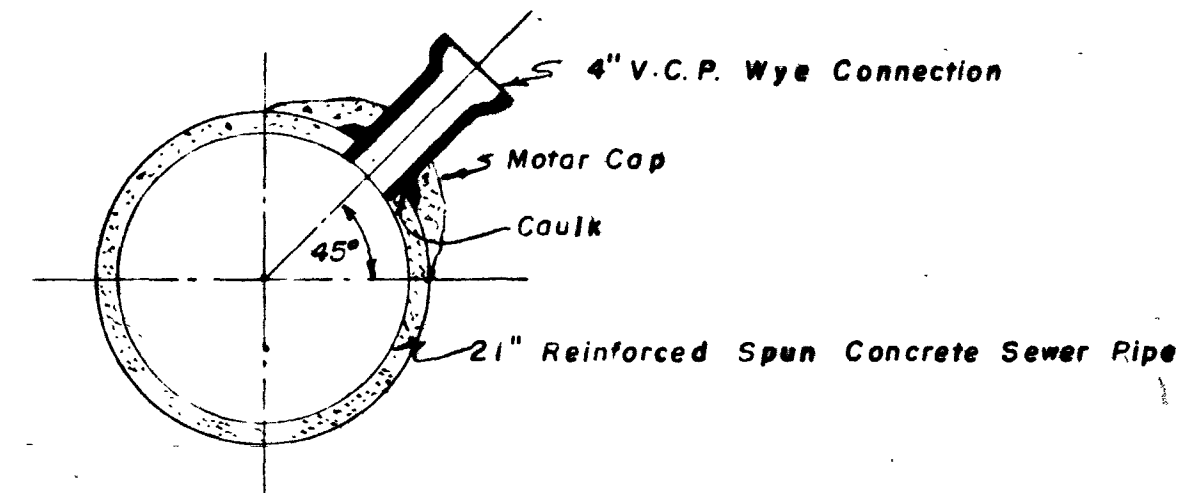


DETAIL - WYE CONNECTION
No Scale

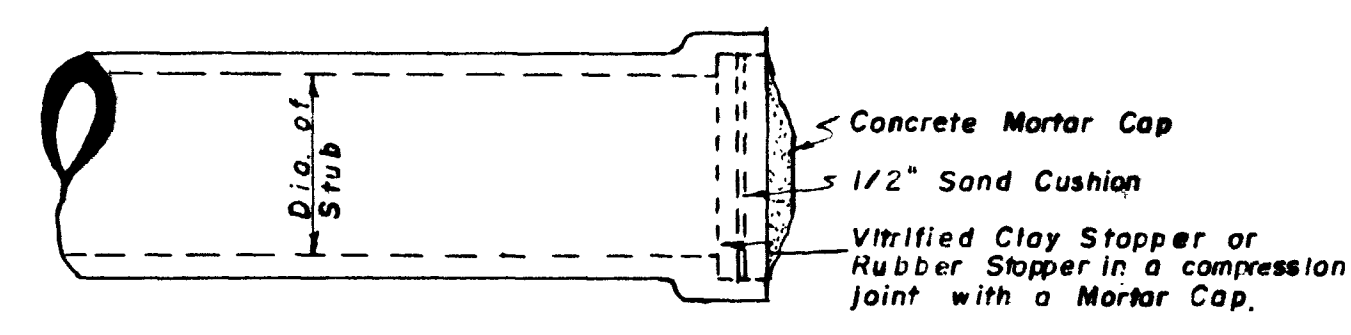


PLUGGED STUB DETAIL
No Scale

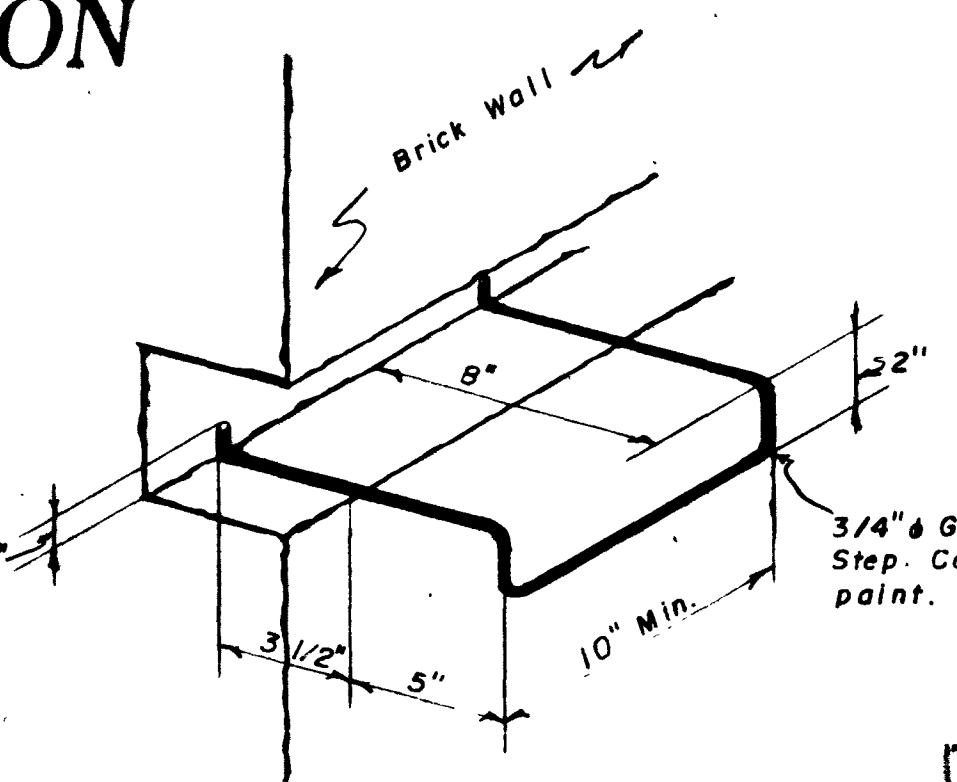

MANHOLE STEP DETAIL
No Scale

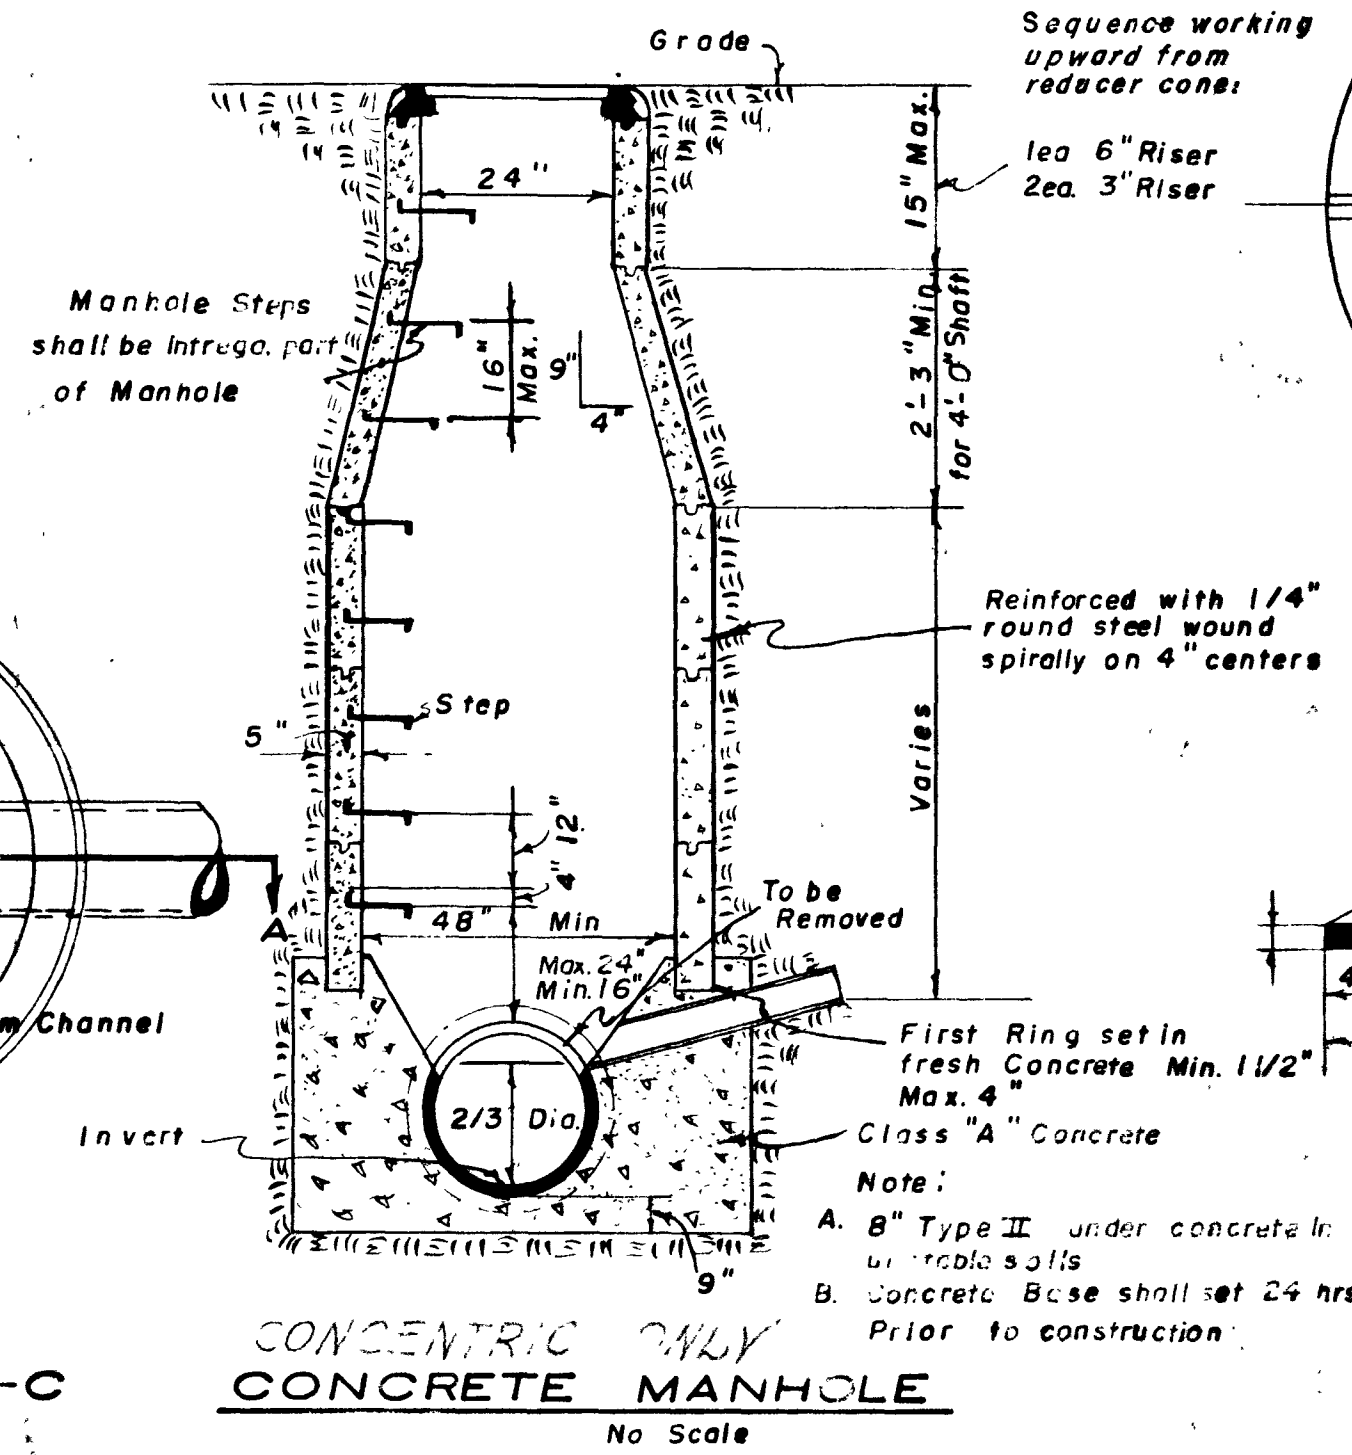


CONCENTRIC ONLY CONCRETE MANHOLE
No Scale

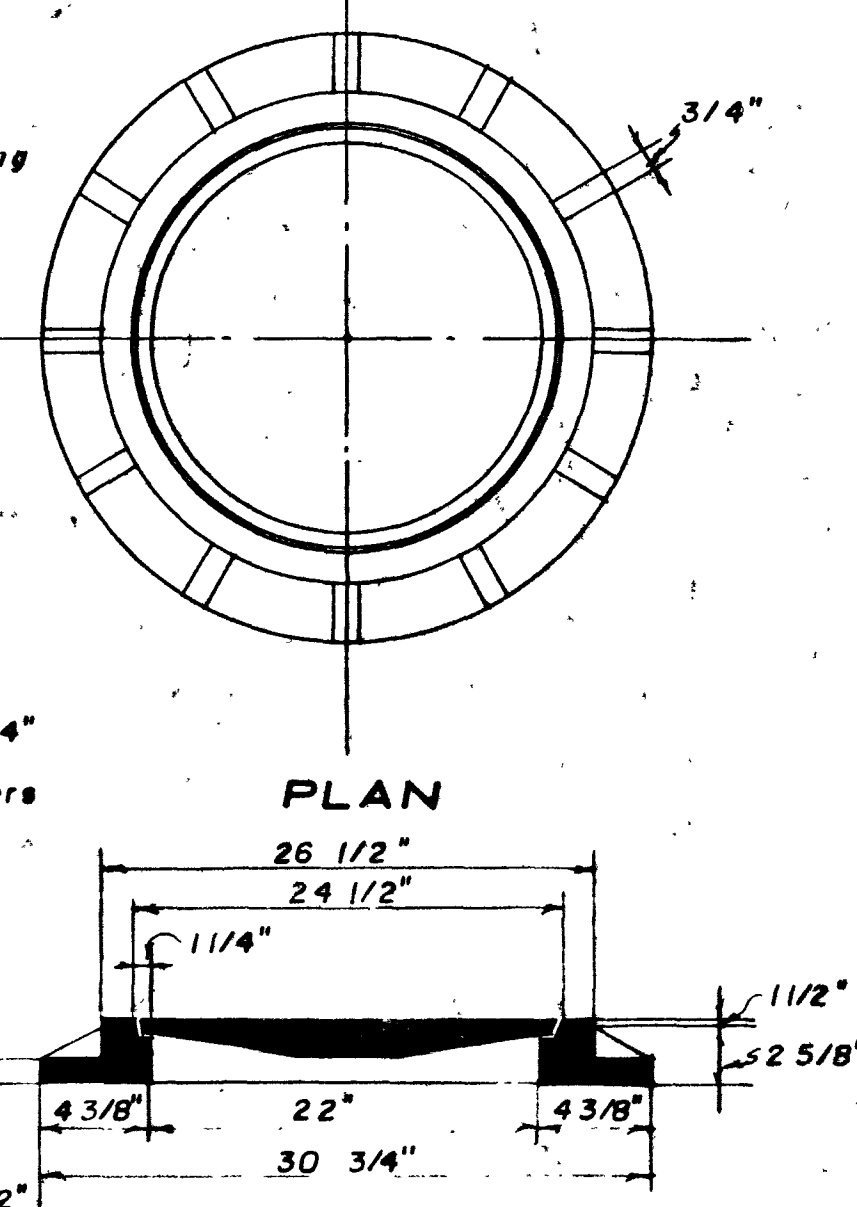


FRAME
No Scale

1. Frame and Cover to be Alhambra Foundry Co. Type A 1310 or approved equal.
2. Cast Iron shall have minimum tensile strength of 30,000 lbs./sq. inch.
3. Frame and Cover machined to fit.
4. Weight of Frame and Cover 330 lbs. approx.
5. For additional details see C.L.V. Standard Drawings S-110 and S-117.
6. Manhole Cover Min. 155 Lbs.
7. Manhole Ring Min. 175 Lbs.


MANHOLE FRAME & COVER
No Scale

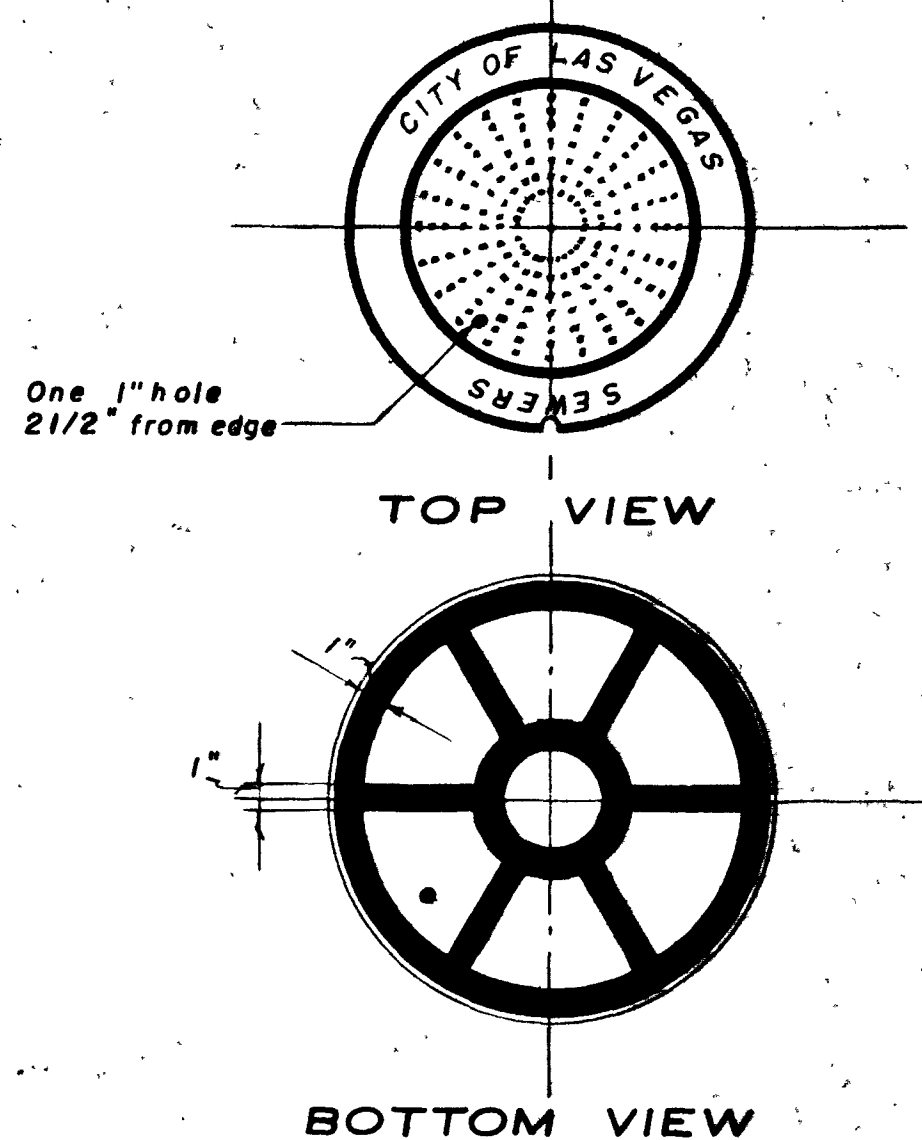


COVER
No Scale

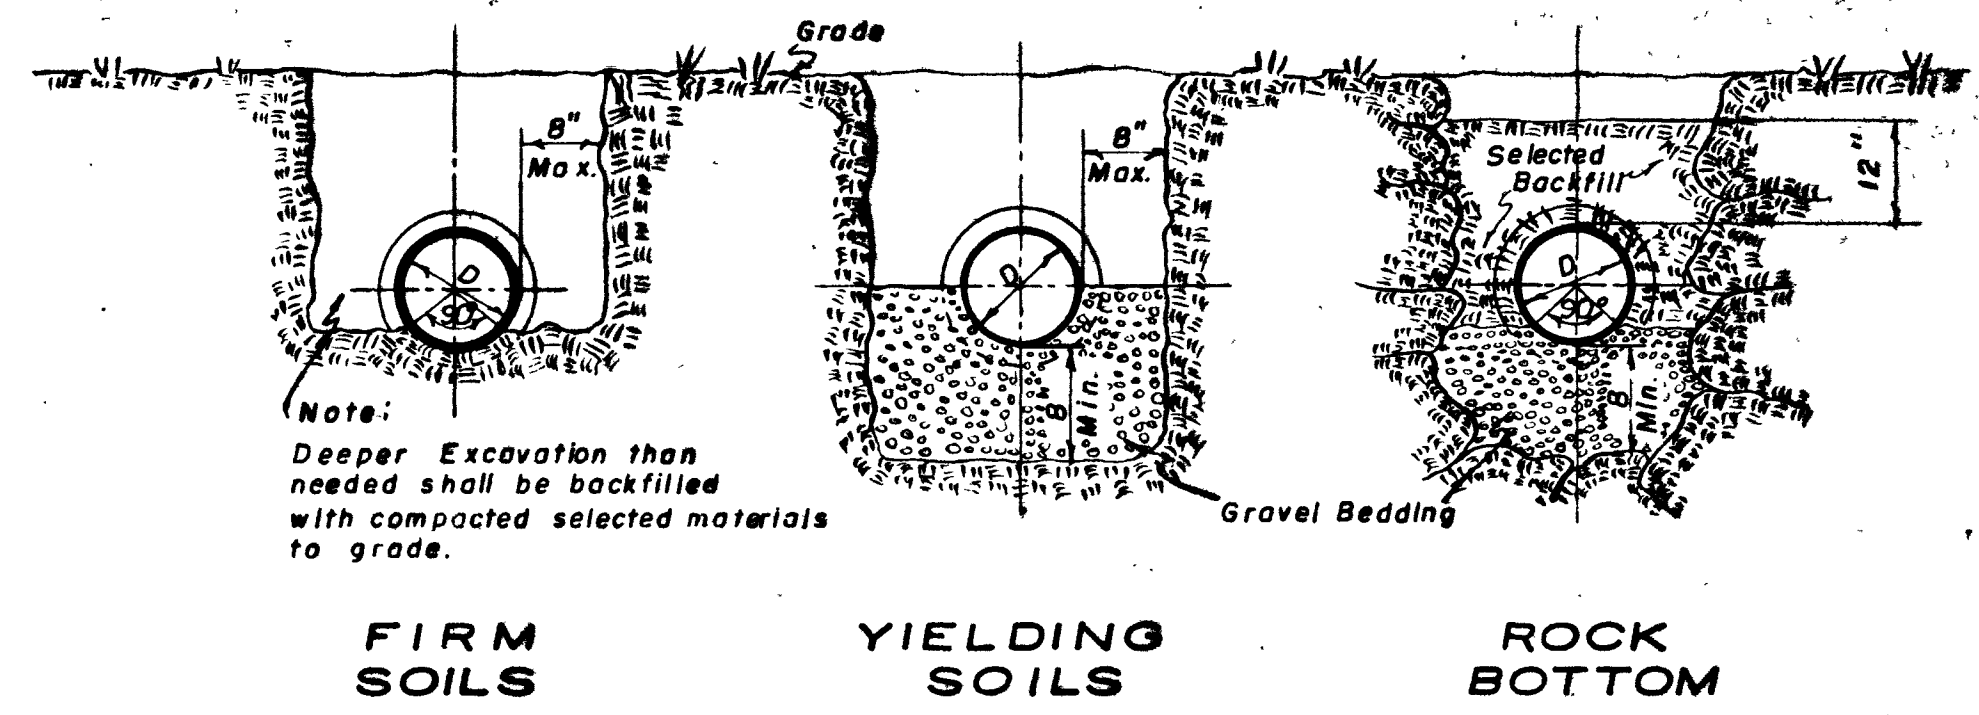

PIPE LAYING
No Scale

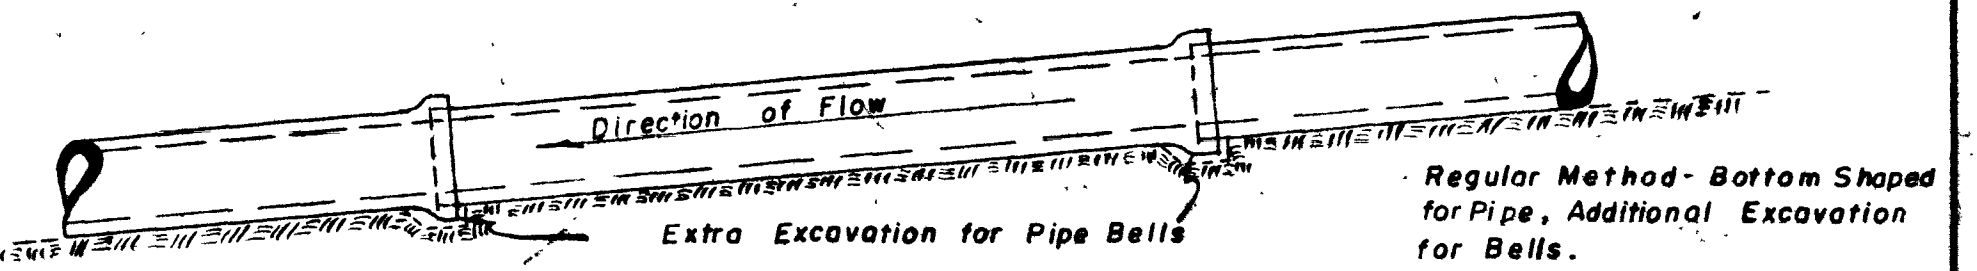

PIPE BEDDING
No Scale

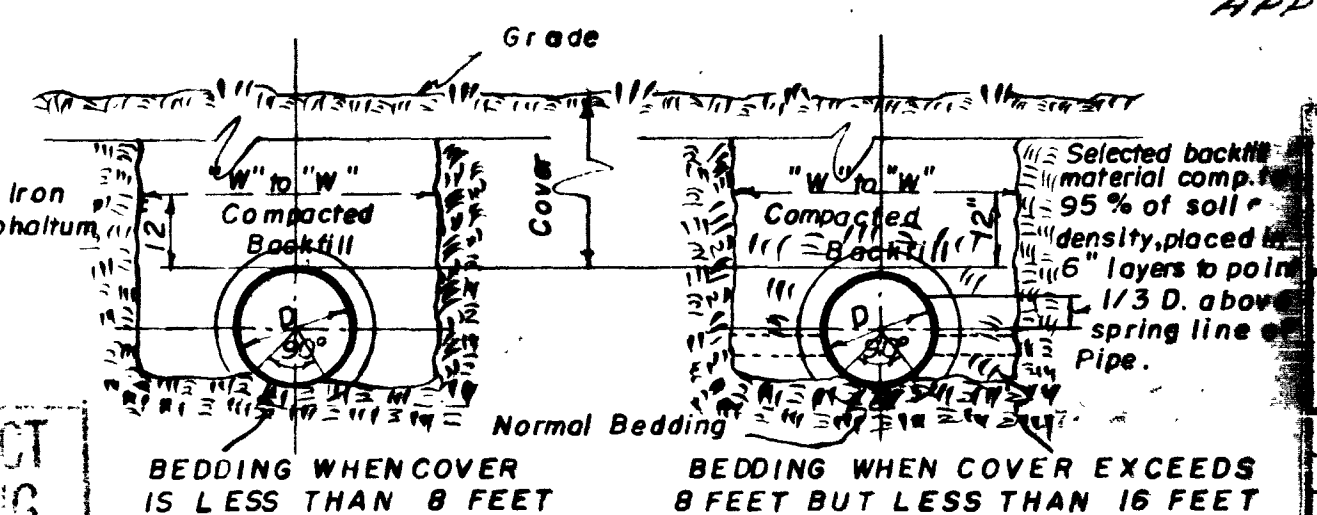

PIPE BEDDING
No Scale

27. Standard
5. H.W. 2/2/65
3. H.W. 1/2/65
2. H.W. 1/2/65
4. H.W. 1/2/65
1. H.W. 1/2/65

CONTRACT DRAWING
FEB 3 1965

CITY OF LAS VEGAS NEVADA
ENGINEERING DEPT.

VEGAS HEIGHTS SANITARY
SEWER DETAIL SHEET

DES.	DATE	SC. (H) NONE
DR. NELSON	11-23-64	SC. (V)
CKD. 11/23/64		F.B.K. NO.
APPROVED BY CITY ENGR.		P.I.O. NO.
		DRAWING NO.

467

307-V87

UNIT 1 SHEET 14 OF 14