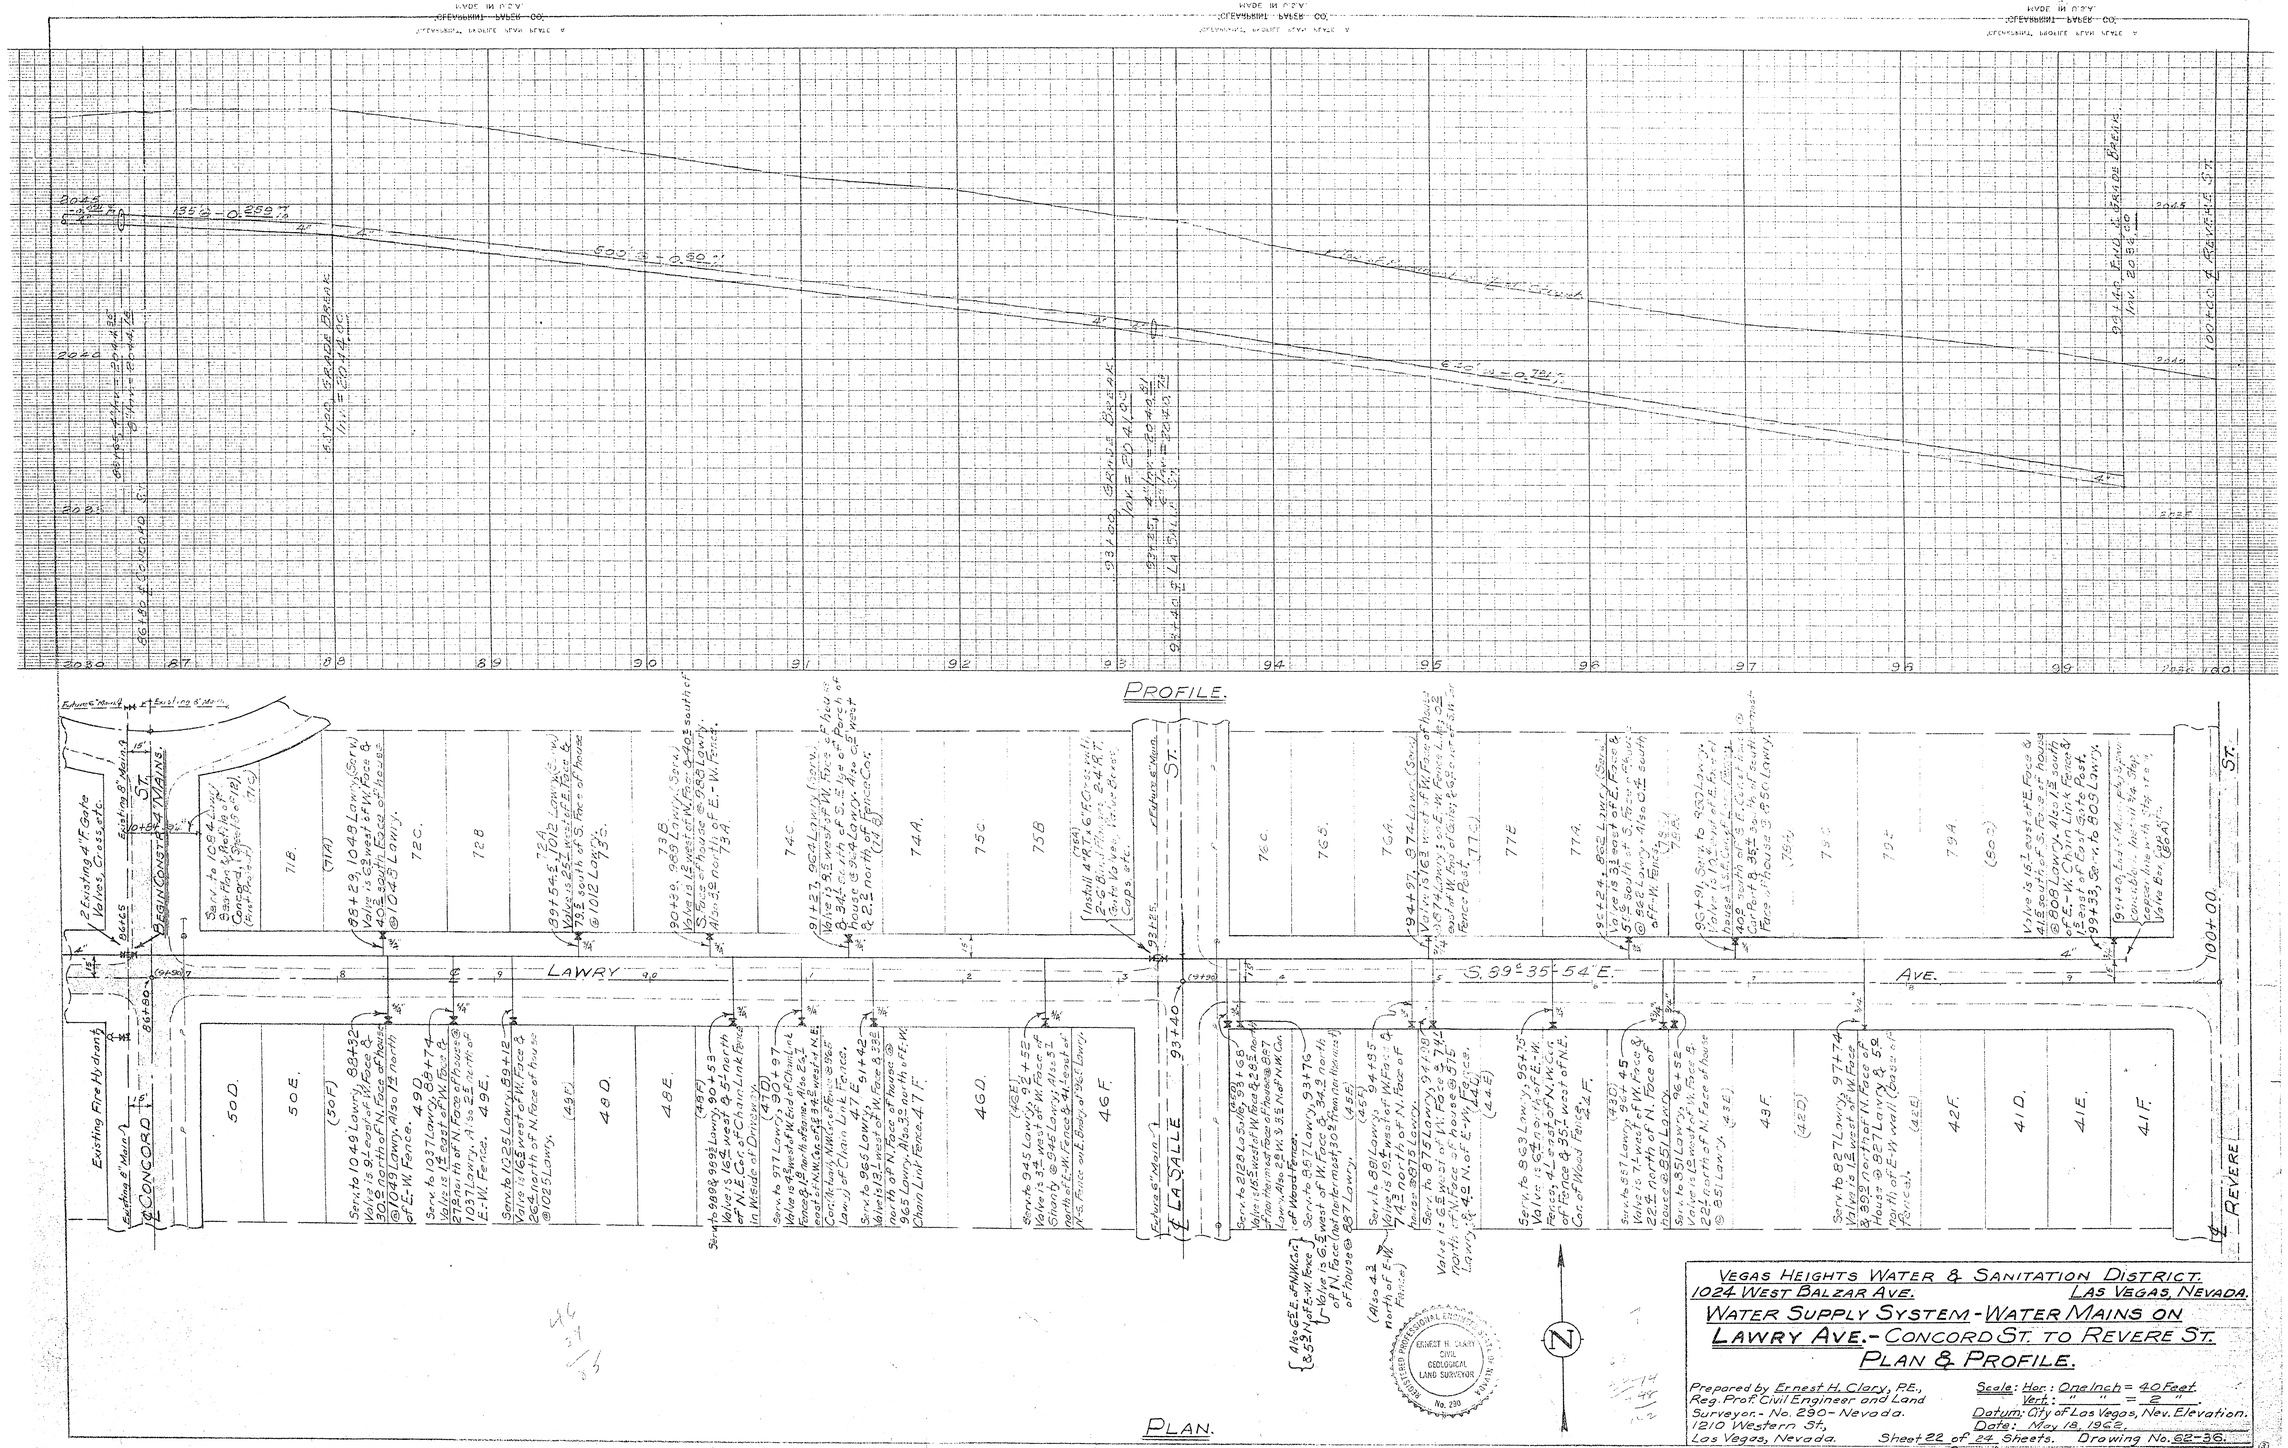
PROFILE.
PLAN.
LAWRY AVE.
S. 59° 35' 54" E.
CONCORD ST.
LA SALLE ST.
REVERE ST.
BEGIN CONSTR. 4" MAINS.
Existing Fire Hydrant
Existing 8" Main
Existing 4" Gate Valves, Cross, etc.
Future 8" Main
Future 4" Main
Sewer to 1049 Lawry, 88+32 Valve is 9' east of W. Face & 30' north of N. Face of house @ 1049 Lawry. Also 12' north of E.-W. Fence. 49 D.
Sewer to 1037 Lawry, 89+74 Valve is 1' east of W. Face & 27' north of N. Face of house @ 1037 Lawry. Also 22' north of E.-W. Fence. 49 E.
Sewer to 1025 Lawry, 89+12 Valve is 16' west of W. Face & 26' north of N. Face of house @ 1025 Lawry.
Sewer to 9898 Lawry, 90+53 Valve is 16' west of W. Face of house & 25' north of N.E. Cor. of Chain Link Fence in Middle of Driveway.
Sewer to 977 Lawry, 90+97 Valve is 4' west of W. side of Chain Link Fence & 19' north of house. Also 24' east of N.W. Cor. of 3' x 5' wall at N.E. Cor. of Lawry & Concord.
Sewer to 965 Lawry, 91+42 Valve is 13' west of W. Face & 33' north of N. Face of house @ 965 Lawry. Also 30' north of E.-W. Chain Link Fence. 47 F.
Sewer to 945 Lawry, 92+52 Valve is 3' west of W. Face of Shanty @ 945 Lawry. Also 31' north of E.-W. Fence & 41' east of W.-S. Fence and Body of 945 Lawry.
Sewer to 2128 La Salle, 93+68 Valve is 6' west of W. Face & 26' south of N. Face of house & 26' north of N.W. Cor. of house. Also 28' W. & 5' N. of N.W. Cor. of Wood Fence.
Sewer to 867 Lawry, 93+76 Valve is 6' west of W. Face & 34' north of N. Face of house @ 867 Lawry. Also 43' north of E.-W. Fence.
Sewer to 889 Lawry, 94+95 Valve is 15' west of W. Face & 7.4' north of N. Face of house @ 889 Lawry.
Sewer to 875 Lawry, 94+98 Valve is 6' west of W. Face & 7.4' north of N. Face of house @ 875 Lawry.
Sewer to 863 Lawry, 95+75 Valve is 6' north of E.-W. Fence & 4' east of N.W. Cor. of Fence & 35' west of N.E. Cor. of Wood Fence. 44 F.
Sewer to 857 Lawry, 96+45 Valve is 7' west of W. Face & 22' north of N. Face of house @ 857 Lawry.
Sewer to 851 Lawry, 96+52 Valve is 1' west of W. Face & 22' north of N. Face of house @ 851 Lawry. 43 F.
Sewer to 827 Lawry, 97+74 Valve is 1' west of W. Face of House @ 827 Lawry & 5' north of E.-W. wall (Loads of Fence). 42 F.
Sewer to 8 Revere, 99+33 Valve is 16' east of E. Face & 41' south of S. Face of house @ 805 Lawry. Also 12' south of E.-W. Ch. Link Fence & 12' east of East Gate Post.
Valve Box (BEAT)
Copper line with stop cock below Valve Box (BEAT)
Sewer to 1054 Lawry, 88+90 Valve is 6' west of W. Face & 30' north of N. Face of house @ 1049 Lawry. Also 12' south of E.-W. Fence. 71 B.
Valve is 6' west of W. Face & 40' south of N. Face of house @ 1049 Lawry.
Valve is 2' west of E. Face & 79' south of S. Face of house @ 1012 Lawry.
Valve is 22' west of E. Face & 79' south of S. Face of house @ 1012 Lawry.
